

Contractor:

George R. Cairns & Sons, Inc.
8 Ledge Road
Windham, NH 03087

Town of Exeter, New Hampshire

Court Street

Little River Bridge Replacement

Issued for Construction

June 2017

George R. Cairns 6-13-17
Signature of Corporate Officer Date

President
Title

Exeter Board of Selectmen


Don Clement, Chair
Anne Surman, Vice Chair
Kathy Corson, Clerk
Dan Chartrand
Julie Gilman

Exeter Town Manager

Russell Dean


Exeter Department of Public Works

Jennifer Perry, PE, Director
Jay Perkins, Hwy. Supt.
Paul Vlasich, PE, Town Engineer
Jennifer Mates, PE, Asst. Town Engineer

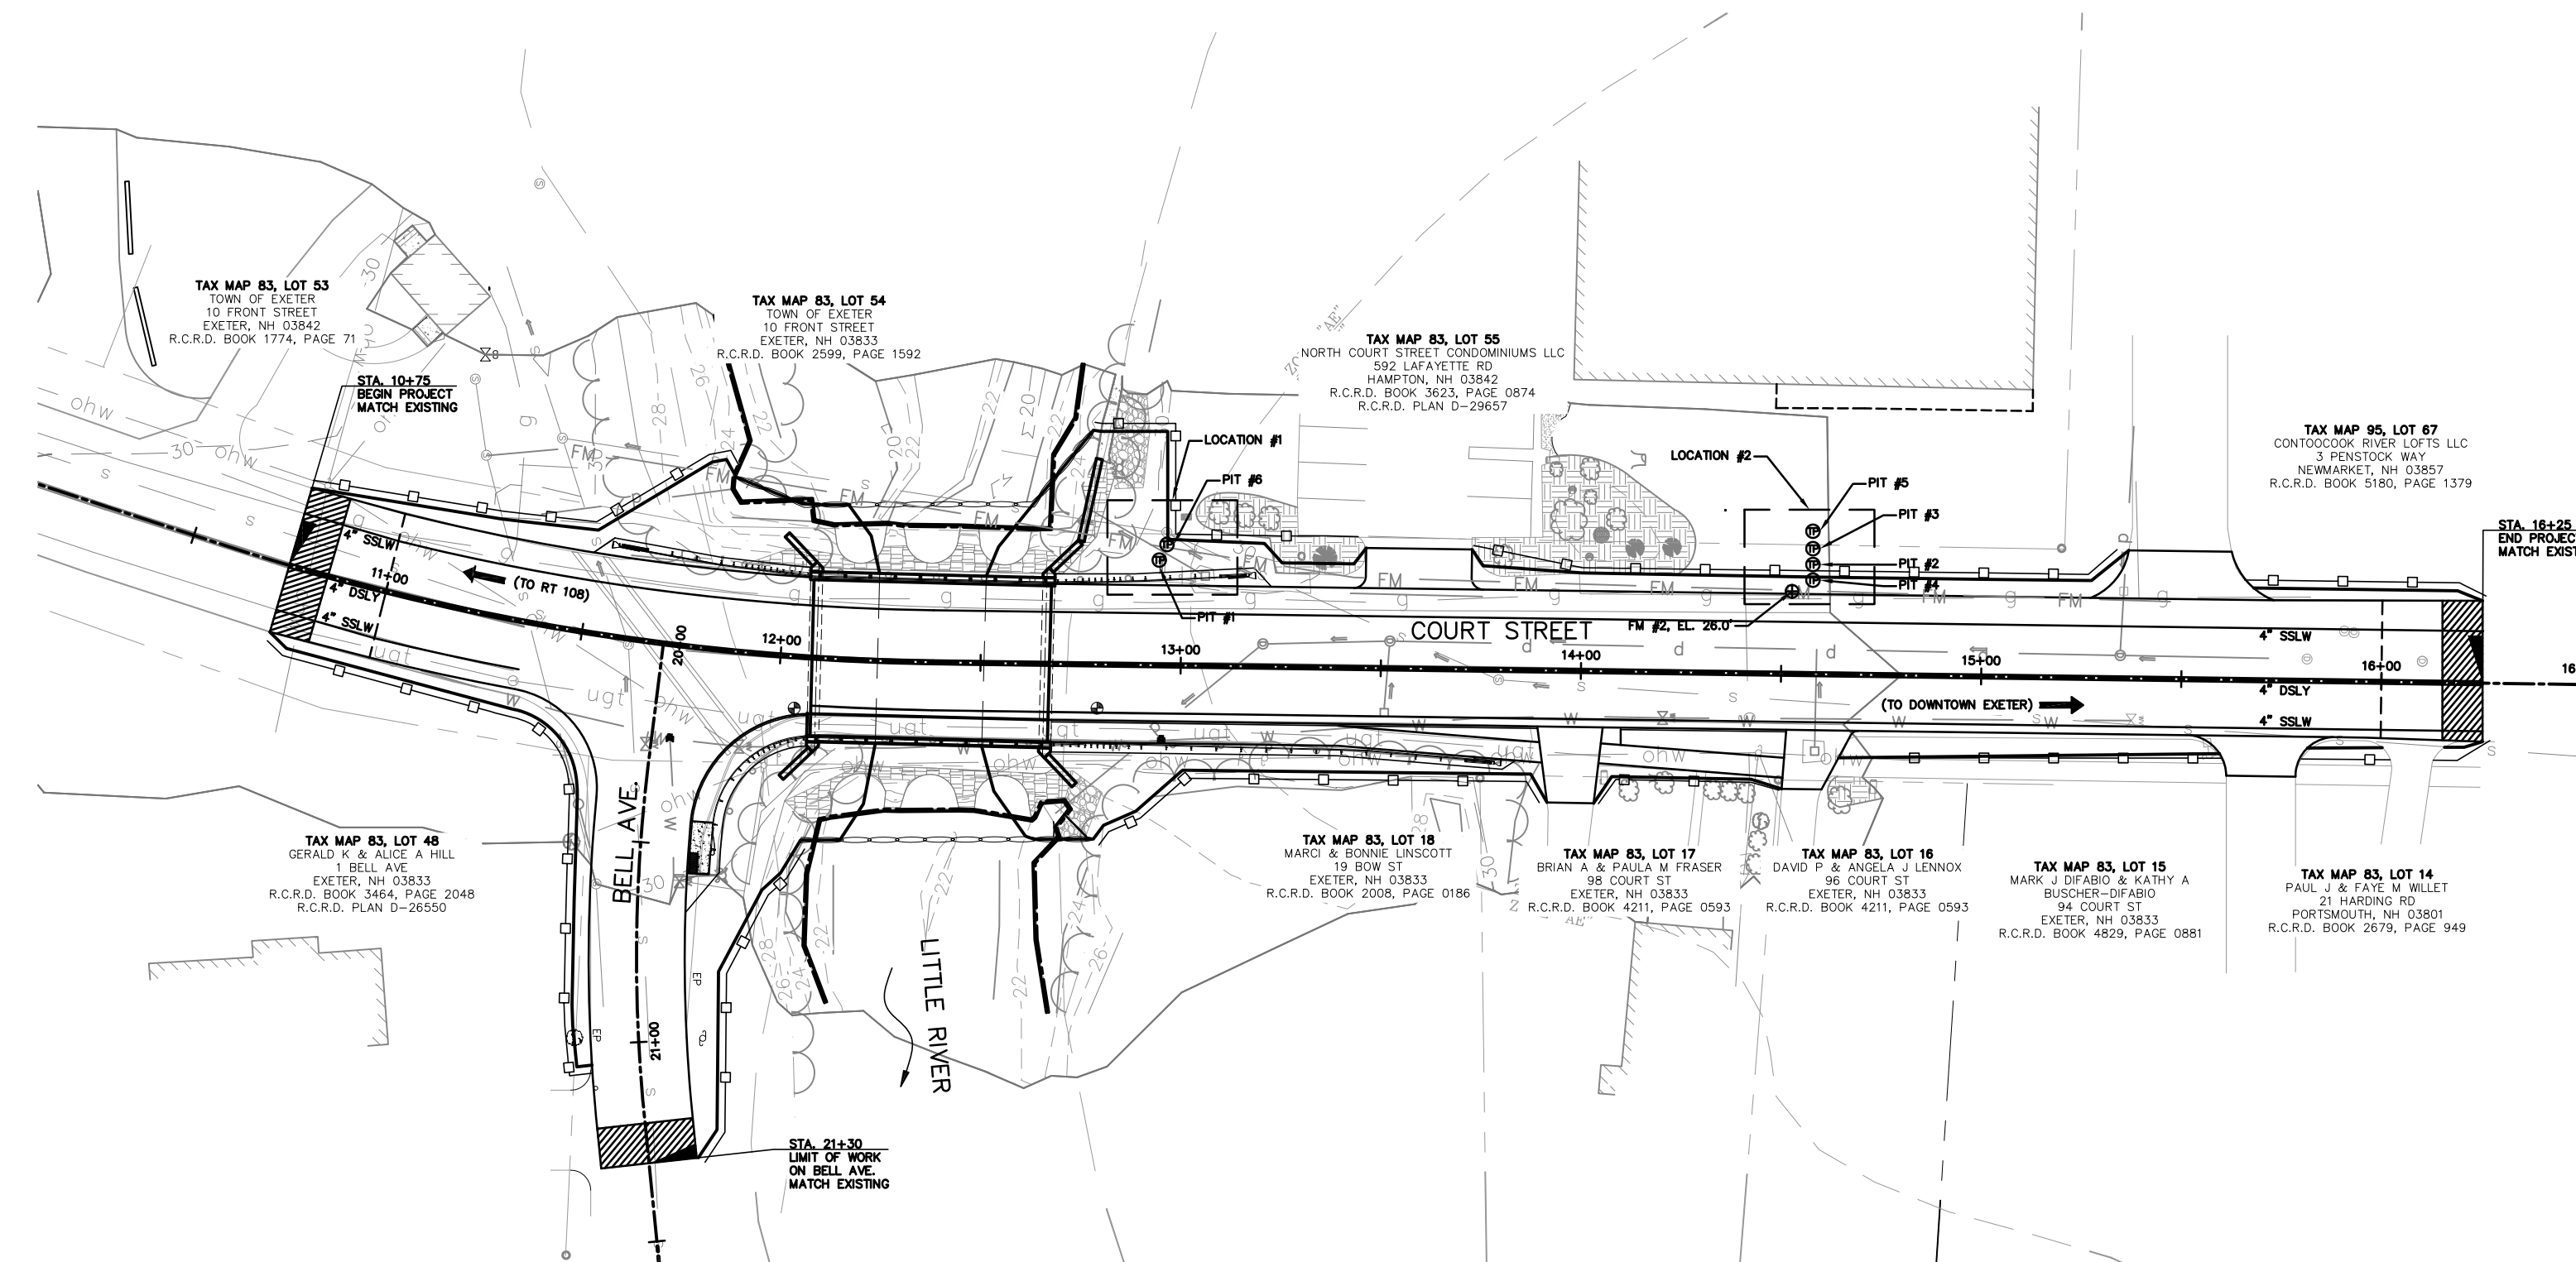

SITE OVERVIEW
SCALE: 1" = 40'

SHEET INDEX	
Sheet Number	Sheet Title
1	Cover
2	General Plan and Elevation
3	Site Plan and Profile
4	Bridge Notes
5	Survey Layout and Channel Sections
6	Boring Logs (Sheet 1 of 2)
7	Boring Logs (Sheet 2 of 2)
8	Abutment A Plan and Elevation
9	Abutment B Plan and Elevation
10	Abutment Sections
11	Abutment and Wingwall Elevations and Details
12	Prestressed Box Beam Layout
13	Prestressed Box Beam Details (Sheet 1 of 3)
14	Prestressed Box Beam Details (Sheet 2 of 3)
15	Prestressed Box Beam Details (Sheet 3 of 3)
16	Typical Section and Rail Layout
17	Superstructure Details
18	Approach Slab Details (Sheet 1 of 2)
19	Approach Slab Details (Sheet 2 of 2)
20	Bearing and Joint Details
21	T101 Bridge & Approach Rail (Steel Posts)
22	Snow Screen With T101 Bridge Rail
23	General Notes and Summary of Quantities
24	Roadway Plan and Profile (Sheet 1 of 2)
25	Roadway Plan and Profile (Sheet 2 of 2)
26	Cross Sections (Sheet 1 of 4)
27	Cross Sections (Sheet 2 of 4)
28	Cross Sections (Sheet 3 of 4)
29	Cross Sections (Sheet 4 of 4)
30	Road and Utility Details
31	Thrust Block Details
32	Court Street Traffic Control Plan
33	Alternative Platform for Offset EAGRT
34	Sidewalk Curb Ramps With Detectable Warnings

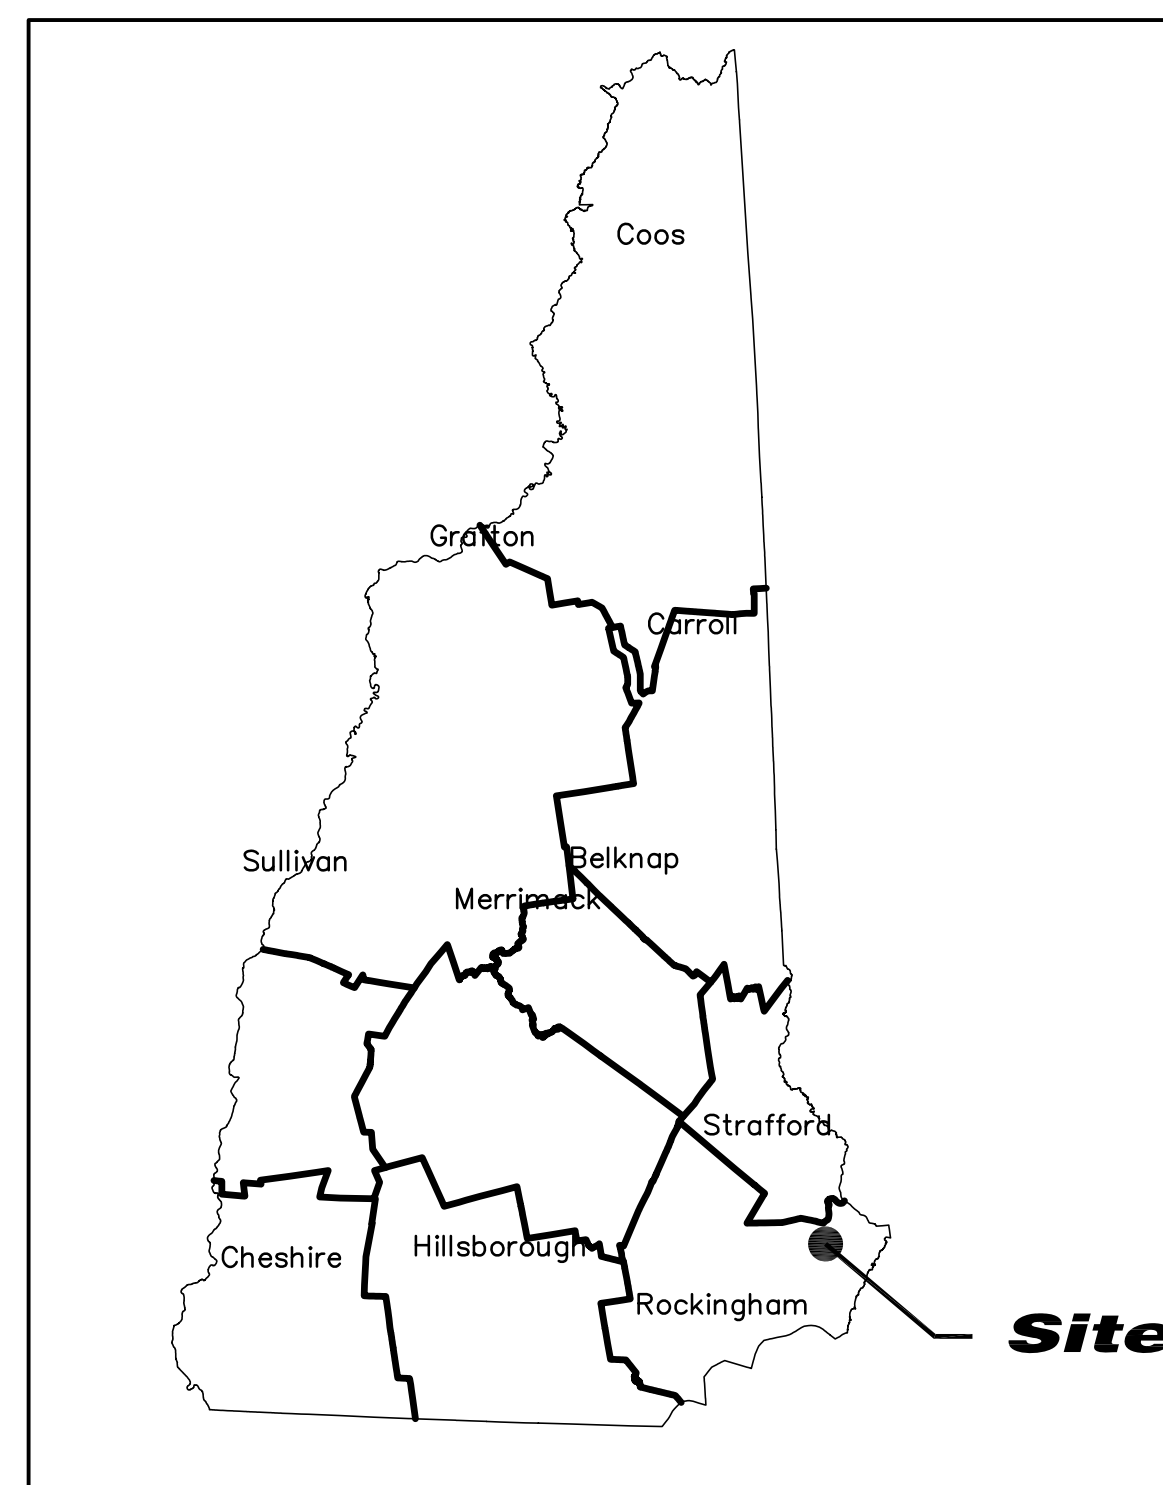

Locus Plan

Prepared For:
Town of Exeter
Department of Public Works
13 Newfields Road
Exeter, New Hampshire 03833

Prepared By:




CIVIL/ENVIRONMENTAL/STRUCTURAL

Portsmouth, NH • Manchester, NH • Portland, ME
603/431-6196 • 603/627-0708 • 207/541-4223
cmaengineers.com



Project Location

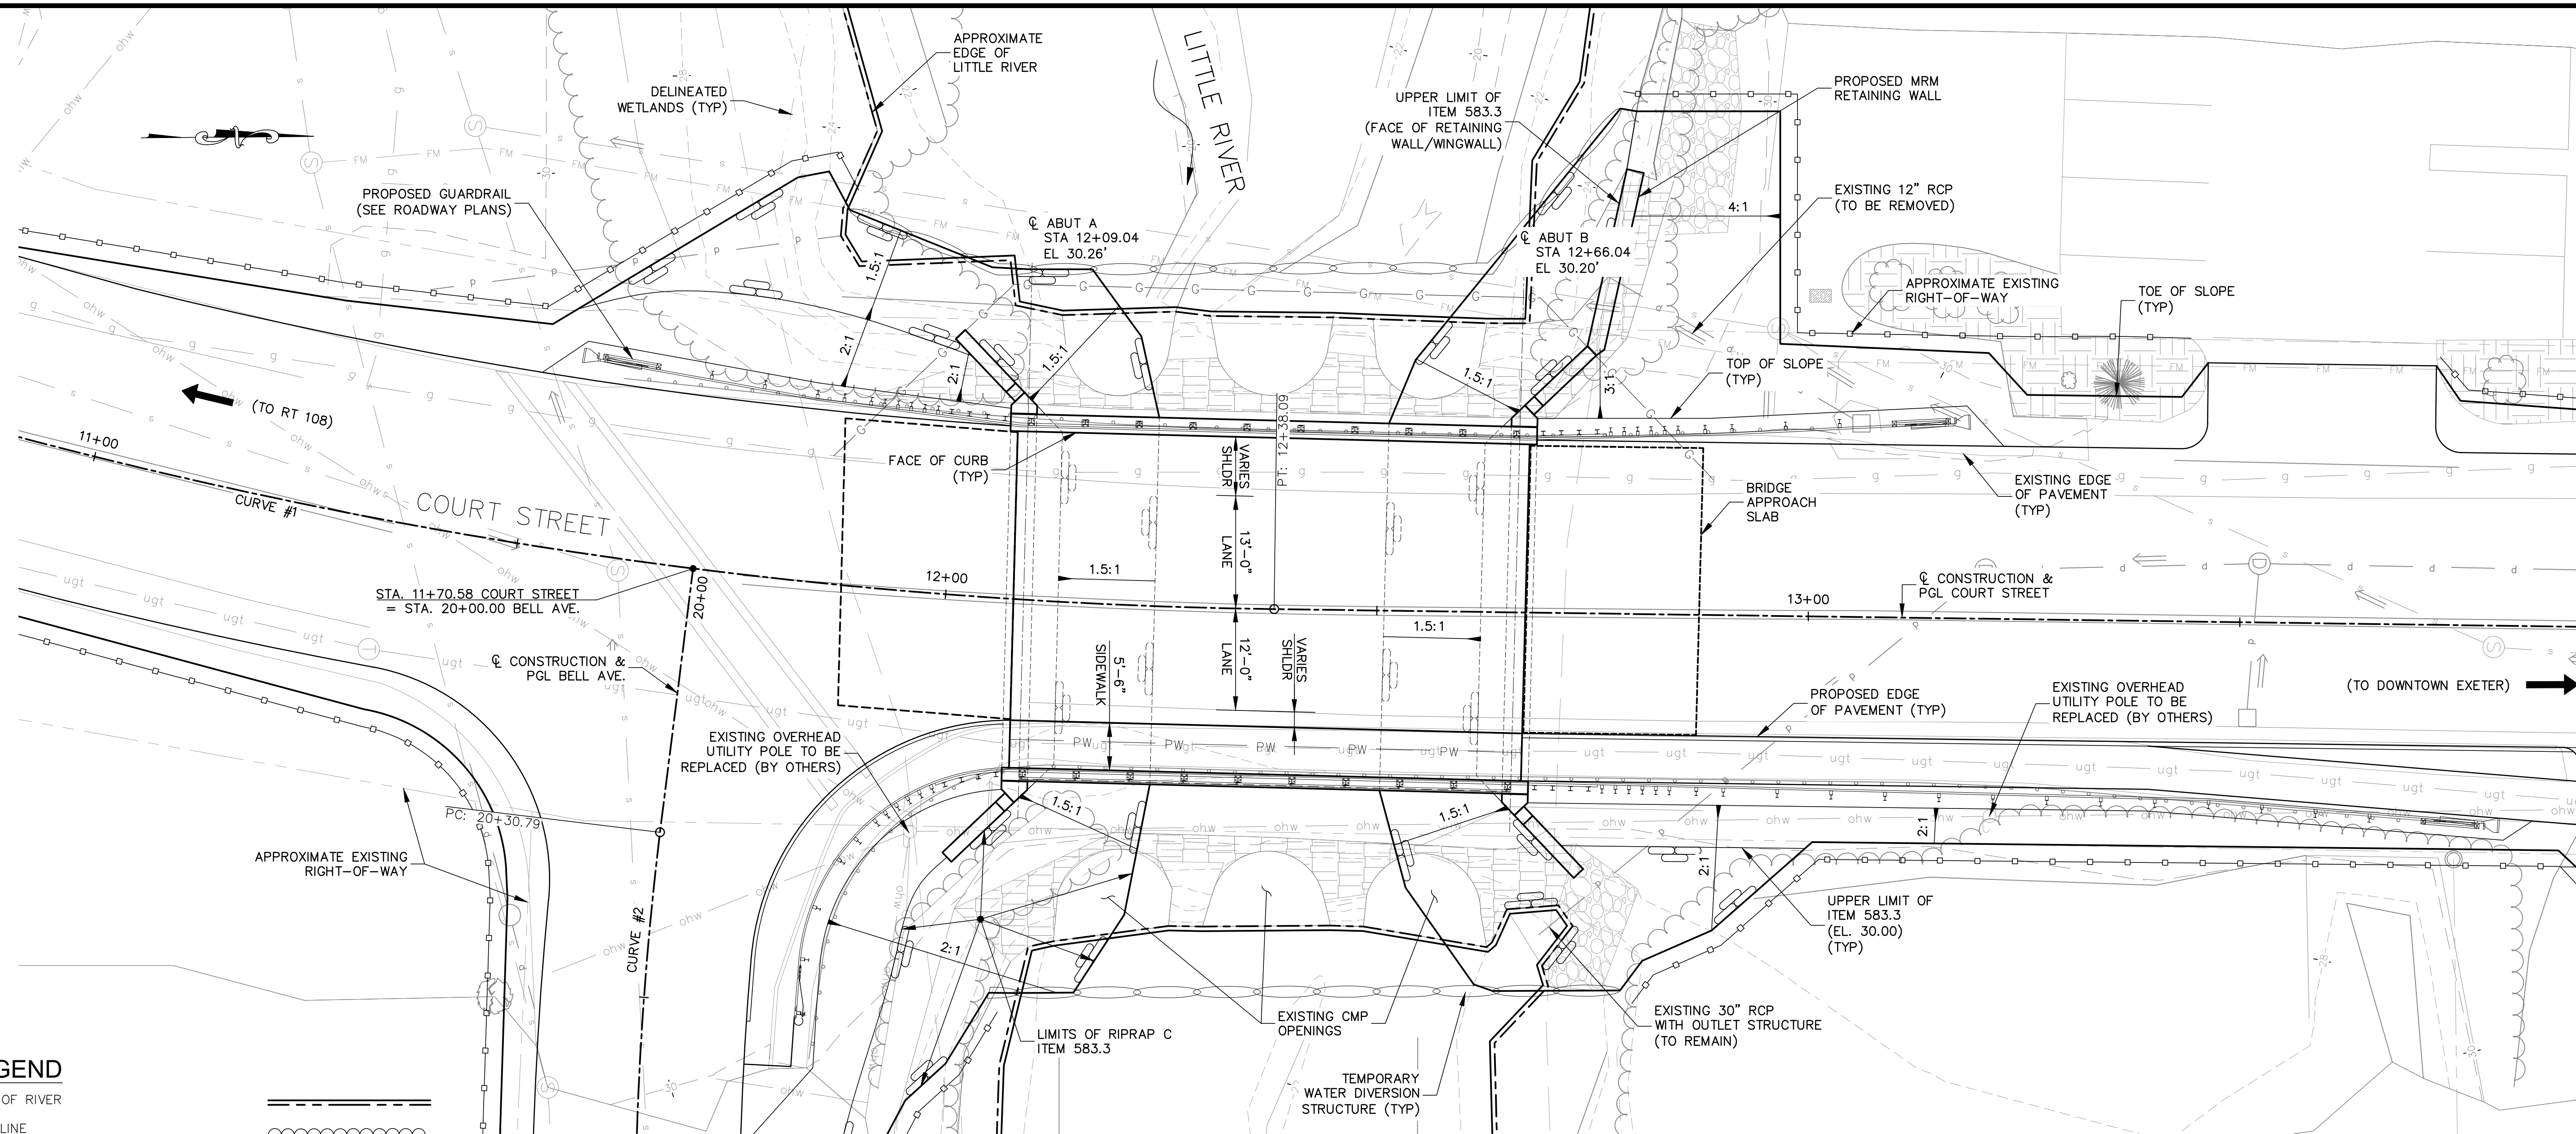

General Plan
Scale: 1"=10'-0"

LEGEND

EDGE OF RIVER	
TREE LINE	
SILT FENCE	
PROPERTY LINE/ROW	
WATER DIVERSION STRUCTURE	
STONE FILL	
EXISTING OVERHEAD ELECTRIC	
PROPOSED OVERHEAD ELECTRIC	
EXISTING WATER MAIN	
PROPOSED WATER MAIN	
EXISTING SEWER MAIN	
PROPOSED UNDERGROUND TELECOM.	
EXISTING GAS MAIN	
PROPOSED GAS MAIN	
EXISTING DRAINAGE PIPE	
PROPOSED DRAINING PIPE	
EXISTING SEWER FORCE MAIN	

HYDRAULIC DATA


DESIGN FLOOD:	957 CFS (50 YEAR)
DESIGN VELOCITY:	2.41 FT/SEC
DESIGN FLOOD ELEVATION:	29.83 FT (50 YEAR)
100 YEAR FLOOD ELEVATION:	31.21 FT

**CURVE #1
COURT STREET**

PI STA = 11+46.88
N = 172946.66
E = 1175795.71
Δ = 17°25'19"
T = 91.93'
R = 600.00'
L = 182.44'
E = 7.00'

**CURVE #1
BELL AVE.**

PI STA = 20+73.91
N = 172962.03
E = 1175865.77
Δ = 13°04'13"
T = 45.86'
R = 400.00'
L = 91.31'
E = 2.62'

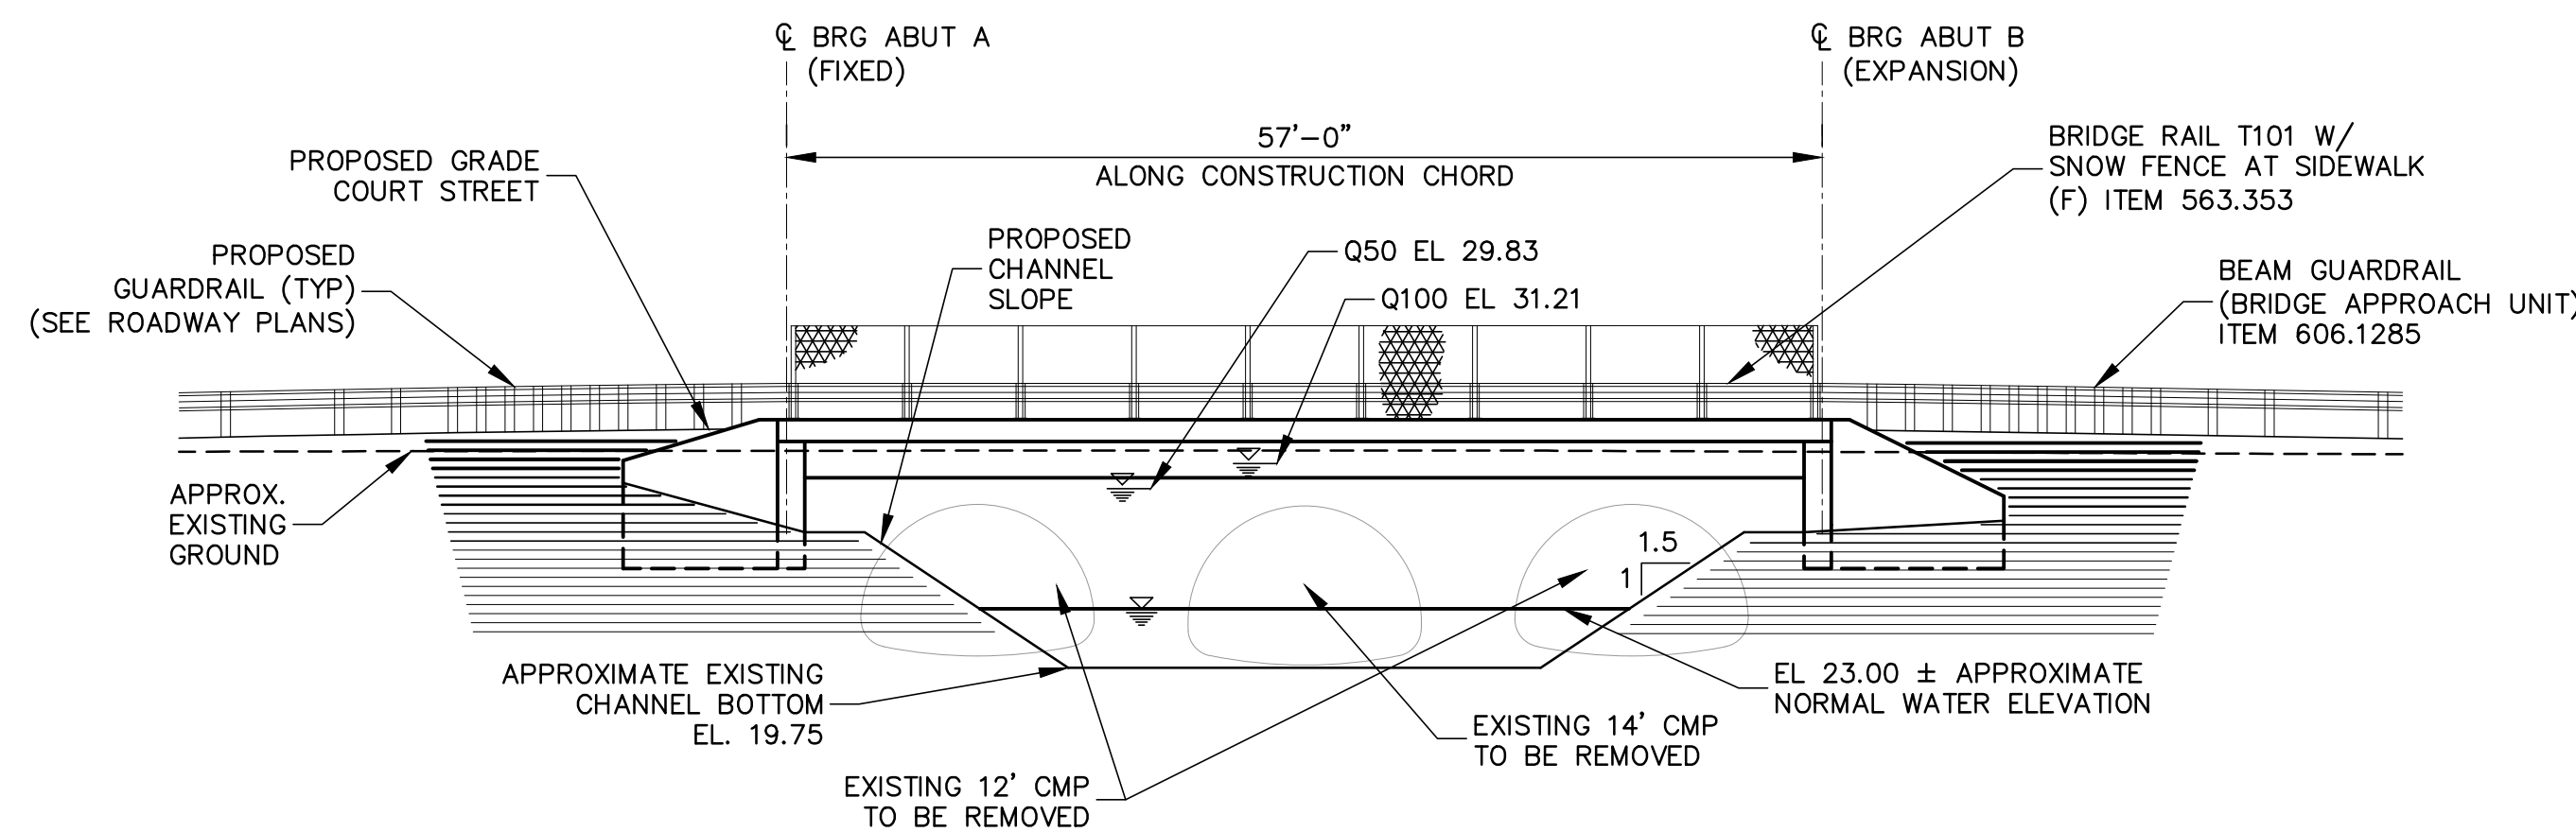


Elevation
Scale: 1"=10'-0"

INDEX OF BRIDGE SHEETS

DRAWING NO.	SHEET TITLE
B-1	GENERAL PLAN AND ELEVATION
B-2	SITE PLAN AND PROFILE
B-3	BRIDGE NOTES
B-4	SURVEY LAYOUT AND CHANNEL SECTIONS
B-5	BORING LOGS (SHEET 1 OF 2)
B-6	BORING LOGS (SHEET 2 OF 2)
B-7	ABUTMENT A PLAN AND ELEVATION
B-8	ABUTMENT B PLAN AND ELEVATION
B-9	ABUTMENT SECTIONS
B-10	ABUTMENT AND WINGWALL ELEVATIONS AND DETAILS
B-11	PRESTRESSED BOX BEAM LAYOUT
B-12	BOX BEAM DETAILS (SHEET 1 OF 3)
B-13	BOX BEAM DETAILS (SHEET 2 OF 3)
B-14	BOX BEAM DETAILS (SHEET 3 OF 3)
B-15	TYPICAL SECTION AND RAIL LAYOUT
B-16	SUPERSTRUCTURE DETAILS
B-17	APPROACH SLAB DETAILS (SHEET 1 OF 2)
B-18	APPROACH SLAB DETAILS (SHEET 2 OF 2)
B-19	BEARING AND JOINT DETAILS
B-20	T101 BRIDGE AND APPROACH RAIL
B-21	SNOW SCREEN WITH T101 BRIDGE RAIL

 CIVIL/ENVIRONMENTAL/STRUCTURAL Portsmouth, NH • Manchester, NH • Portland, ME 603/431-6196 • 603/627-0708 • 207/541-4223 c m a a e n g i n e e r s . c o m	ISSUED FOR CONSTRUCTION A 6/13/17 JLG date by
	designed by: LBK/OGK drawn by: LBK/BGP approved by: JLG date: June 2017 project no: 17-001 file name: S-1.dwg scale:
Town of Exeter Department of Public Works Court Street Little River Bridge Replacement General Plan and Elevation	drawing no. B-1 sheet: 2 of 34

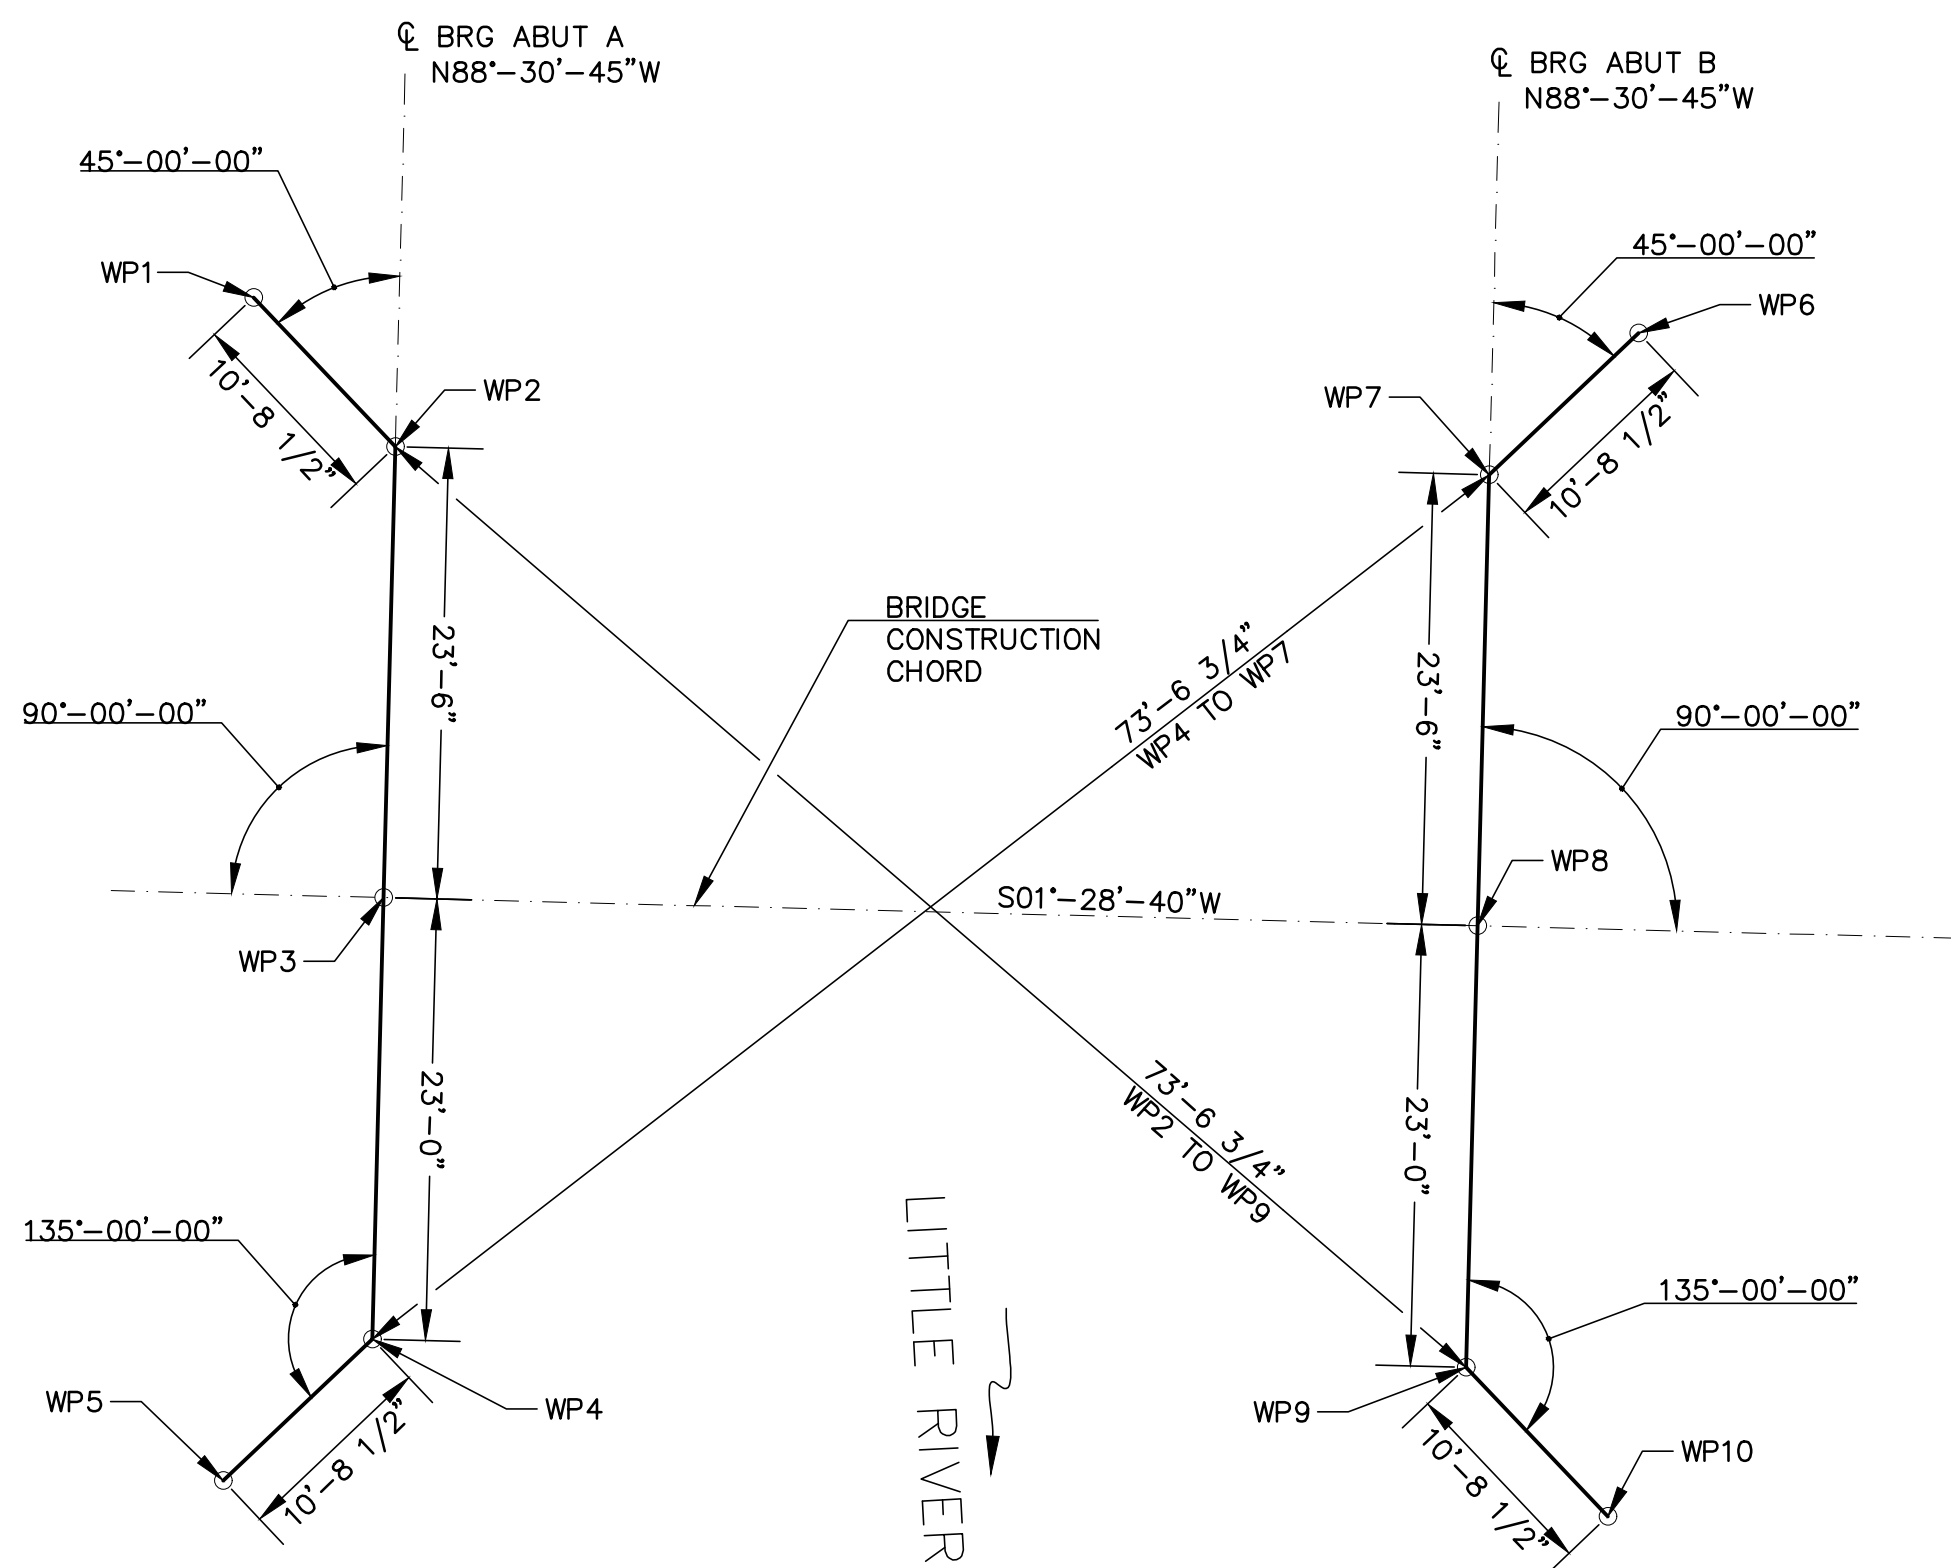

Survey Layout

Scale: 1"=10'

WORKING POINT COORDINATES		
WORKING POINT NO.	NORTHING	EASTING
WP1	173002.78	1175764.60
WP2	173010.15	1175772.36
WP3	173009.54	1175795.85
WP4	173008.95	1175818.85
WP5	173001.18	1175826.22
WP6	173074.90	1175766.46
WP7	173067.13	1175773.84
WP8	173066.52	1175798.33
WP9	173065.93	1175820.32
WP10	173073.30	1175828.08


SUMMARY OF BRIDGE QUANTITIES			
ITEM NO.	ITEM DESCRIPTION	QUANTITY	UNIT
207.1	COMMON CHANNEL EXCAVATION	1250	CY
209.201	GRANULAR BACKFILL (BRIDGE) (F)	130	CY
403.911	HOT BITUMINOUS BRIDGE PAVEMENT, 1 1/2" BASE COURSE	20	TON
502	REMOVAL OF EXISTING BRIDGE STRUCTURE	1	U
503.101	WATER DIVERSION STRUCTURE	1	U
504.1	COMMON BRIDGE EXCAVATION (F)	340	CY
504.2	ROCK BRIDGE EXCAVATION	5	CY
508	STRUCTURAL FILL	28	CY
510.1	PILE DRIVING EQUIPMENT	1	U
510.61	FURNISHING & DRIVING STEEL BEARING PILES	28200	LB
510.65	DRIVING-POINTS FOR STEEL BEARING PILES	14	EA
520.01	CONCRETE CLASS AA	140	CY
520.0302	CONCRETE CLASS AA APPROACH SLABS	71	CY
520.21	CONCRETE CLASS B, FOOTINGS (F)	7	CY
528.3224	PRESTRESSED CONCRETE BRIDGE DECK, 24" BUTTED BOX BEAMS (F)	2300	SF
534.3	WATER REPELLENT (SILANE/SILOXANE)	15	GAL
538.2	BARRIER MEMBRANE, PEEL AND STICK - VERTICAL SURFACES (F)	9	SY
538.5	BARRIER MEMBRANE, HEAT WELDED (F)	250	SY
544.3	REINFORCING STEEL (CONTRACTOR DETAILED)	7100	LB
544.31	REINFORCING STEEL, EPOXY COATED (CONTRACTOR DETAILED)	16700	LB
544.7	SYNTHETIC FIBER REINFORCING (F)	500	LB
548.11	ELASTOMERIC BEARING PADS (F)	44	EA
559.4	ASPHALTIC PLUG EXPANSION JOINT (F)	34	LF
559.41	ASPHALTIC PLUG FOR CRACK CONTROL (F)	34	LF
562.1	SILICONE JOINT SEALANT (F)	23	LF
563.3	BRIDGE RAIL T101	60	LF
563.353	BRIDGE RAIL T101 WITH SNOW SCREENING	60	LF
570.4	MORTAR RUBBLE MASONRY (F)	19	CY
583.3	RIPRAP CLASS III	280	CY
593.411	GEOTEXTILE; PERM CONTROL CL. 1, NON-WOVEN	650	SY
1008.9	ALTERATIONS AND ADDITIONS AS NEEDED - TESTING OF MATERIAL	6000	\$

LOCATION AND DESCRIPTION OF BENCHMARKS				
BENCHMARK	LOCATION	NORTHING	EASTING	ELEVATION
TBM "C"	MAG NAIL SET, UP 6" IN POLE #45/24/2VZ/2/25VZ	173357.27	1175819.77	32.93'
TBM "D"	MAG NAIL SET, UP 6" IN POLE #1/8/3/7/29	172887.80	1175752.20	30.62

HORIZONTAL DATUM: NAD 1983, NEW HAMPSHIRE STATE PLANE COORDINATE SYSTEM
 VERTICAL DATUM: NGVD 1929


NOTE: SEE ROADWAY PLANS FOR LOCATION OF TEMPORARY BENCH MARKS

Vertical datum of bridge plans is NGVD29. Subtract 0.76 ft from all elevations on plans to convert to NAVD88 for HEC-RAS model.

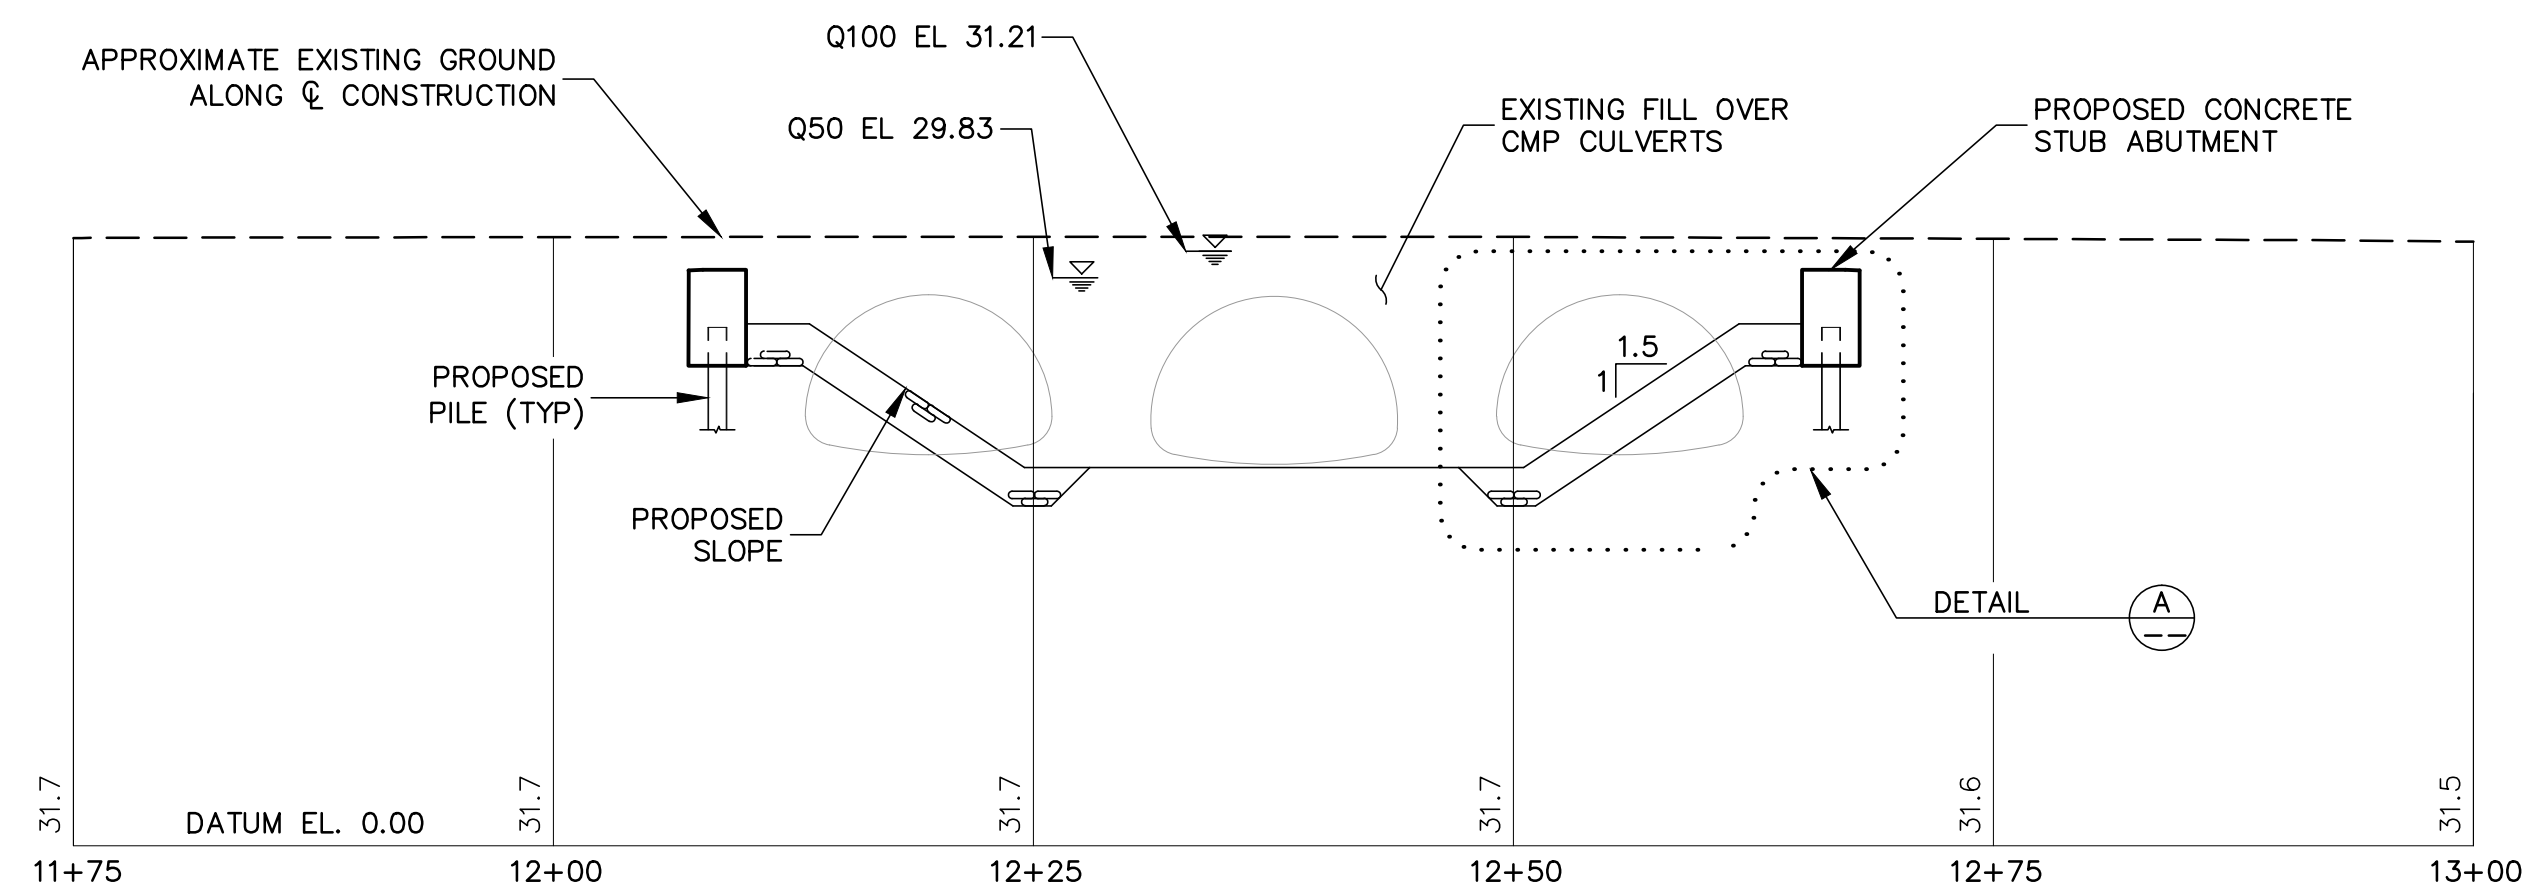

Proposed Channel Section

Scale: 1"=10'-0"

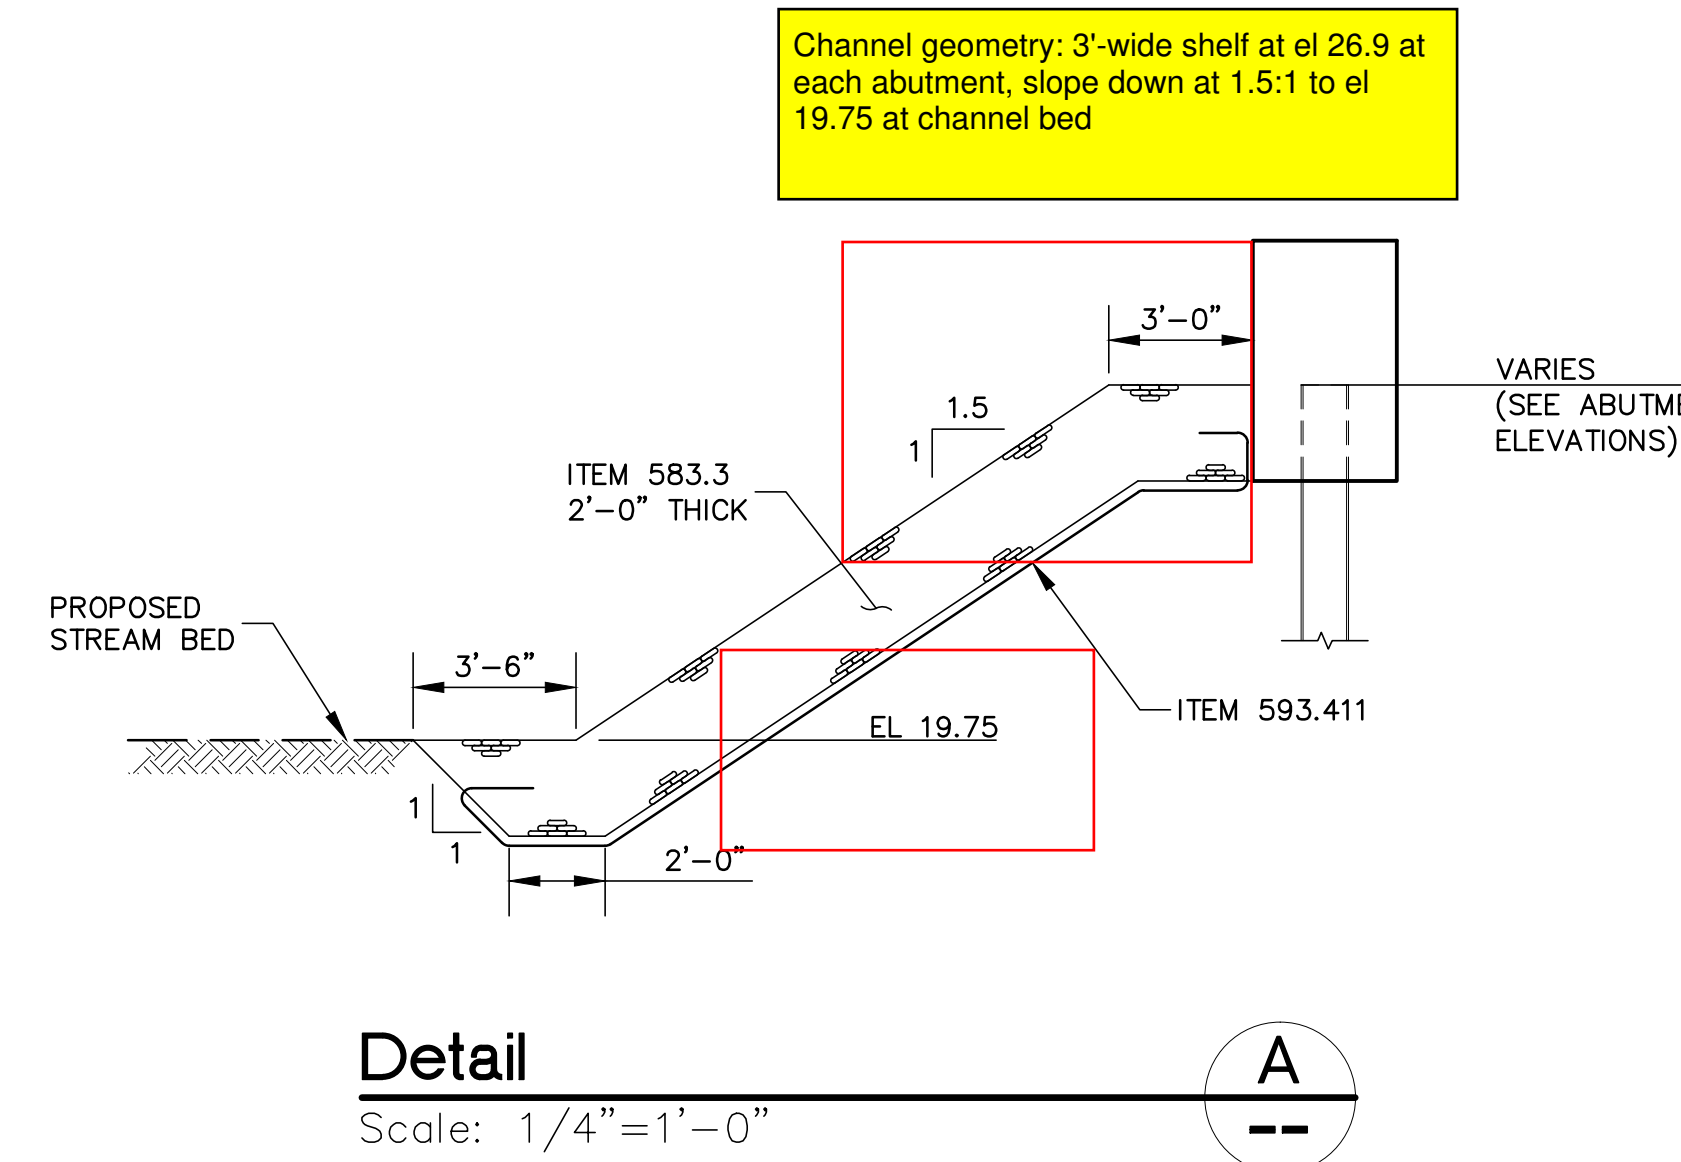

Detail


Scale: 1/4"=1'-0"

		Portsmouth, NH • Manchester, NH • Portland, ME 603/431-6196 • 603/627-0708 • 207/541-4223 c m a e n g i n e e r s . c o m	
designed by: LBK/OGK	drawn by: LBK/BGP	approved by: JLG	scale:
date: June 2017	project no: 	file name: S-4.dwg	
Town of Exeter Department of Public Works		Court Street Little River Bridge Replacement Survey Layout and Channel Sections	
drawing no. B-4		sheet: 5 of 34	

Boring No. B-1
Station 12+04, 12.9 Right


TEST BORING LOG

CMA Engineers, Inc. Civil/Environmental Engineers 35 Bow Street Portsmouth, NH 03801 Phone: 603.431.6196 Fax: 603.431.5376		PROJECT Description: Court St. Bridge Location: Exeter, NH Notes: Contractor: Great Works Pump & Test Boring, Inc.		Test Boring Number B-1 Sheet 1 of 2									
OBSERVED BY: CMA Engineer: Bob Grillo		Equipment: Acker Track Rig		Date: July 7, 2014									
File Number: #923		Operator: Peter Michaud		Weather: Sun 80F									
Depth	Sample No. Depth (ft)	Blow Count	Sample Descriptions and Classifications	Remarks									
1	S-1 0.5' - 2.5'	9	Brown Sand and Gravel, trace silt. Fill. Dry.	4" Asphalt Cobble at 1'									
2		10											
3		16											
4		16											
5	S-2 5' - 7'	7	Brown Sandy Clay. Roots and organics. Fill. Moist.	Groundwater Encountered at 8.0'									
6		2											
7		1											
8		1											
9	S-3 5' - 7'	8	Gray Medium Sand, trace silt. Wood fragments. Fill.	Change to Silty Clay at 12.5' Solid stem augers to 10' 4" Casing to 13'. Drive and wash drilling.									
10		5											
11		4											
12		4											
13	S-4 13' - 15'	WOH / 2'		Gray Silty Clay.									
14		WOH / 2'											
15	T-1 15' - 17'	440 psf		Vane Shear 17' - 17.75'									
16						440 psf		Vane Shear 17.75' - 18.5'					
17										450 psf		Vane Shear 20' - 20.75'	
18													
19	450 psf		Vane Shear 20.75' - 21.5'										
20					450 psf		Vane Shear 20.75' - 21.5'						
21									450 psf		Vane Shear 20.75' - 21.5'		
22													450 psf
23	450 psf		Vane Shear 20.75' - 21.5'										
24					450 psf		Vane Shear 20.75' - 21.5'						
25									450 psf		Vane Shear 20.75' - 21.5'		
26													450 psf
27	450 psf		Vane Shear 20.75' - 21.5'										
28					450 psf		Vane Shear 20.75' - 21.5'						
29									450 psf		Vane Shear 20.75' - 21.5'		
30													450 psf
31	450 psf		Vane Shear 20.75' - 21.5'										
32					450 psf		Vane Shear 20.75' - 21.5'						
33									450 psf		Vane Shear 20.75' - 21.5'		
34													450 psf
35	450 psf		Vane Shear 20.75' - 21.5'										
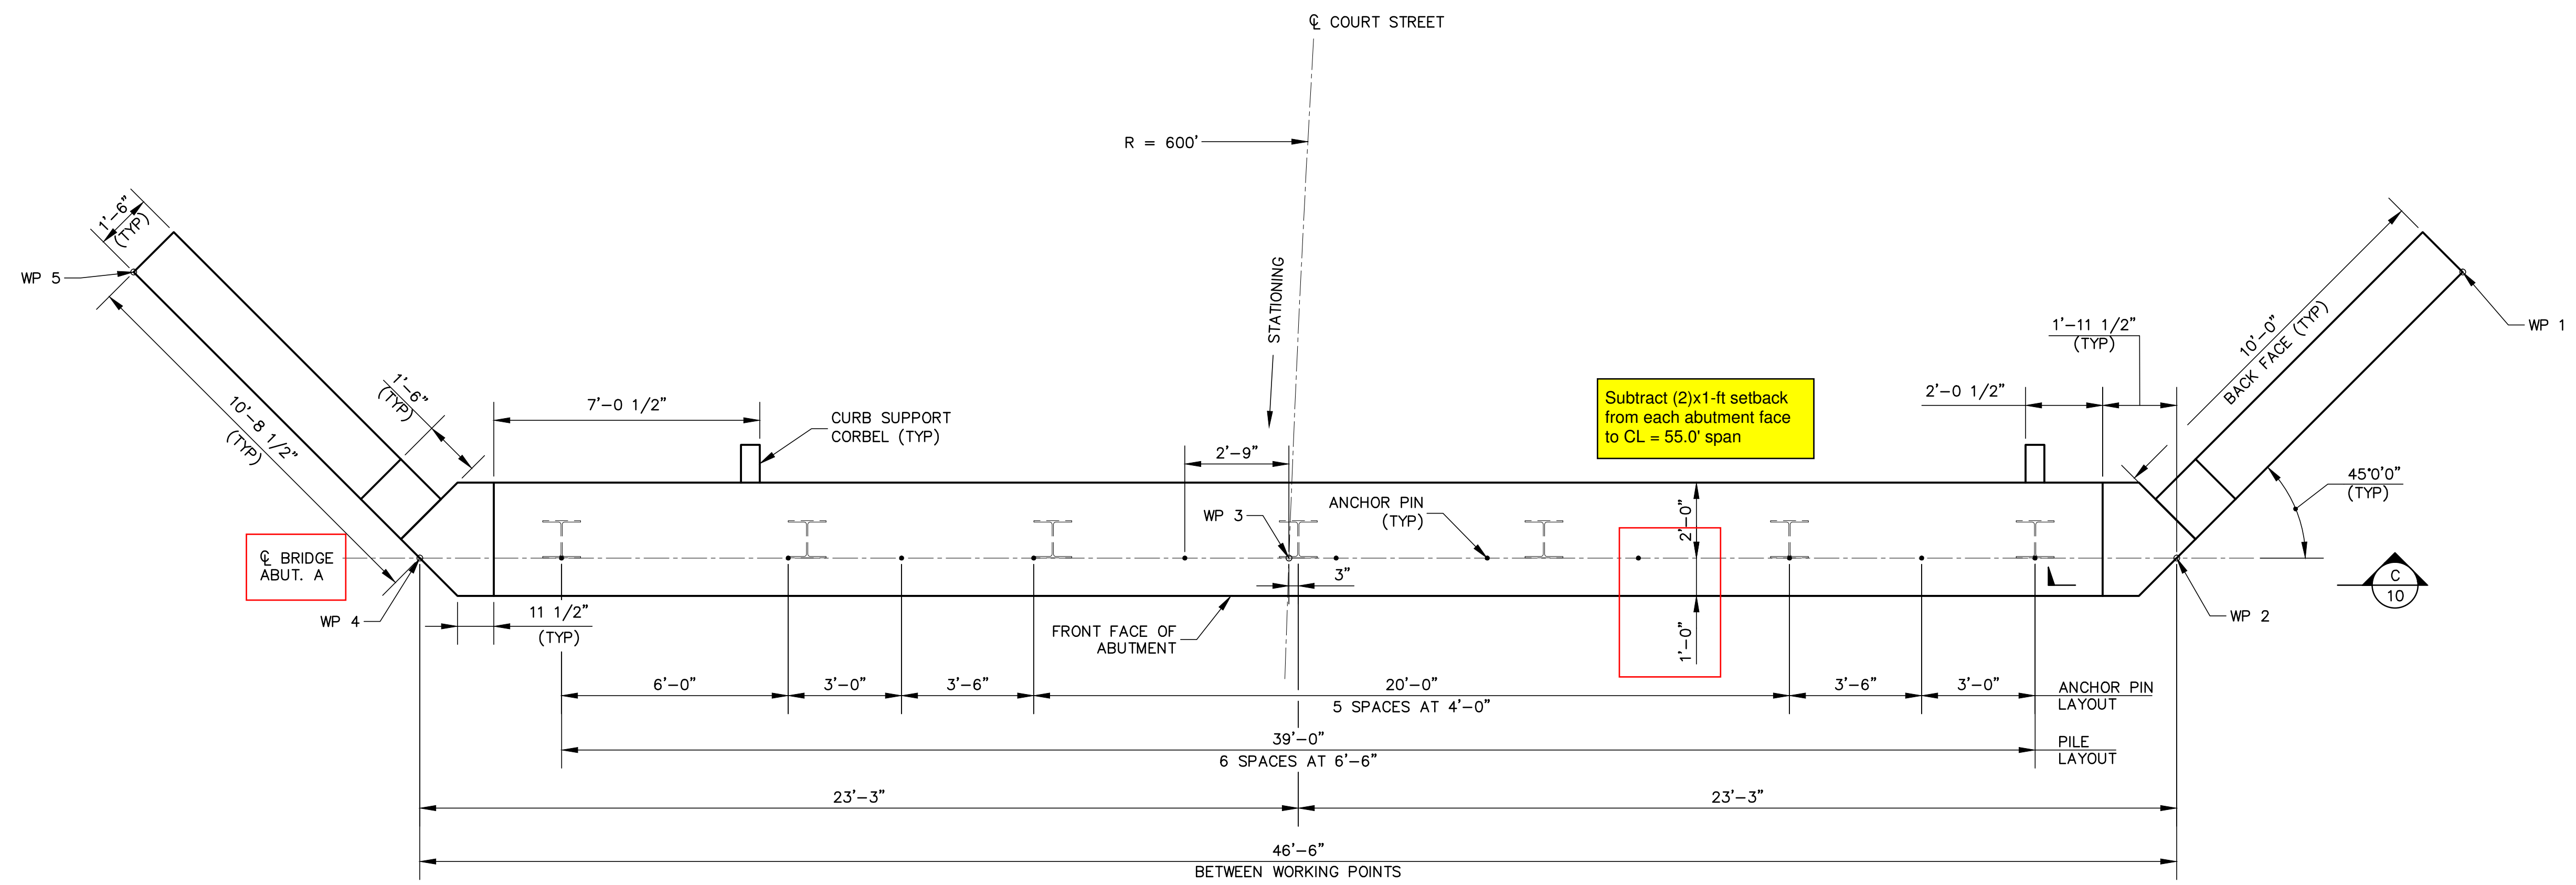

Abutment A Plan


Scale: 3/8"=1'-0"

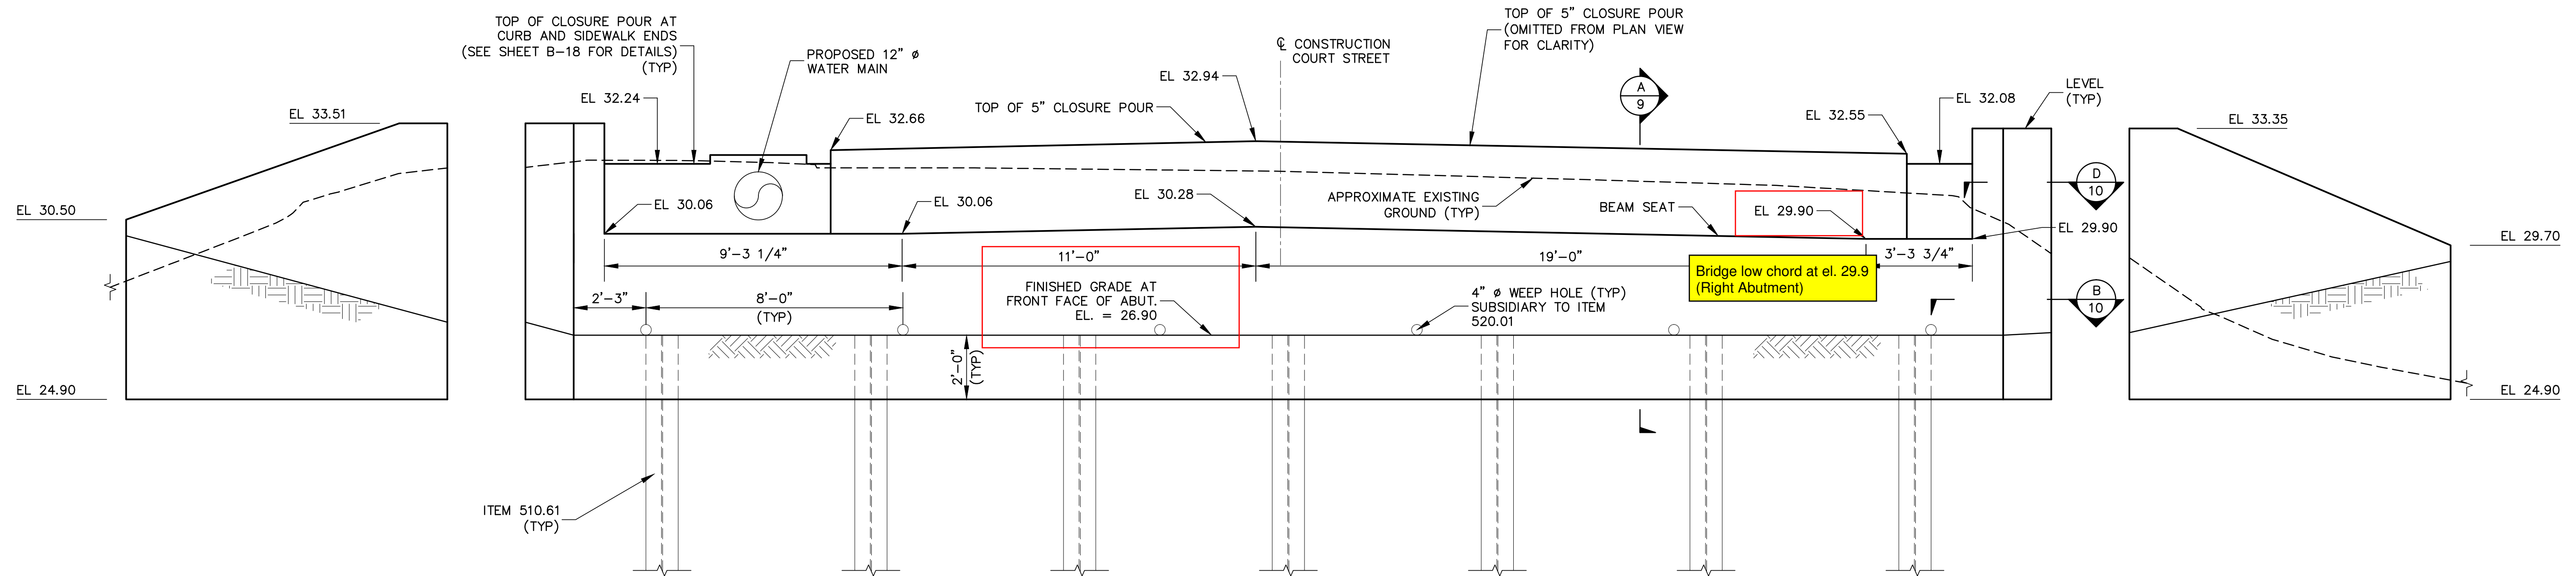


Abutment A Elevation

Scale: 3/8"=1'-0"


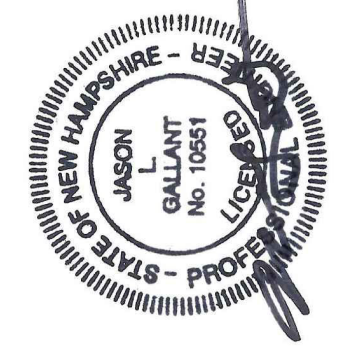
		6/13/17 date	JLG by
ISSUED FOR CONSTRUCTION no.		revision	
PORTSMOUTH, NH • 603/431-6196 MANCHESTER, NH • 603/627-0708 PORTLAND, ME • 207/541-4223 c m a e n g i n e e r s . c o m		A	
designed by: LBK/OGK	date: June 2017	drawn by: LBK/BGP	approved by: JLG
project no.: S-7 & S-9.dwg	file name: S-7 & S-9.dwg	scale: D 10 B 10	
Town of Exeter Department of Public Works Court Street Little River Bridge Replacement Abutment A Plan and Elevation			
drawing no. B-7			
sheet: 8 of 34			


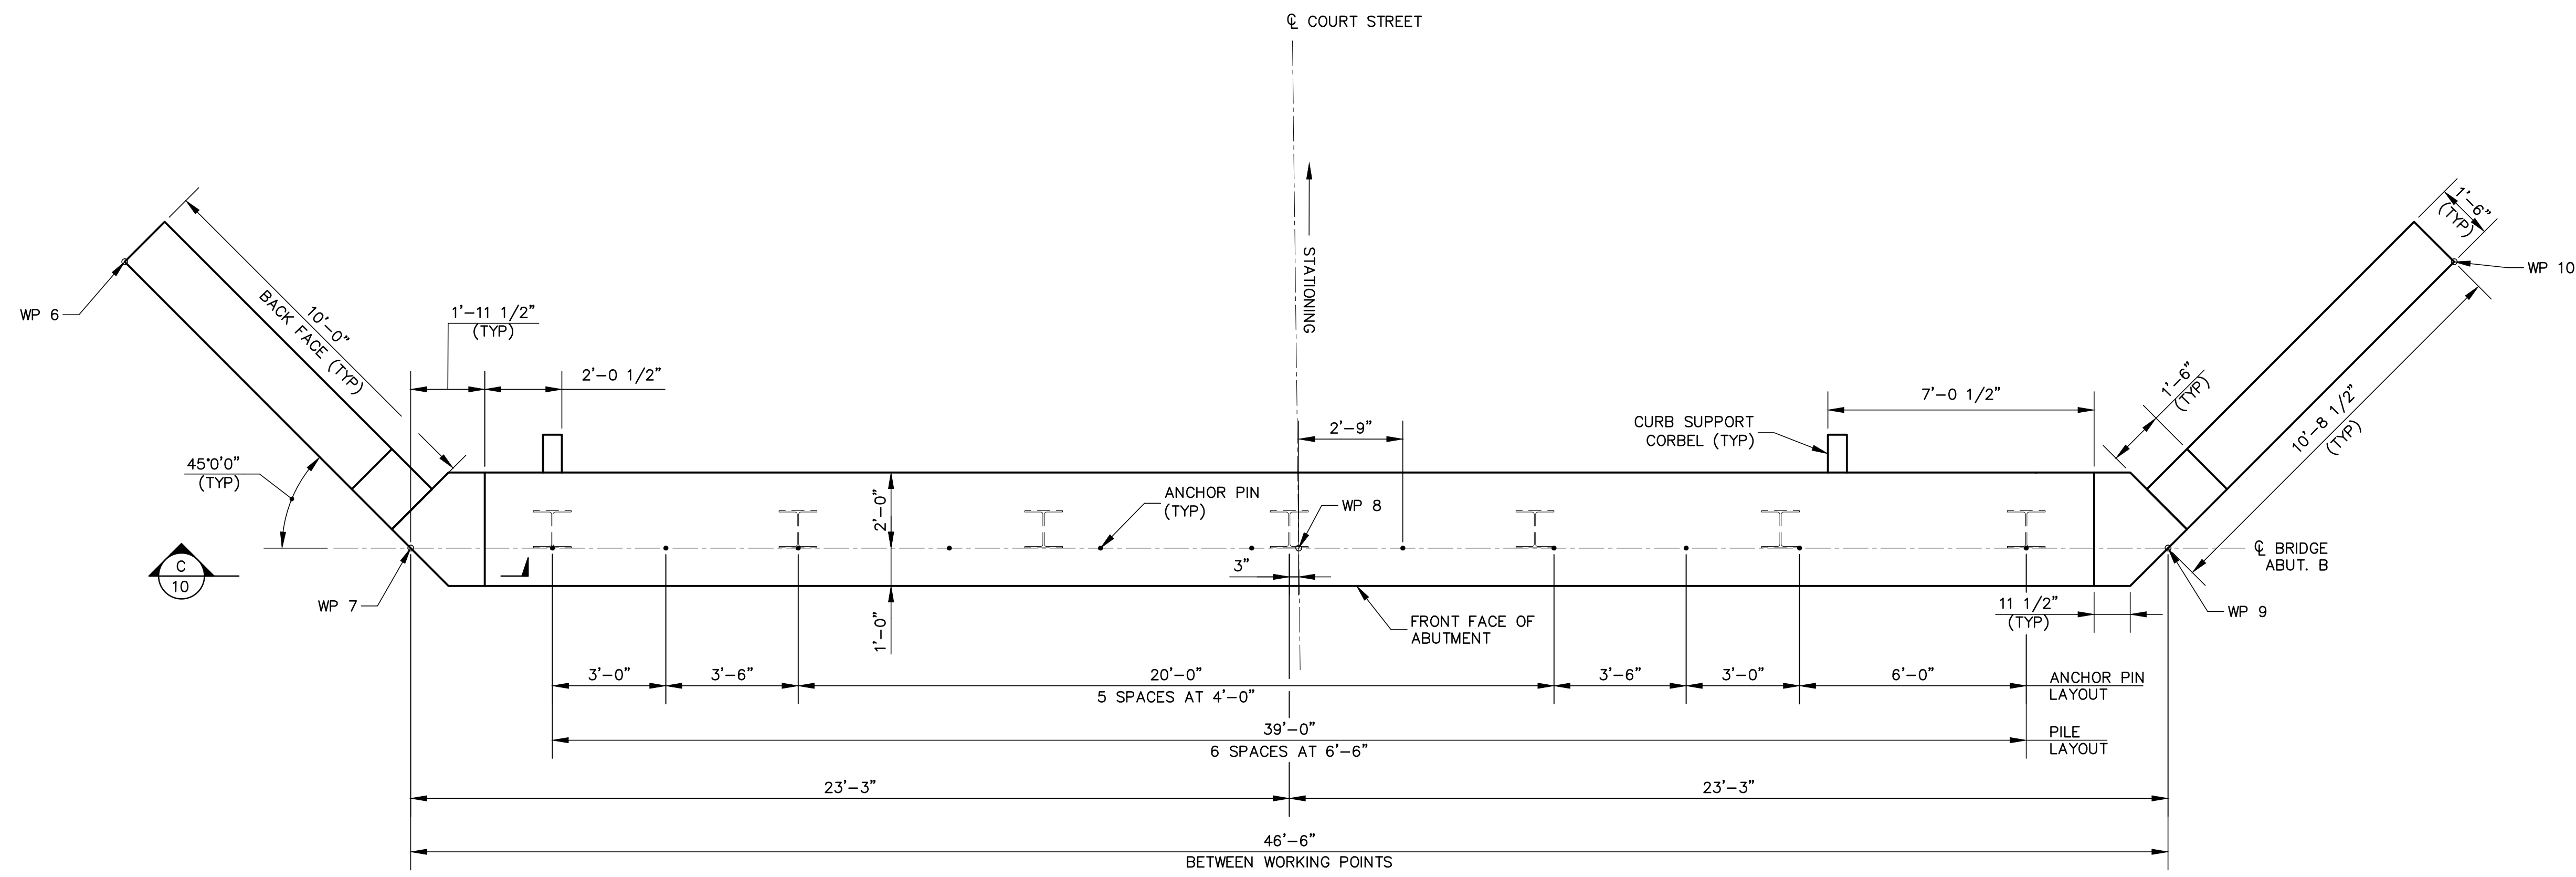


Abutment B Plan
Scale: 3/8" = 1'-0"

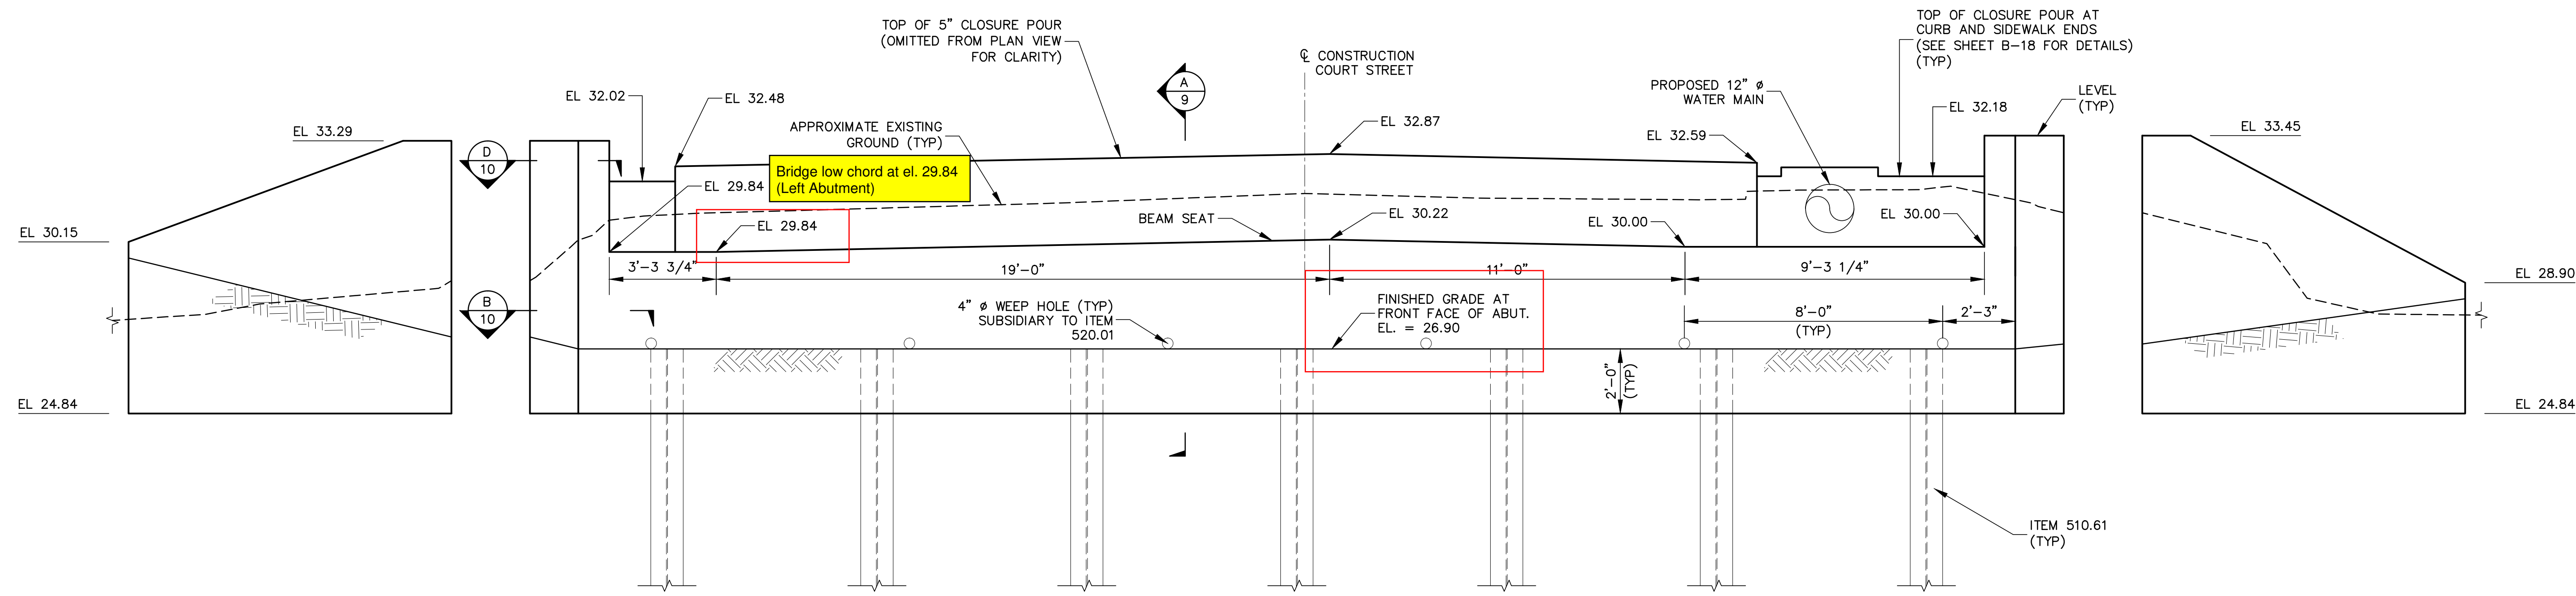


Abutment B Elevation
Scale: 3/8" = 1'-0"

 CIVIL/ENVIRONMENTAL/STRUCTURAL Portsmouth, NH • Manchester, NH • Portland, ME 603/431-6196 • 603/627-0708 • 207/541-4223 c m a a e n g i n e e r s . c o m		ISSUED FOR CONSTRUCTION A no.	6/13/17 JLG date by
		designed by: LBK/OGK date: June 2017	drawn by: LBK/BGP project no.:
Town of Exeter Department of Public Works Court Street Little River Bridge Replacement Abutment B Plan and Elevation		approved by: JLG file name: S-7 & S-9.dwg	scale:
drawing no. B-8		sheet: 9 of 34	

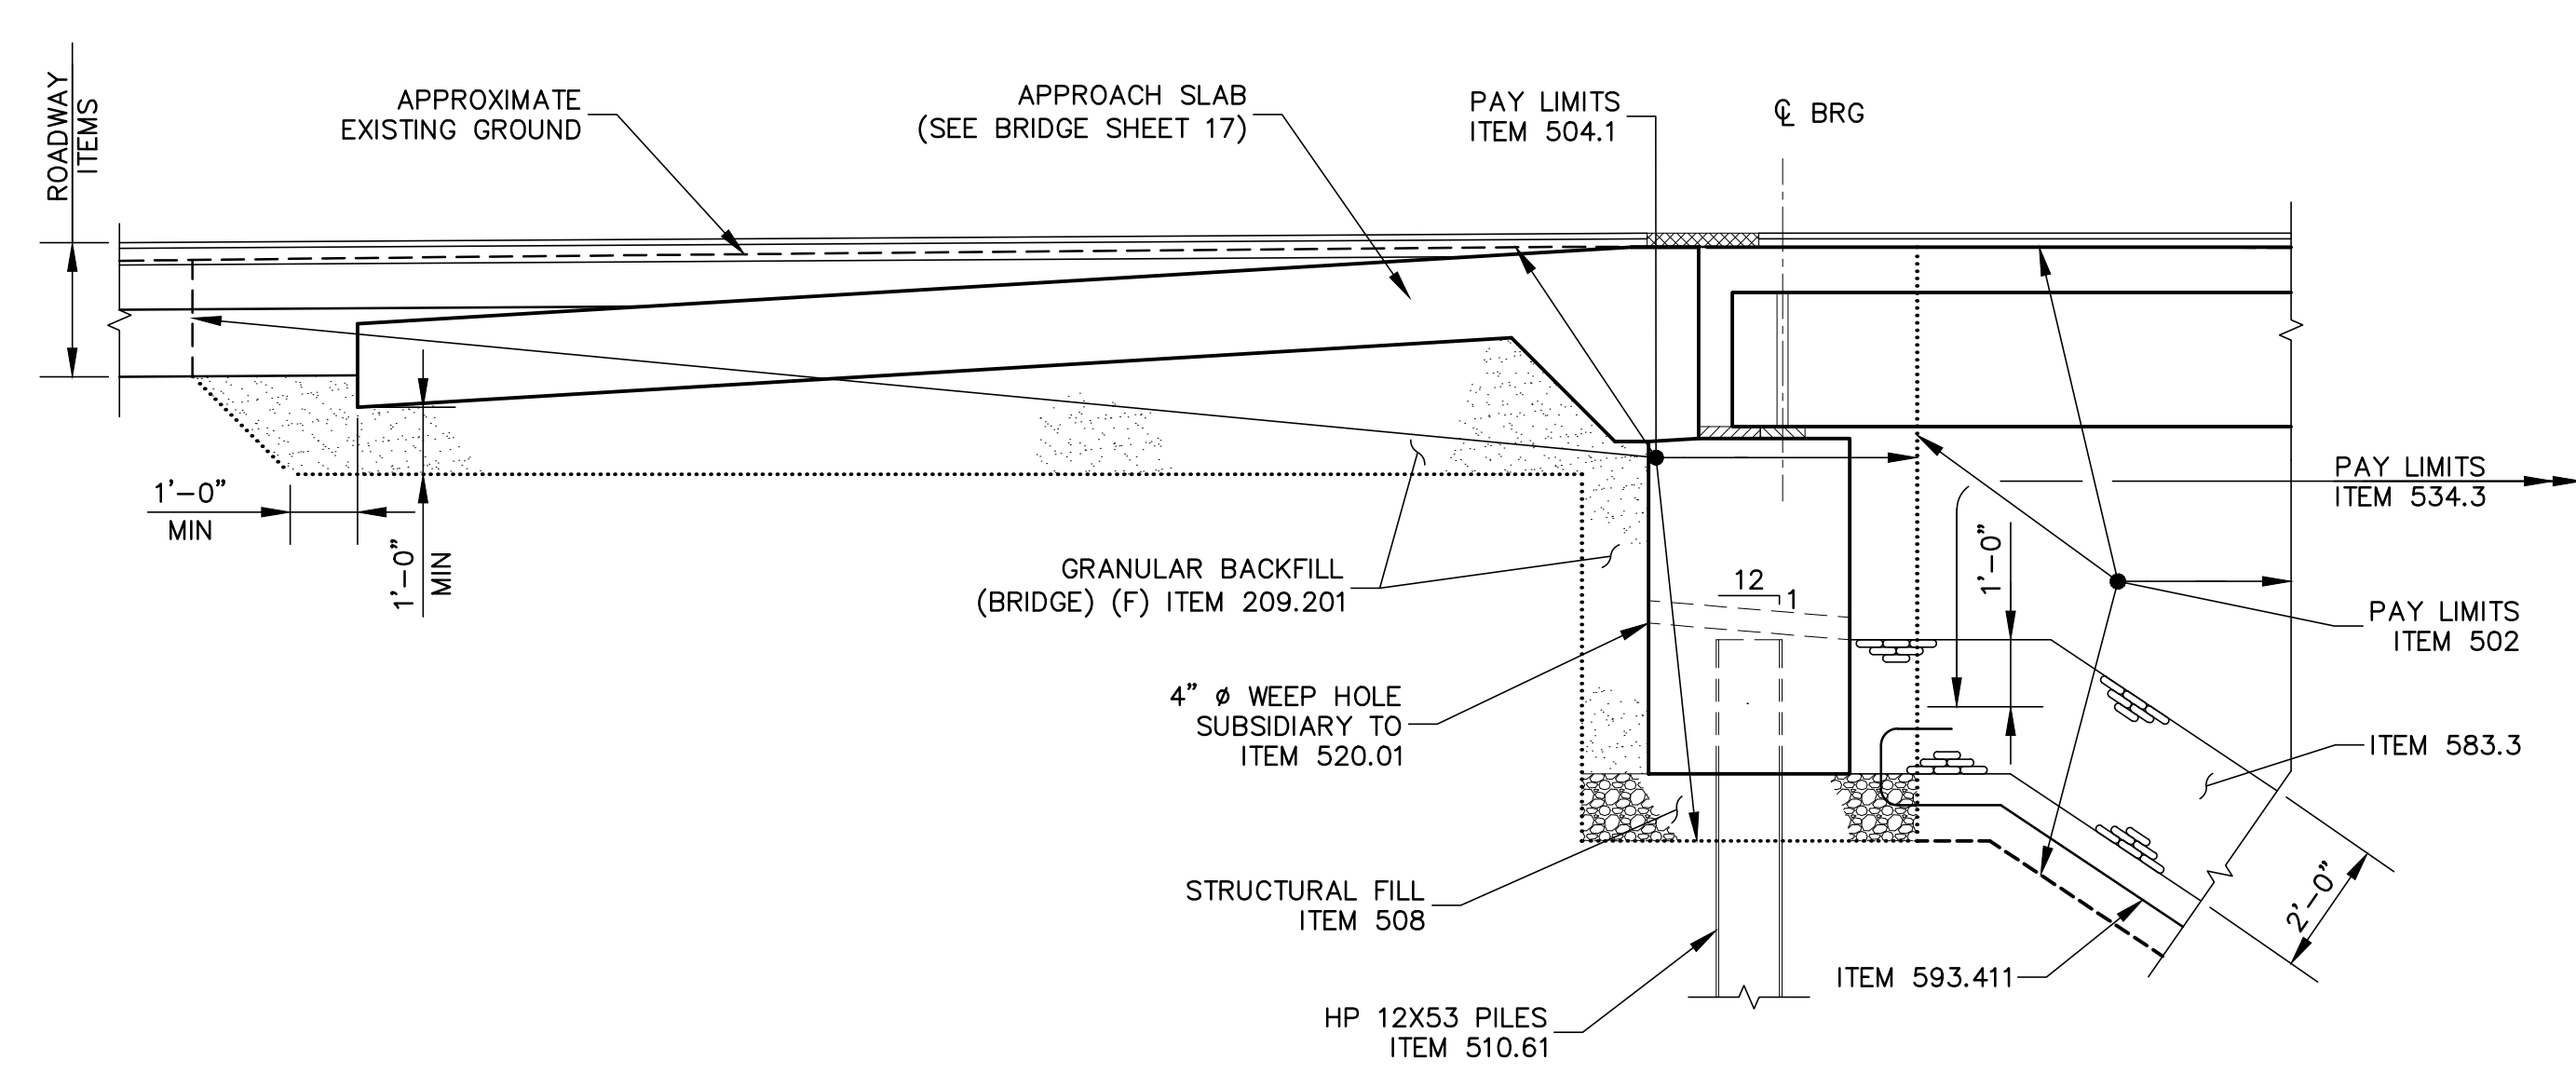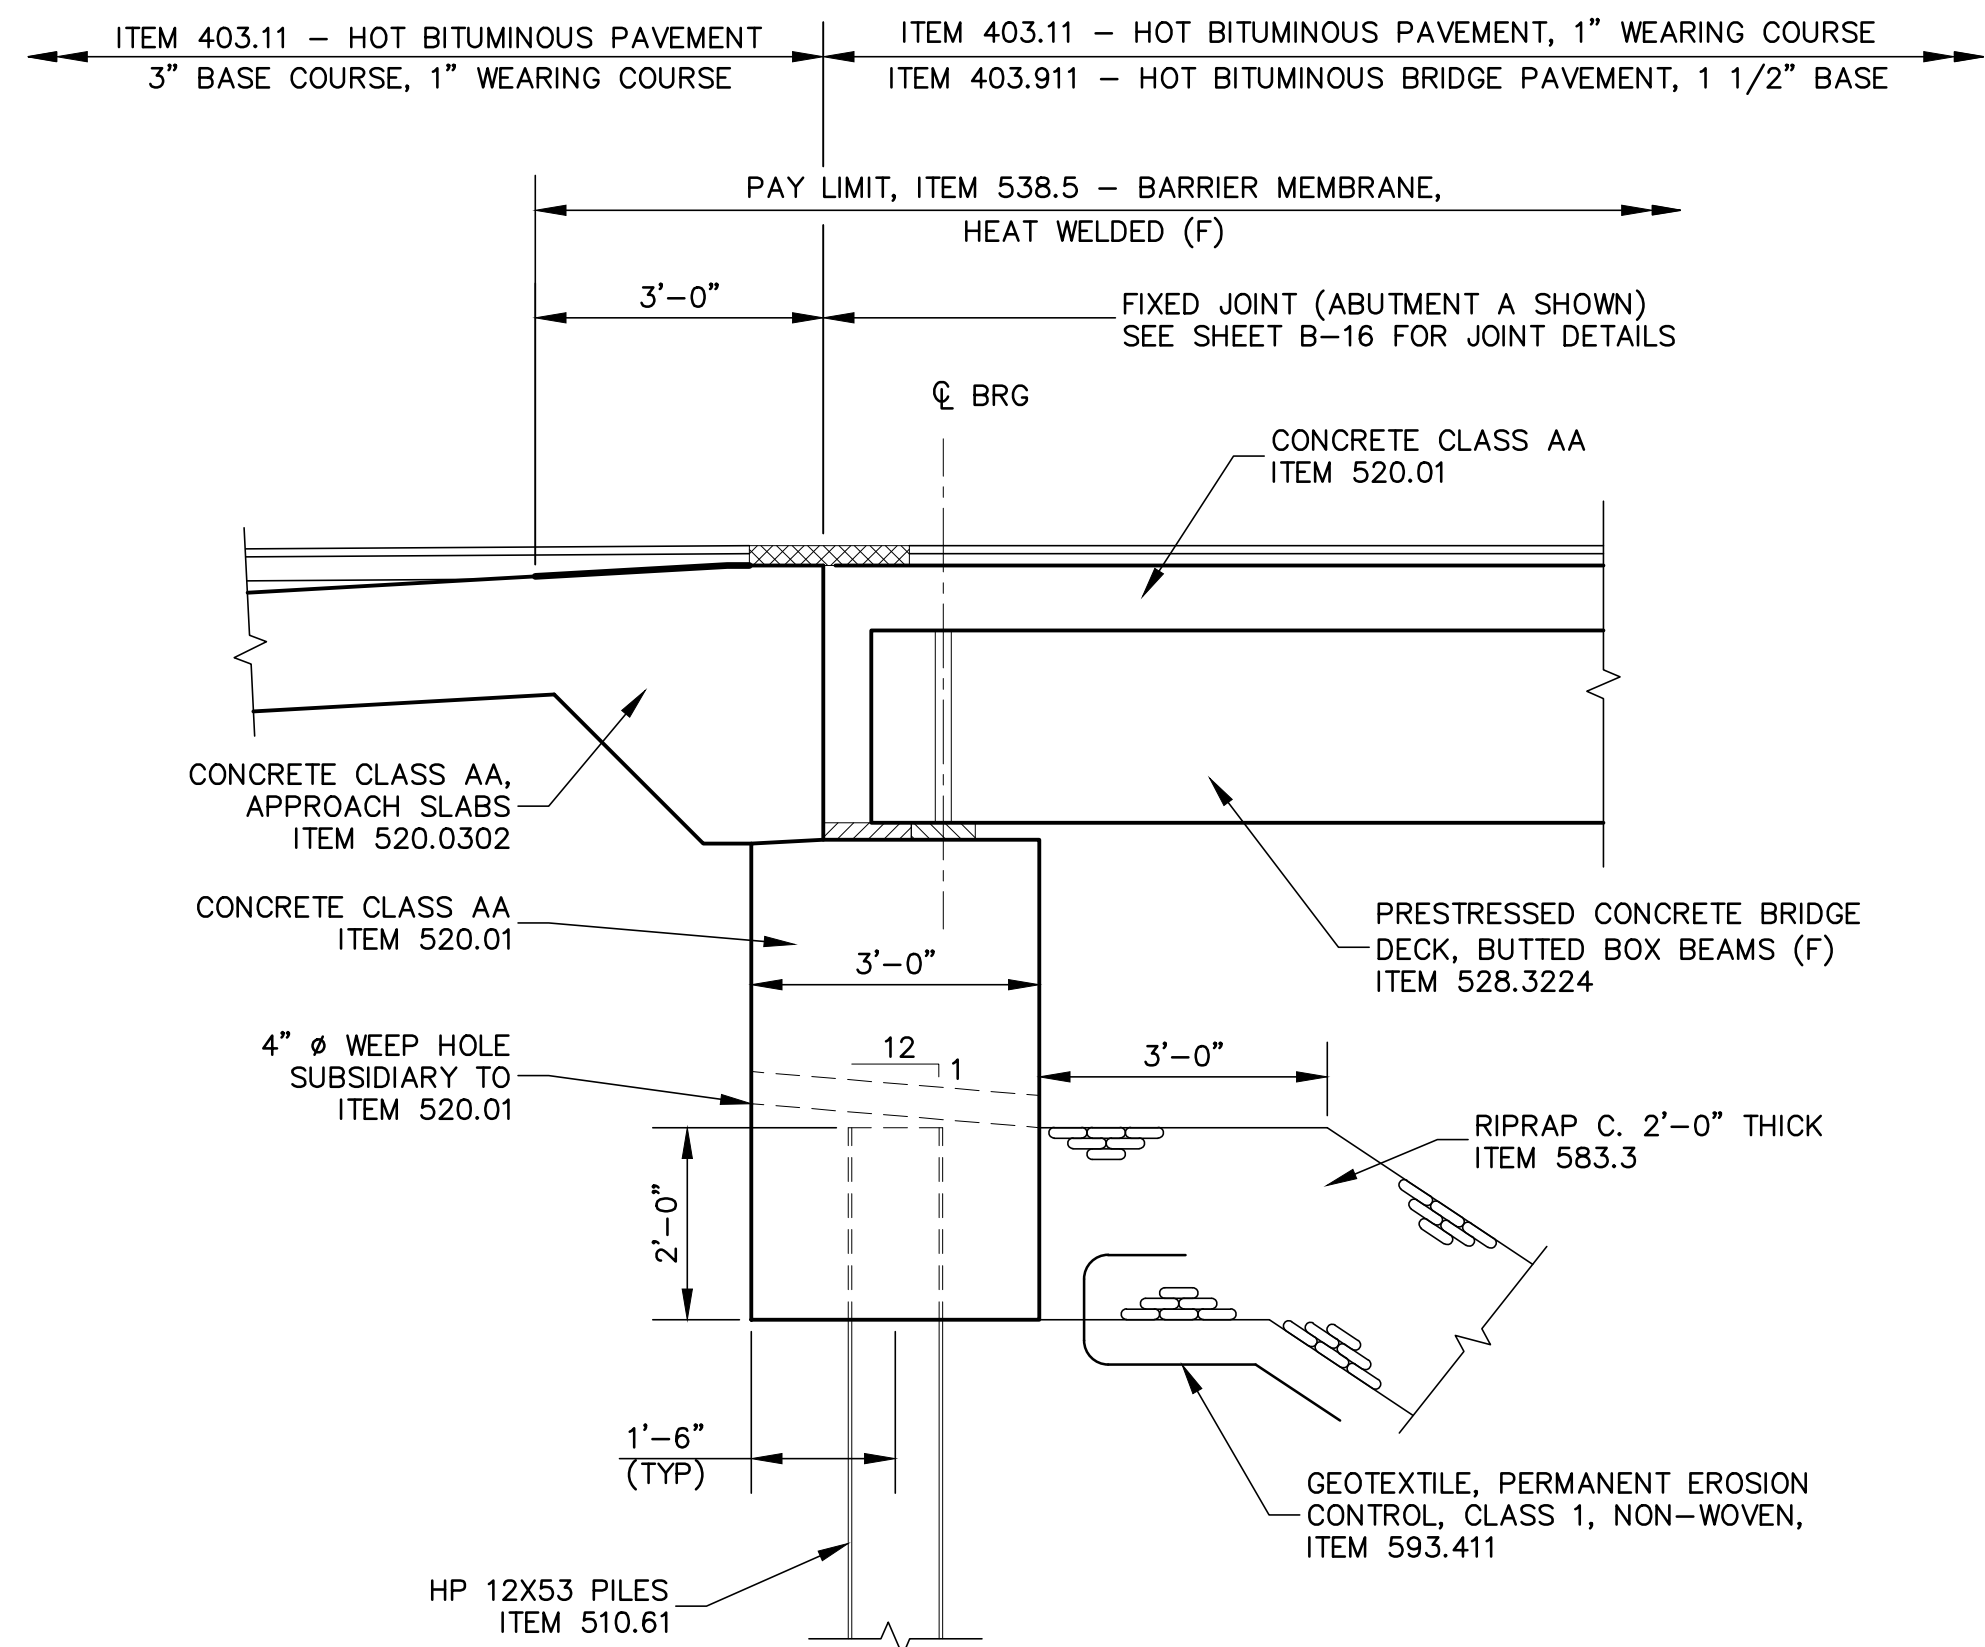


Typical Abutment Section
Scale: 3/8" = 1'-0"


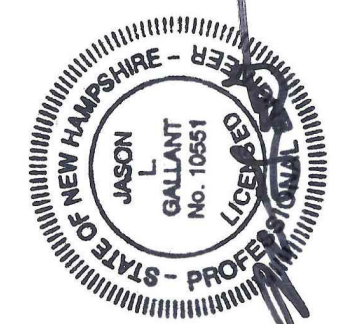
Section A-A
Scale: 1/2" = 1'-0"

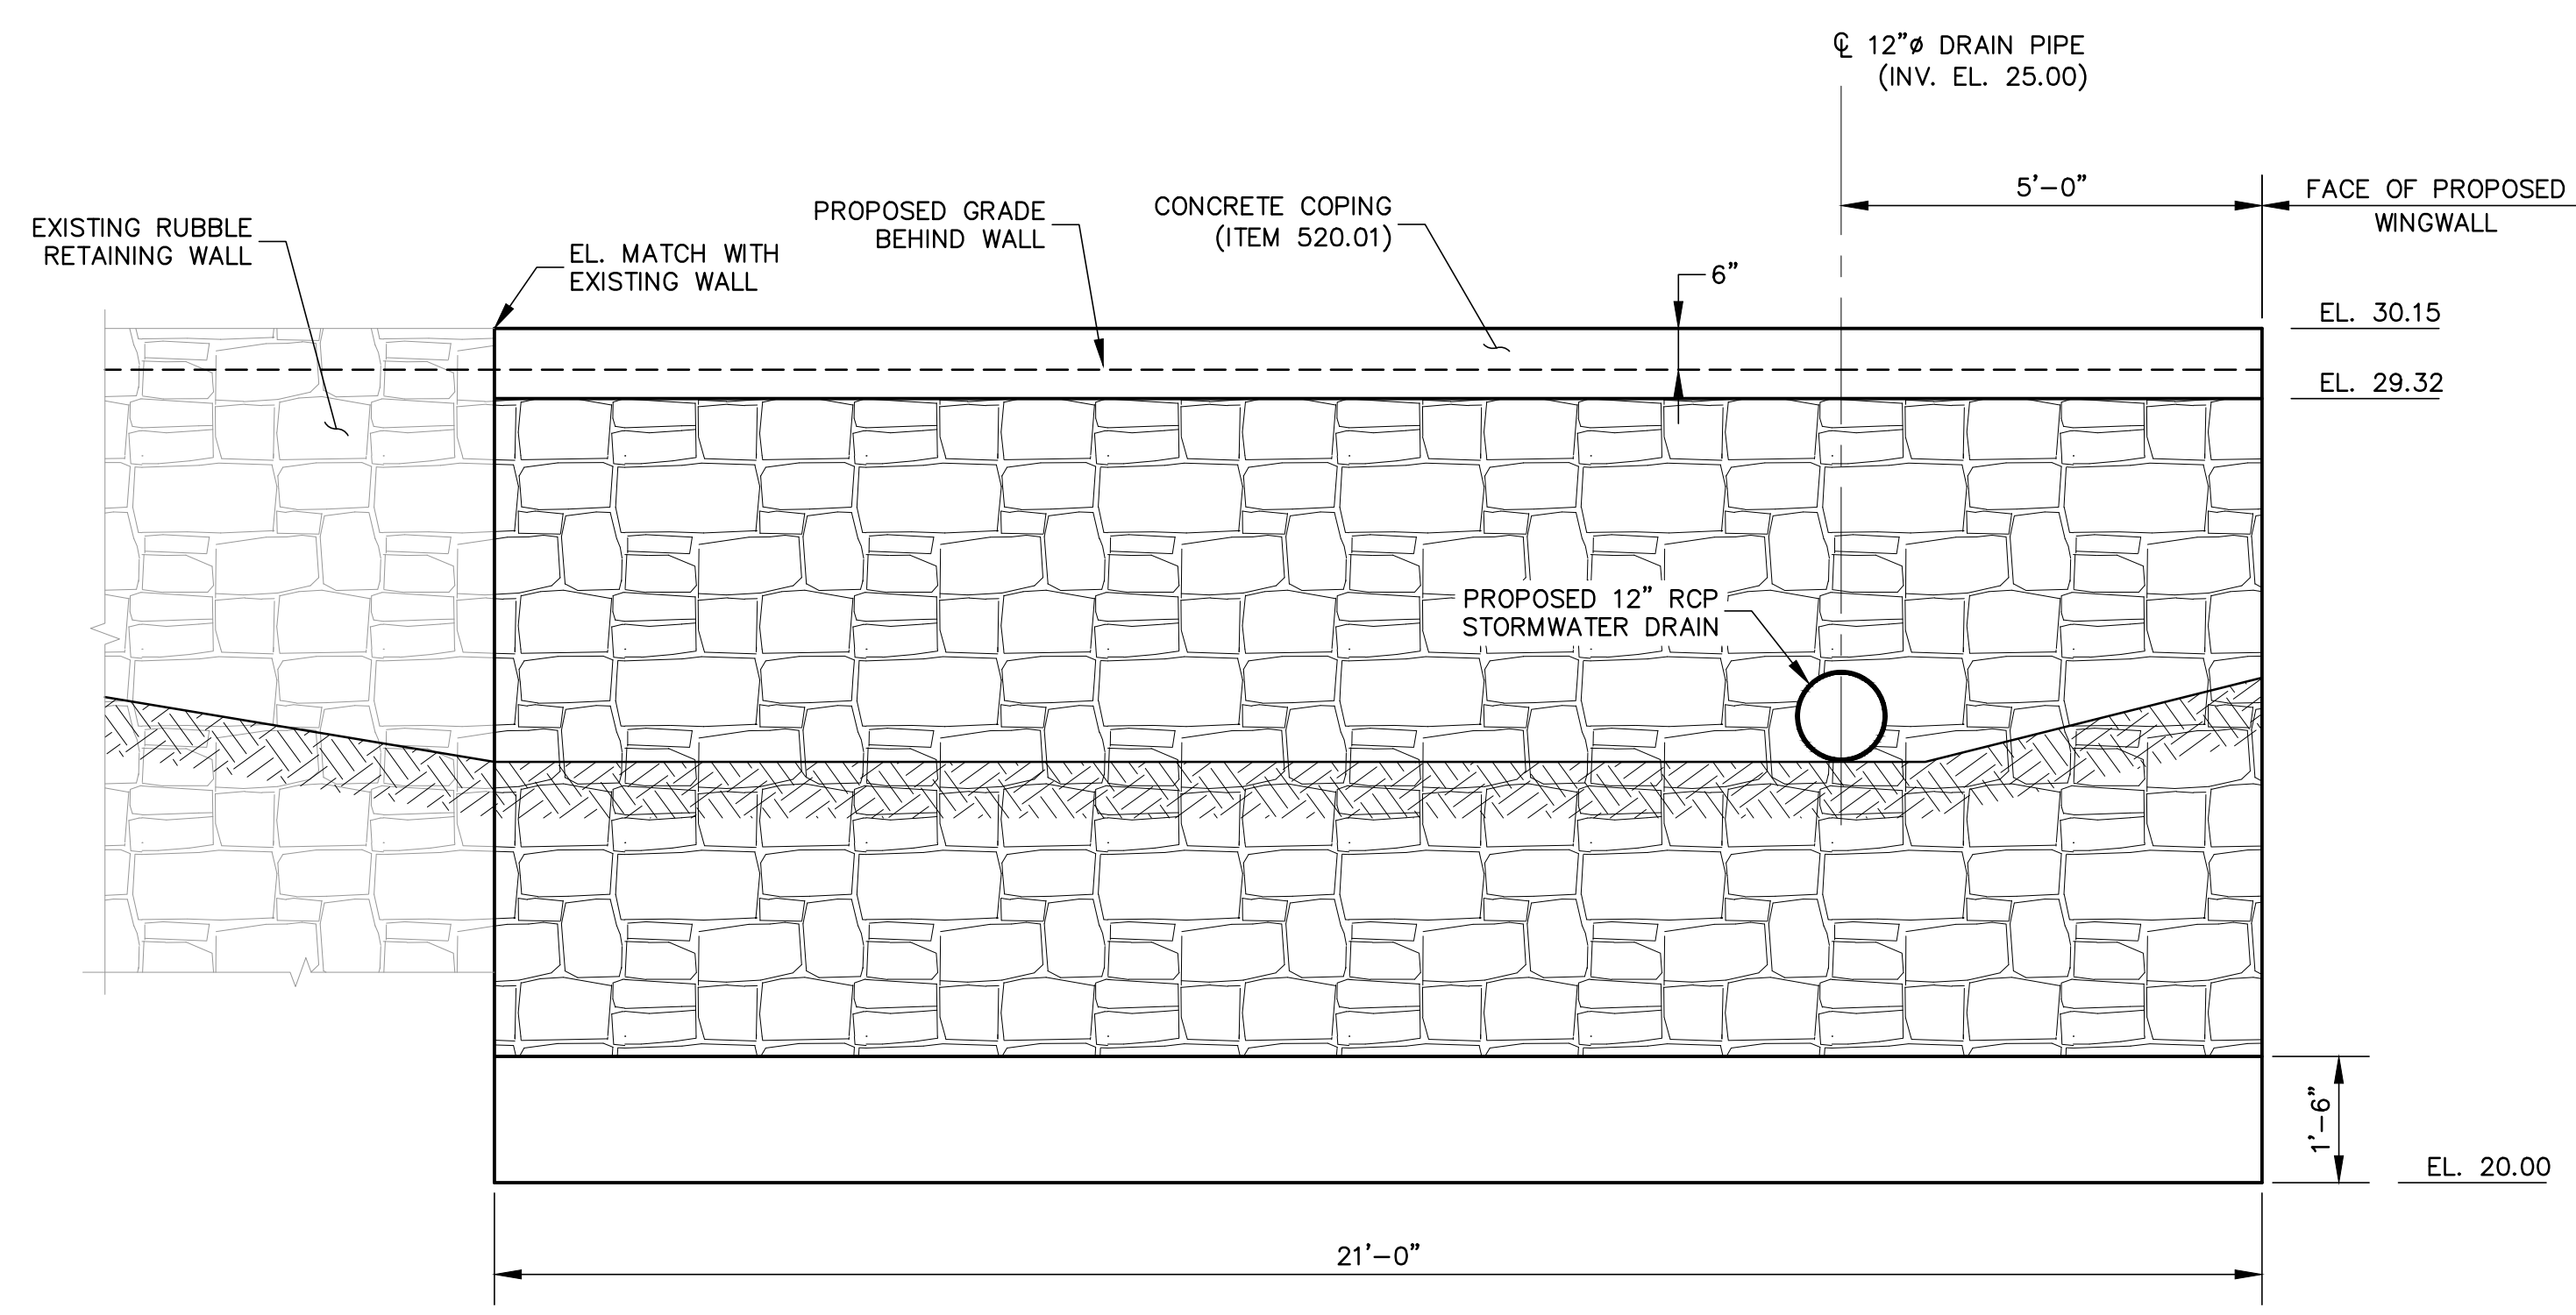


Mortar Rubble Masonry Wall Elevation
Scale: 1/2" = 1'-0"

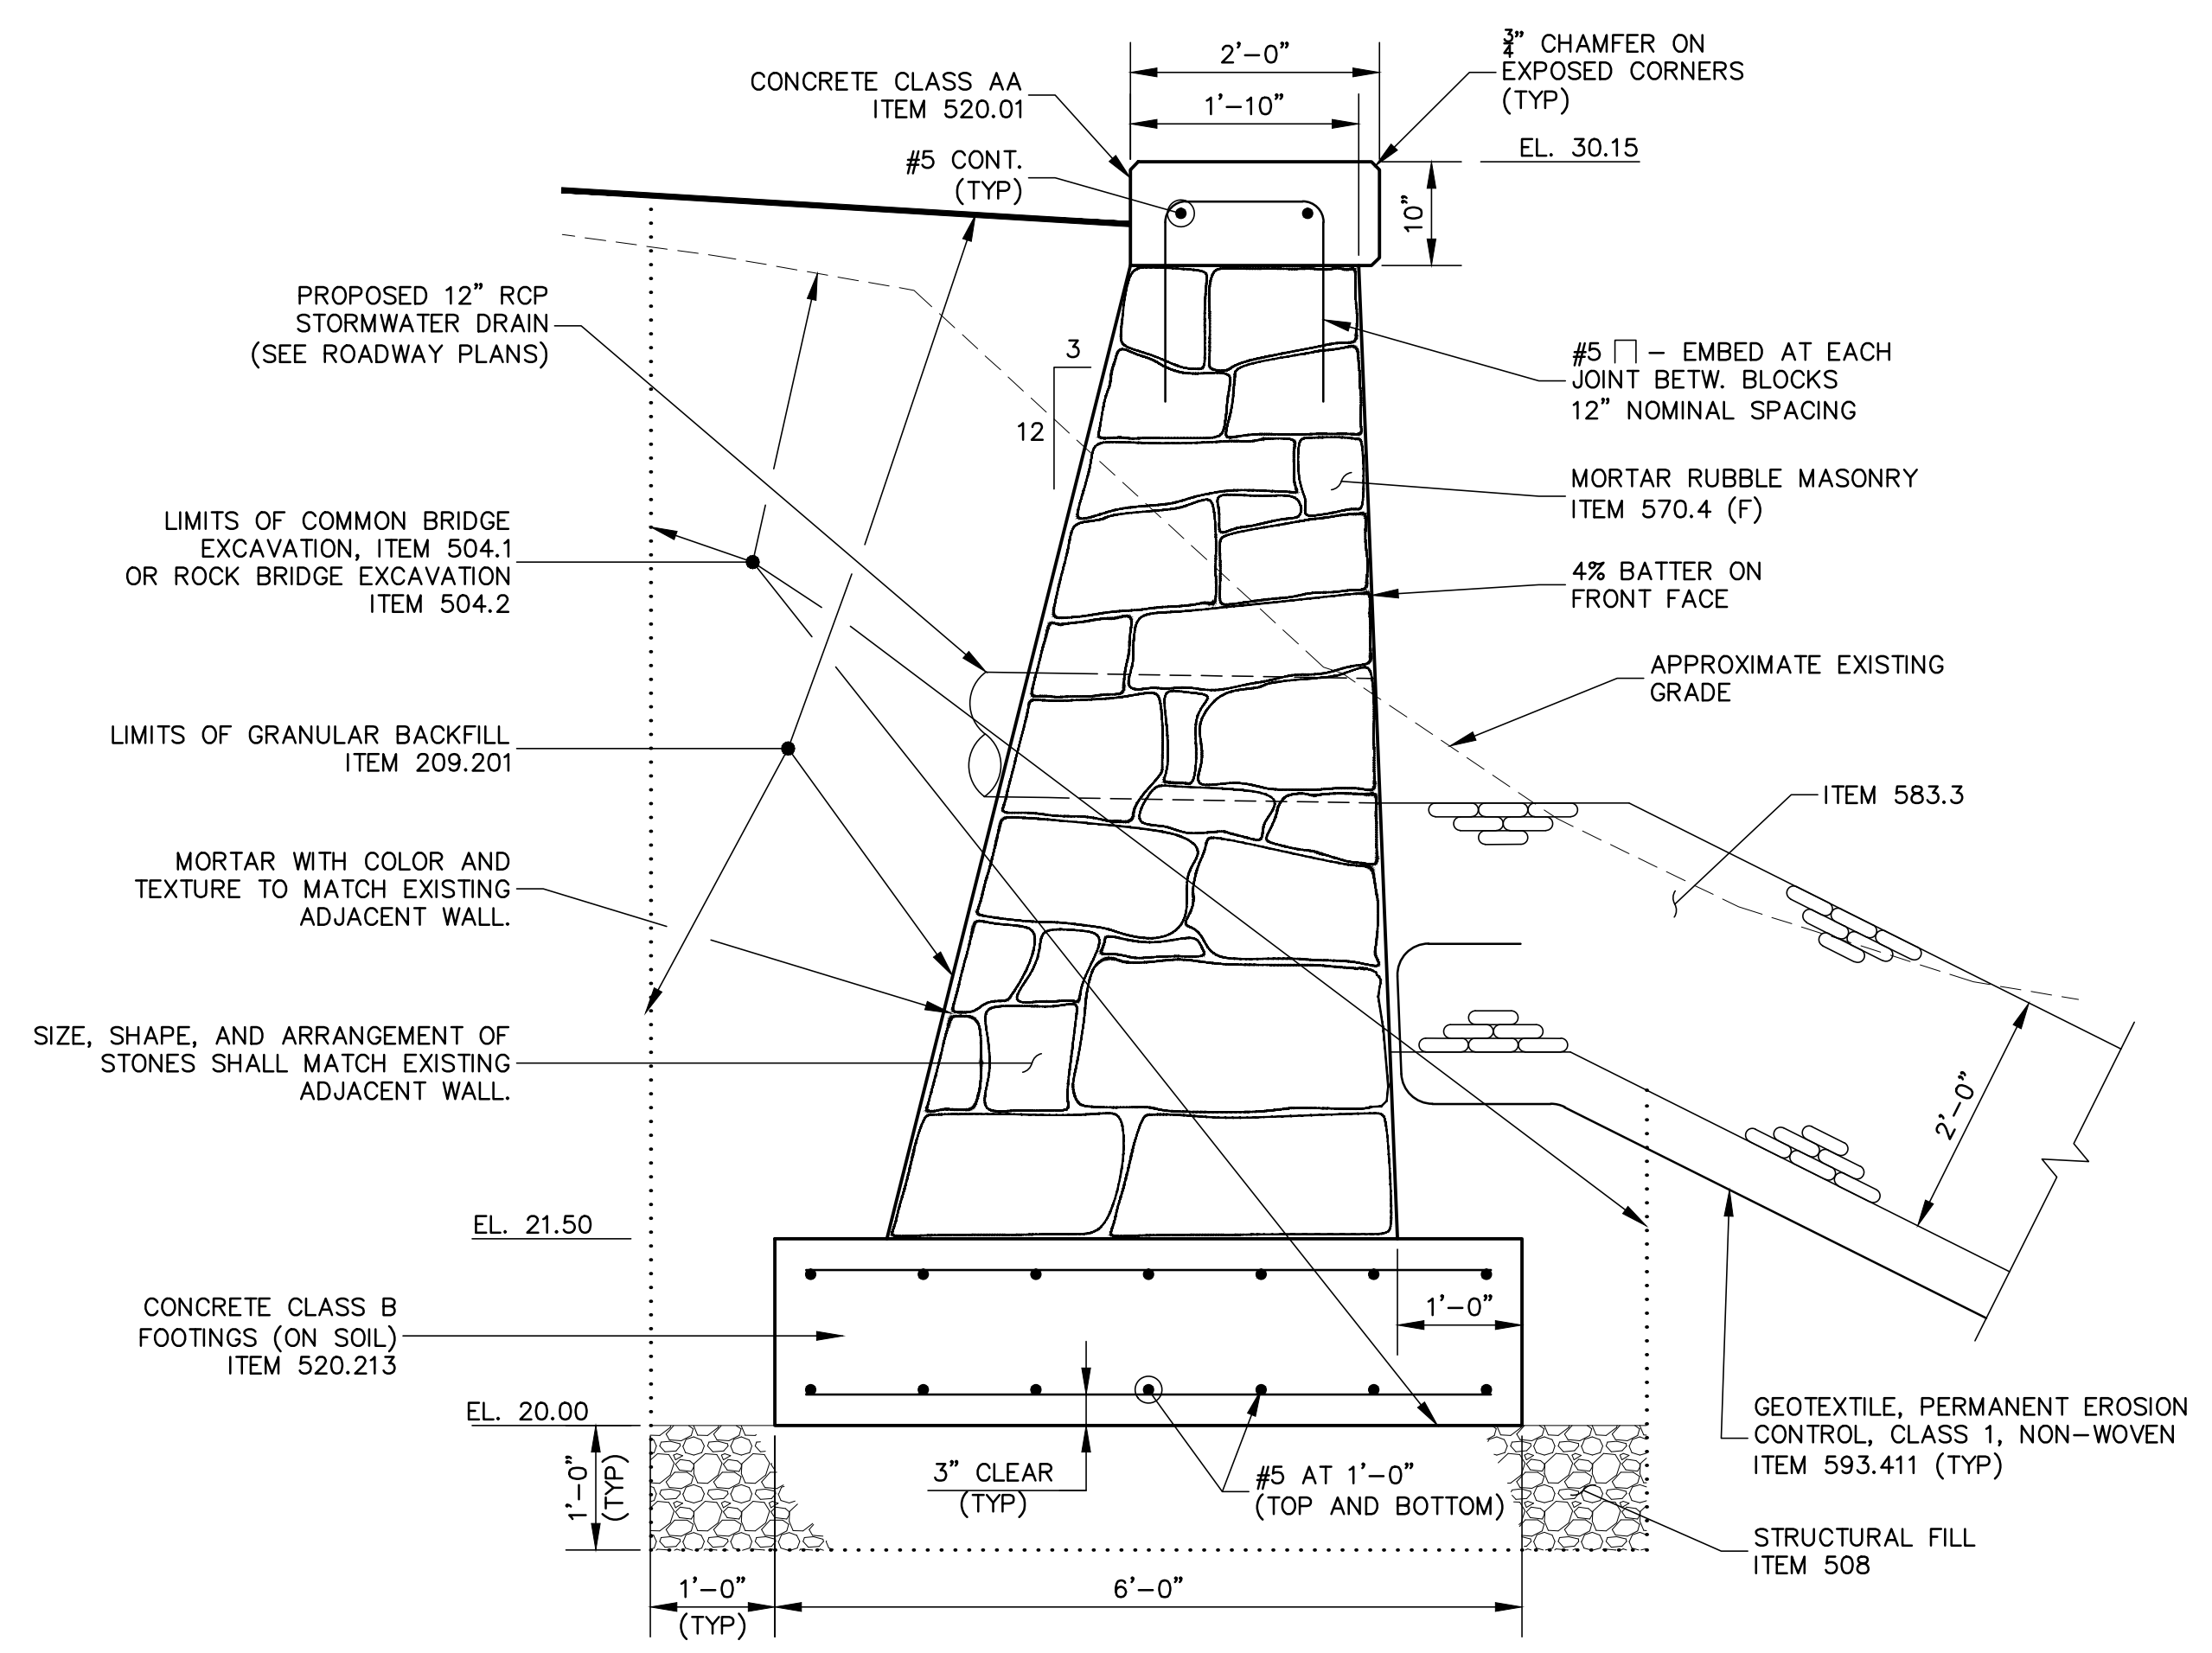


Mortar Rubble Masonry Wall Section
Scale: 3/4" = 1'-0"

 <p>Civil/Environmental/Structural</p> <p>Portland, ME 603/431-6196 Manchester, NH 603/627-0708 Portland, ME 207/541-4223</p> <p style="text-align: right;">c m a a e n g i n e e r s . c o m</p>	<p>ISSUED FOR CONSTRUCTION</p> <p>no. A</p> <p>date 6/13/17</p> <p>by JLG</p>
	<p>designed by: LBK/OGK</p> <p>drawn by: LBK/BGP</p> <p>approved by: JLG</p> <p>date: June 2017</p> <p>project no: 17-000</p> <p>file name: S-7 & S-9.dwg</p> <p>scale:</p>
<p>Town of Exeter Department of Public Works Court Street Little River Bridge Replacement Abutment Sections</p>	
<p>drawing no. B-9</p> <p>sheet: 10 of 34</p>	

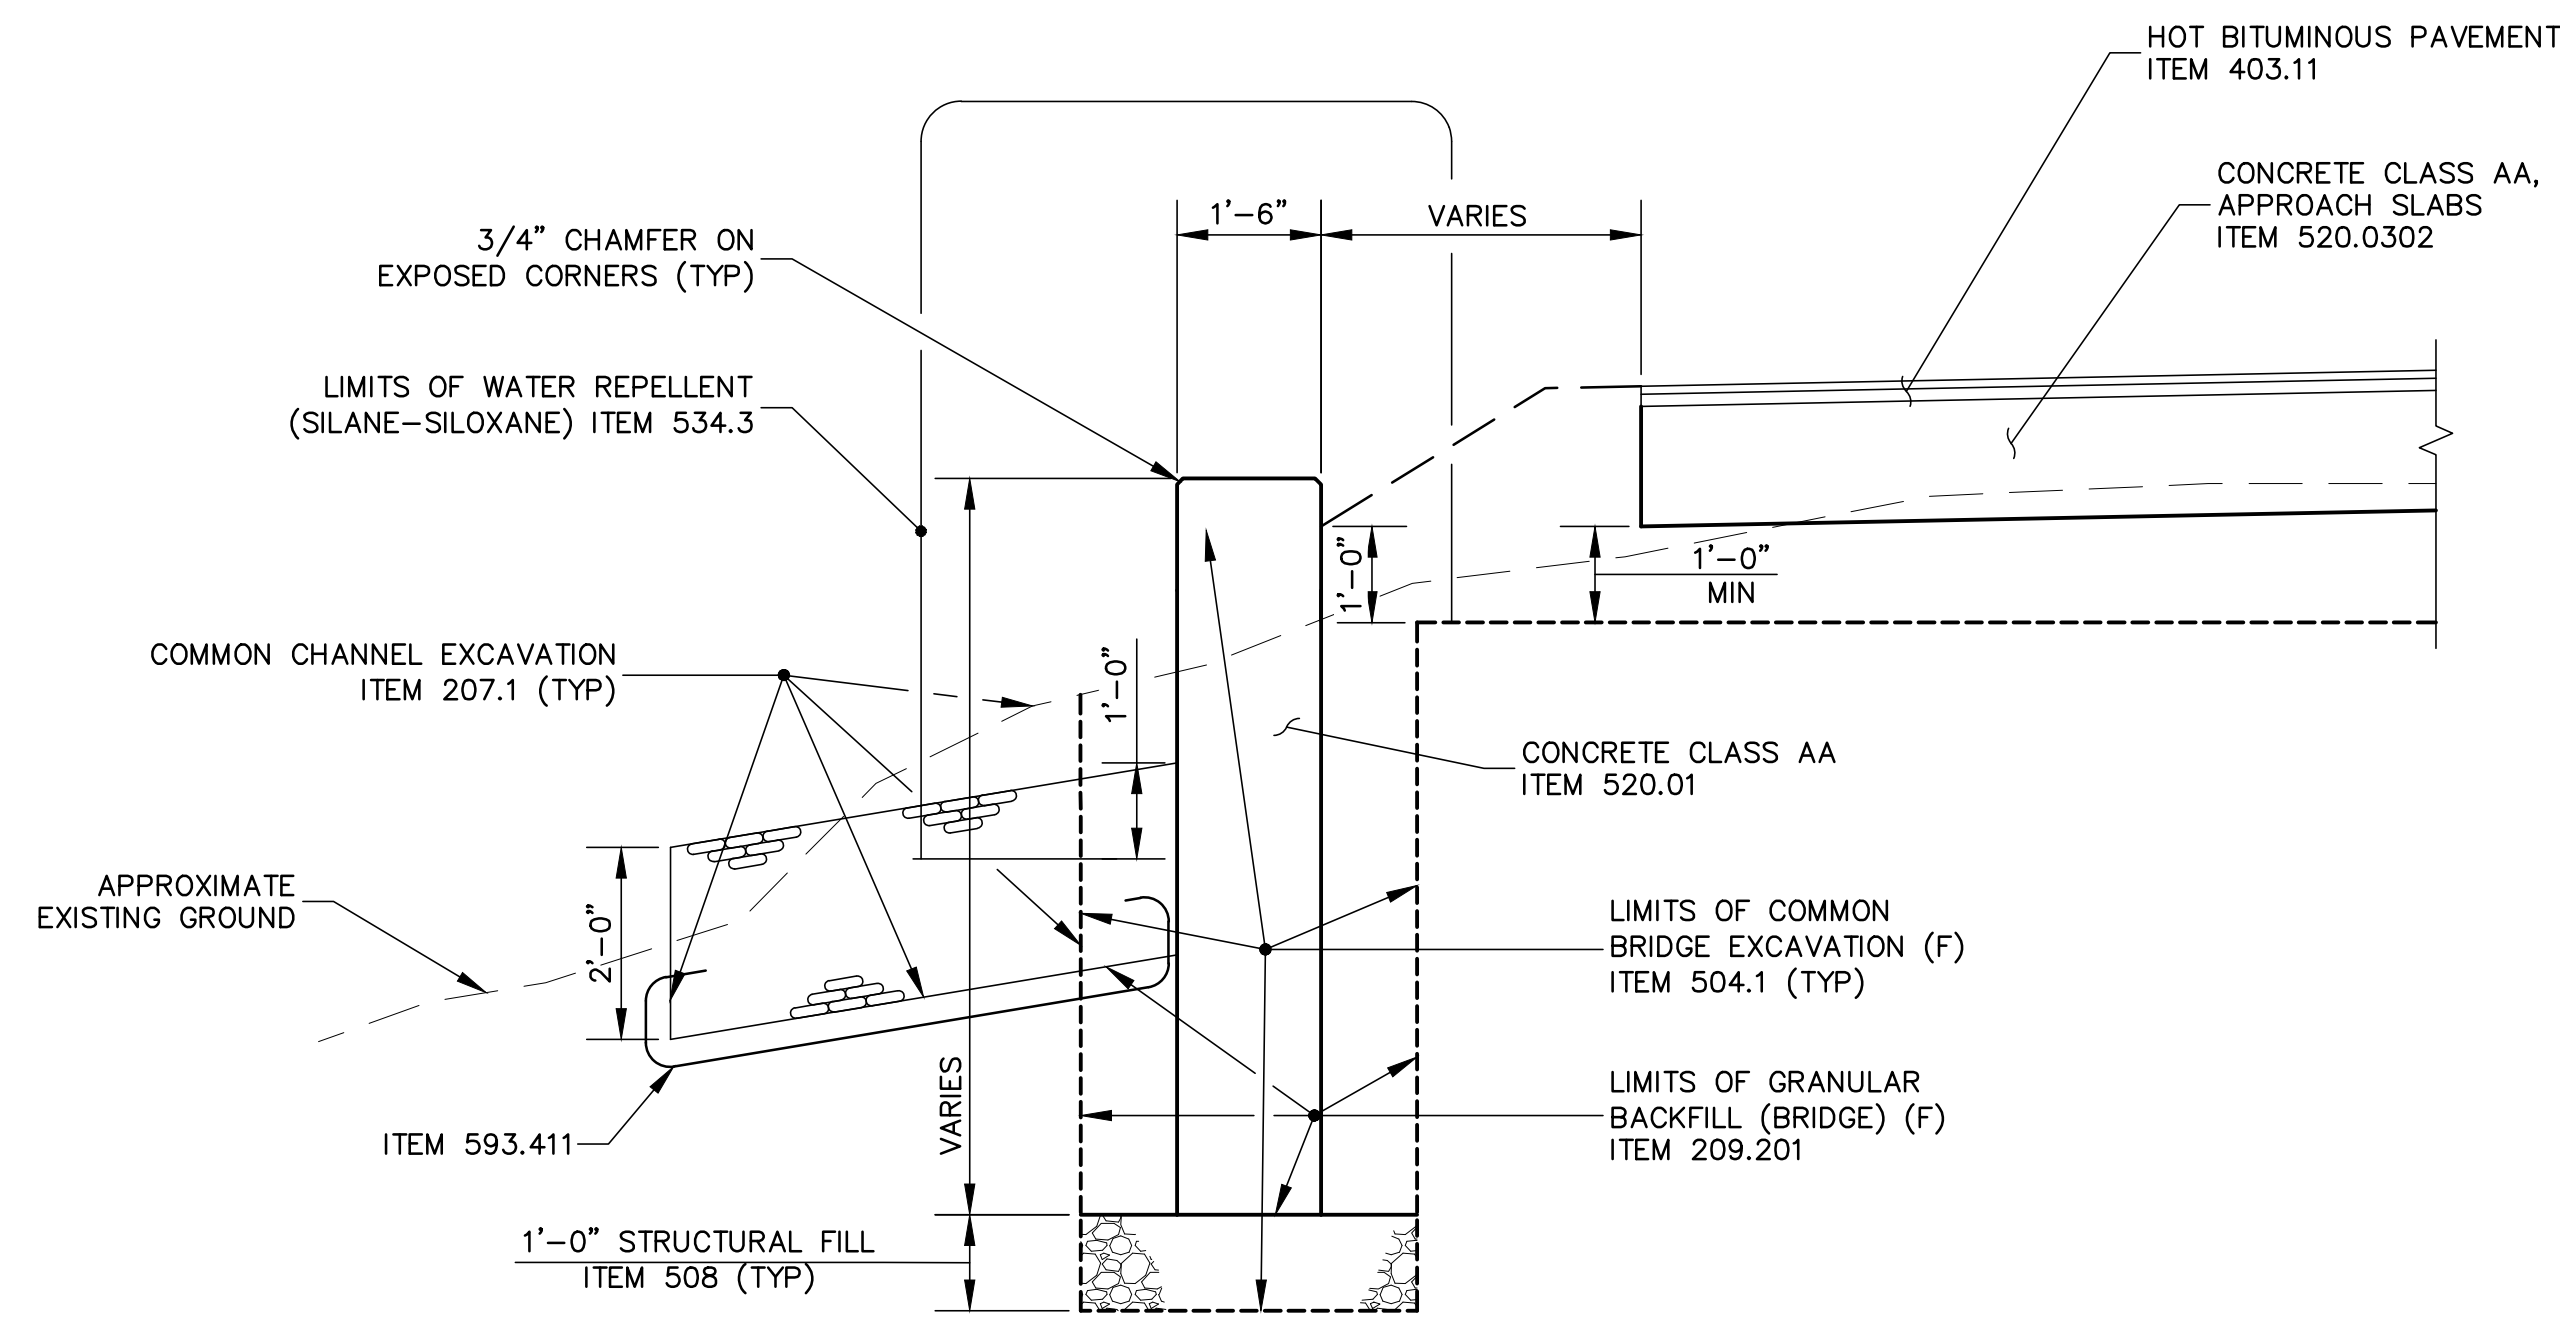


Typical Wingwall Section

Scale: 1/2"=1'-0"

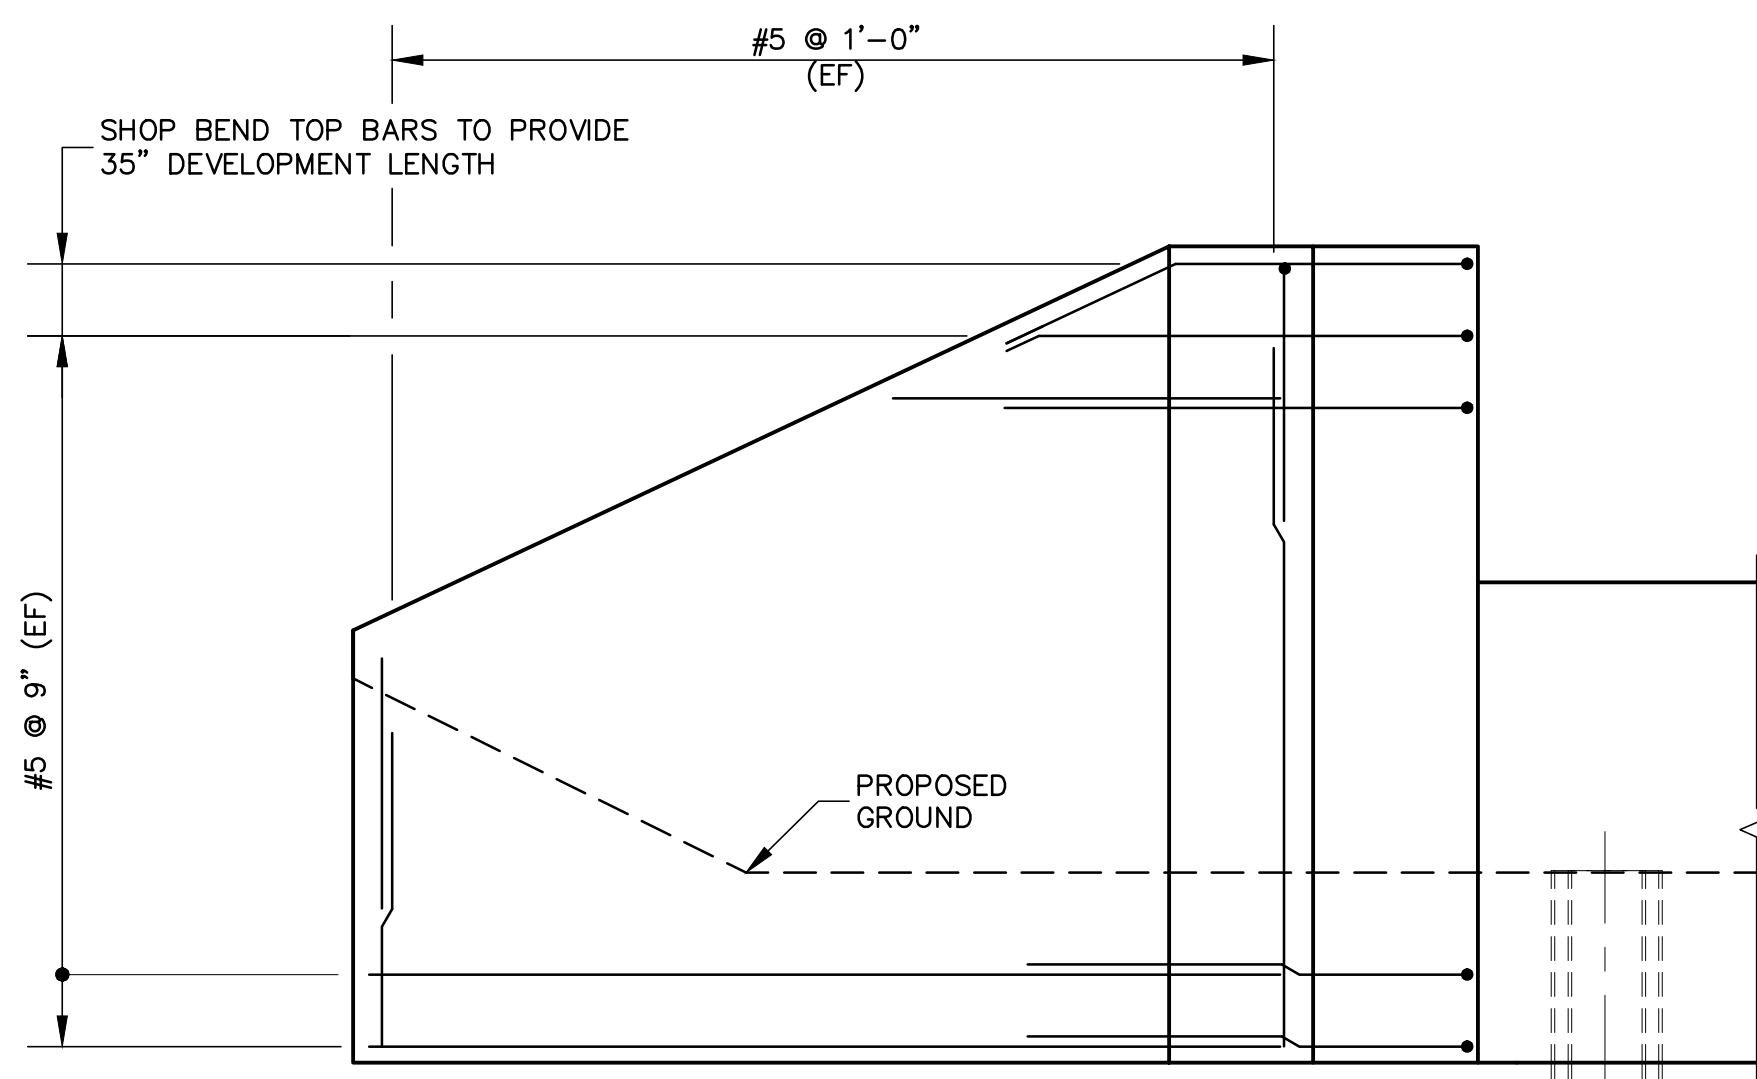



Wingwall Reinforcement

Scale: 1/2"=1'-0"

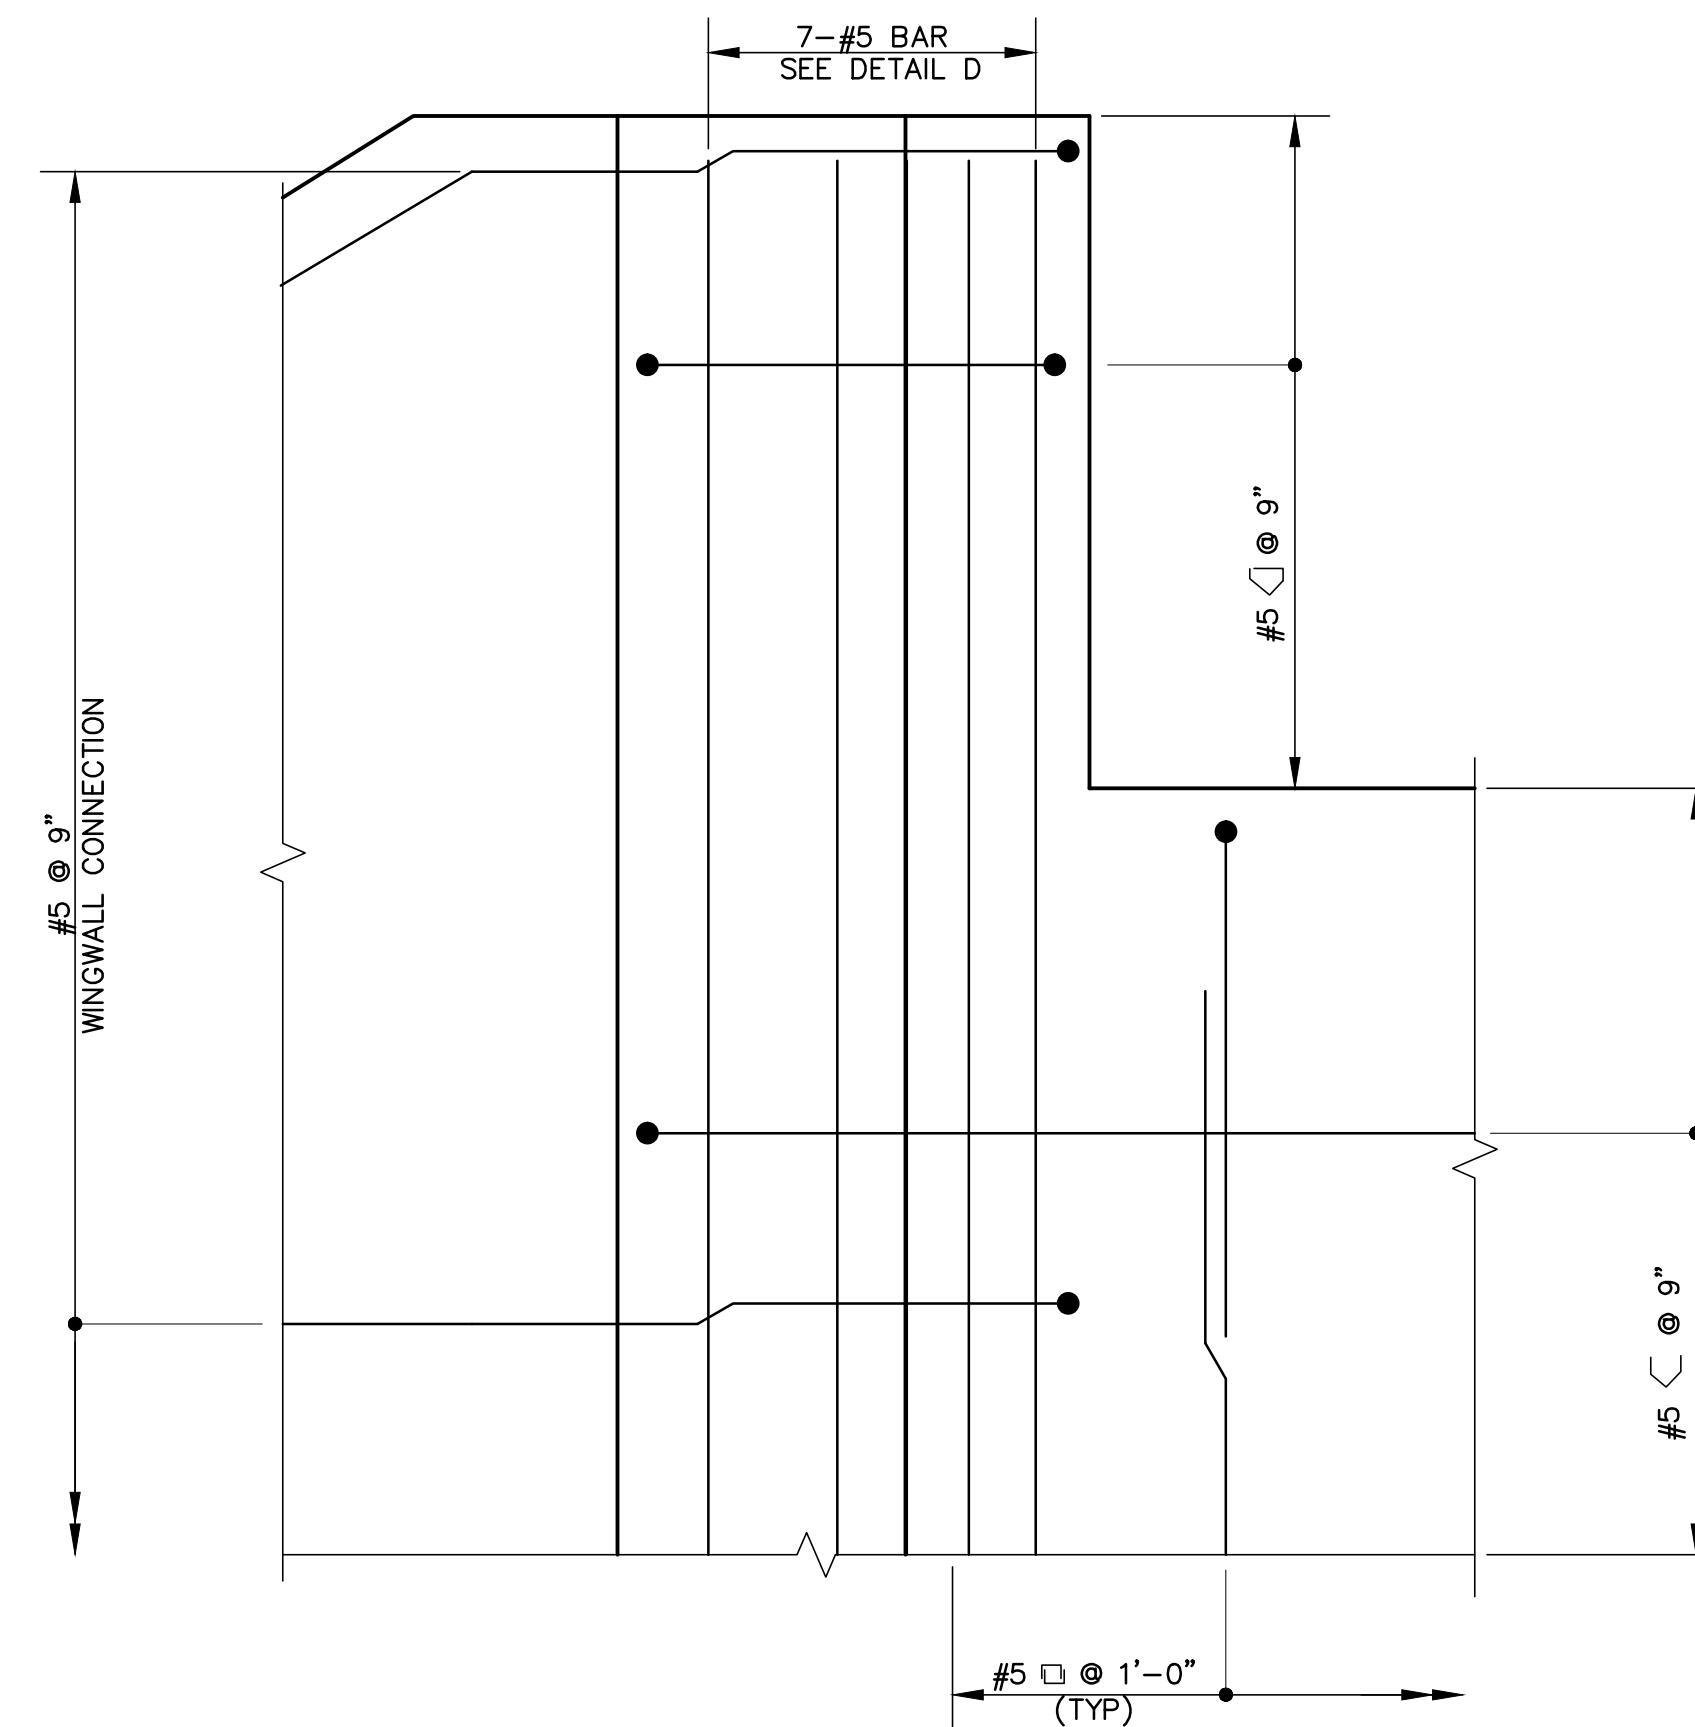



Reinforcing Section

Scale: 1"=1'-0"

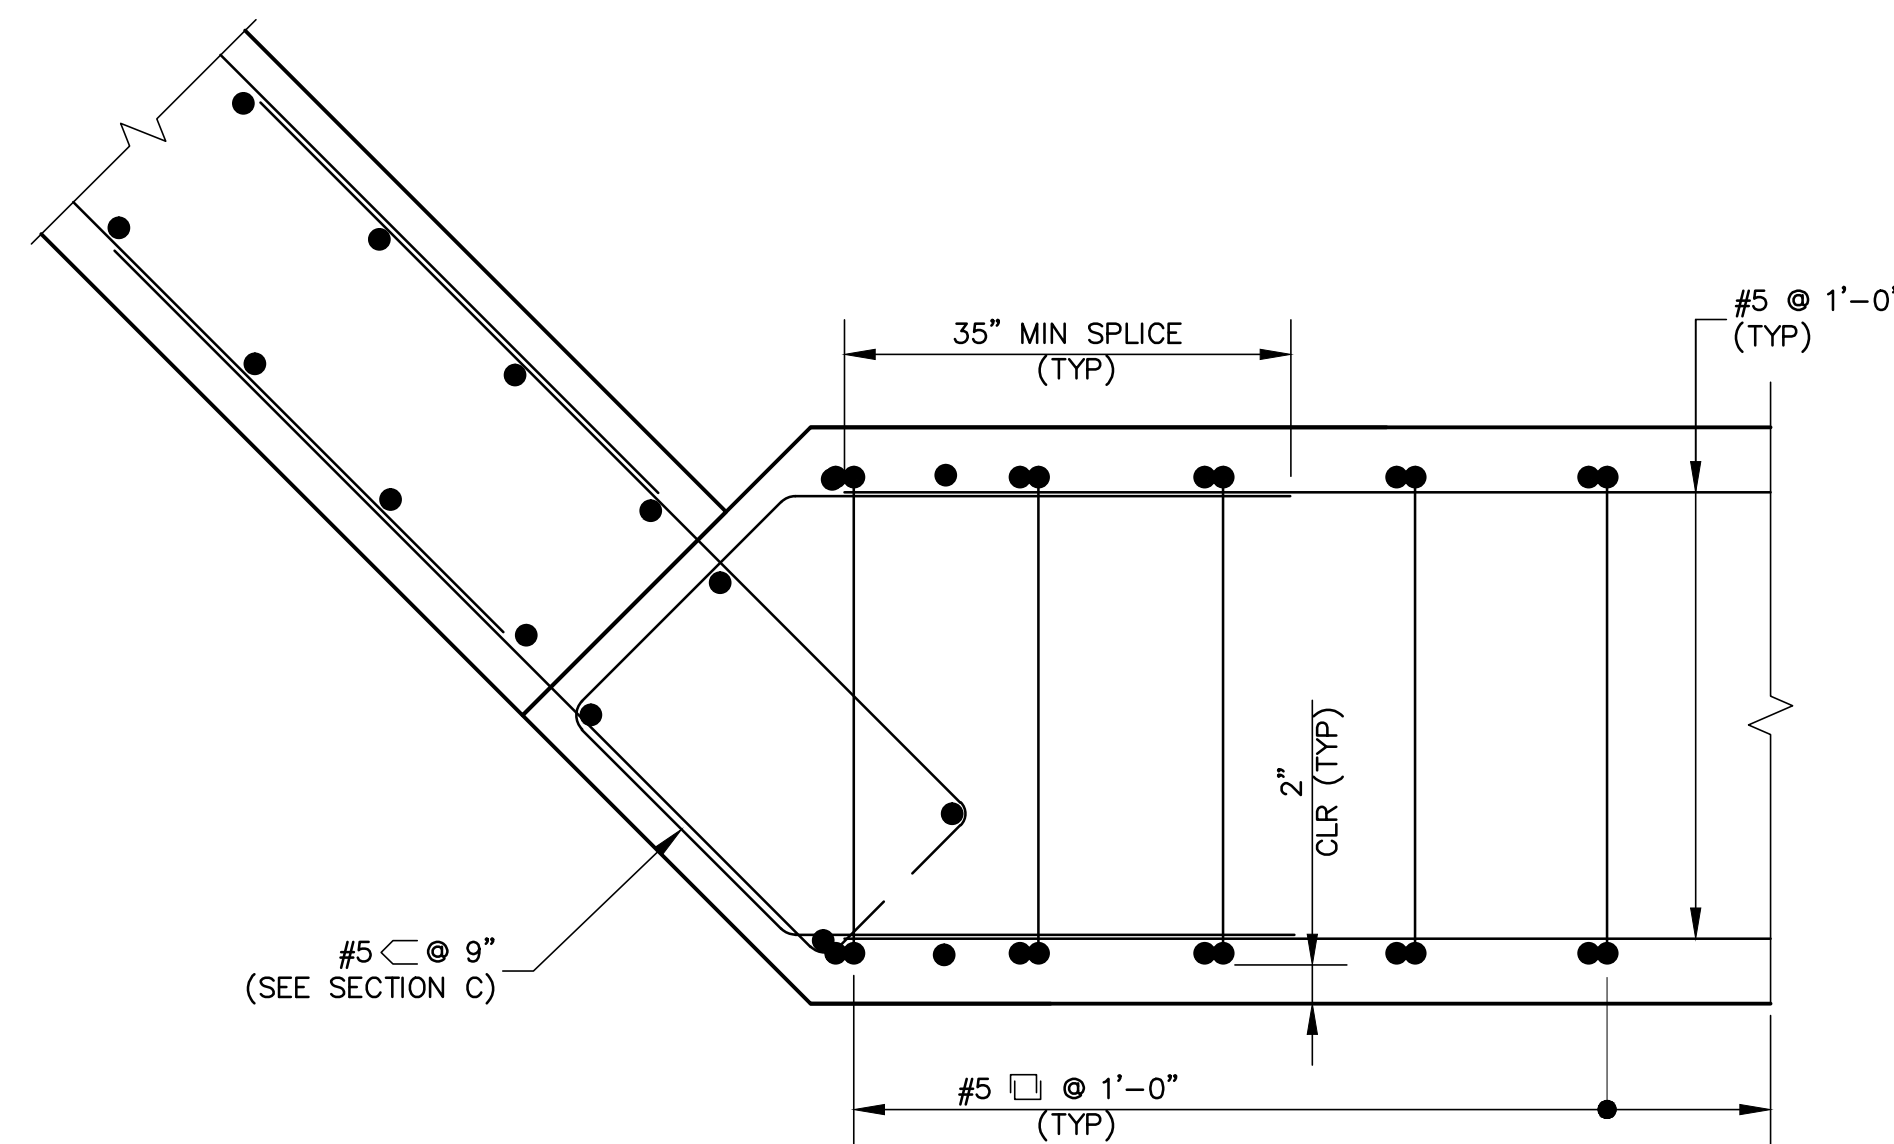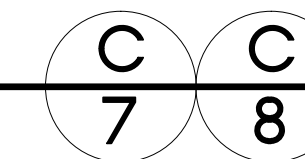


Reinforcing Detail

Scale: 1"=1'-0"

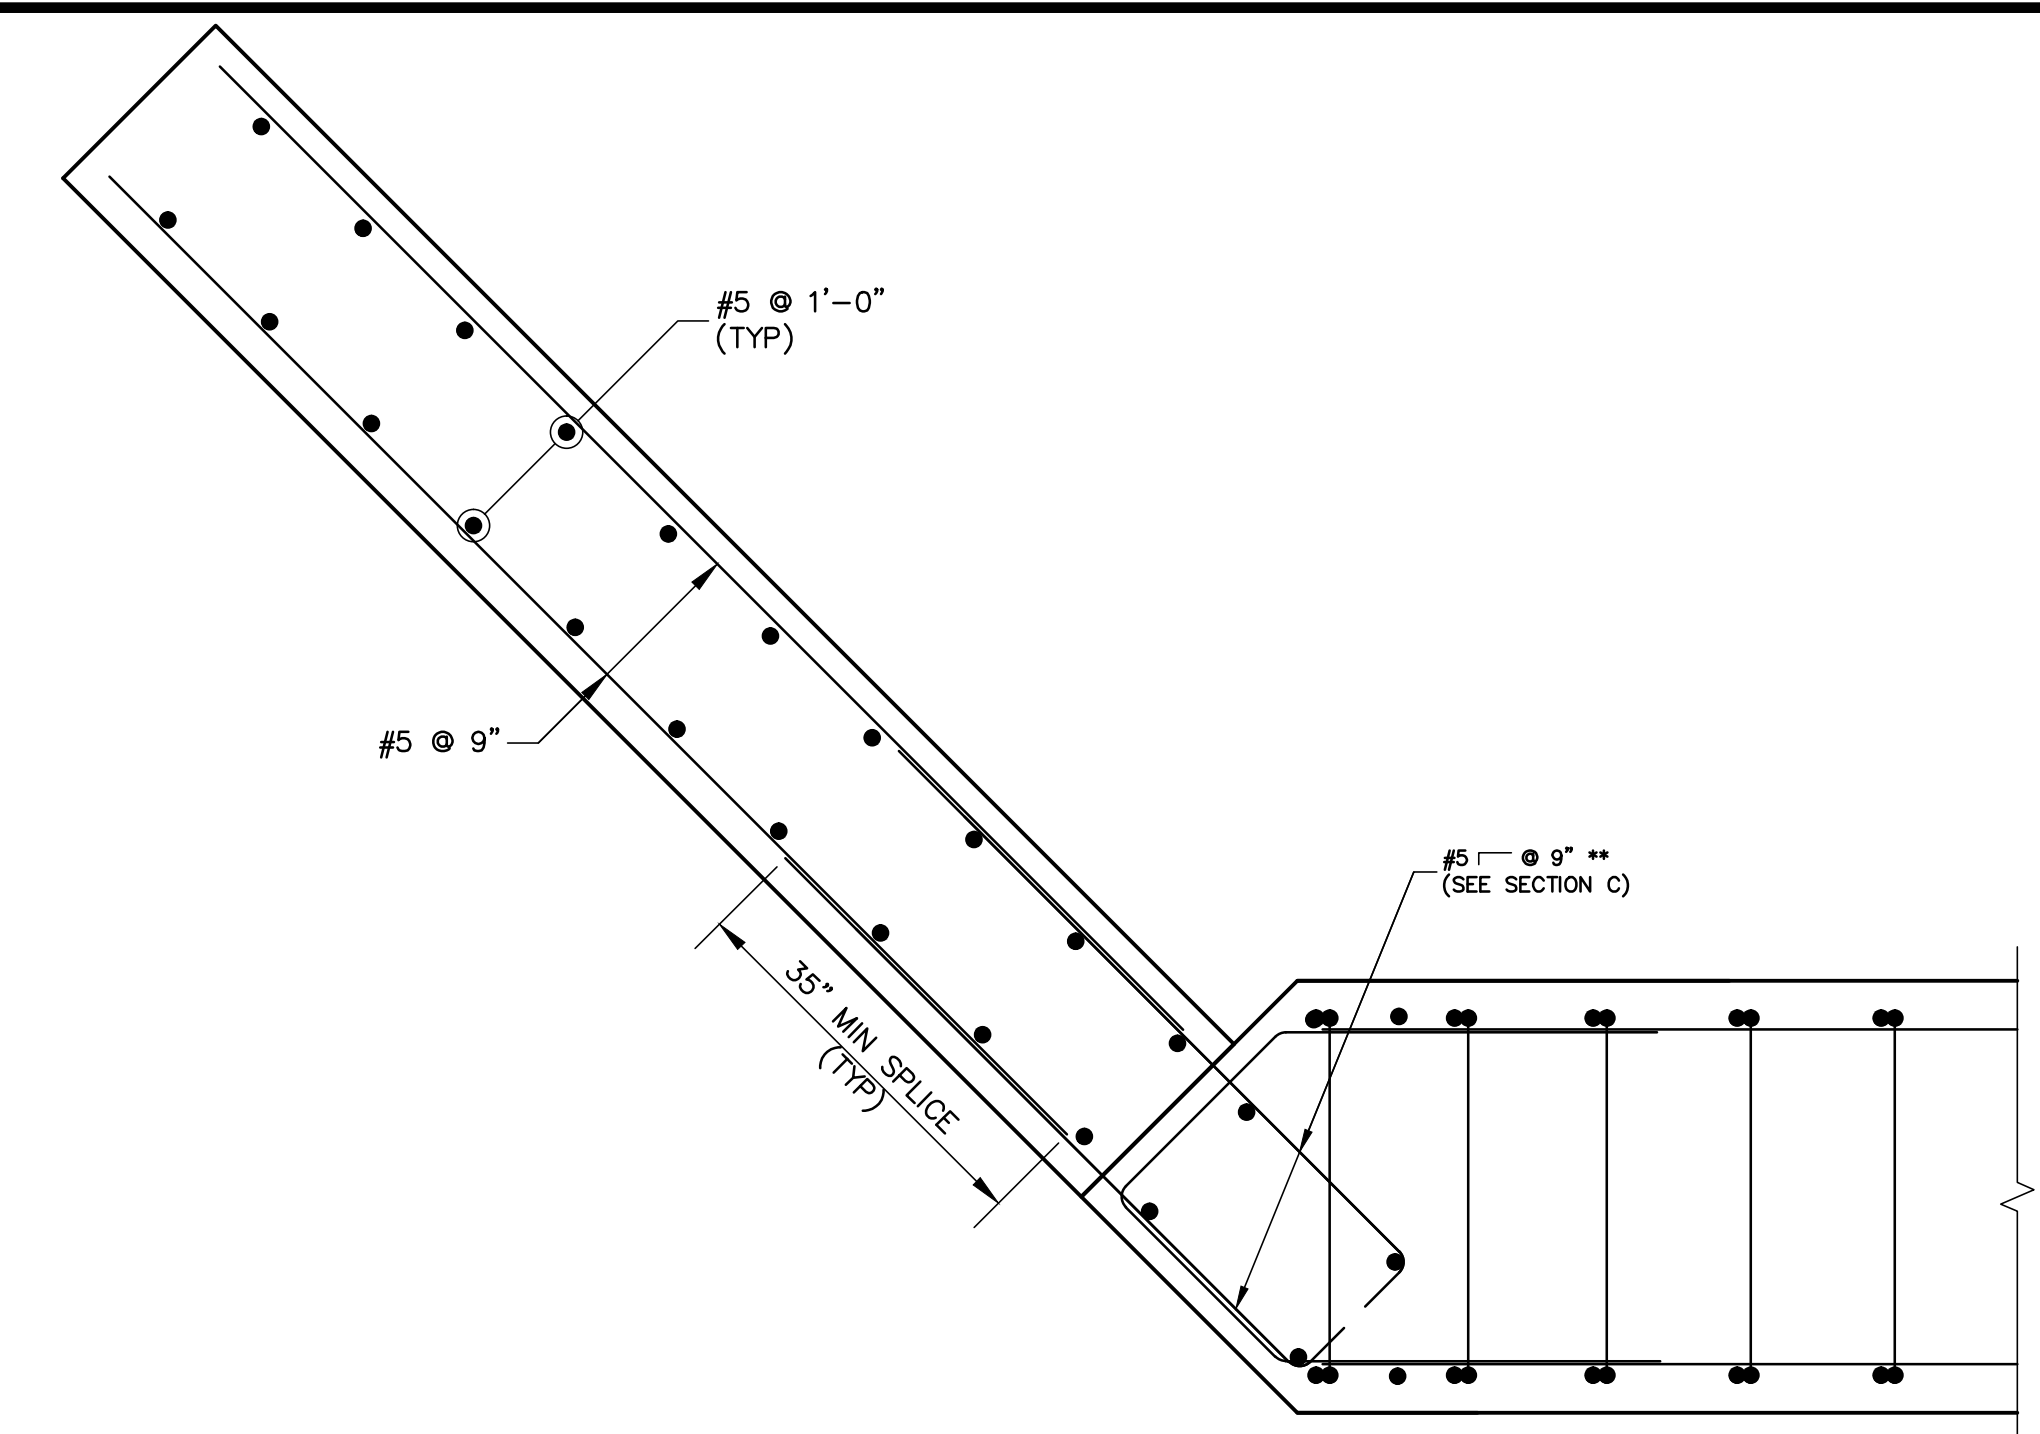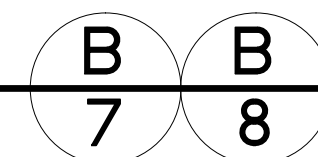


Wingwall Reinforcement Plan

Scale: 3/4"=1'-0"

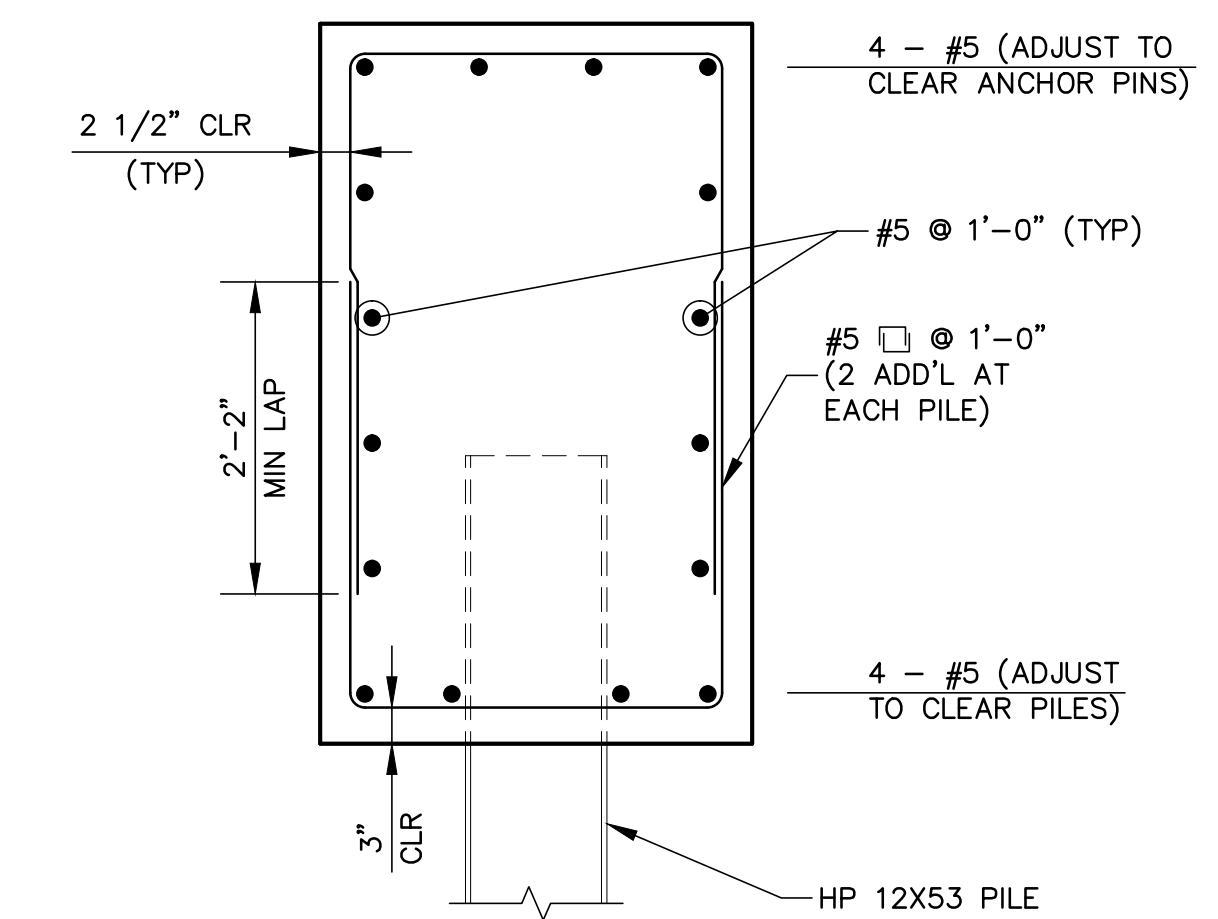


Typical Abutment Reinforcing

Scale: 3/4"=1'-0"

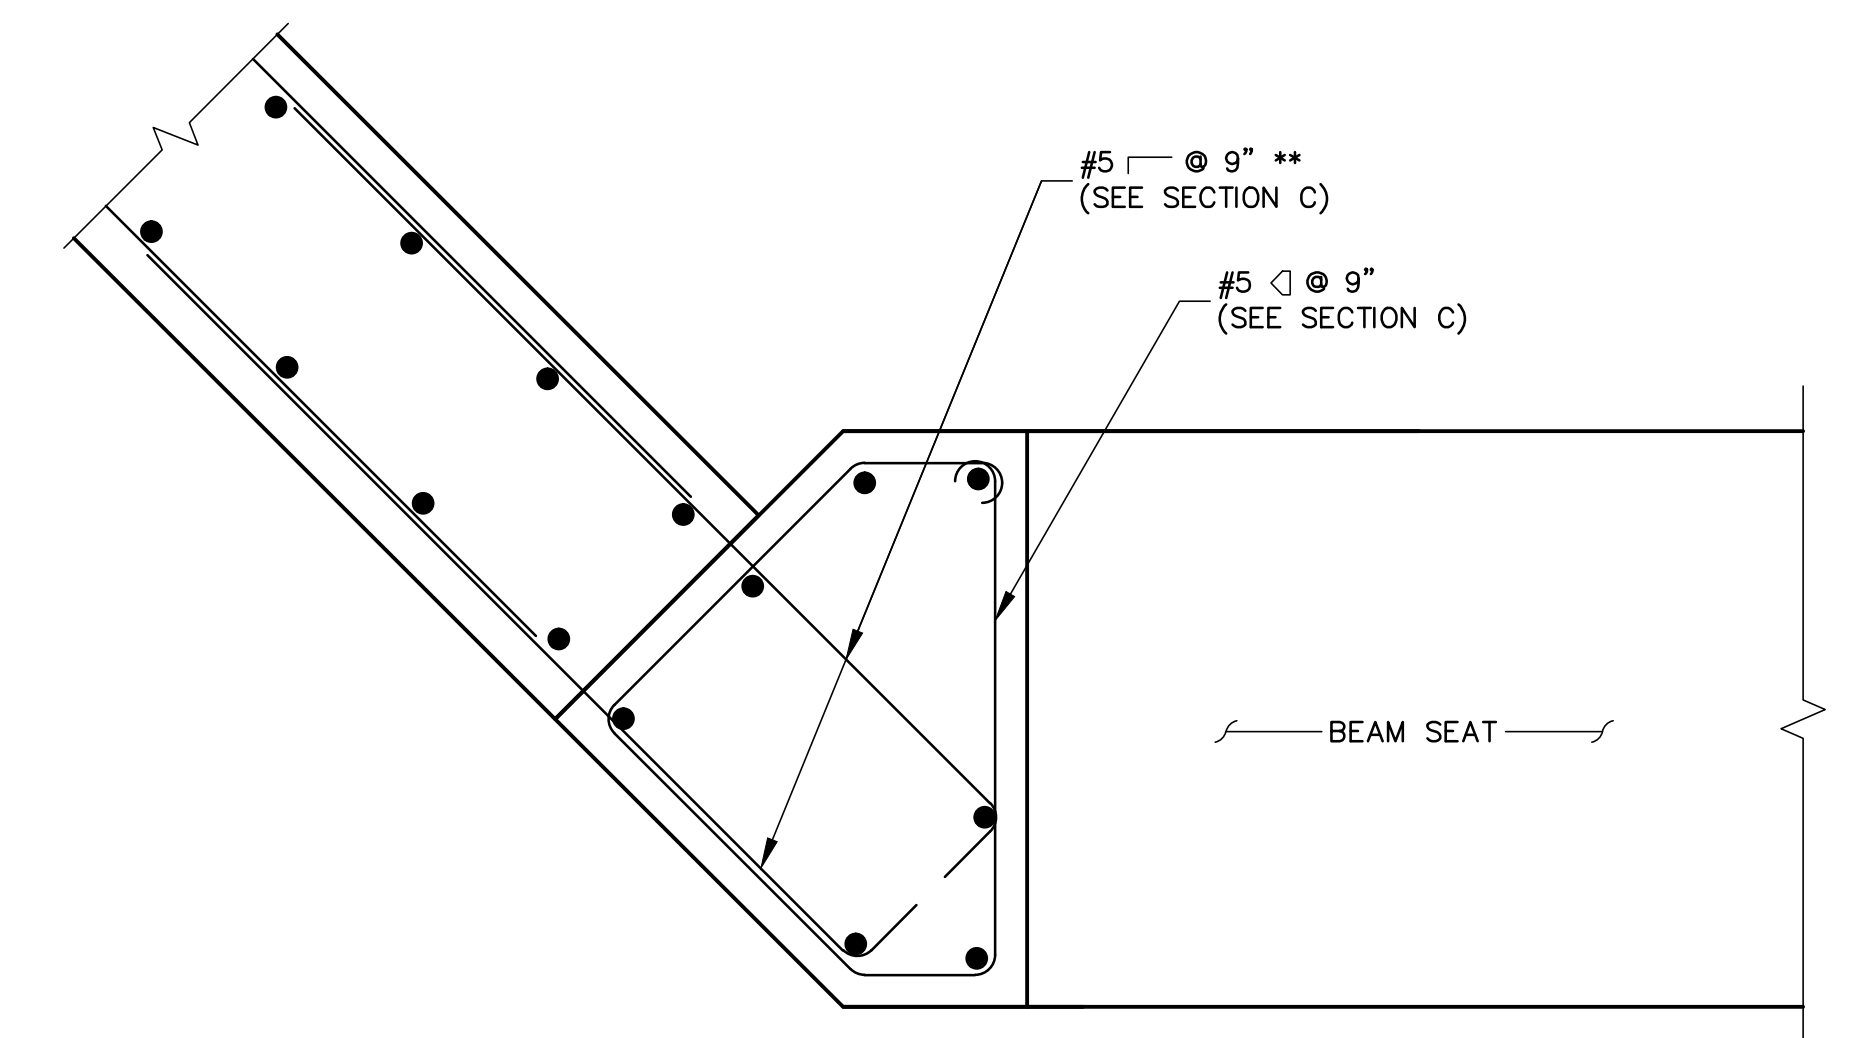


Reinforcing Detail

Scale: 1"=1'-0"

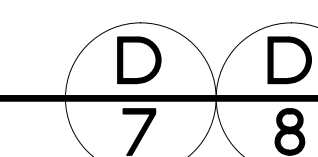


		designed by: LBK/OGK	date: June 2017
CIVIL/ENVIRONMENTAL/STRUCTURAL		drawn by: LBK/BGP	project no:
Portsmouth, NH • Manchester, NH • Portland, ME 603/431-6196 • 603/627-0708 • 207/541-4223		approved by: JLG	file name: S-10.dwg
c m a e n g i n e e r s . c o m		scale:	
Town of Exeter Department of Public Works Court Street Little River Bridge Replacement Abutment and Wingwall Elevations and Details			
drawing no. B-10			
sheet: 11 of 34			
ISSUED FOR CONSTRUCTION			no.
A			date 6/13/17 by JLG

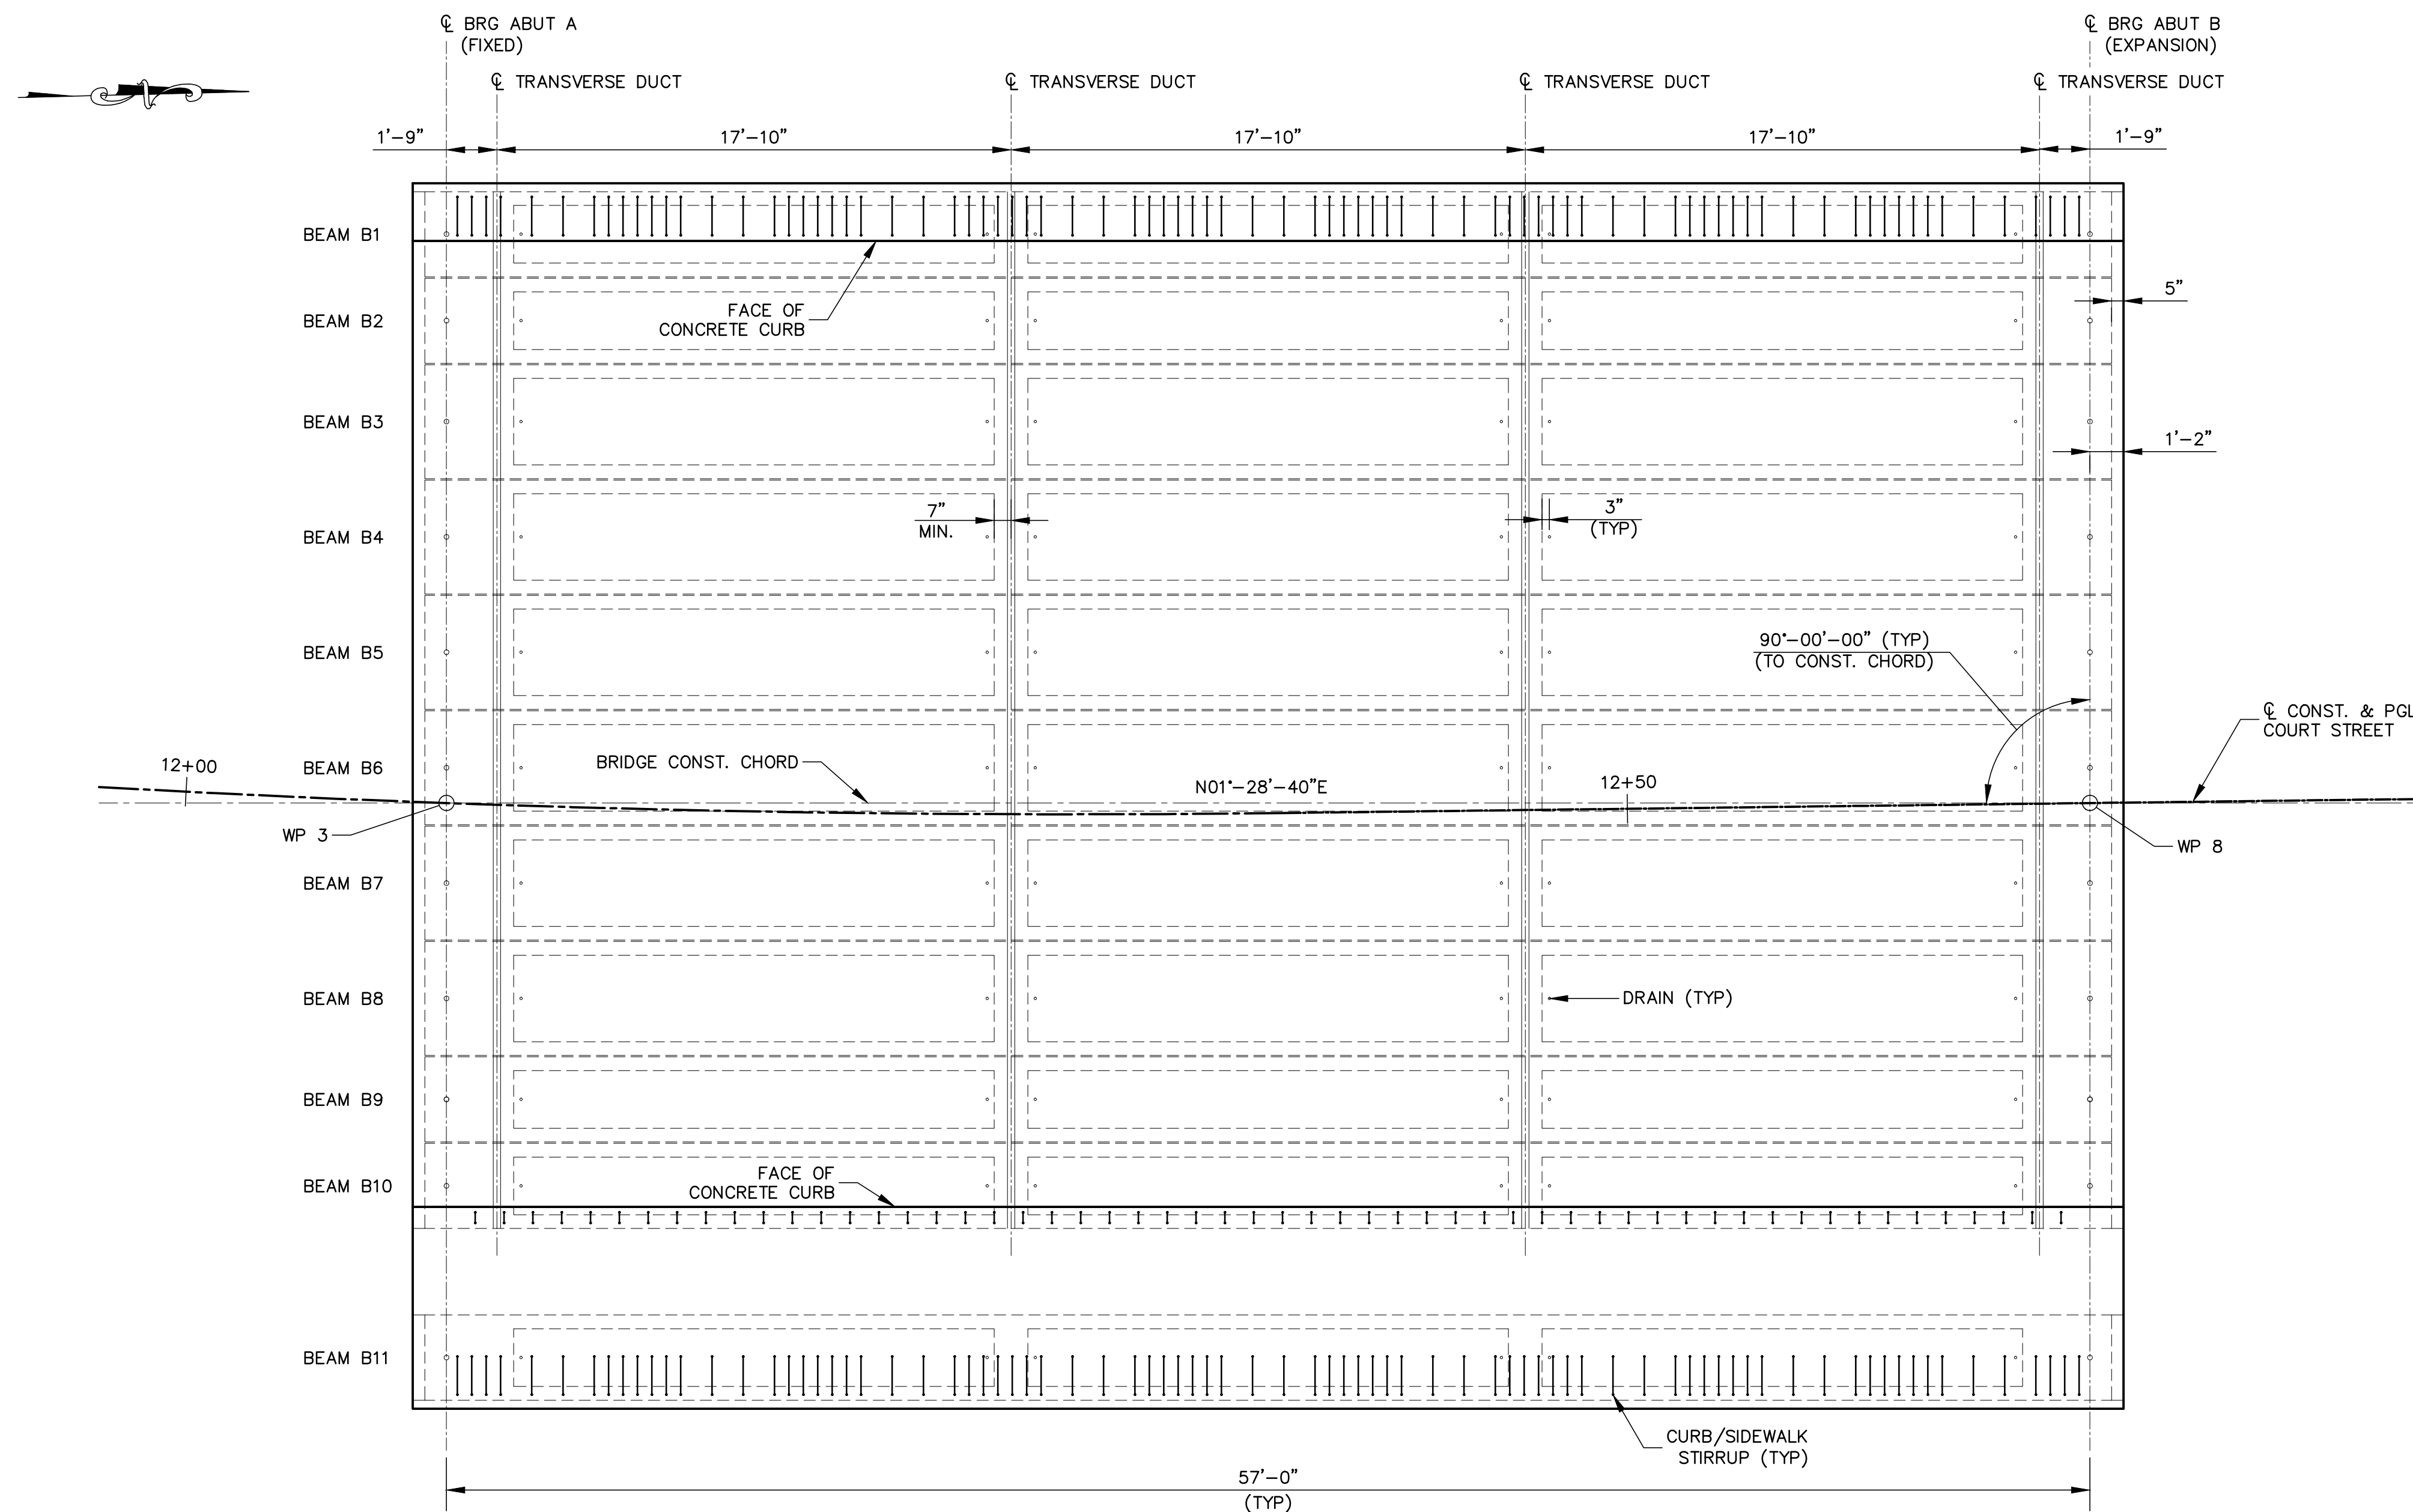


Prestressed Box Beam Layout

Scale: 1/4" = 1'-0"

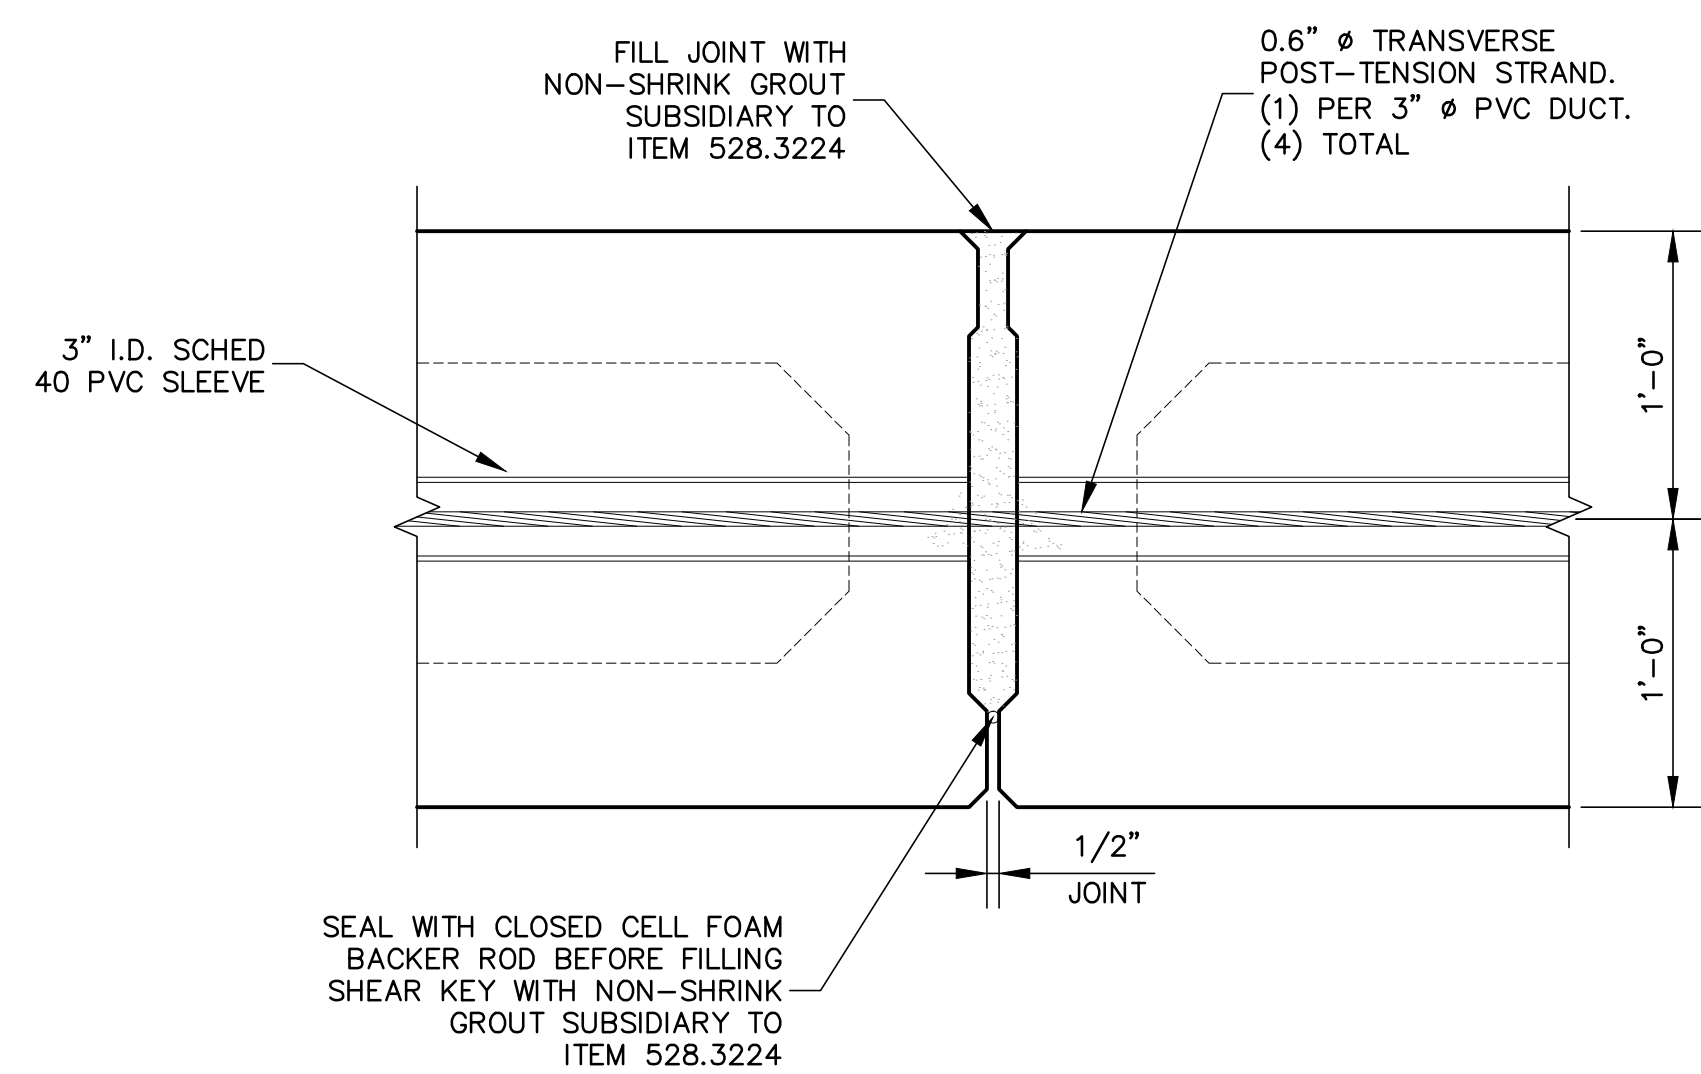


Post Tension/Grouted Shear Key Detail

Scale: 1 1/2" = 1'-0"

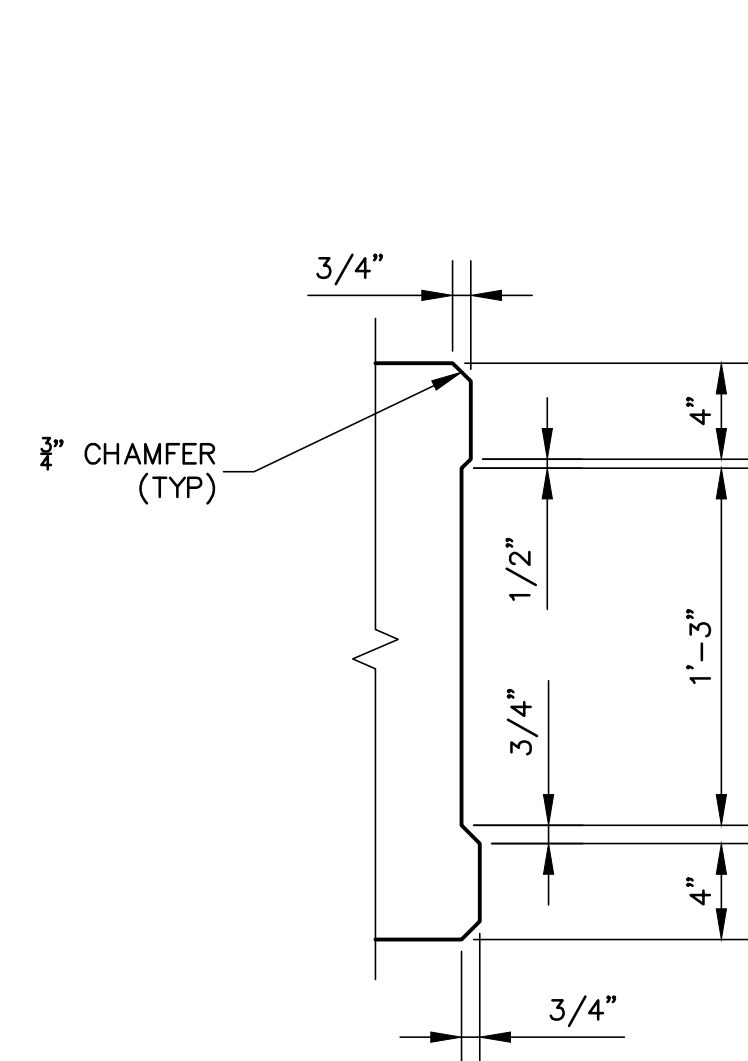


Typical Shear Key

Scale: 1 1/2" = 1'-0"

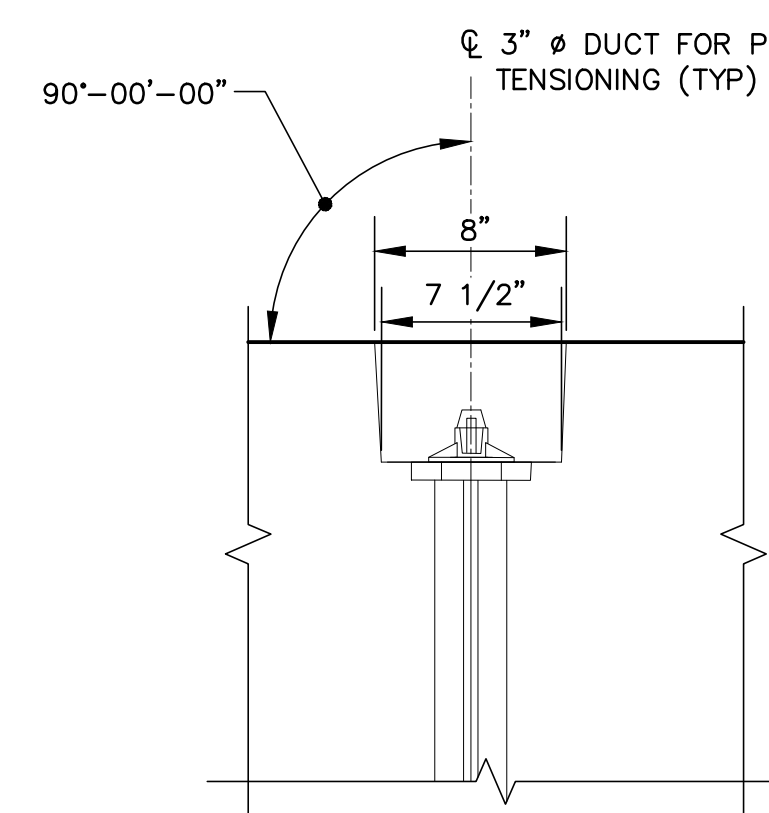

Plan

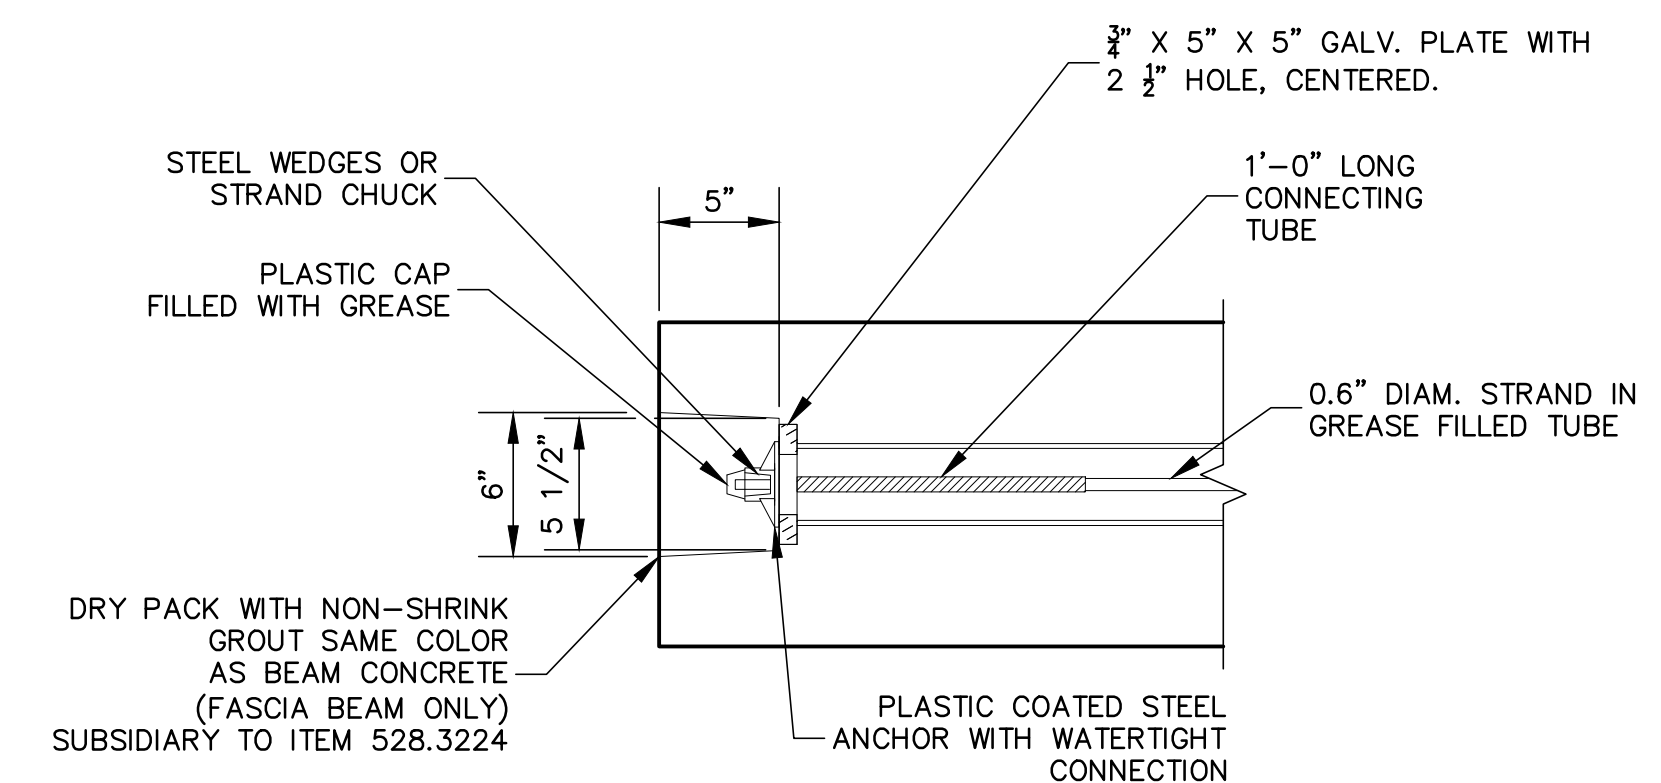


Elevation

Post Tension Detail

Scale: 1 1/2" = 1'-0"

no.	revision	date	by
A	ISSUED FOR CONSTRUCTION	6/13/17	JLG


CMA ENGINEERS
 CIVIL/ENVIRONMENTAL/STRUCTURAL
 Portsmouth, NH • Manchester, NH • Portland, ME
 603/431-6196 • 603/627-0708 • 207/541-4223
 c m a e n g i n e e r s . c o m

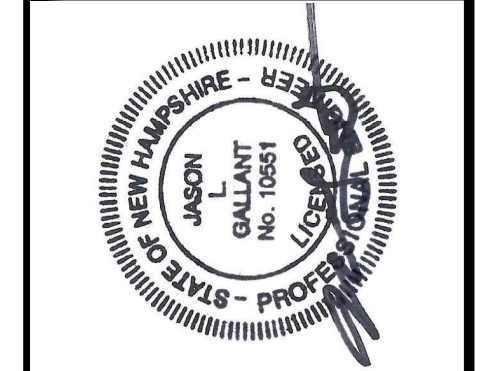

date:	June 2017
designed by:	LBK/OGK
drawn by:	LBK/BGP
approved by:	JLG
project no.:
file name:	S-11 to S-14.dwg
scale:	


Town of Exeter
 Department of Public Works
 Court Street
 Little River Bridge Replacement
 Prestressed Box Beam Layout

F:\CADD\PROJECTS\923-Exeter Bridges\Production\Court St\Final Design\S-11 to S-14.dwg Date Plotted: Jun 12, 2017 - 11:51am Plotted By: SPOMEROY

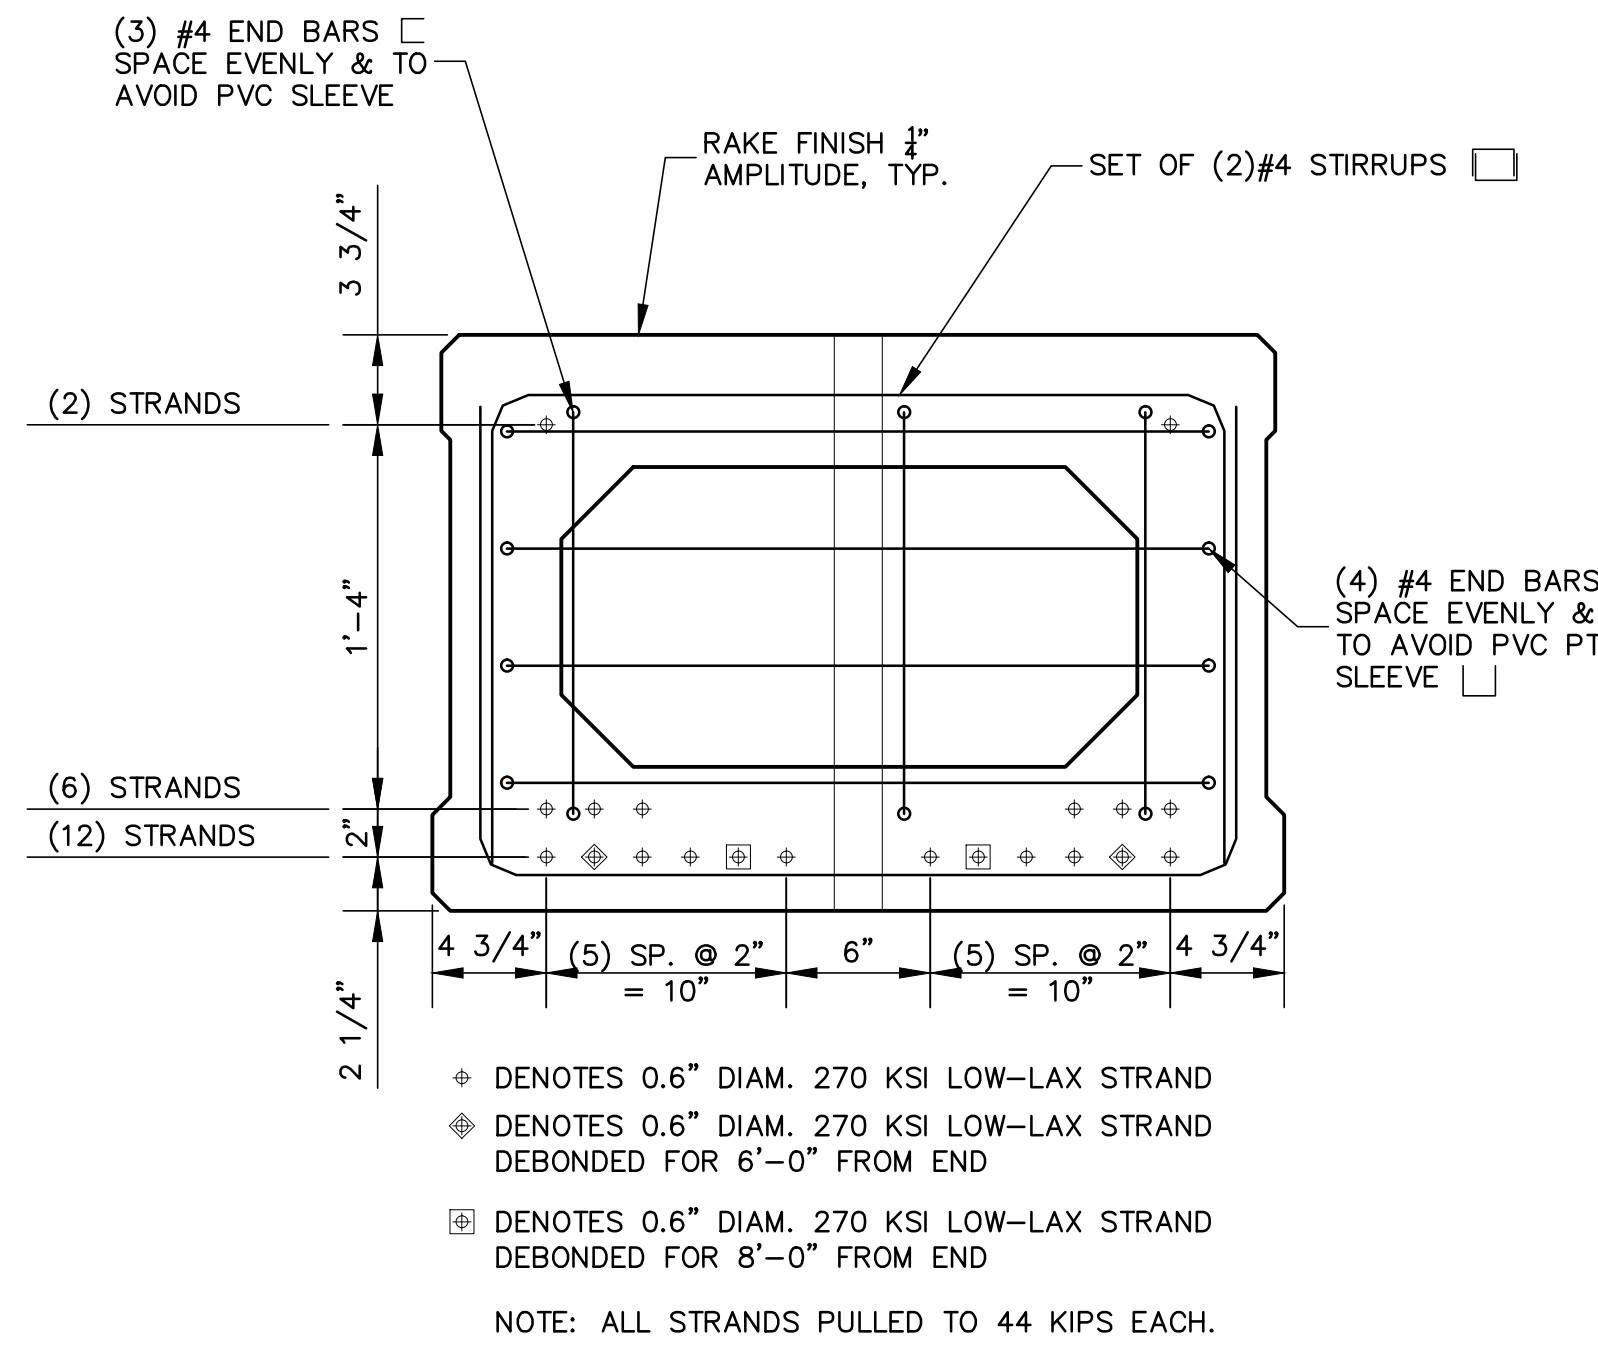


36" Box Beam Typical End Section

Scale: $1\frac{1}{2}" = 1'-0"$

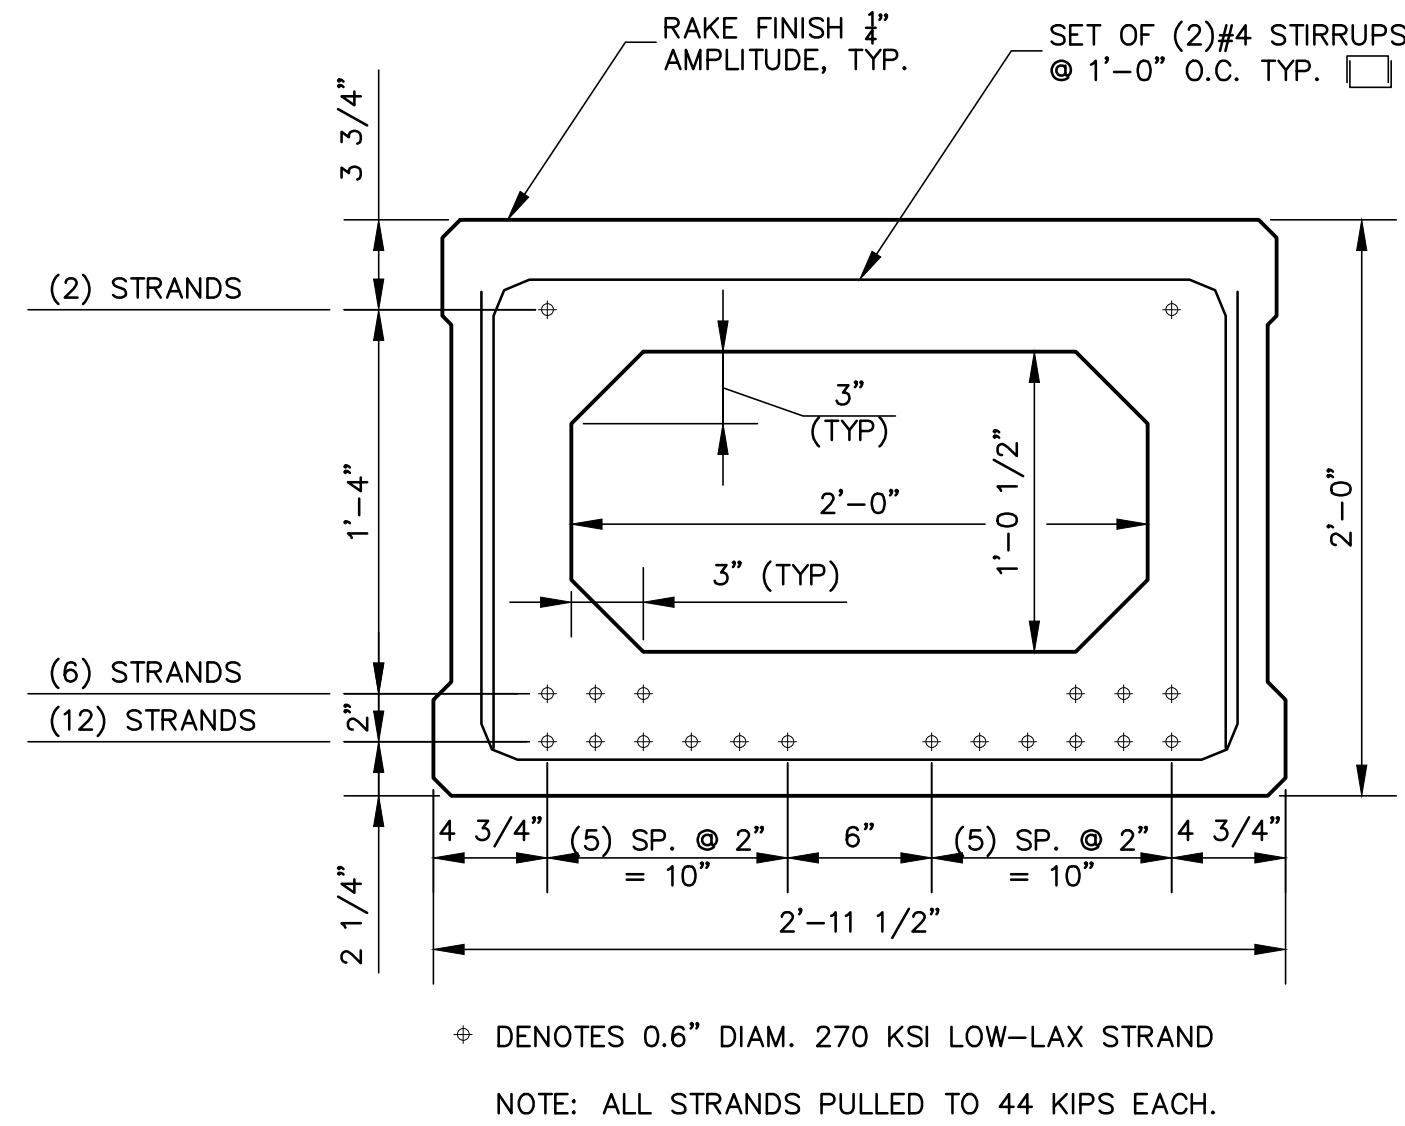


36" Box Beam Typical Mid Section

Scale: $1\frac{1}{2}" = 1'-0"$

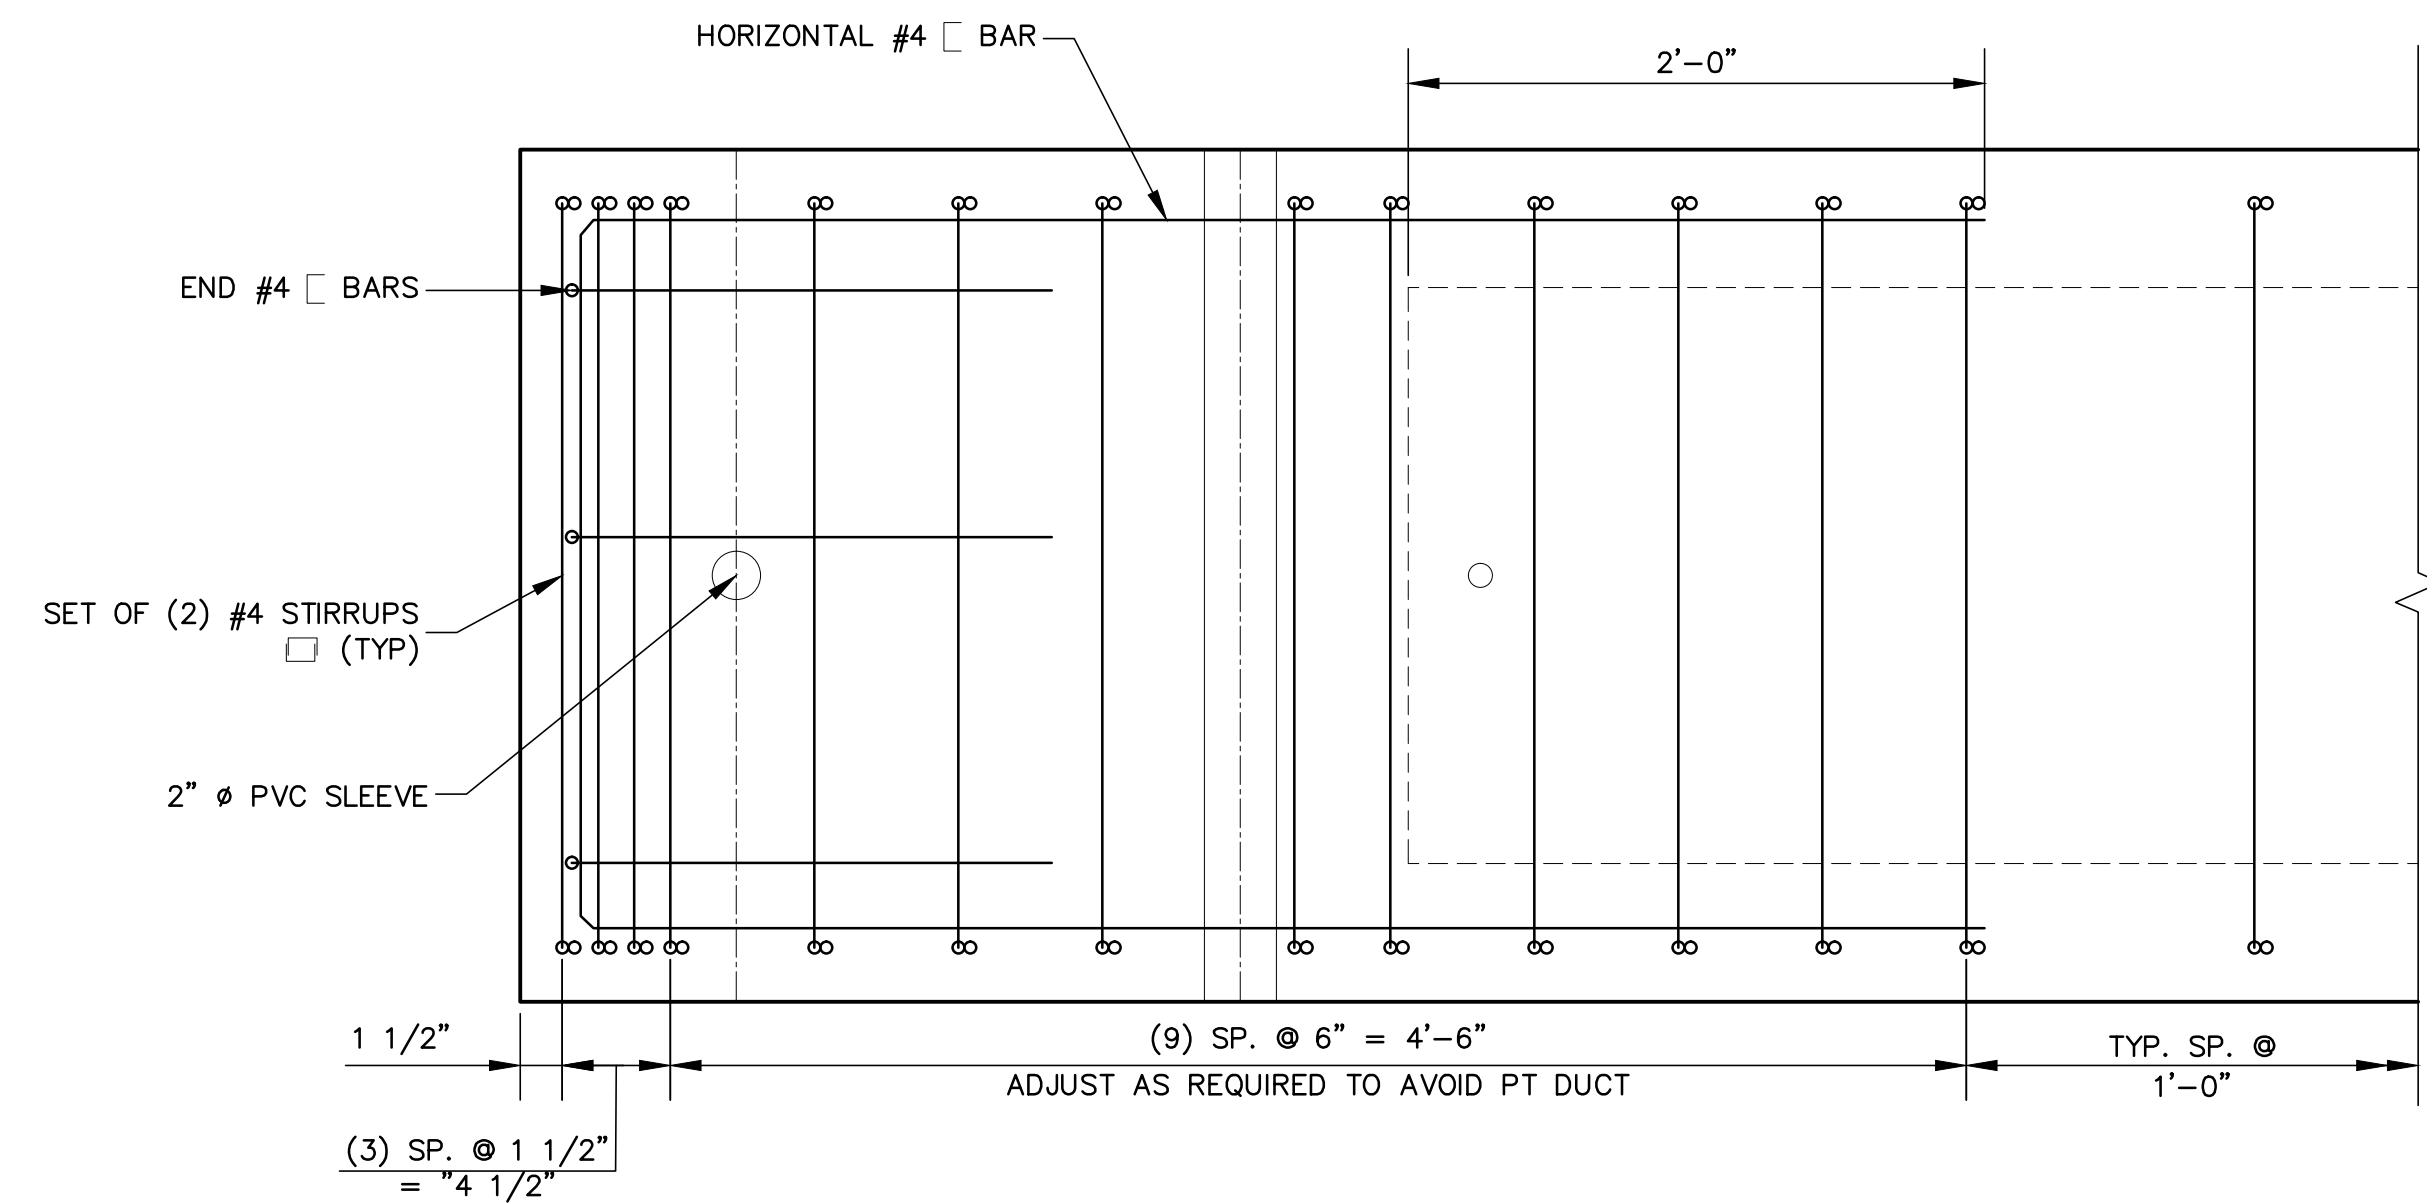


36" Box Beam Typical End Plan

Scale: $1\frac{1}{2}" = 1'-0"$

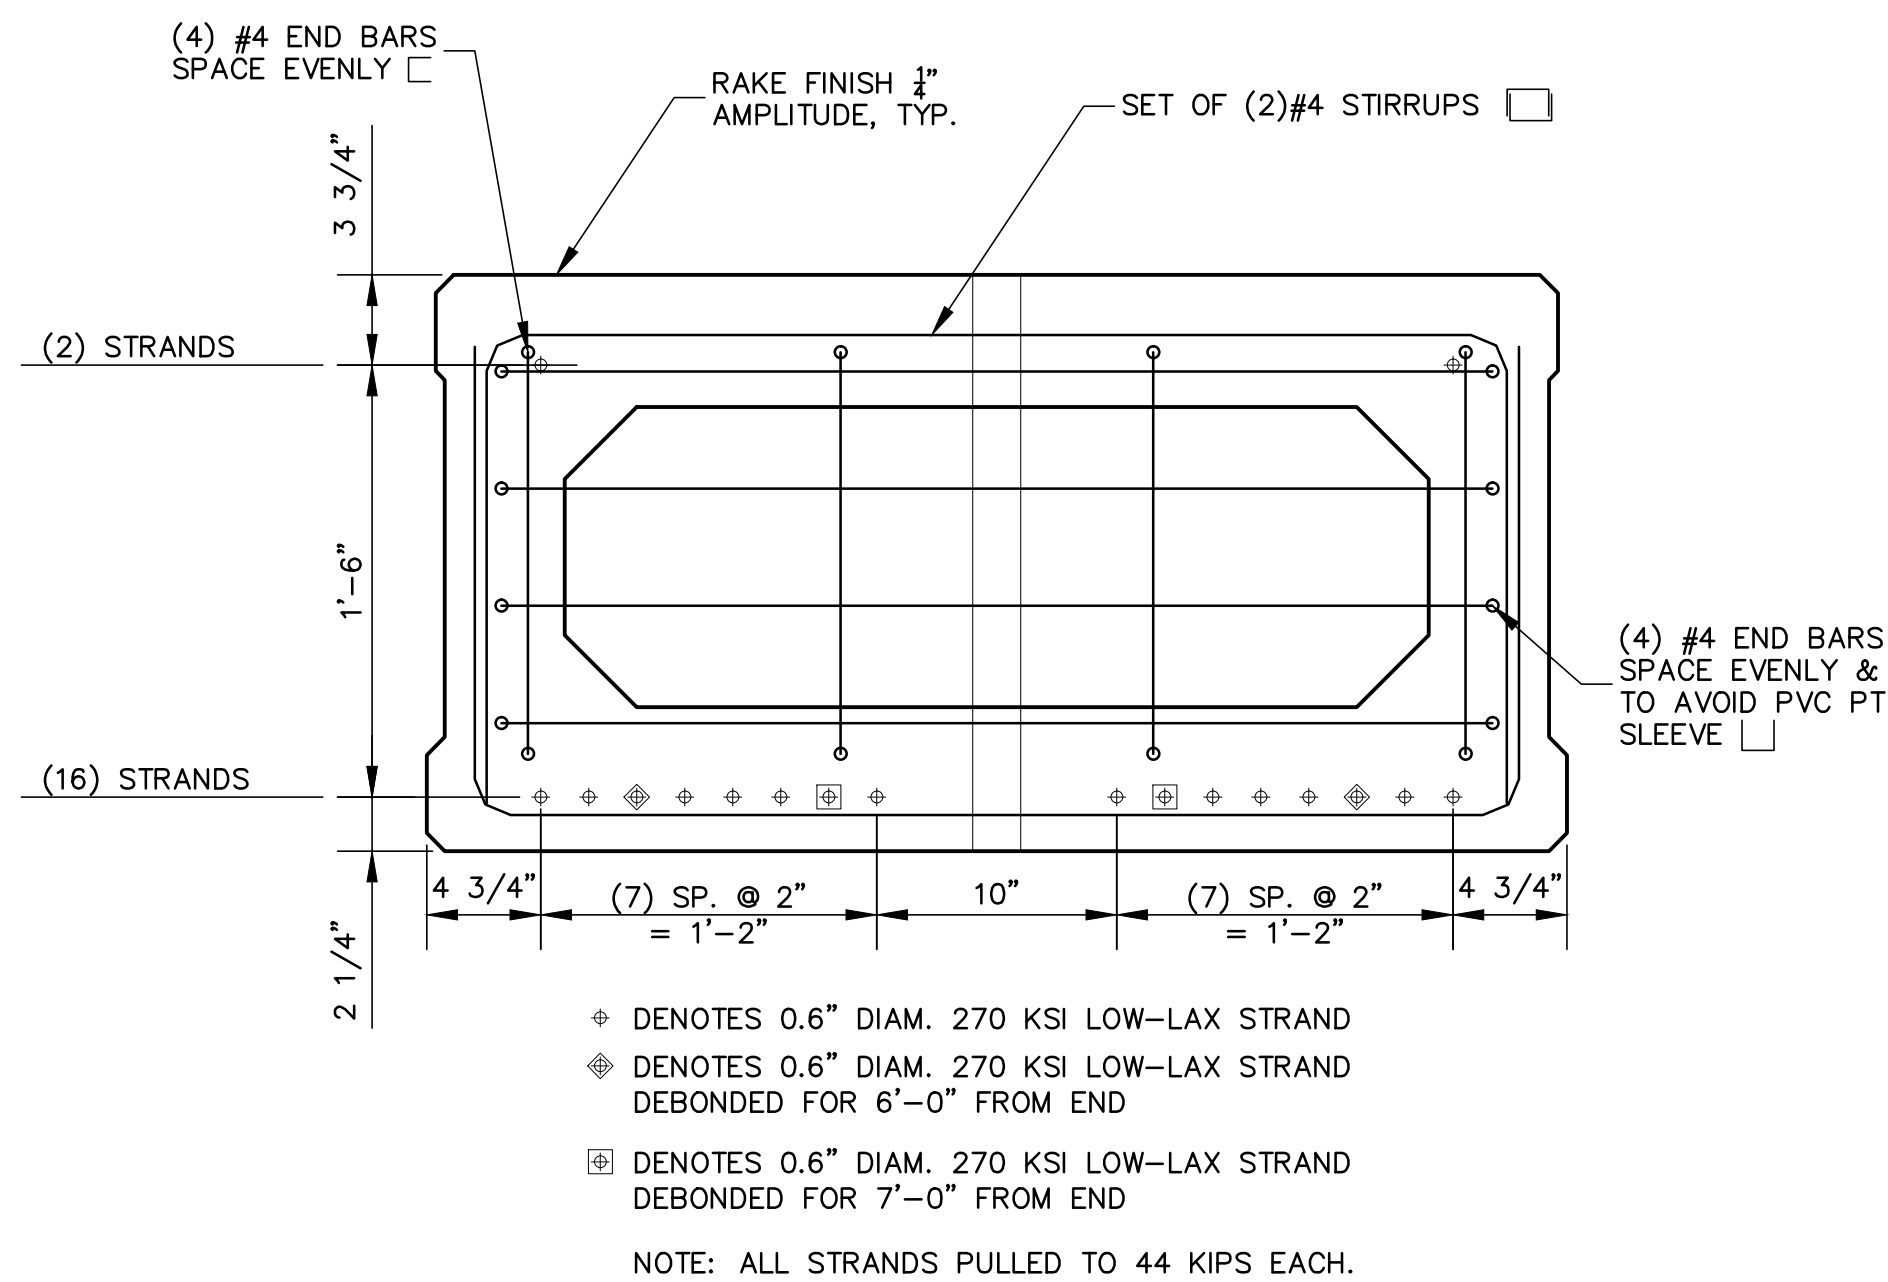


48" Box Beam Typical End Section

Scale: $1\frac{1}{2}" = 1'-0"$

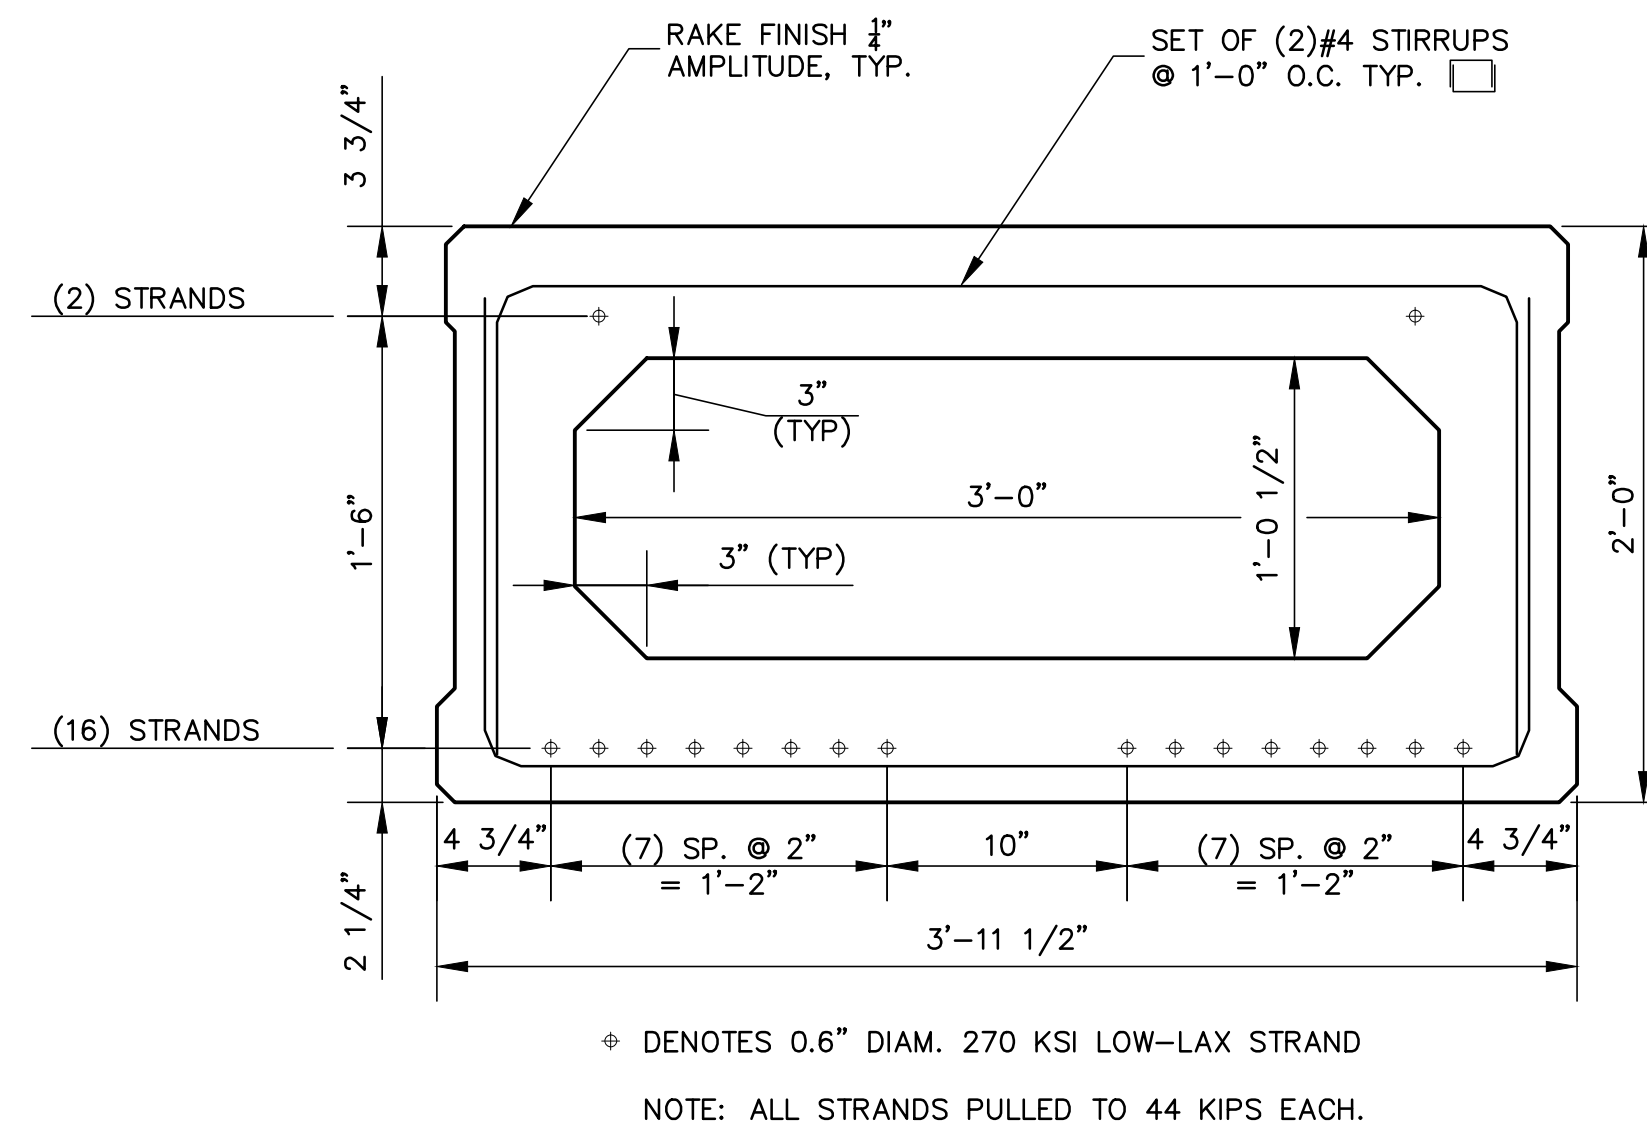

48" Box Beam Typical Mid Section

Scale: $1\frac{1}{2}" = 1'-0"$

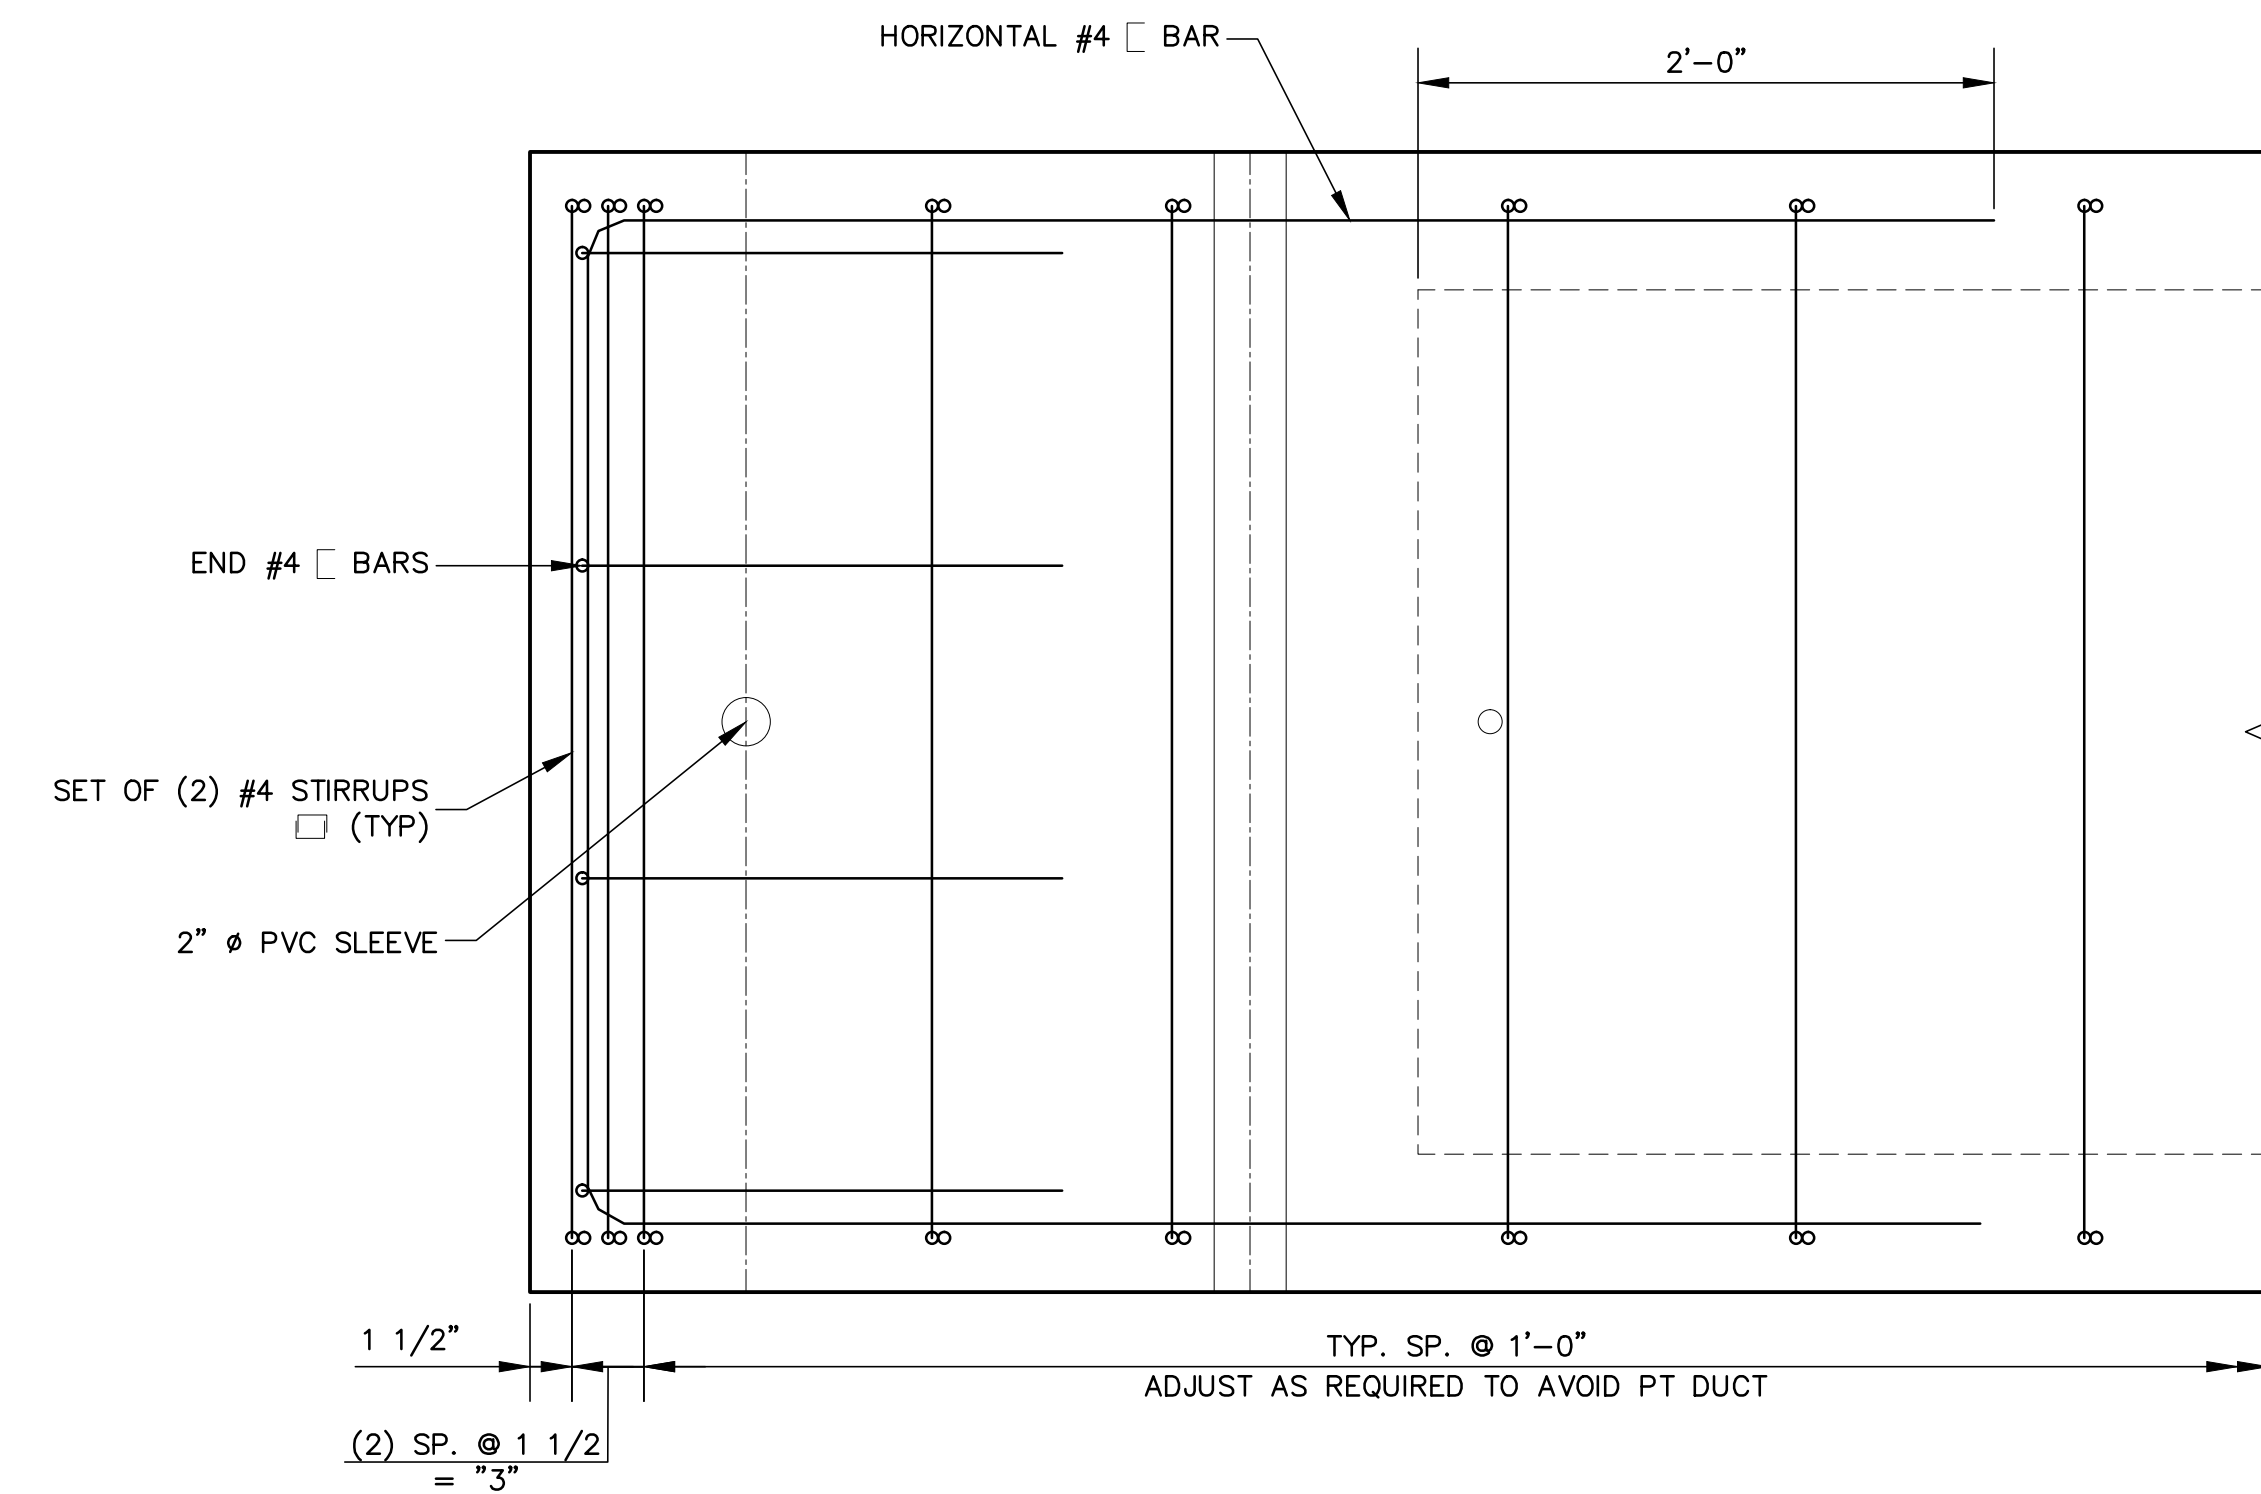


48" Box Beam Typical End Plan

Scale: $1\frac{1}{2}" = 1'-0"$

CAMBER AT MID-SPAN (IN)					
	PRESTRESS	SELF WEIGHT	SUPERIMPOSED DL	TOTAL AT ERECTION	TOTAL AT FINAL
BEAM B1	2.35	-0.97	-0.48	2.43	1.39
BEAM B2 AND B9	2.35	-0.97	-0.43	2.43	1.54
BEAM B3-B8	1.72	-0.92	-0.42	1.40	0.31
BEAM B10	2.35	-0.97	-0.79	2.43	0.48
BEAM B11	2.35	-0.97	-1.05	2.43	-0.32


NOTE: NEGATIVE VALUES INDICATE DOWNWARD DEFLECTION.

designed by: LBK/OGK	drawn by: LBK/BGP	approved by: JLG	scale:
date: June 2017	project no:	file name: S-11 to S-14.dwg	
CMA ENGINEERS CIVIL/ENVIRONMENTAL/STRUCTURAL Portsmouth, NH • Manchester, NH • Portland, ME 603/431-6196 • 603/627-0708 • 207/541-4223 c m a e n g i n e e r s . c o m			
Town of Exeter Department of Public Works Court Street Little River Bridge Replacement Prestressed Box Beam Details (Sheet 1 of 3)			
drawing no. B-12			
sheet:	13	of	34

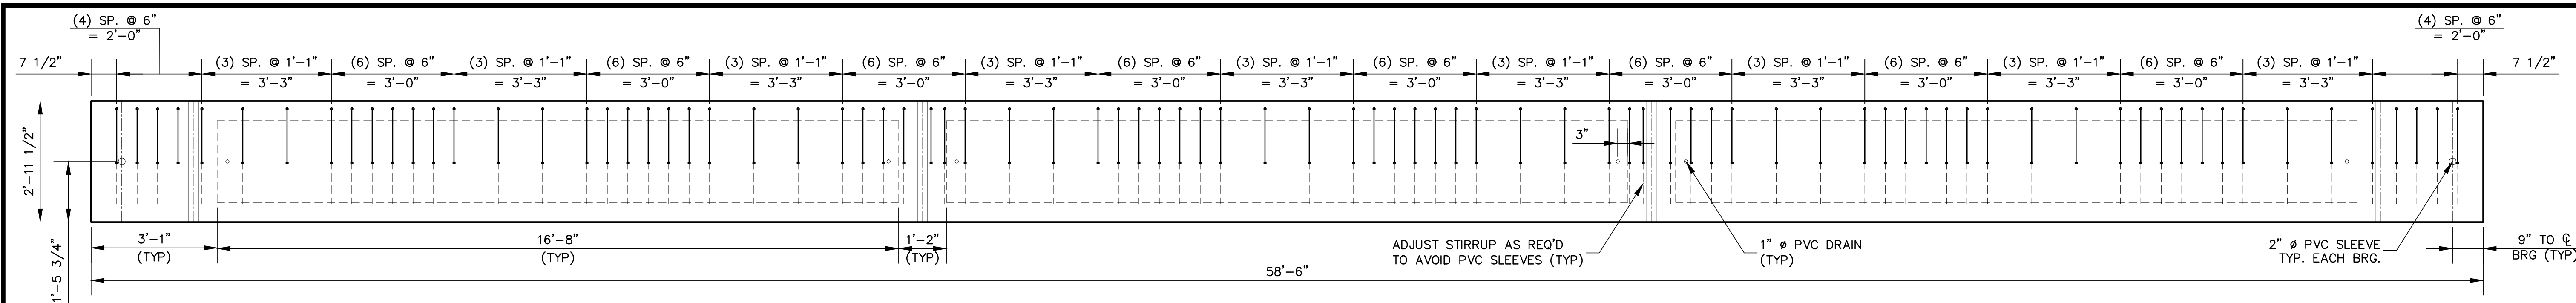


Beam B1 Plan

Scale: $\frac{1}{2}'' = 1'-0''$

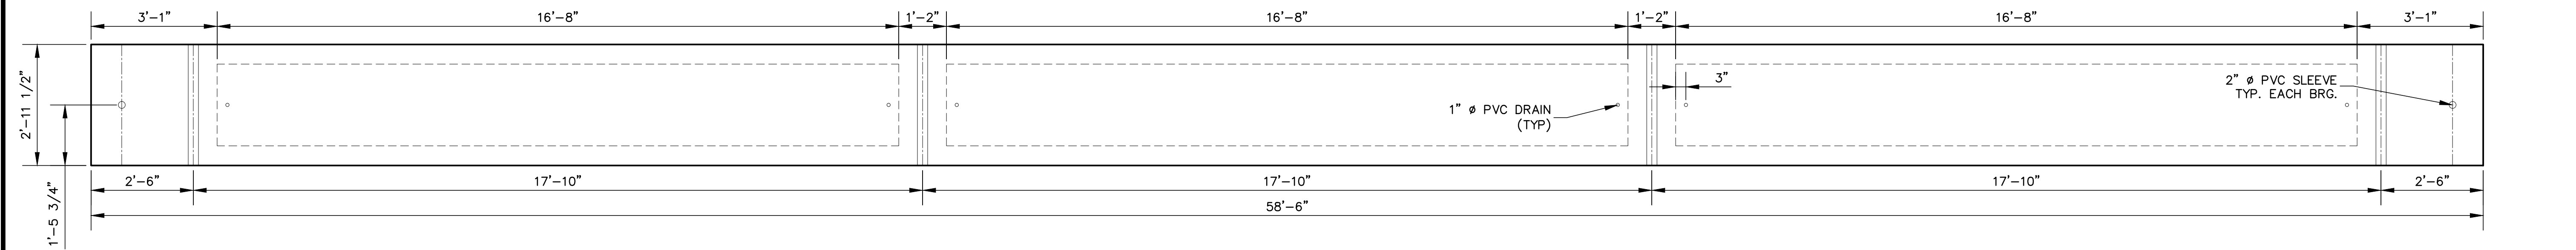


Beam B2 and B9 Plan

Scale: $\frac{1}{2}'' = 1'-0''$

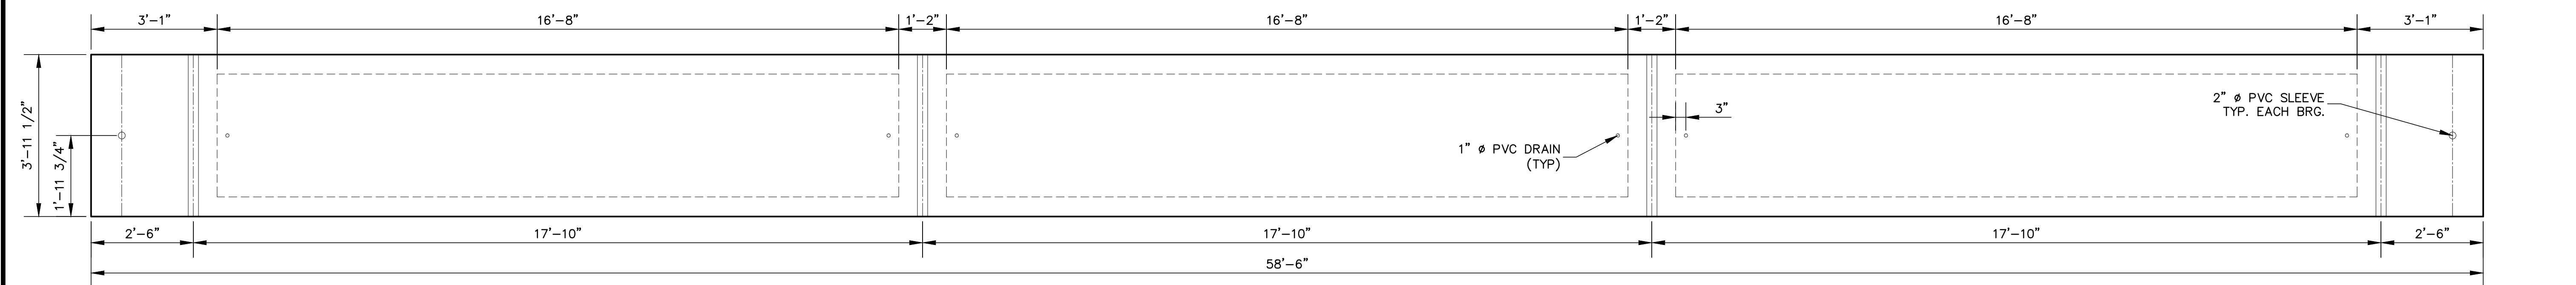


Beam B3 Through B8 Plan

Scale: $\frac{1}{2}'' = 1'-0''$

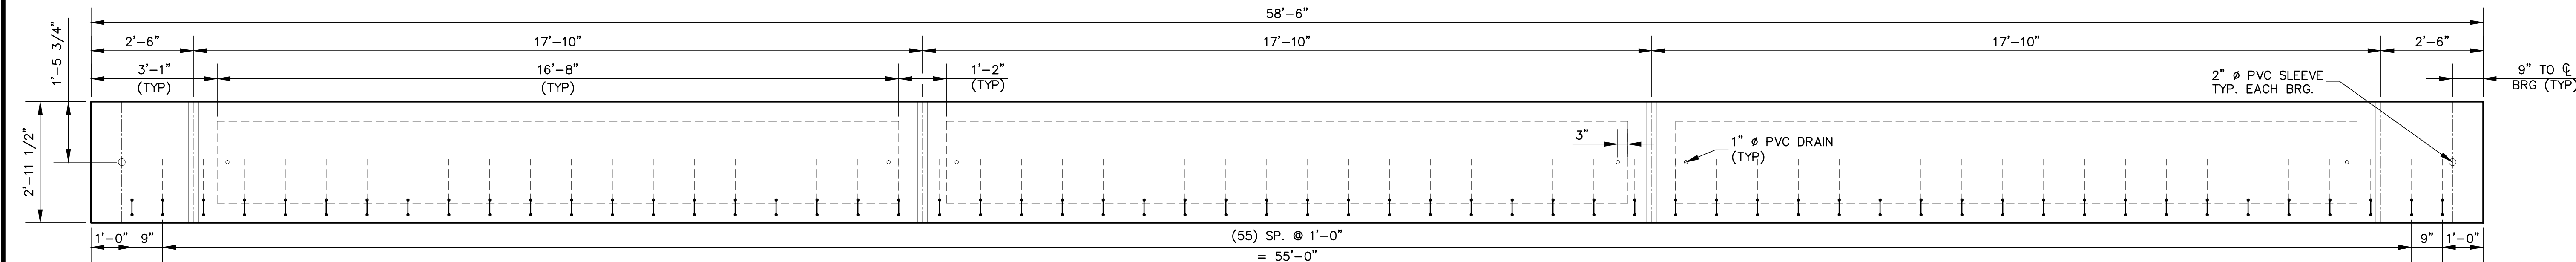

Beam B10 Plan


Scale: $\frac{1}{2}'' = 1'-0''$

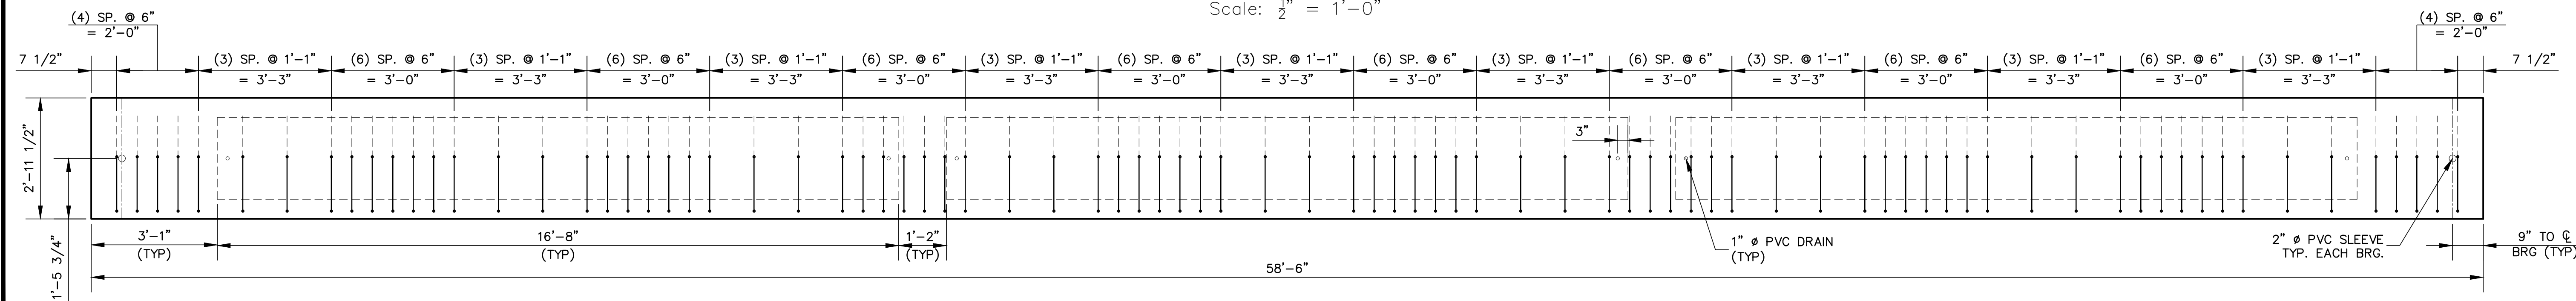


Beam B11 Plan

Scale: $\frac{1}{2}'' = 1'-0''$

designed by: LBK/OGK	date: June 2017	project no:	file name: S-11 to S-14.dwg	scale:
drawn by: LBK/BGP	approved by: JLG			
CMA ENGINEERS CIVIL/ENVIRONMENTAL/STRUCTURAL Portsmouth, NH • Manchester, NH • Portland, ME 603/431-6196 • 603/627-0708 • 207/541-4223 c m a e n g i n e e r s . c o m				
Town of Exeter Department of Public Works Court Street Little River Bridge Replacement Prestressed Box Beam Details (Sheet 3 of 3)				
drawing no. B-14				
sheet: 15 of 34				
no.	revision	date	by	JLG
A	ISSUED FOR CONSTRUCTION	6/3/17		

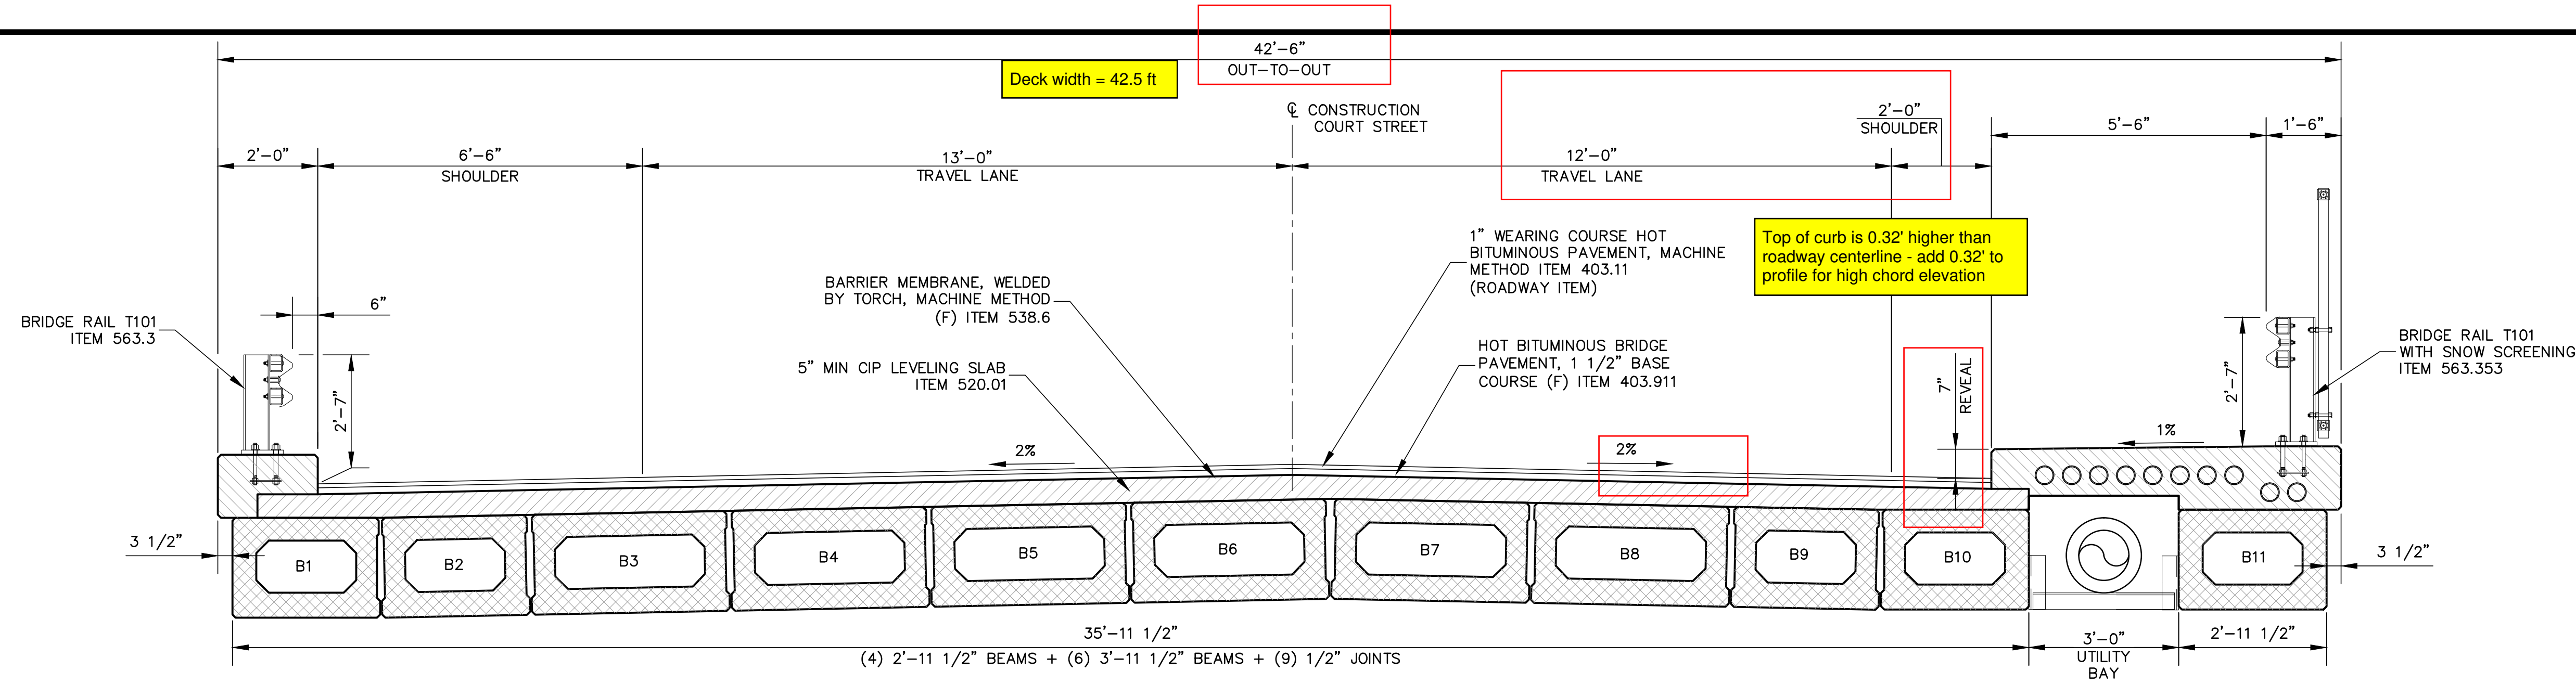


Typical Deck Section
Scale: 1/2" = 1'-0"

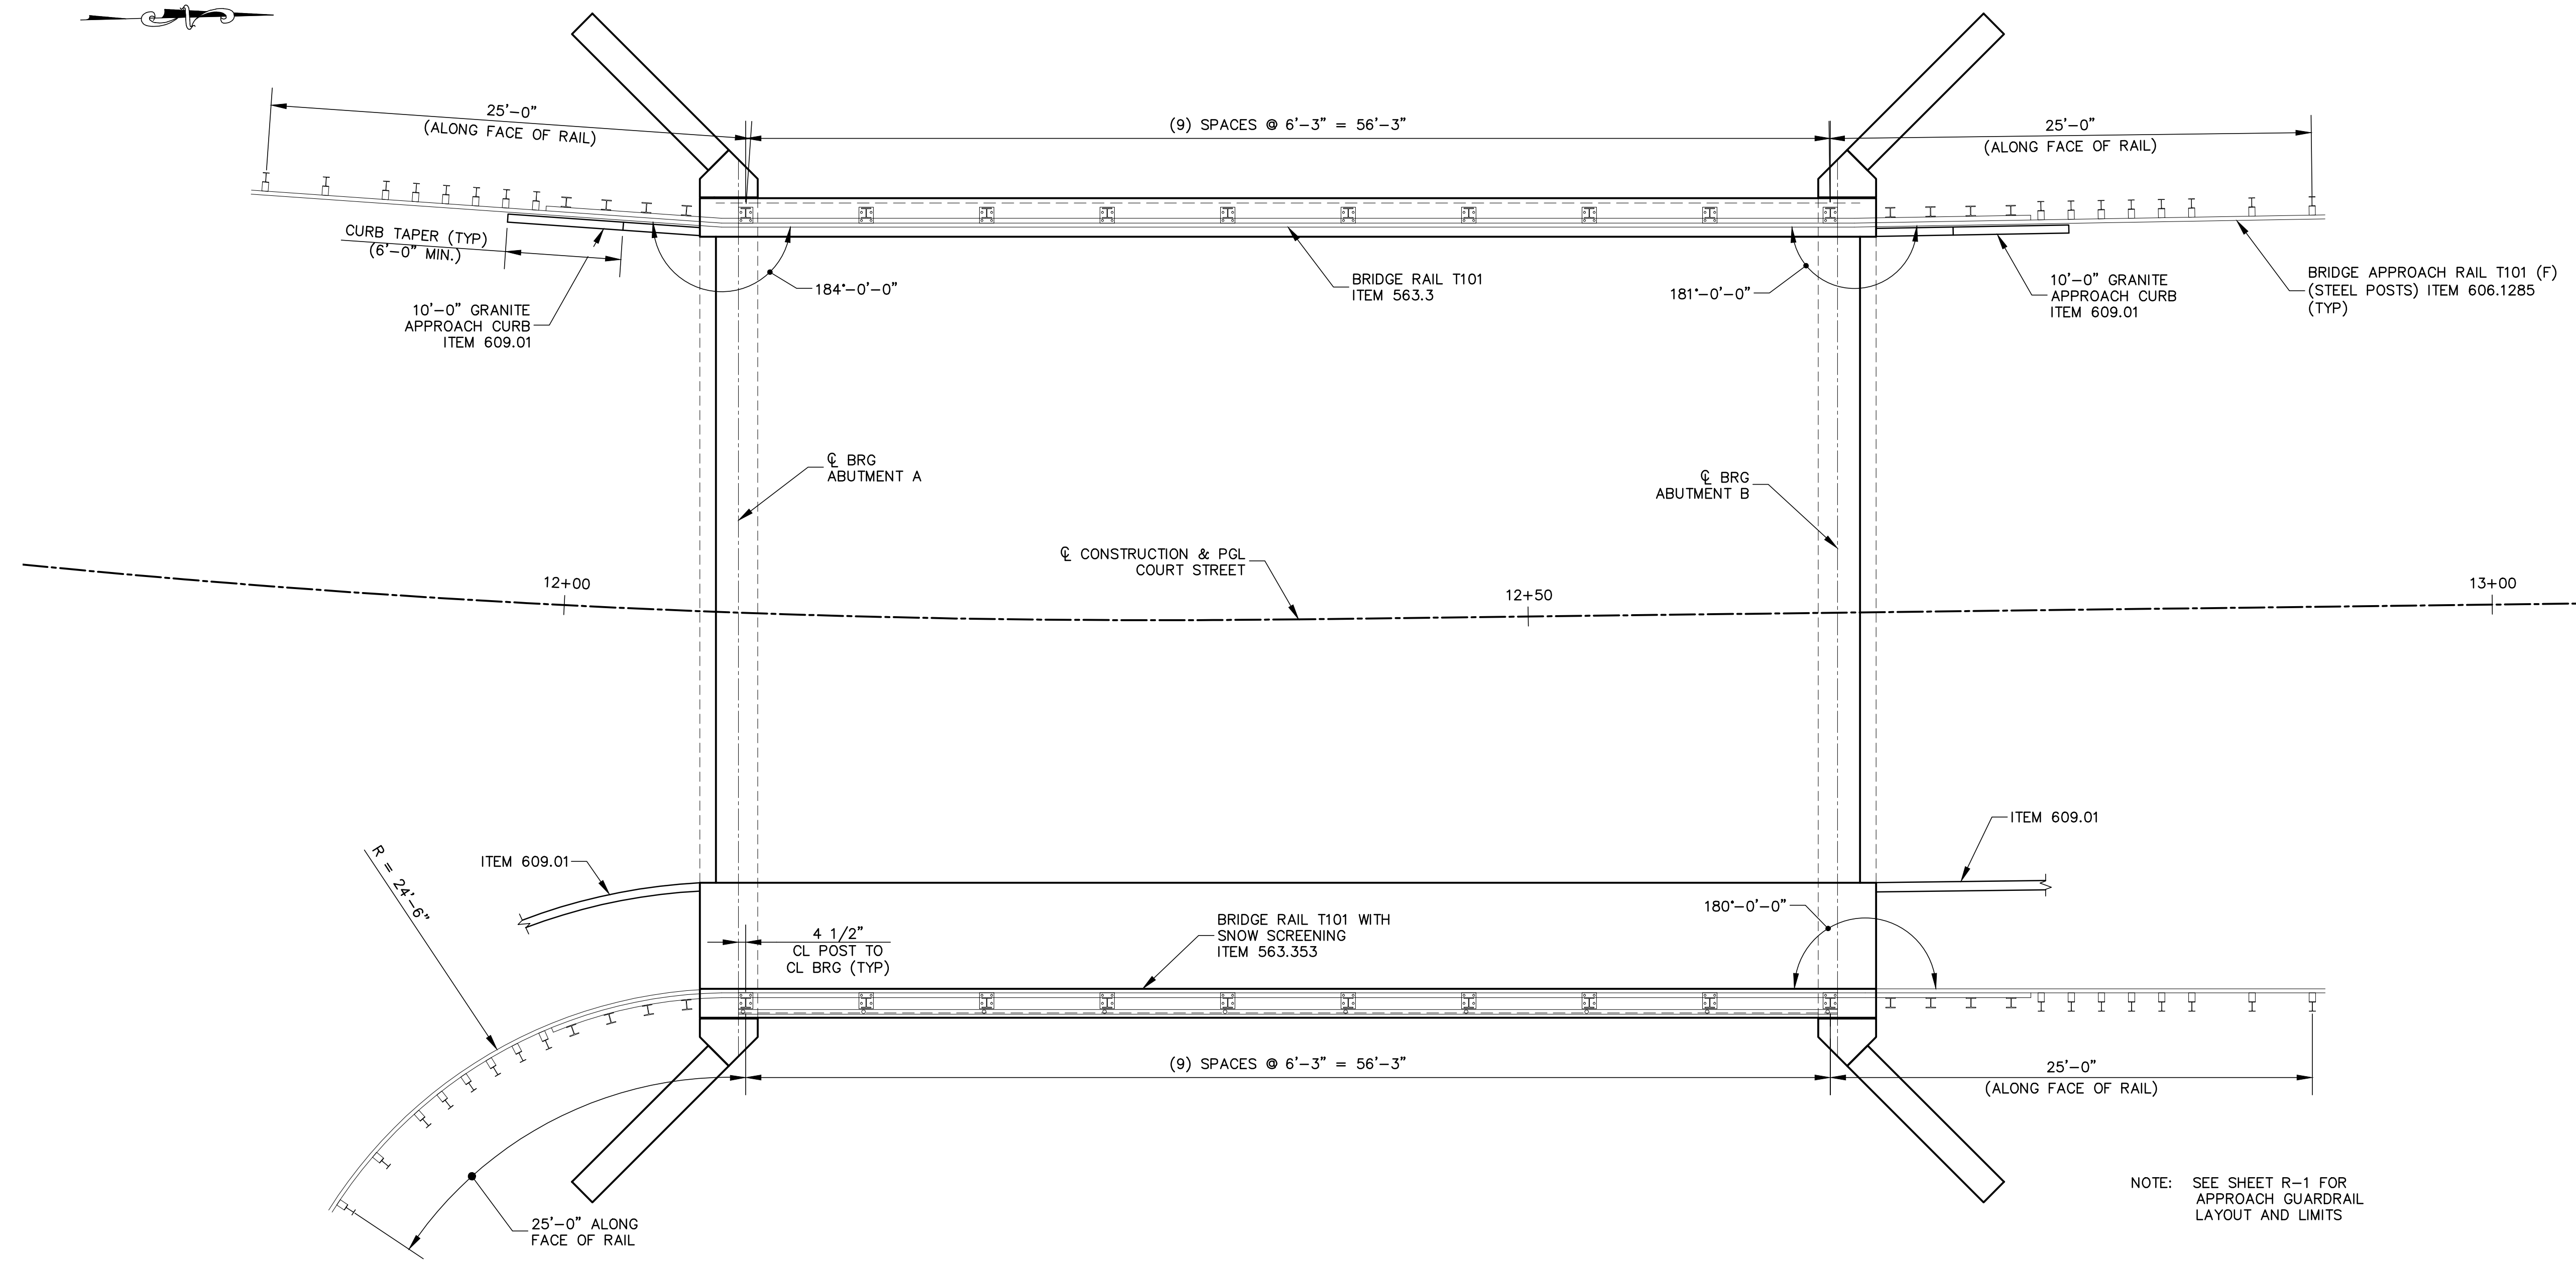


Rail Layout Plan
Scale: 1" = 5'-0"


designed by: LBK/OGK		drawn by: LBK/BGP		approved by: JLG	
date: June 2017		project no: S-15.010		file name: S-15.dwg	
scale:		scale:		scale:	
<p>Town of Exeter Department of Public Works Court Street Little River Bridge Replacement Typical Section and Rail Layout</p>					
drawing no. B-15					
sheet: 16 of 34					
<p>CMA ENGINEERS CIVIL/ENVIRONMENTAL/STRUCTURAL Portland, ME • 603/627-0708 • 207/541-4223 Manchester, NH • 603/627-0708 • 207/541-4223 Portsmouth, NH • 603/431-6196</p>					
<p>ISSUED FOR CONSTRUCTION</p>					
<p>6/13/17 JLG date by</p>					

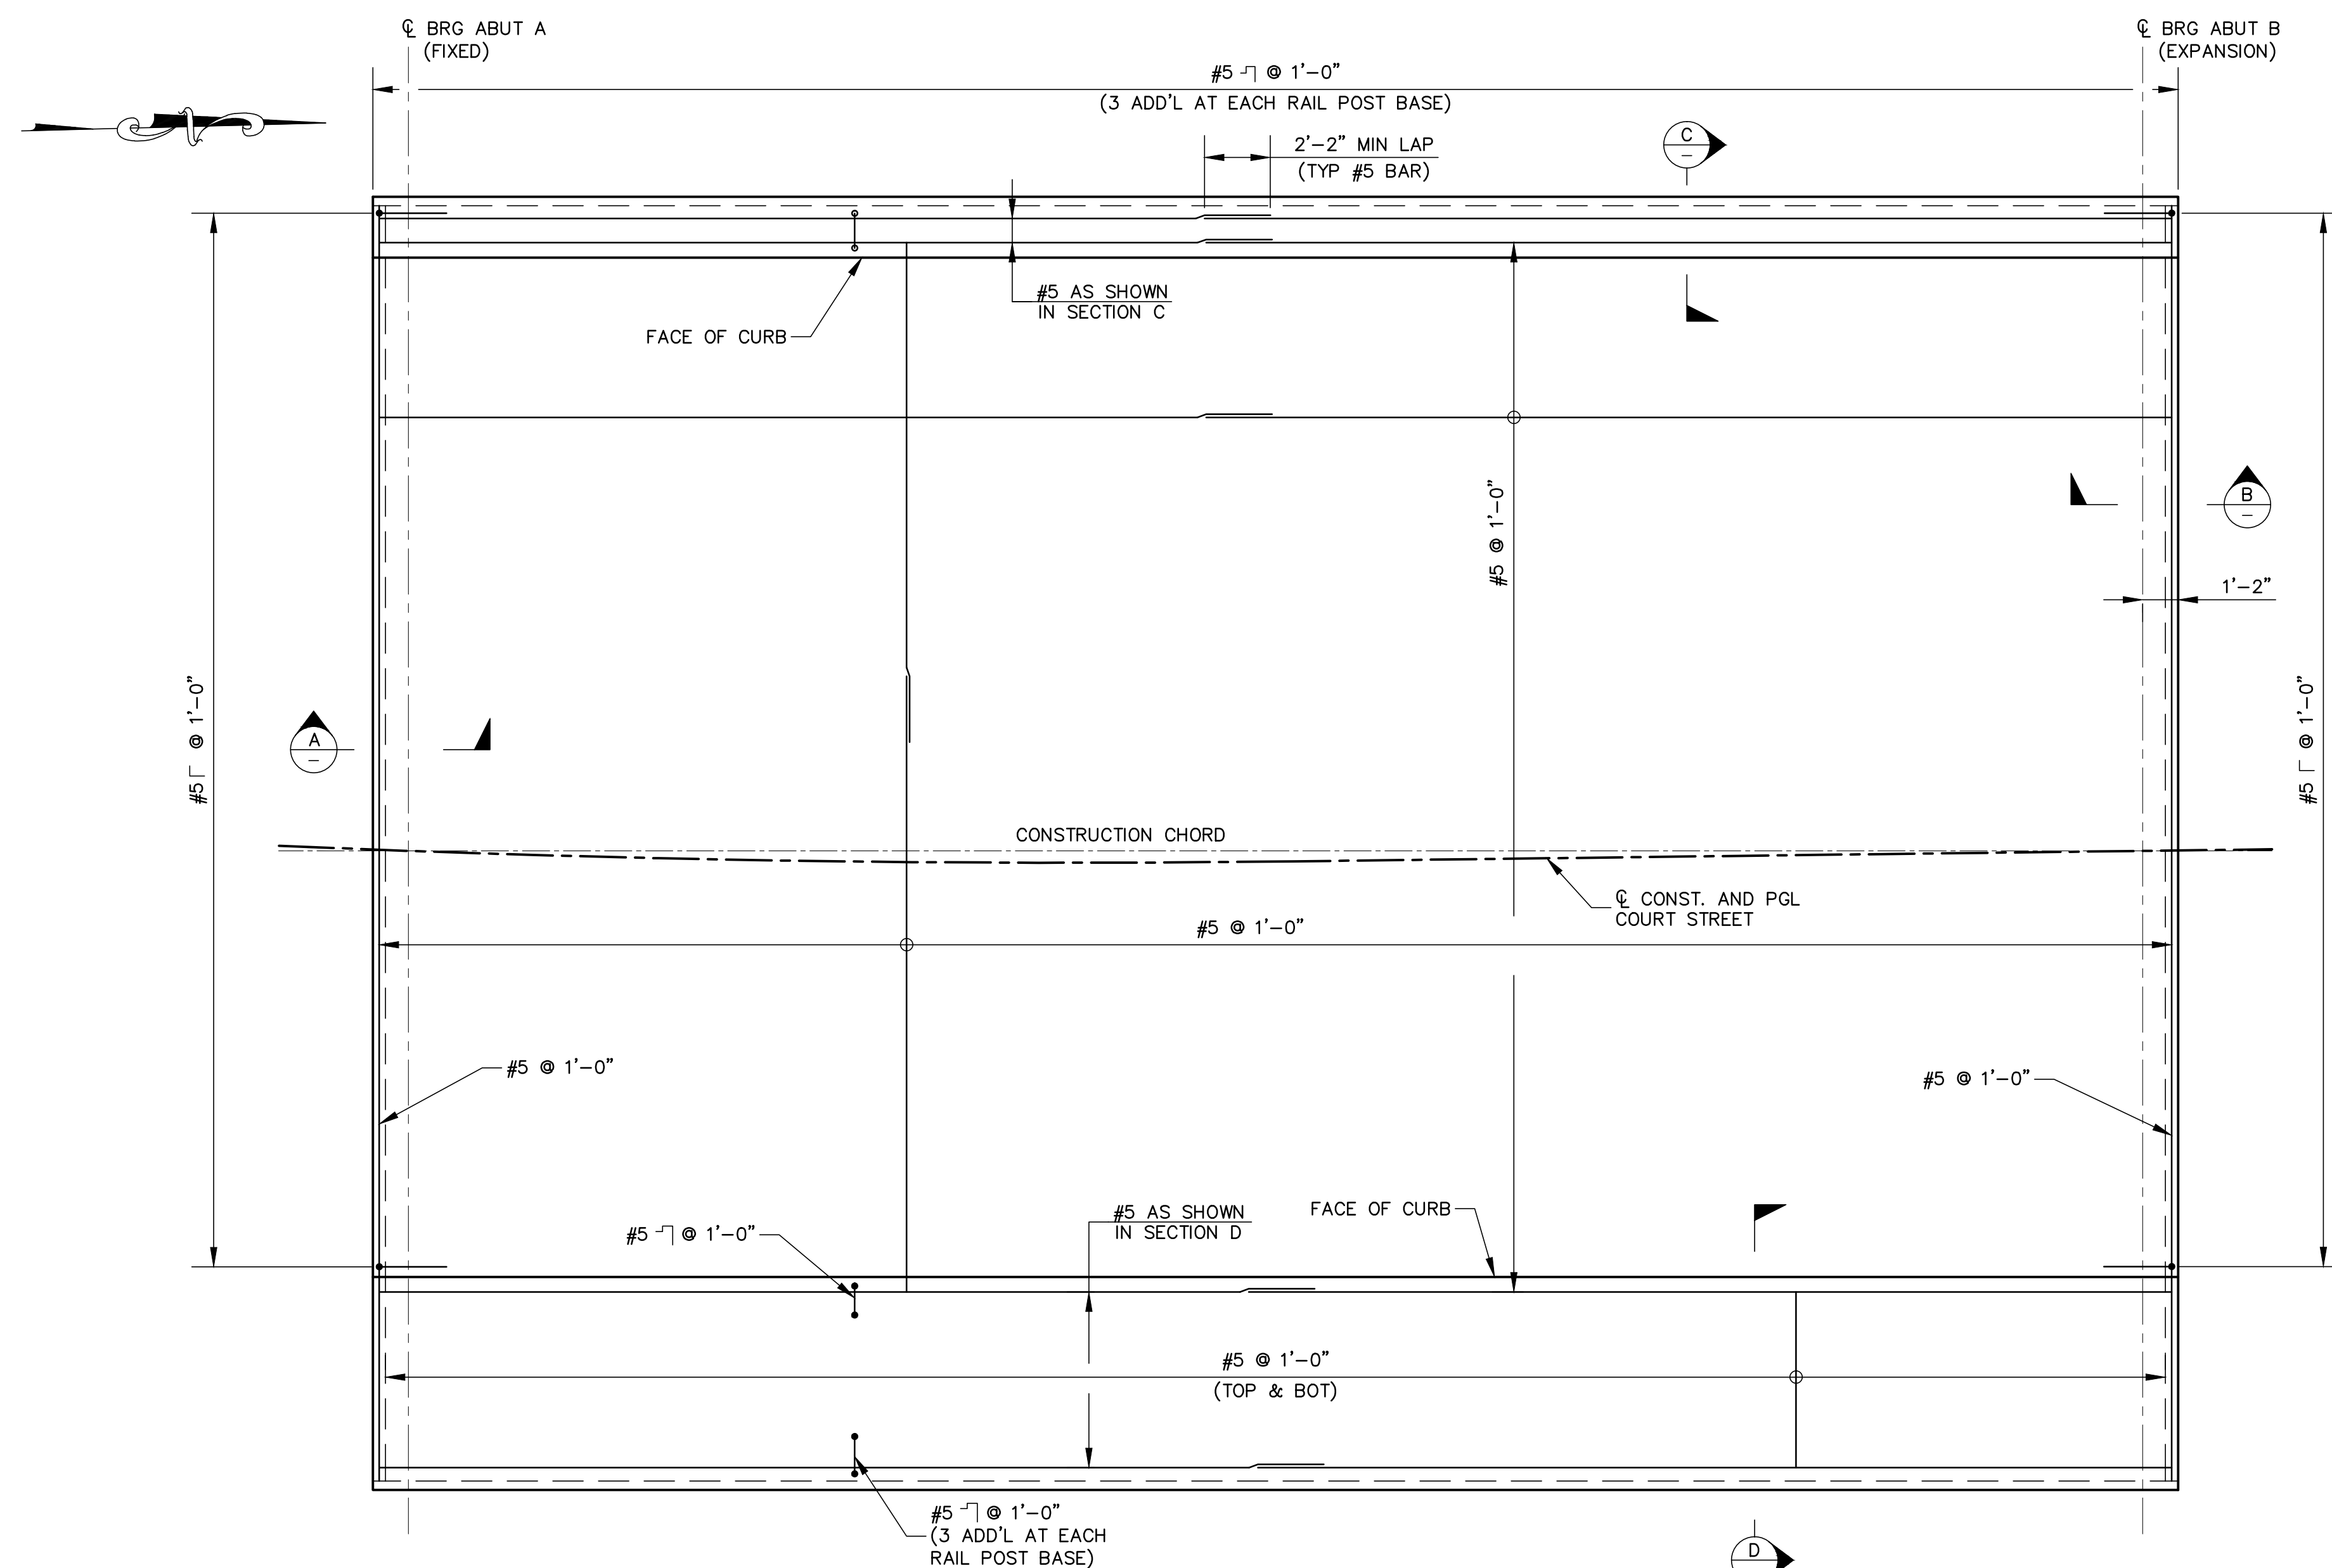


Overlay and Curb Reinforcing Plan
Scale: 1/4"=1'-0"

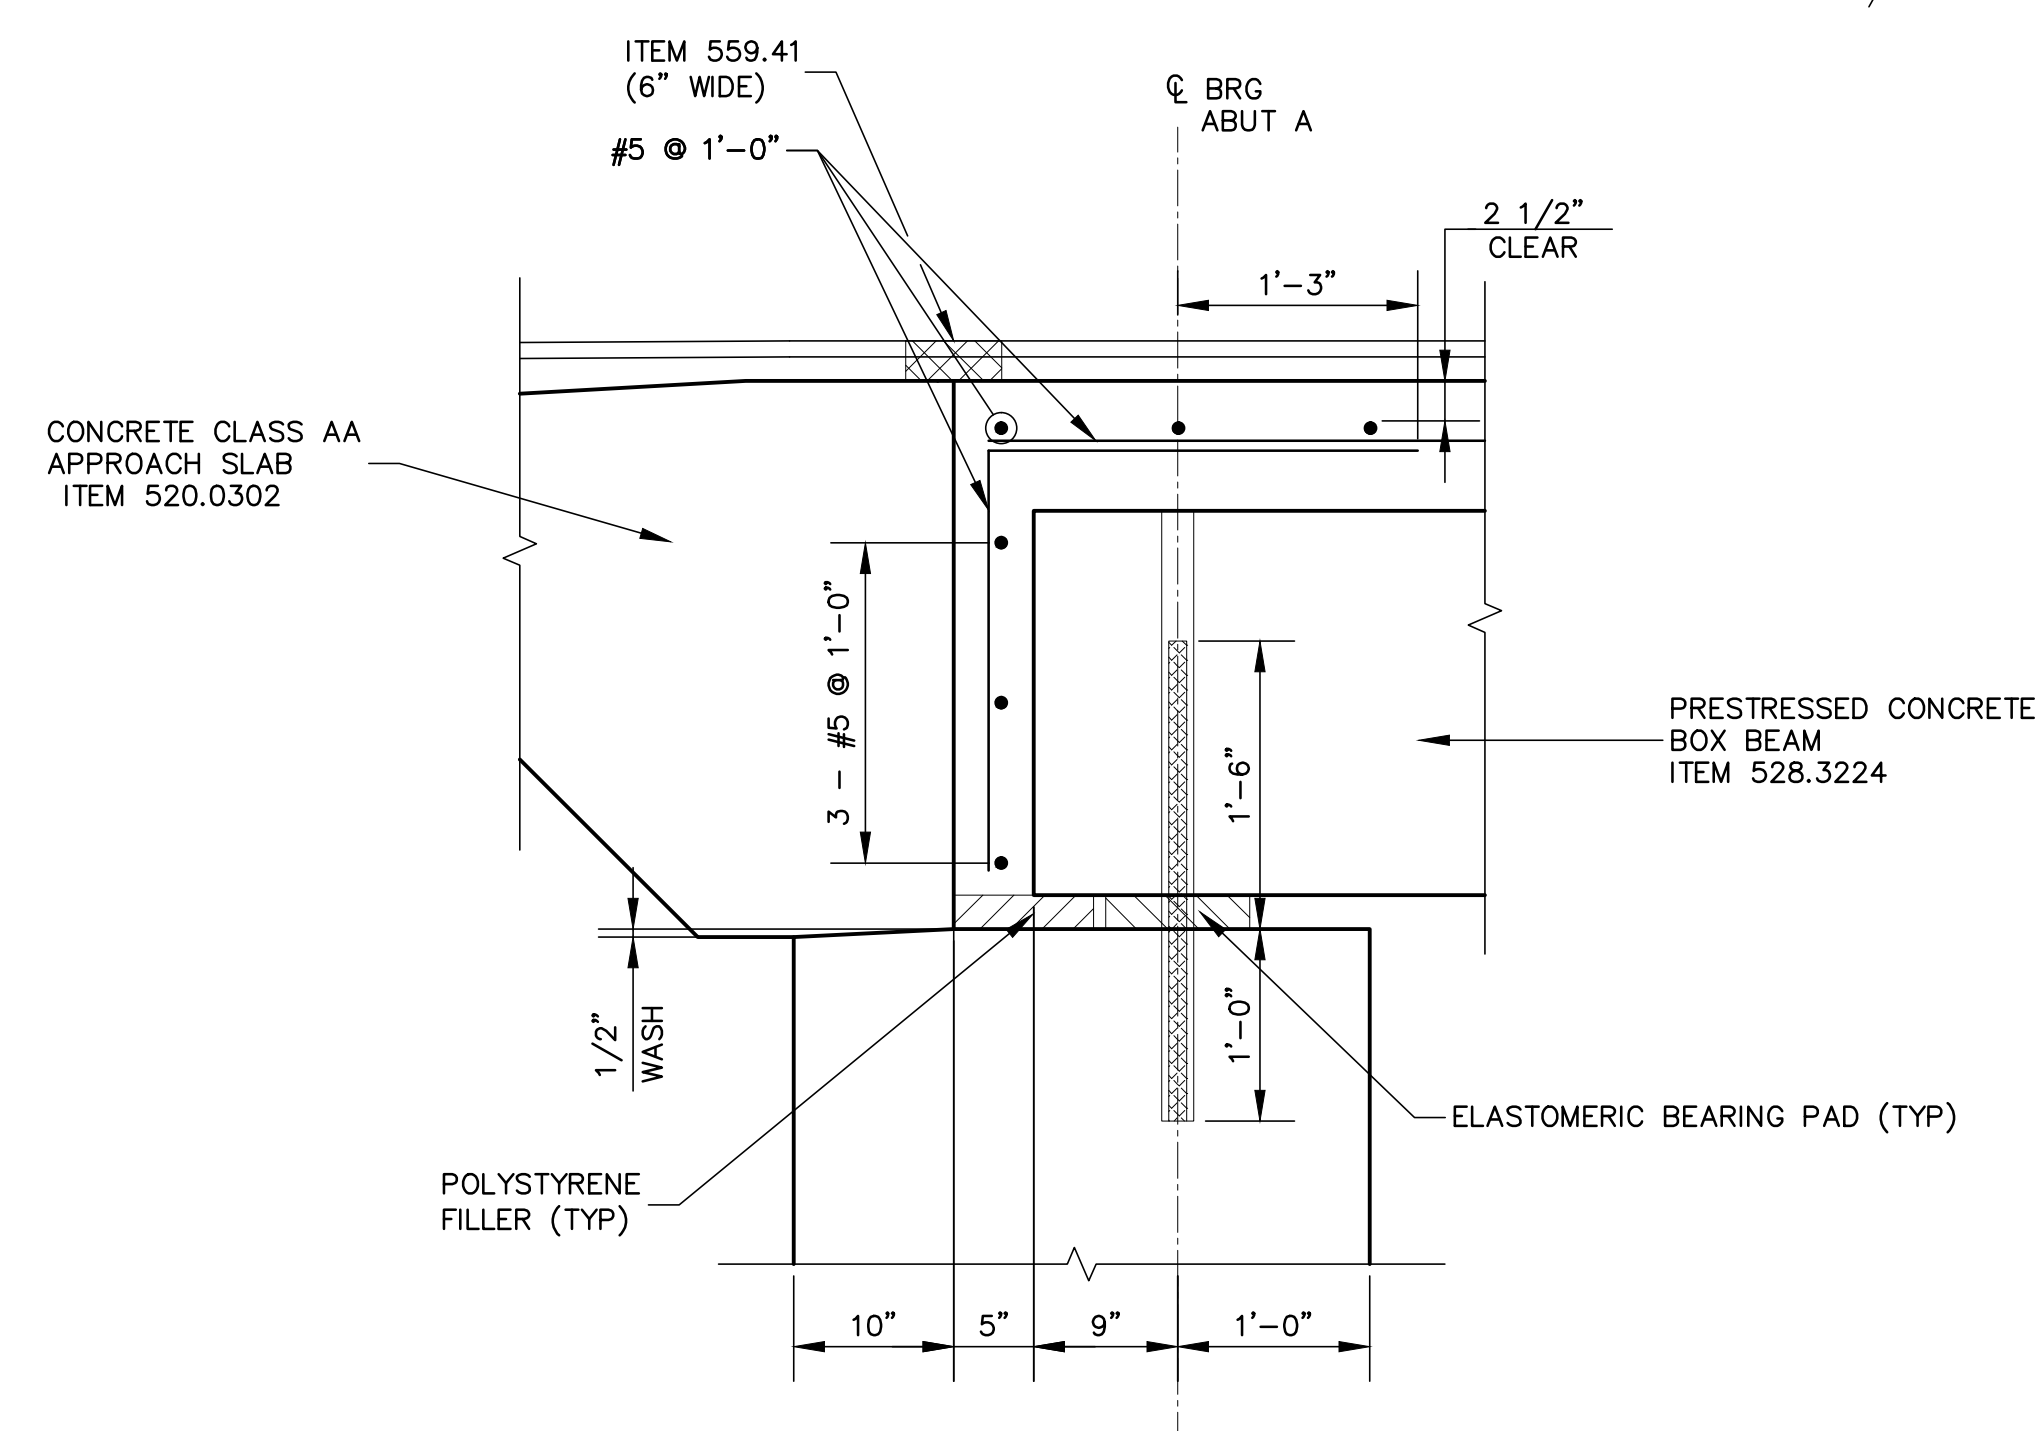

Section A
Scale: 1"=1'-0"

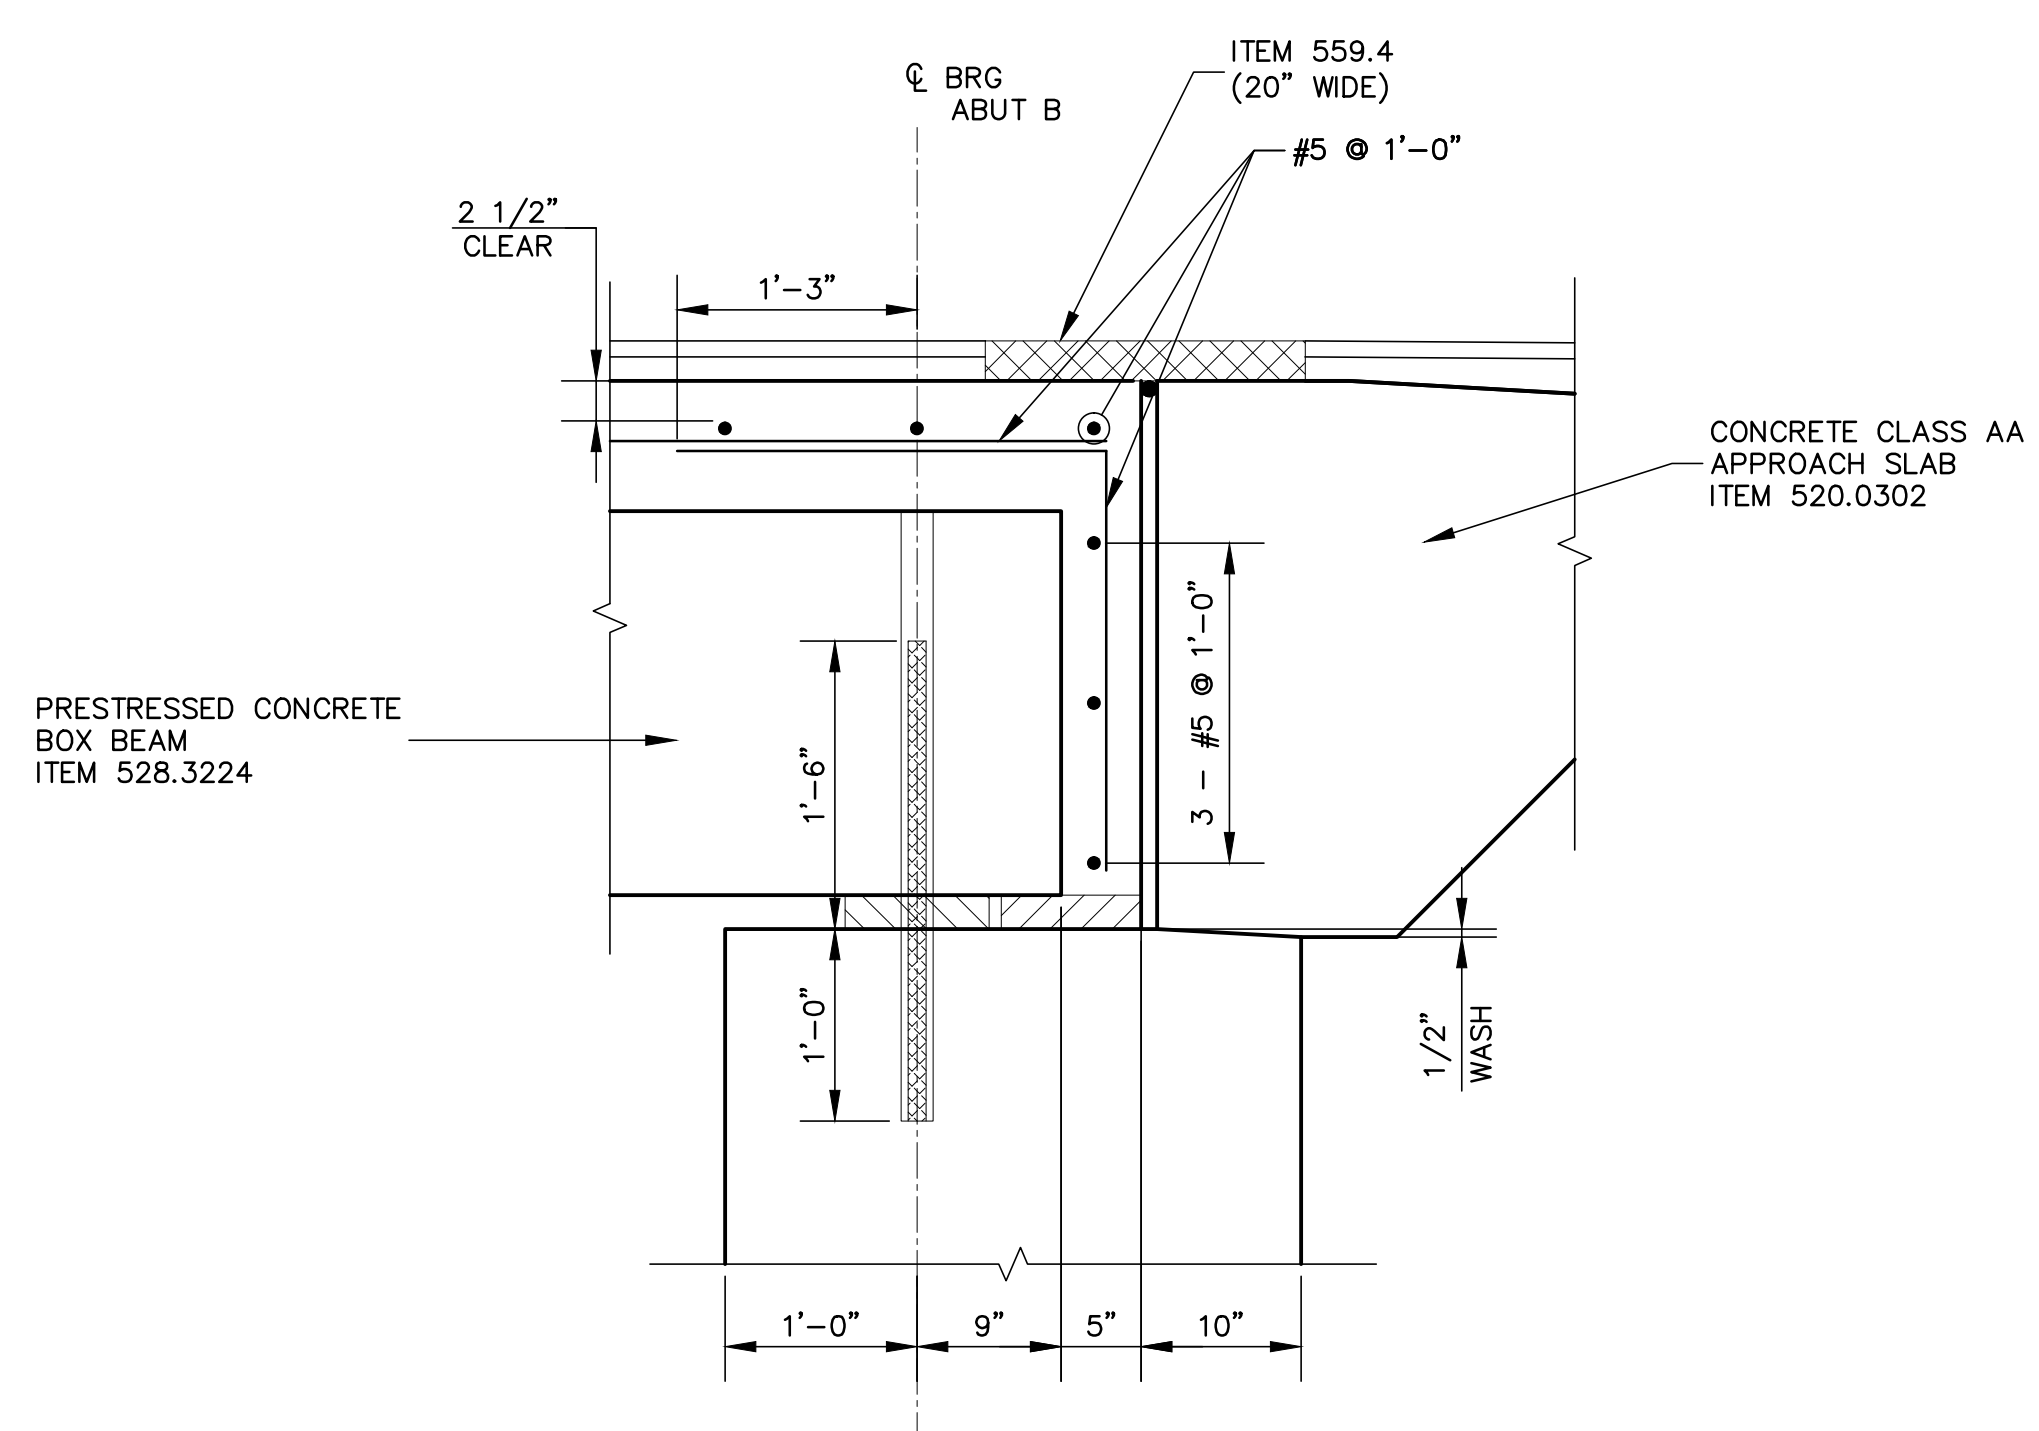


Section B
Scale: 1"=1'-0"

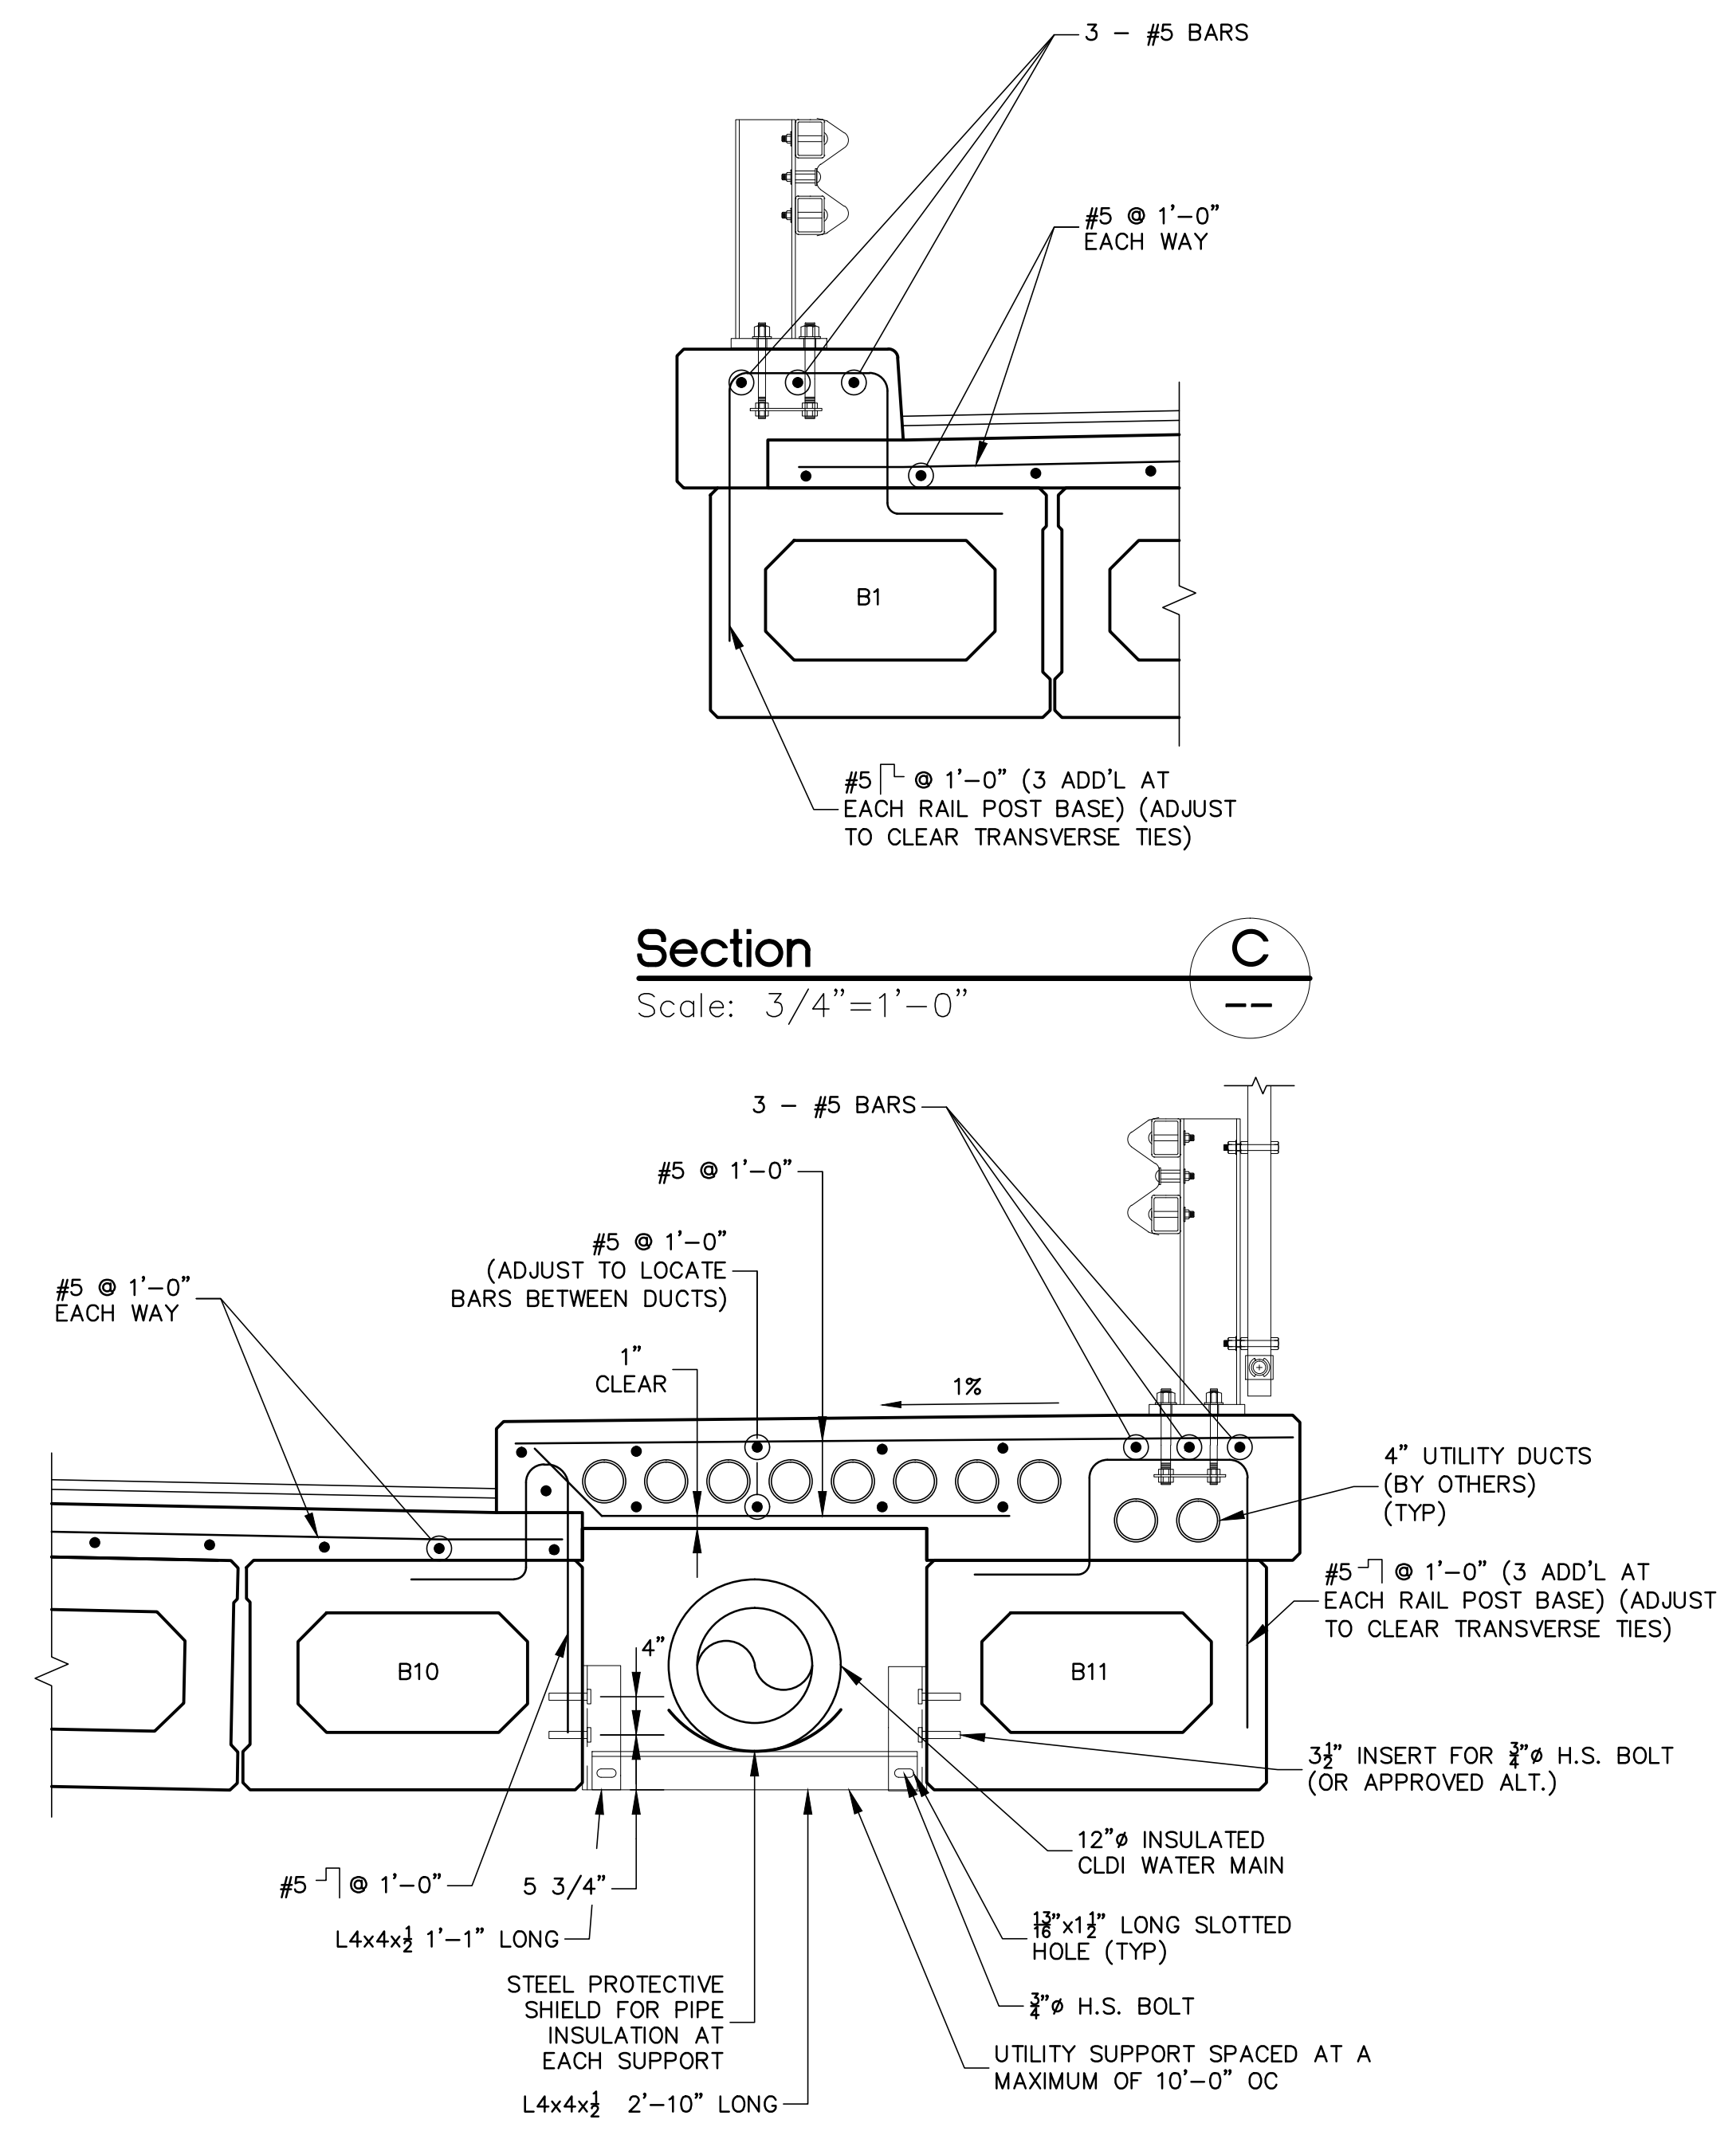

Section C
Scale: 3/4"=1'-0"


Section D
Scale: 3/4"=1'-0"

		designed by: LBK/OGK	date: June 2017
drawn by: LBK/BGP		project no.: -----	project name: S-16.dwg
approved by: JLG		scale: -----	drawing no.: B-16
Town of Exeter Department of Public Works Court Street Little River Bridge Replacement Superstructure Details			
CMA ENGINEERS CIVIL/ENVIRONMENTAL/STRUCTURAL Portsmouth, NH • Manchester, NH • Portland, ME 603/431-6196 • 603/627-0708 • 207/541-4223 c m a e n g i n e e r s . c o m		no. A	ISSUED FOR CONSTRUCTION 6/13/17 JLG date by
sheet: 17 of 34			

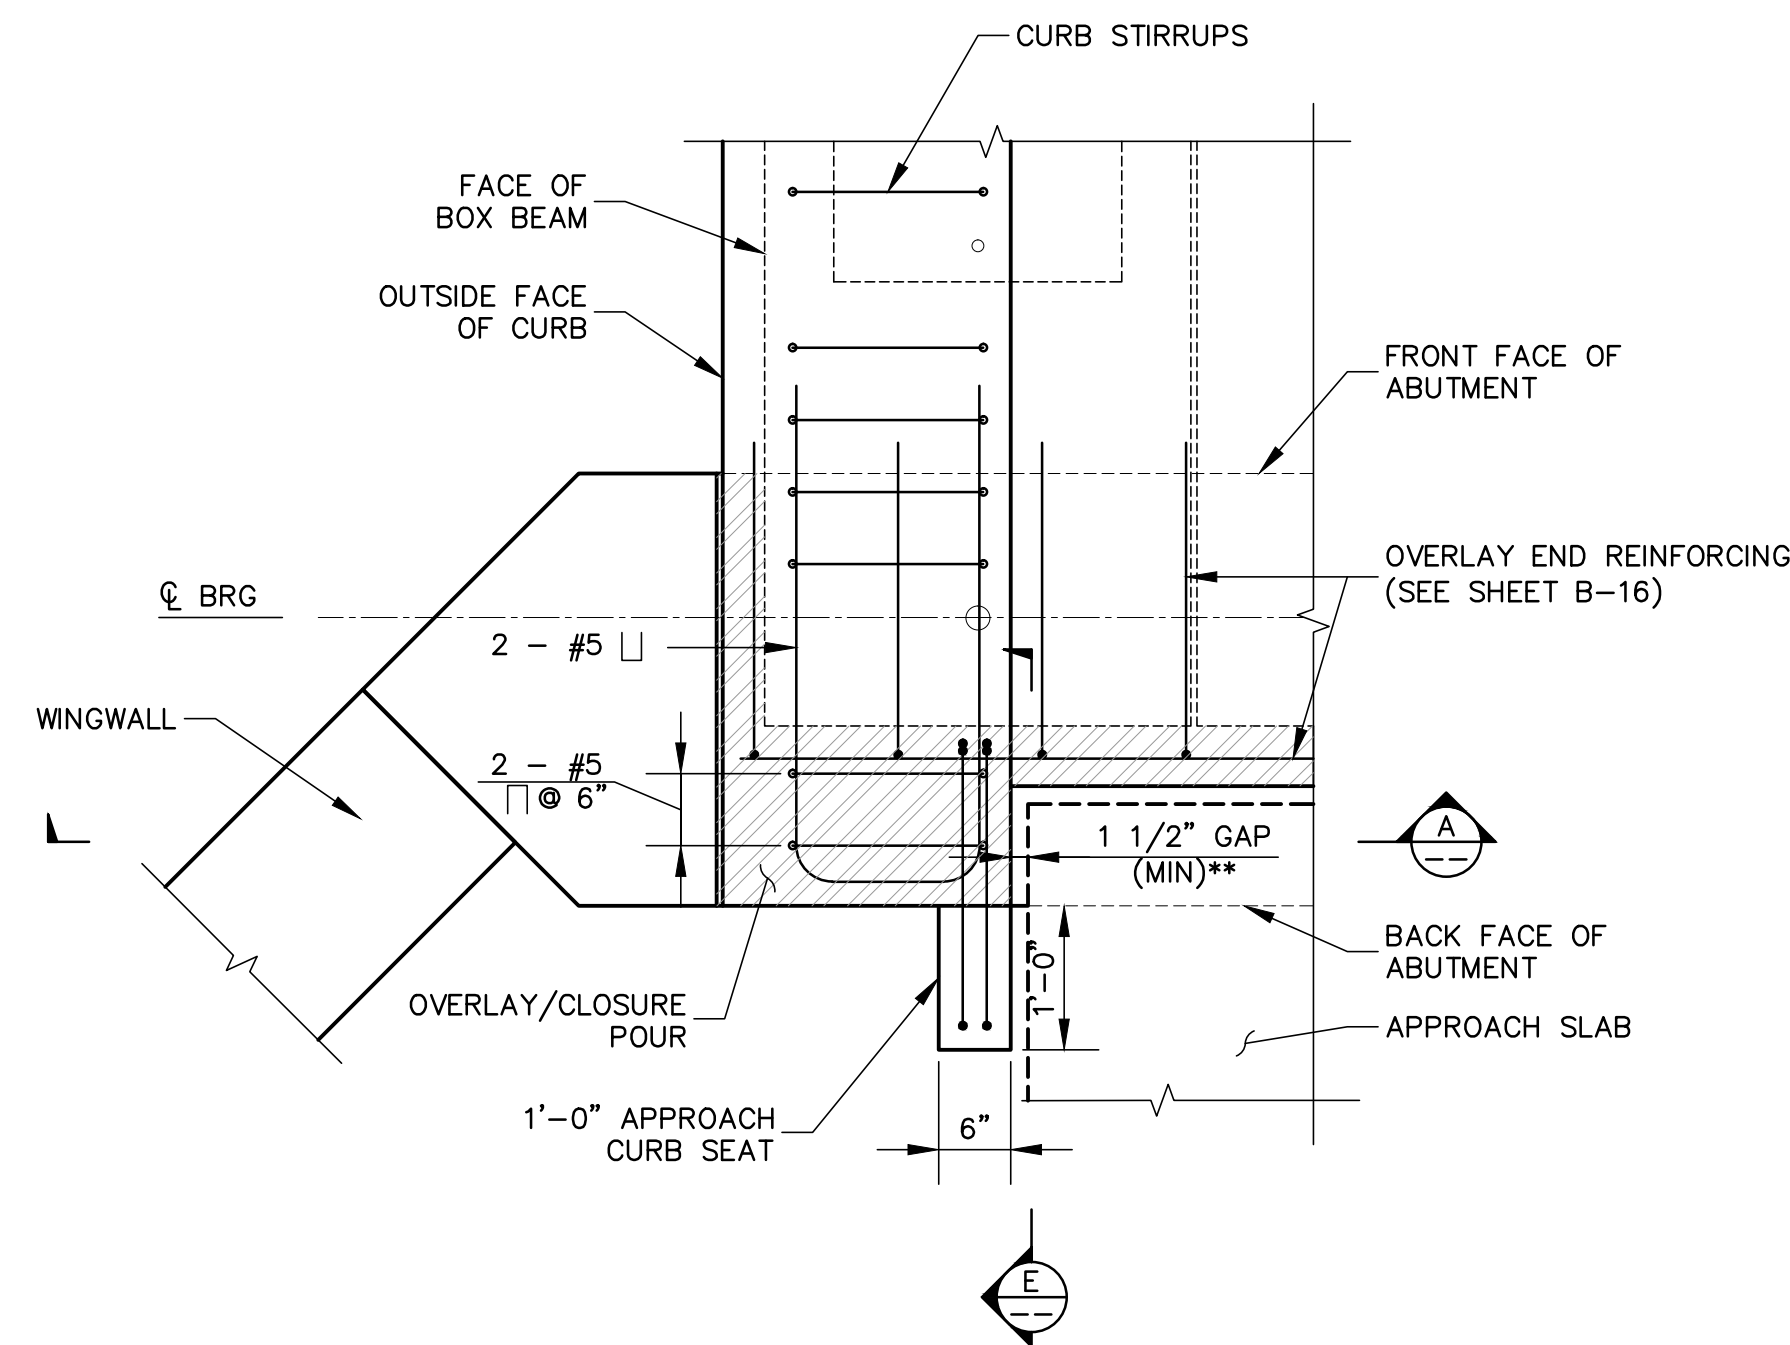


Closure Pour Detail 1

Scale: 3/4"=1'-0"

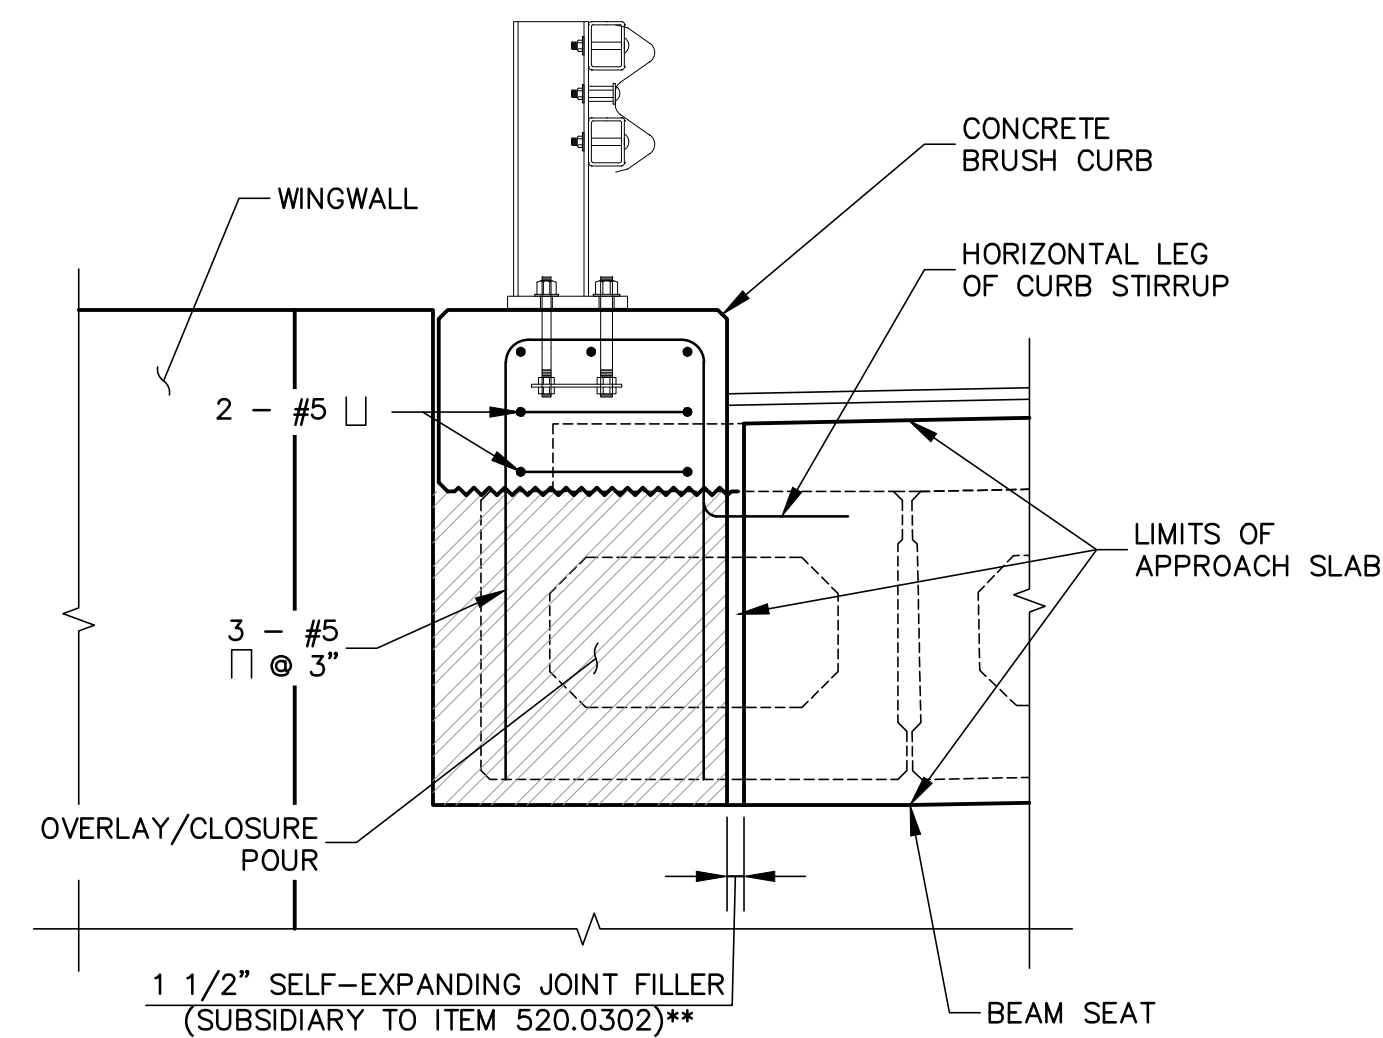


Section A

Scale: 3/4"=1'-0"

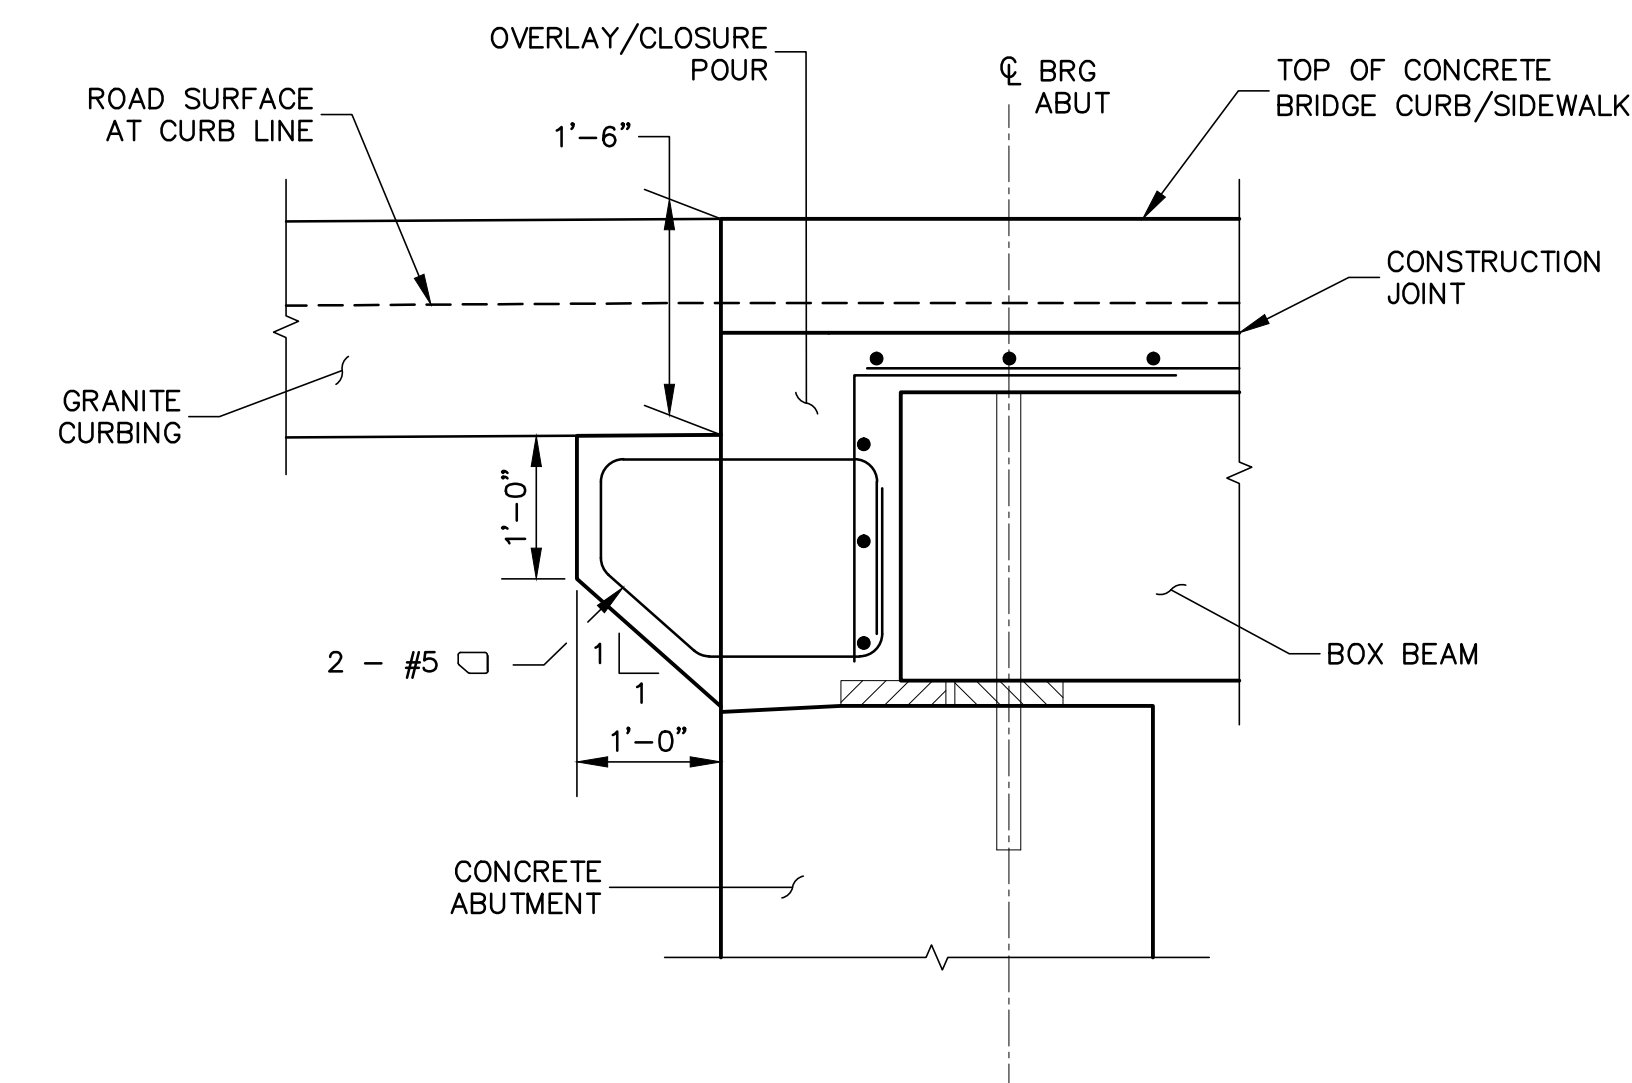


Section E

Scale: 3/4"=1'-0"

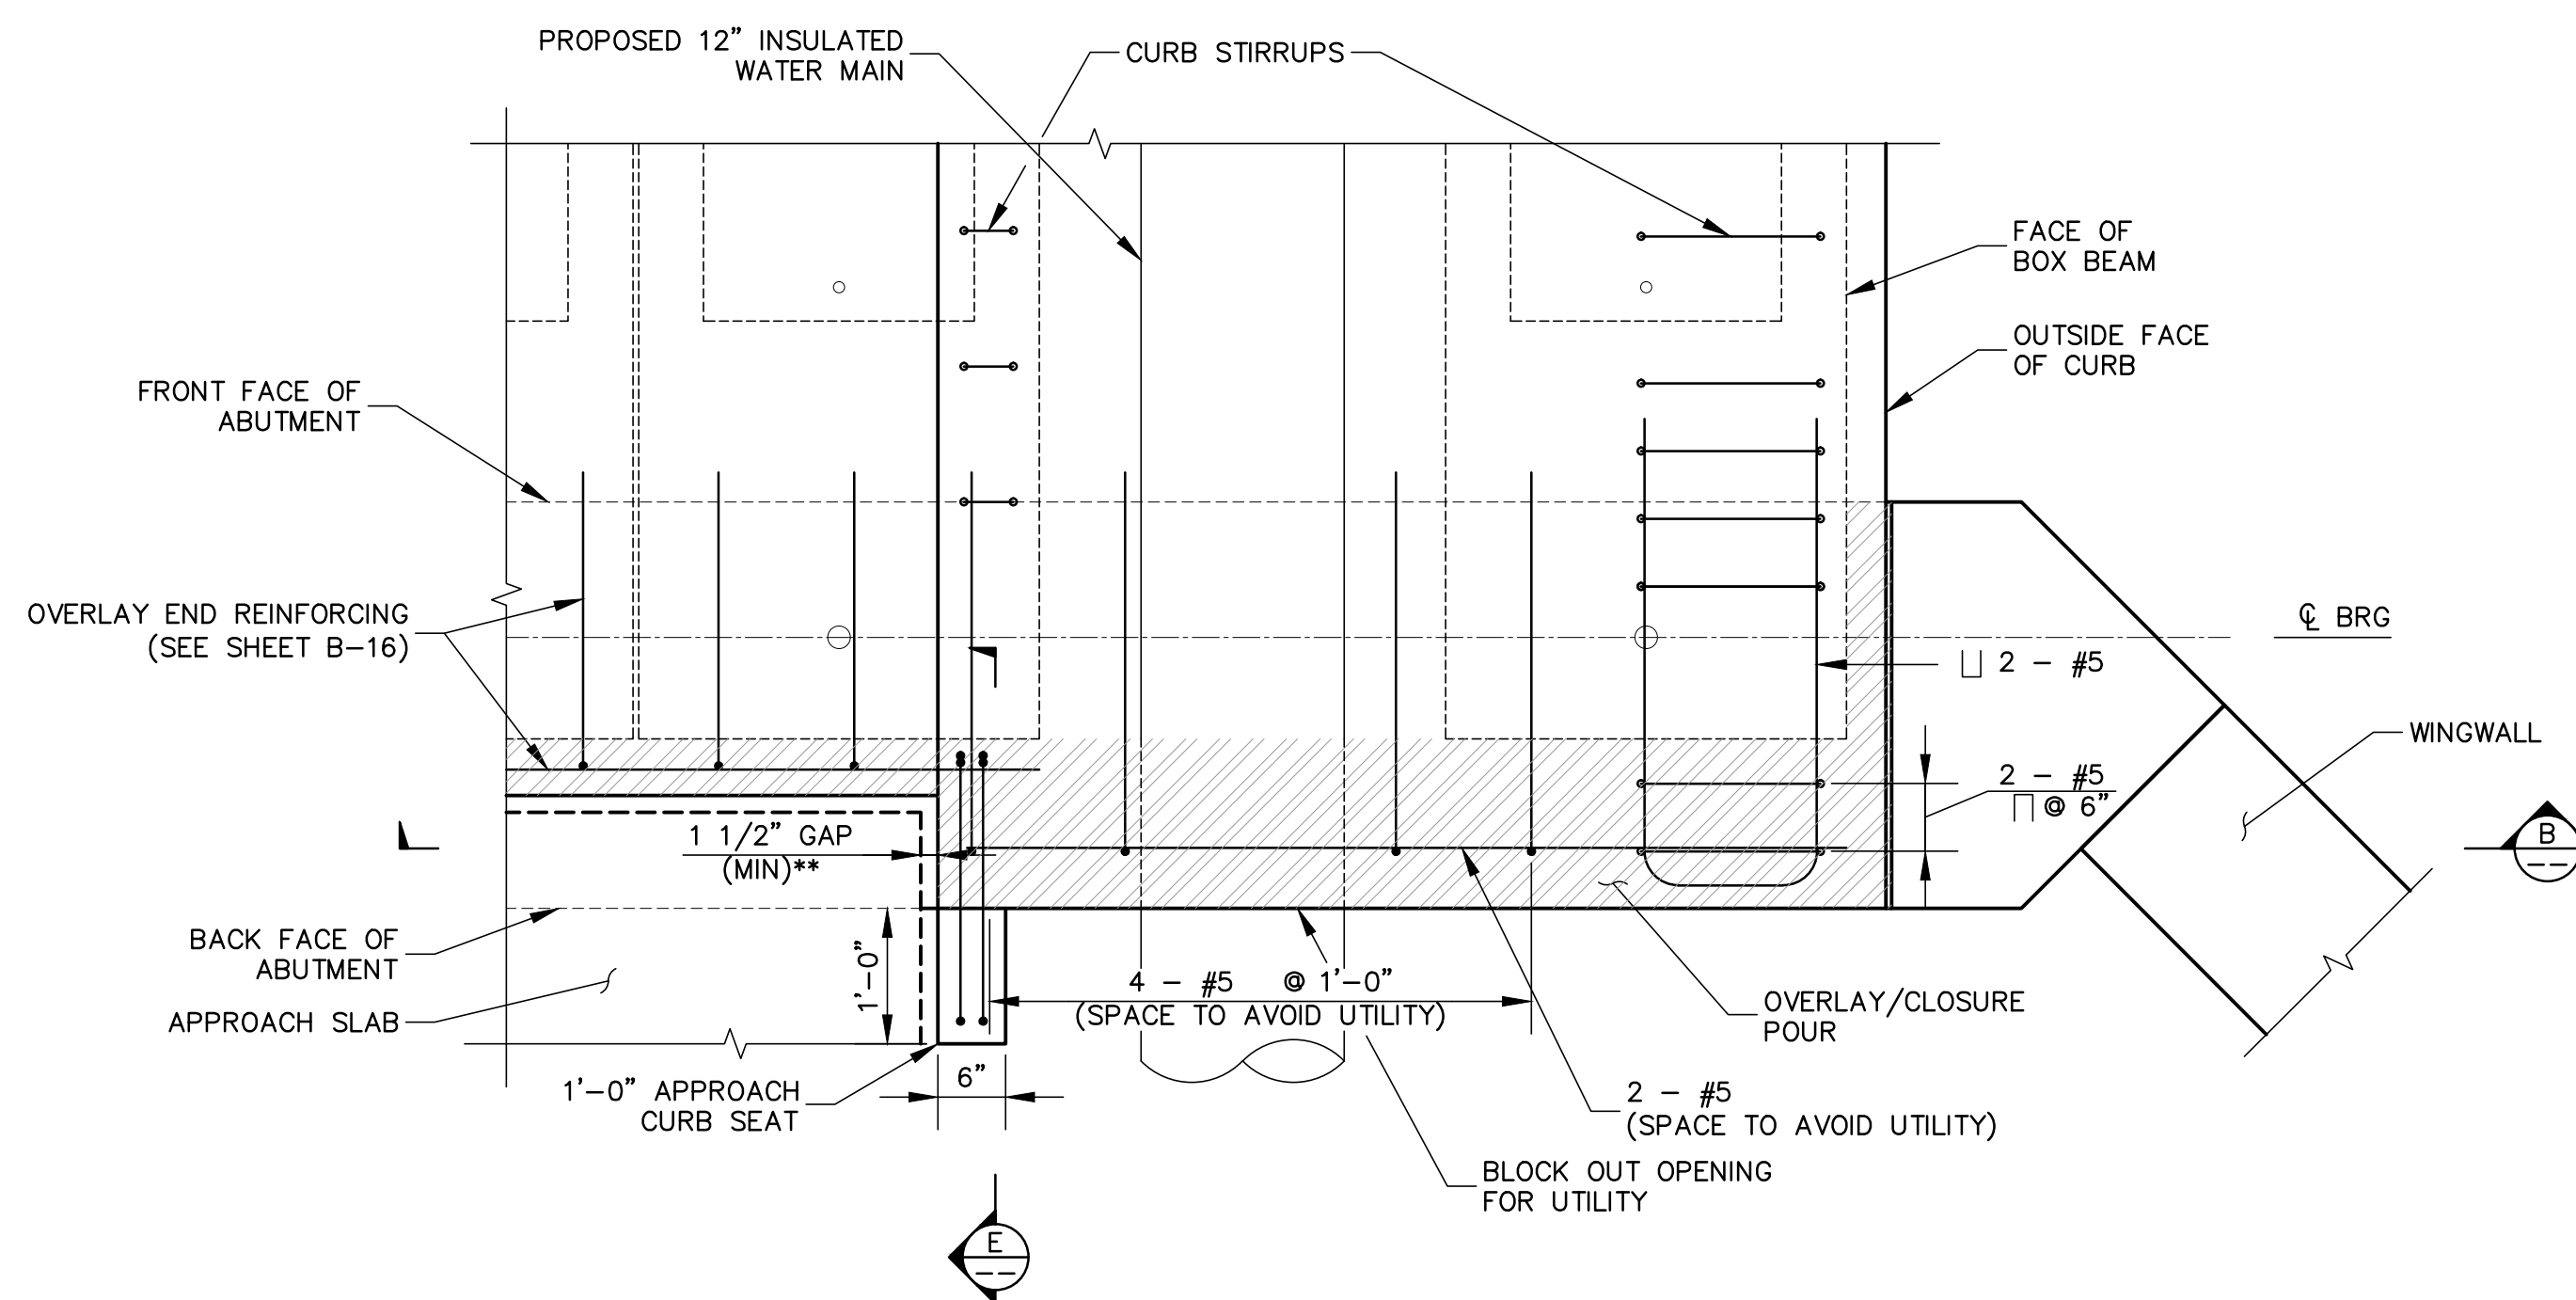

Closure Pour Detail 2

Scale: 3/4"=1'-0"

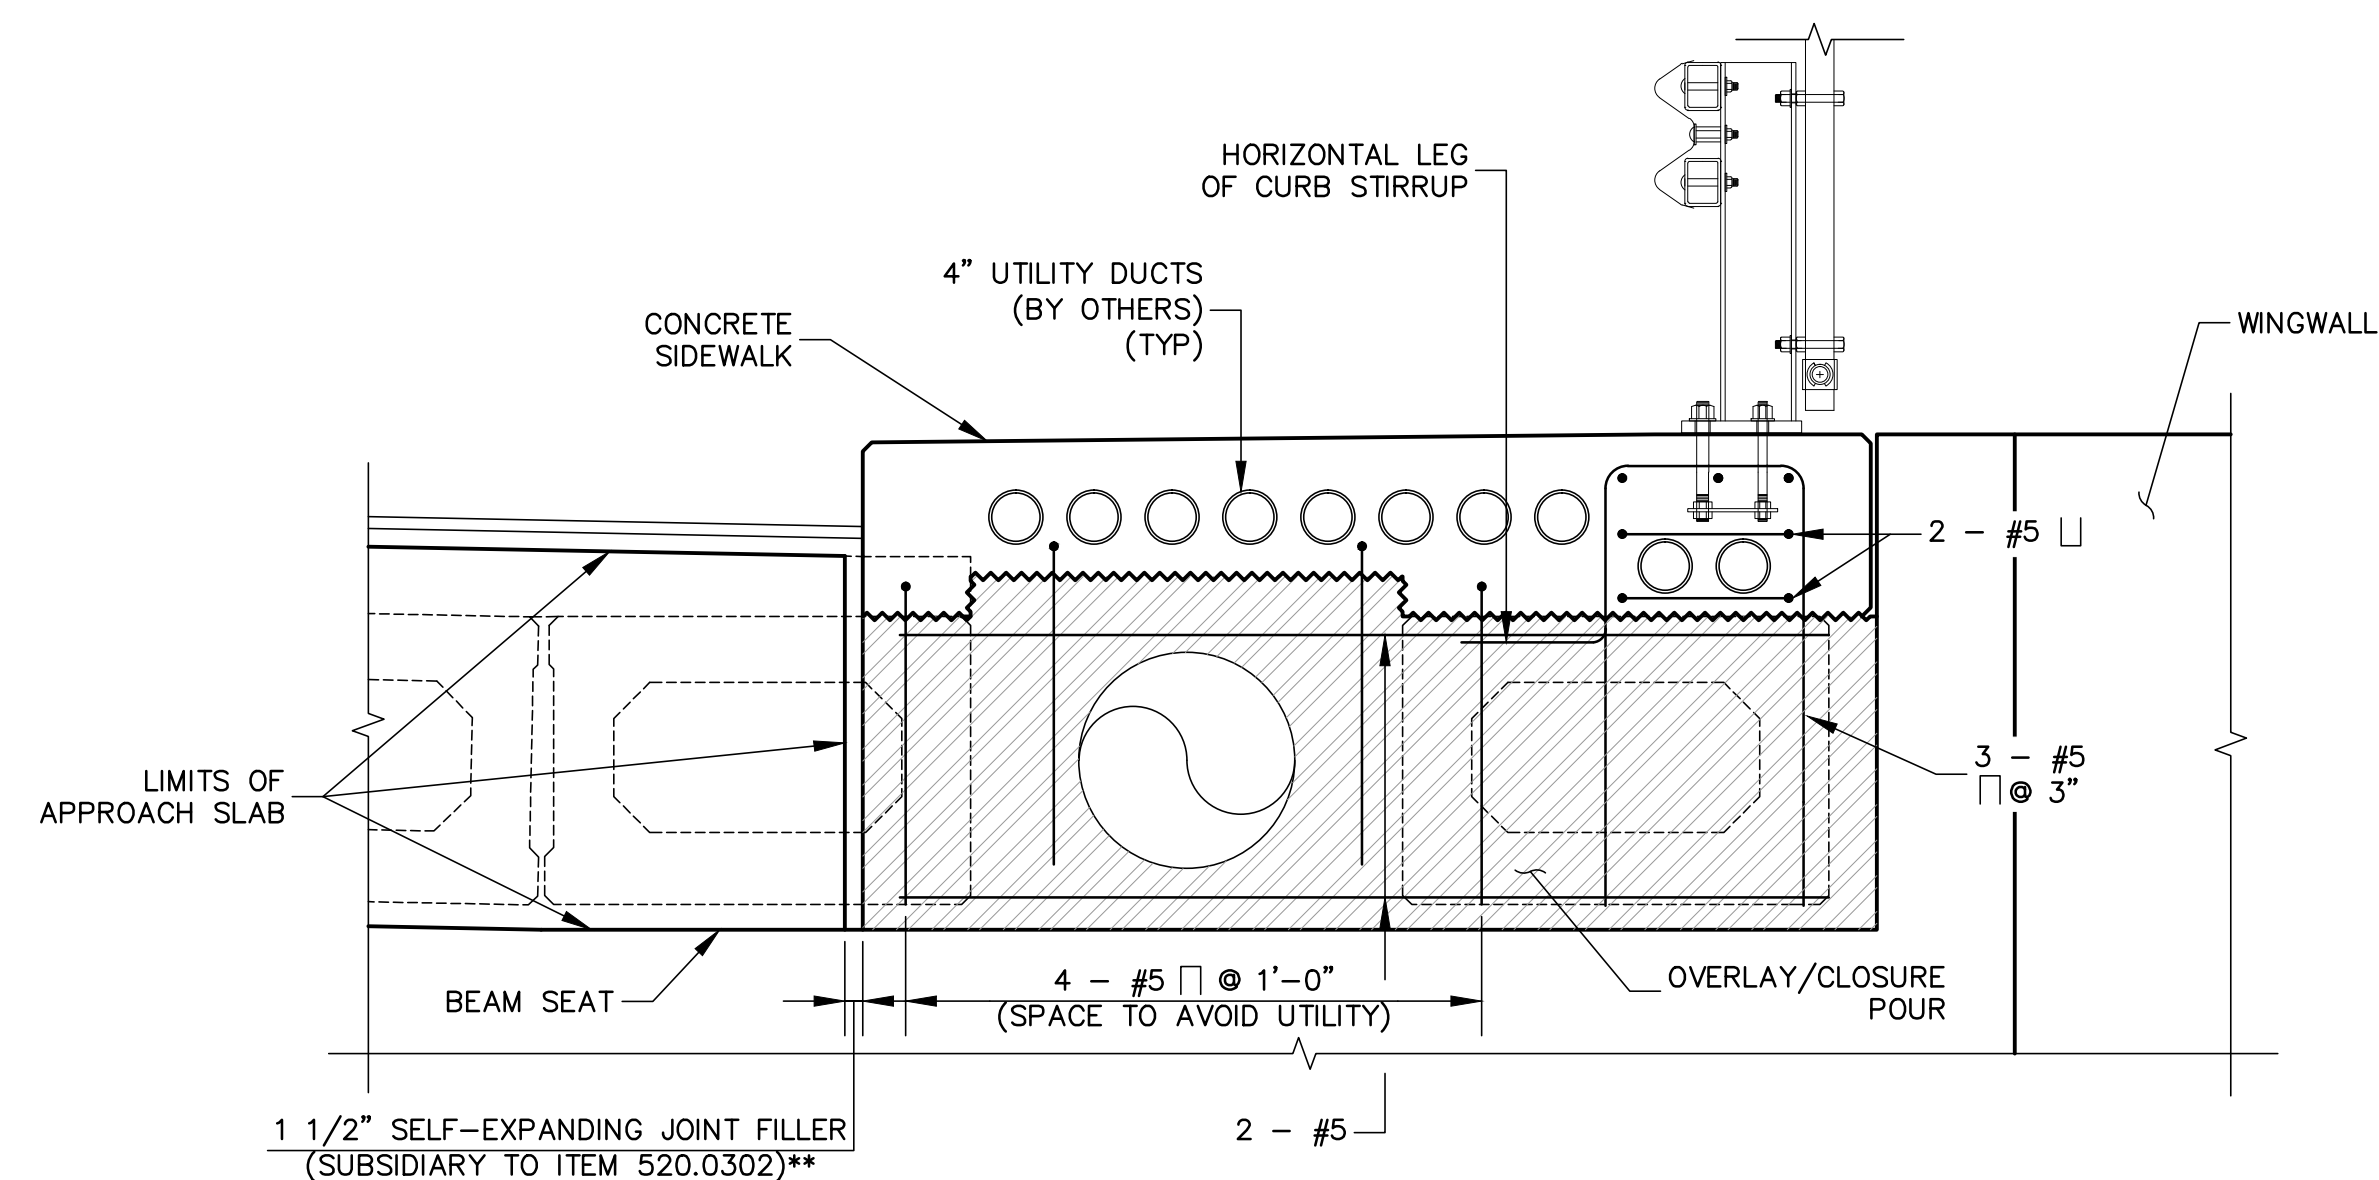

Section B

Scale: 3/4"=1'-0"


** GAP AT ABUTMENT B ONLY (EXPANSION).
OMIT GAP AT ABUTMENT A (FIXED)

no.	revisions	date	by
A	ISSUED FOR CONSTRUCTION	6/13/17	JLG

CMA ENGINEERS
Civil/Environmental/Structural


Portland, ME 207/541-4223
Manchester, NH 603/627-0708
Portsmouth, NH 603/431-6196

cm a e n g i n e e r s . c o m

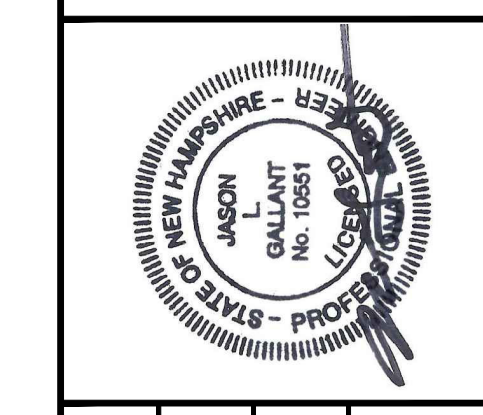


date:	June 2017
designed by:	LBK/OGK
drawn by:	LBK/BGP
approved by:	JLG
project no.:	-----
file name:	S-18.dwg
scale:	-----


Town of Exeter
Department of Public Works
Court Street
Little River Bridge Replacement
Approach Slab Details
(Sheet 2 of 2)

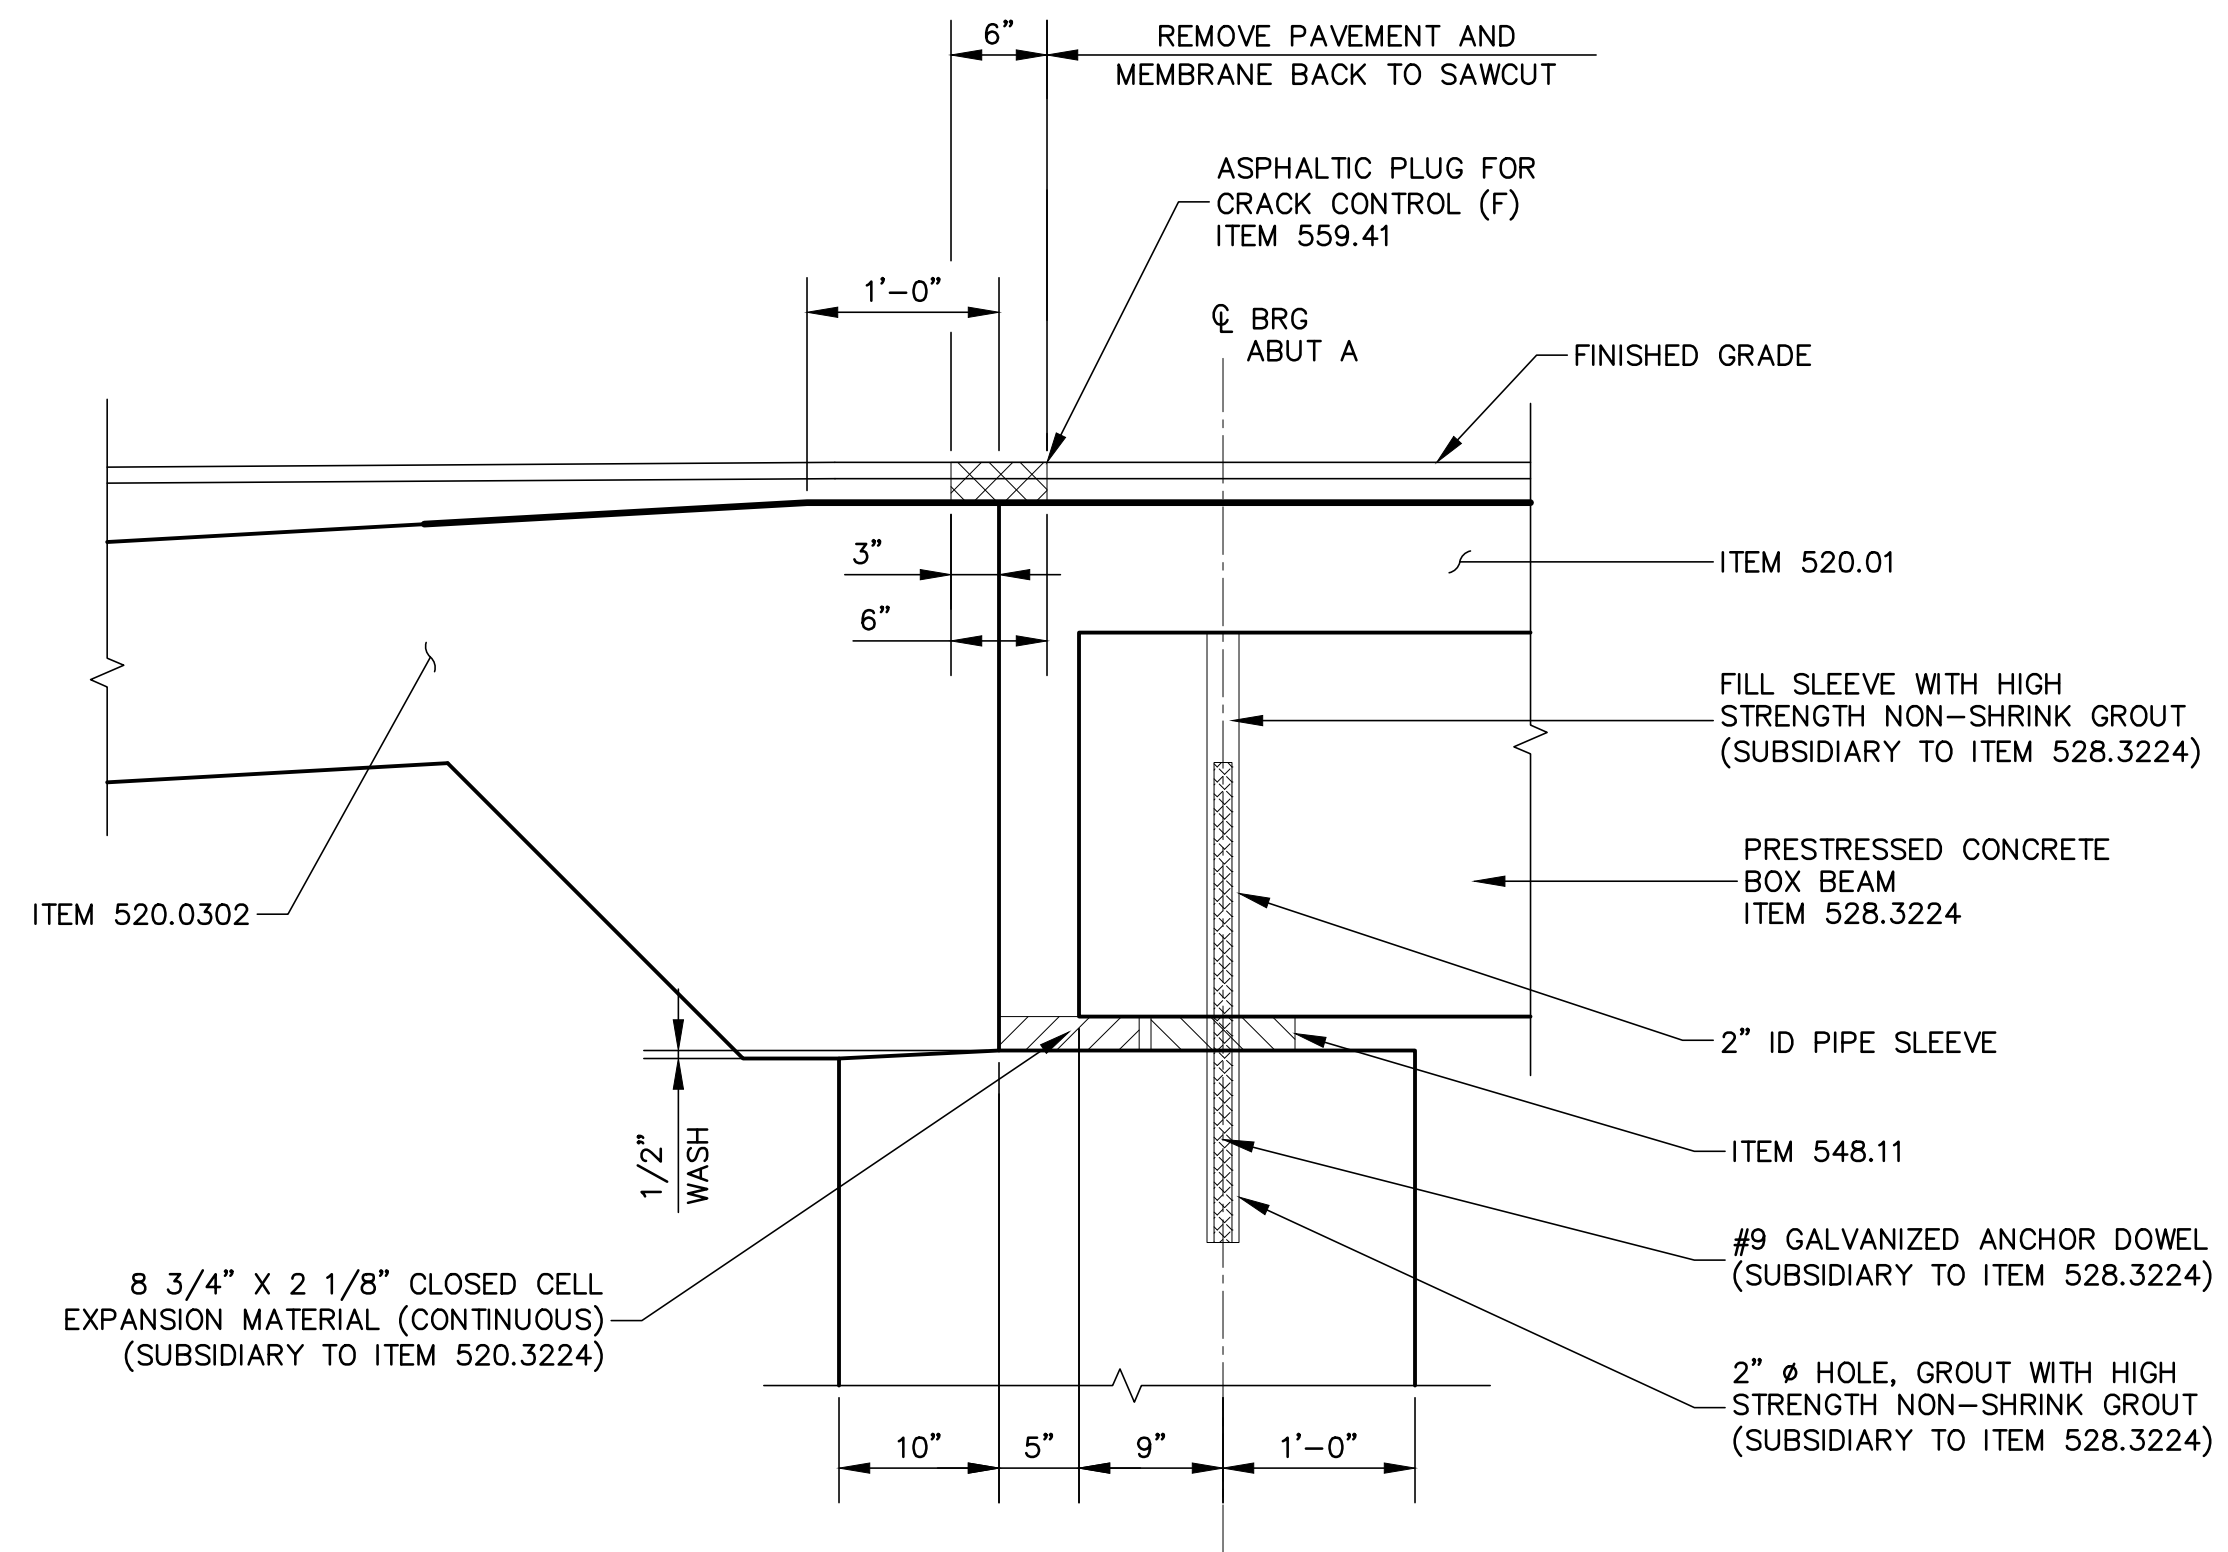


Abutment A
Scale: 1"=1'-0"

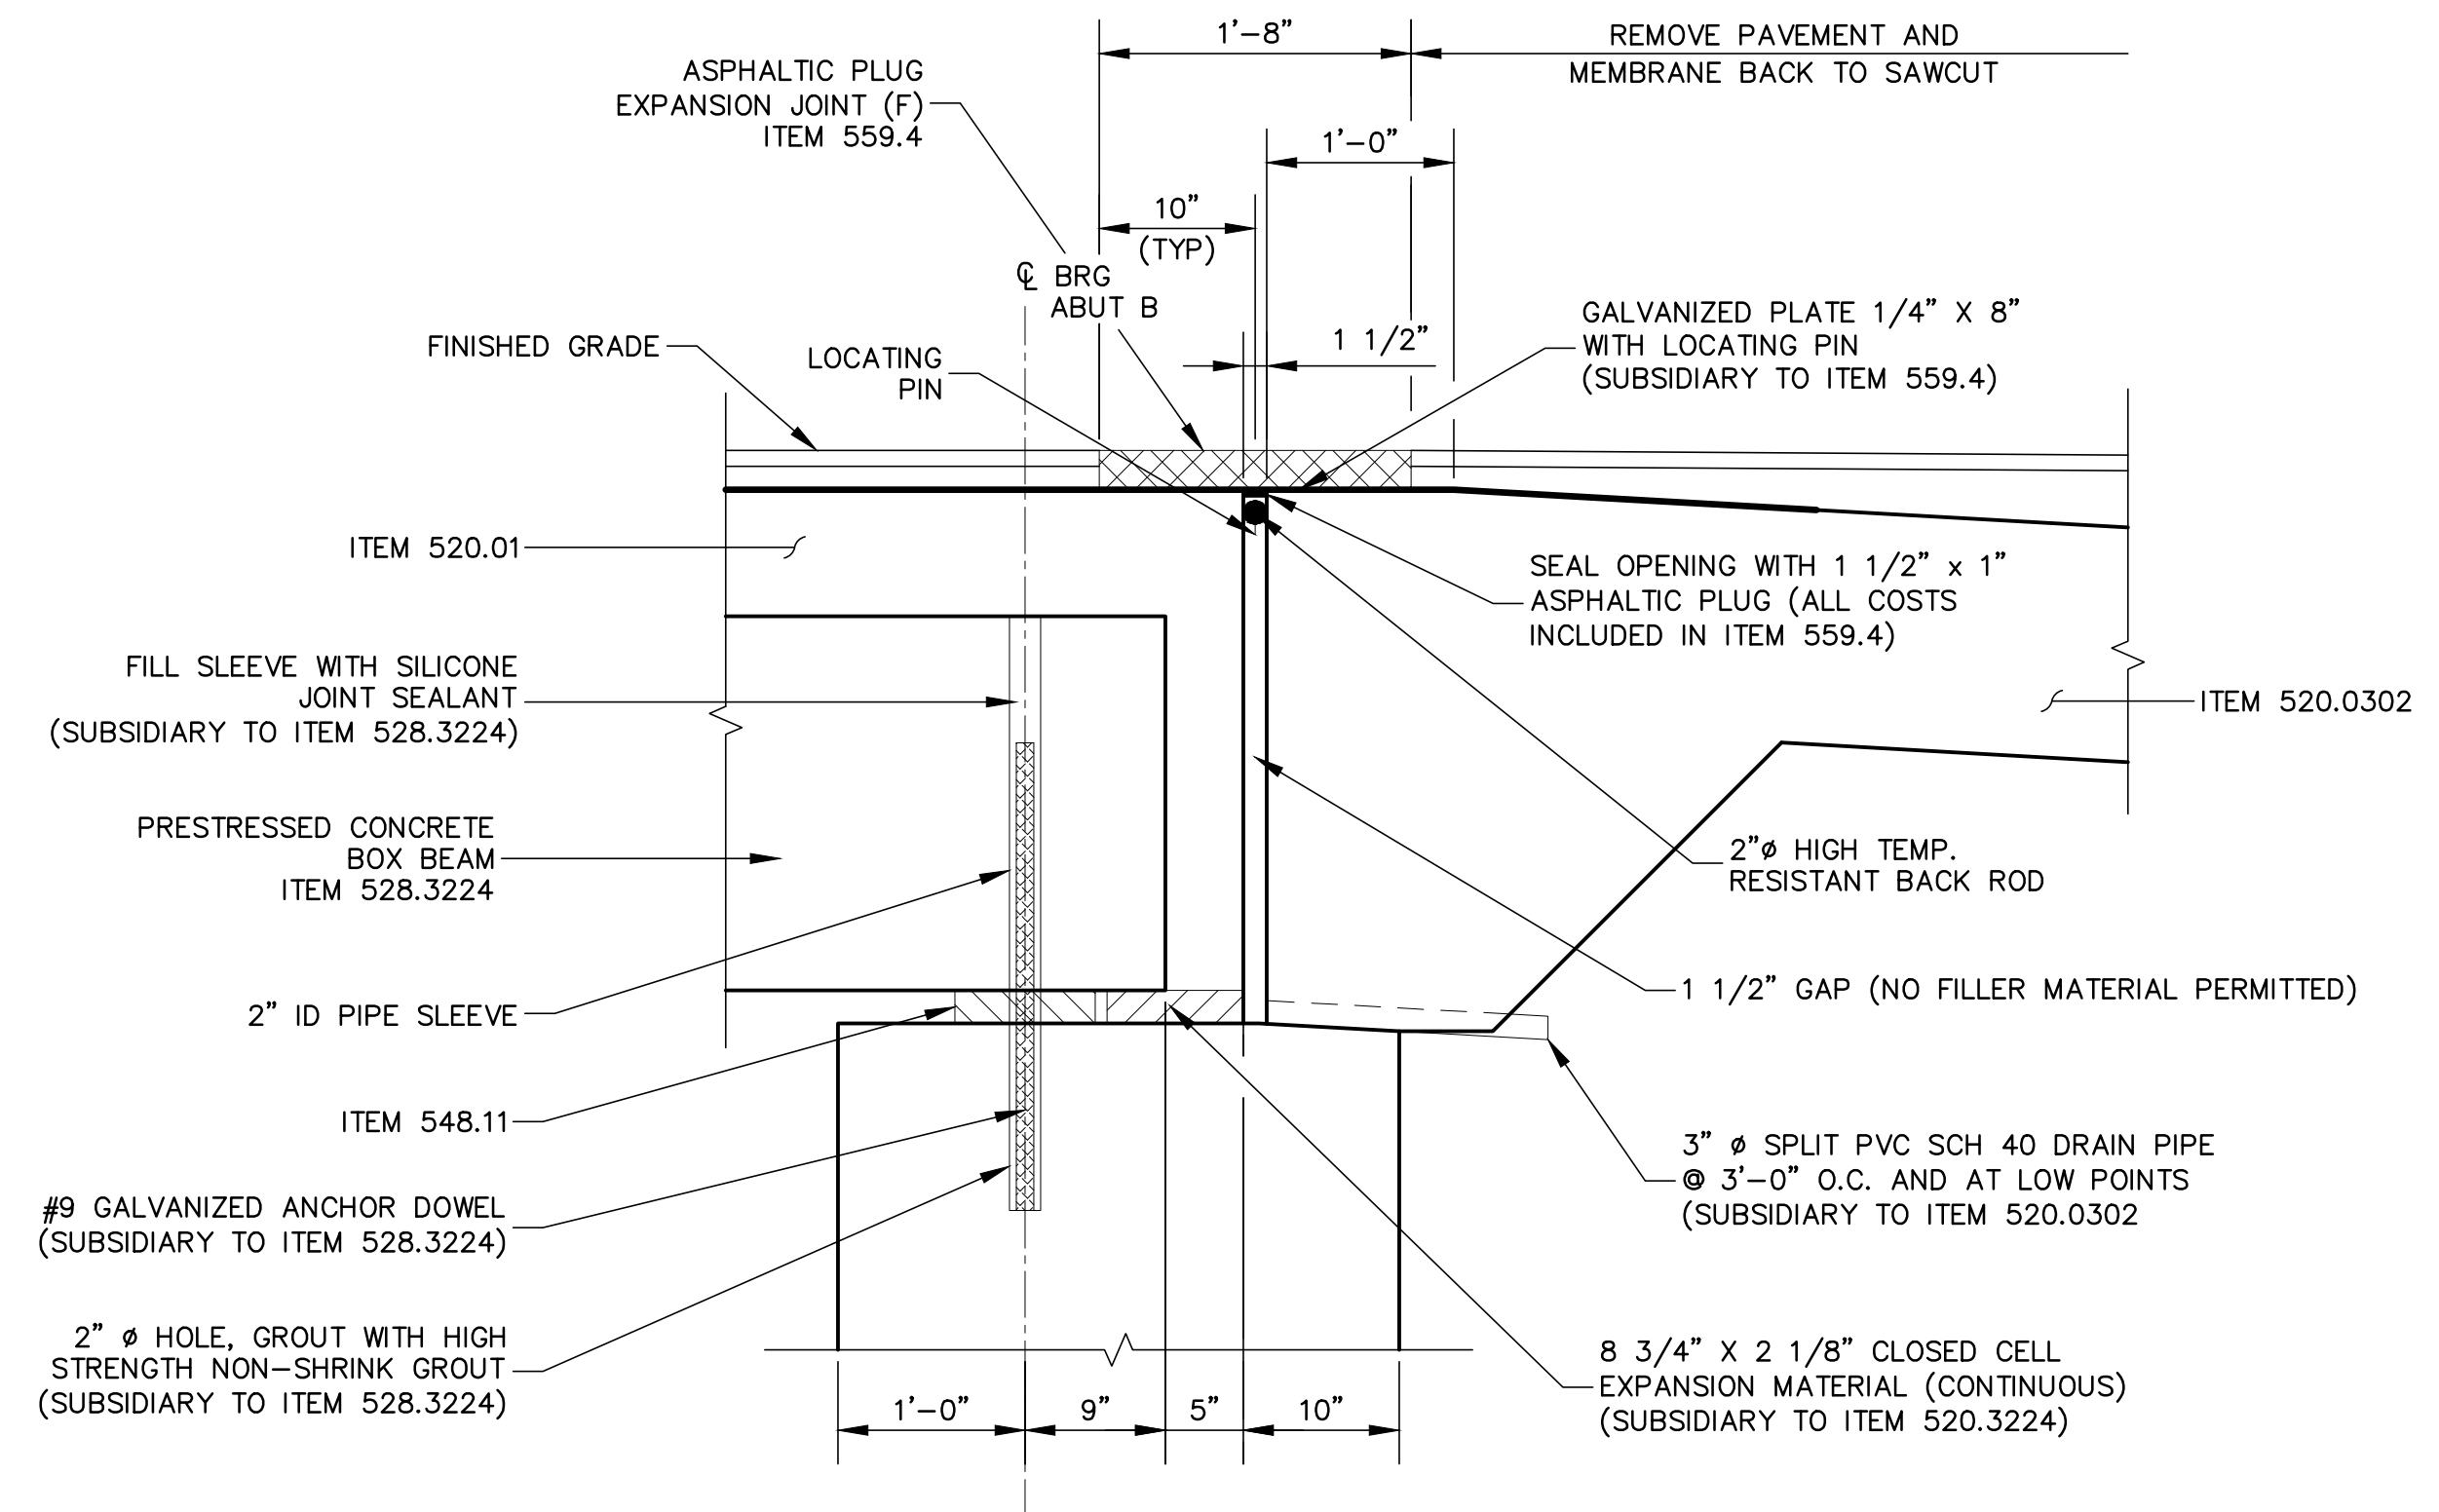


Abutment B
Scale: 1"=1'-0"

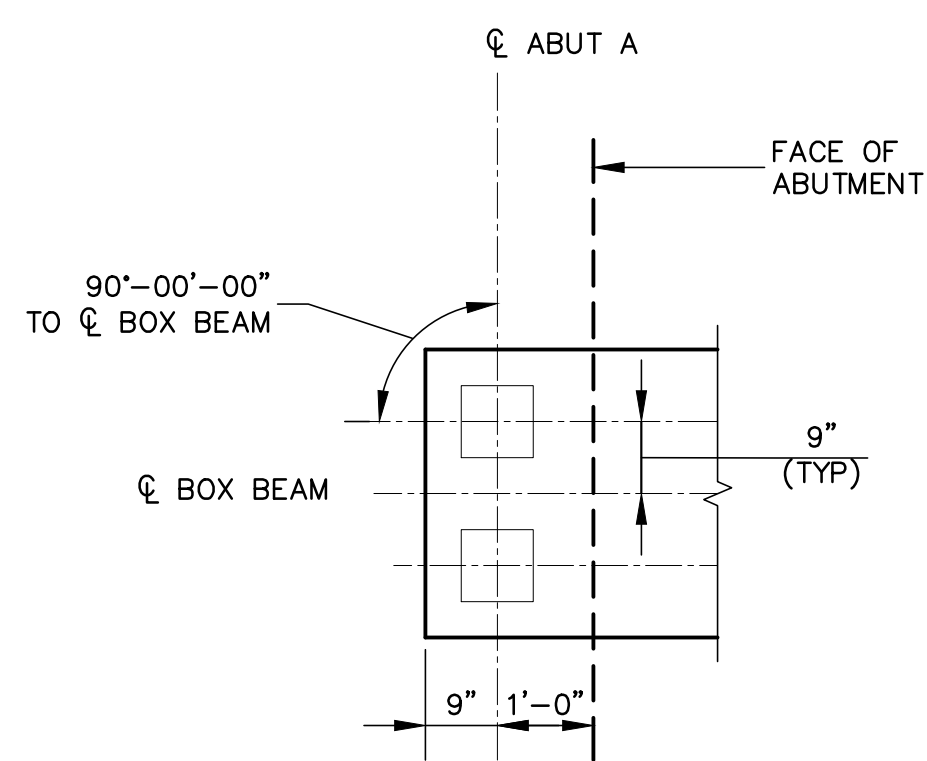


Bearing Layout (Abut A) (3 Ft Beam)
Scale: 1/2"=1'-0"

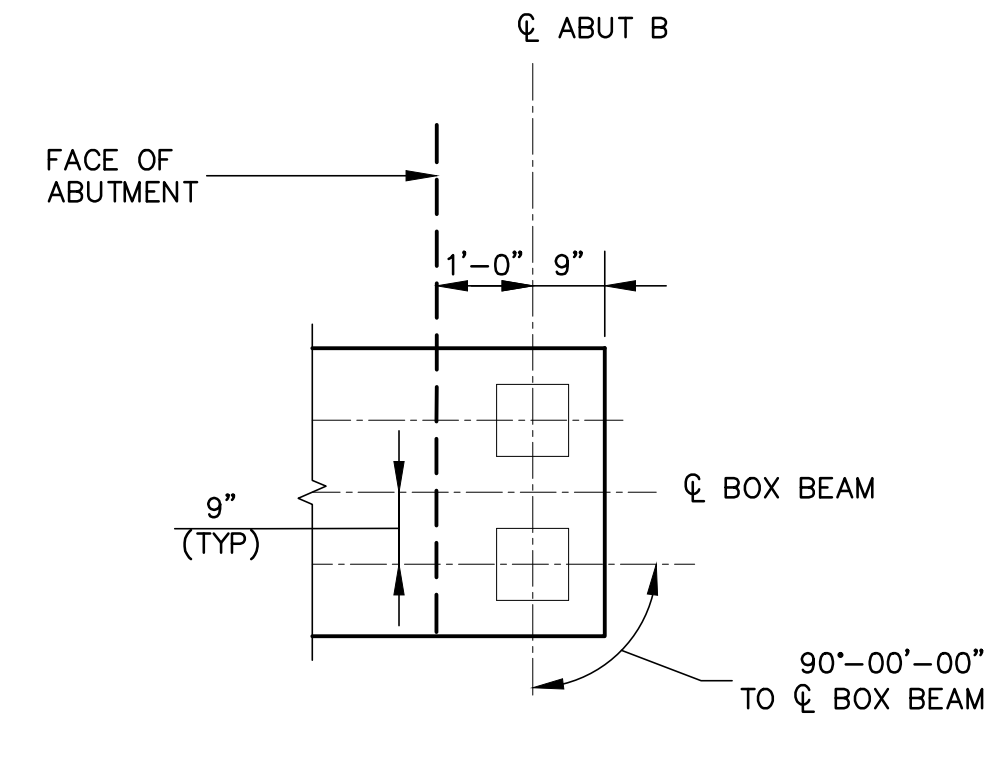


Bearing Layout (Abut B) (3 Ft Beam)
Scale: 1/2"=1'-0"

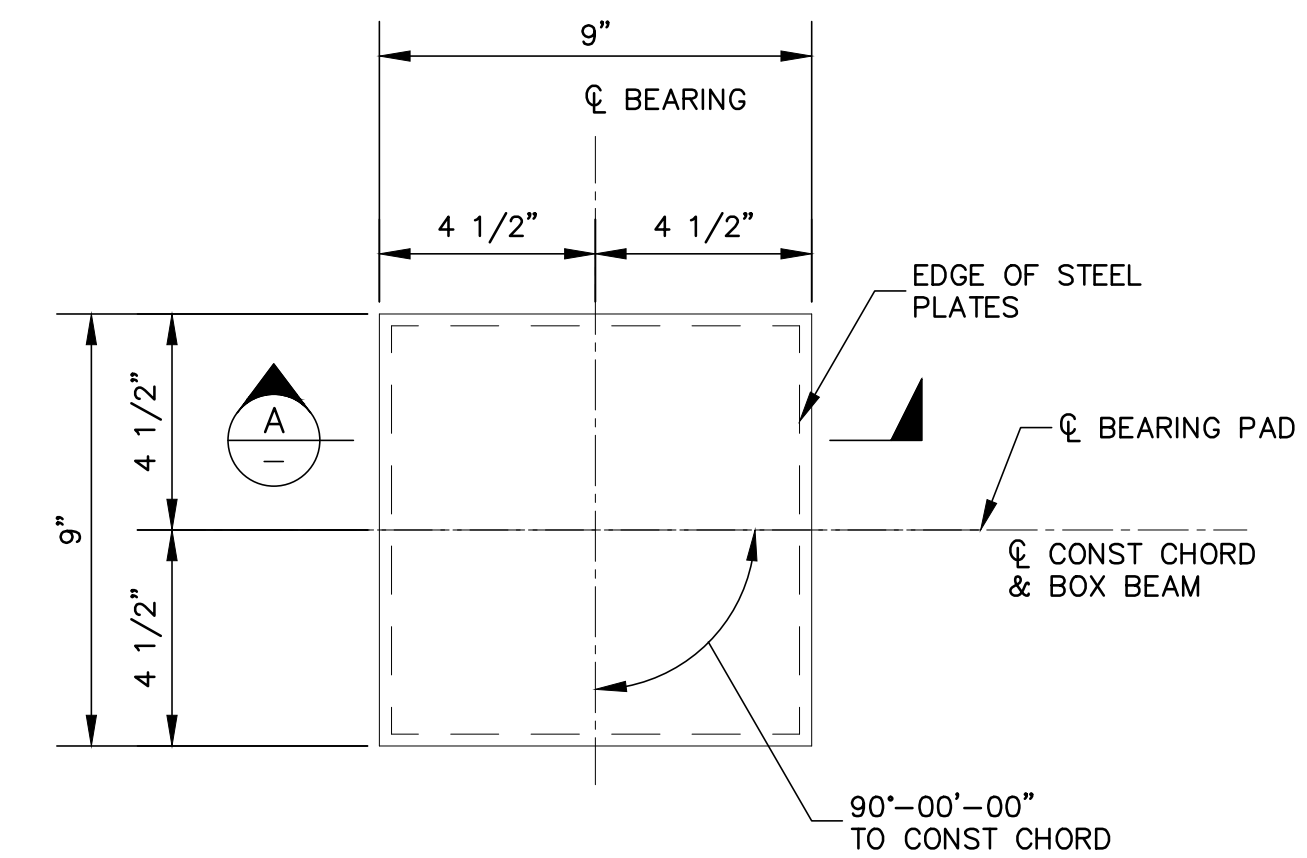


Bearing Plan
Scale: 3"=1'-0"

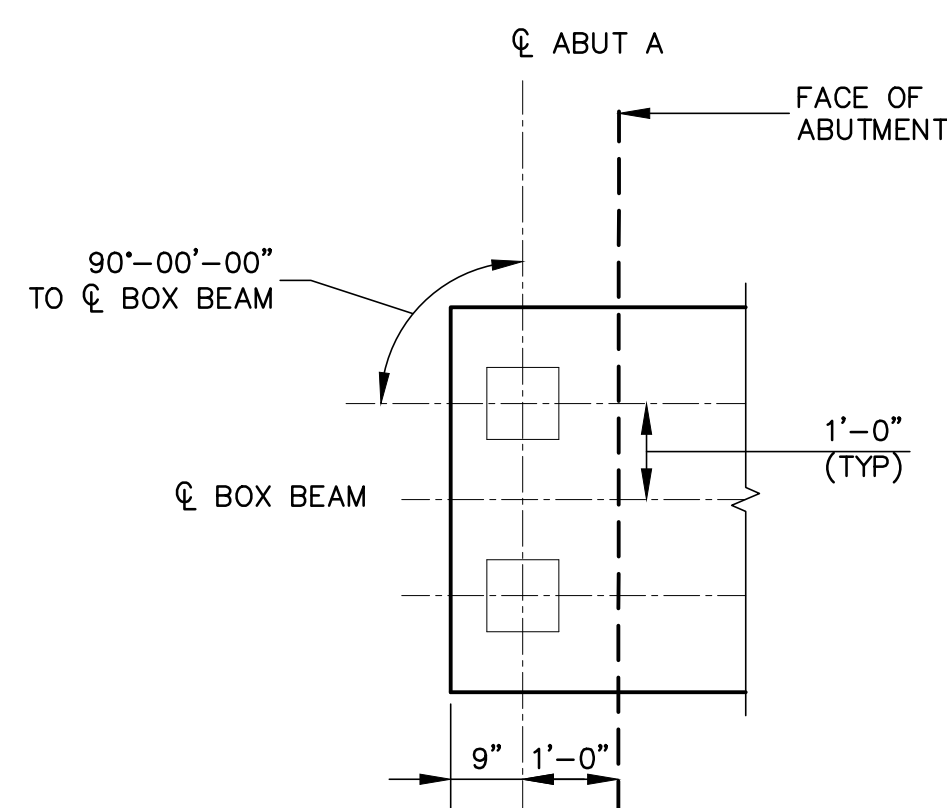

Bearing Layout (Abut A) (4 Ft Beam)
Scale: 1/2"=1'-0"



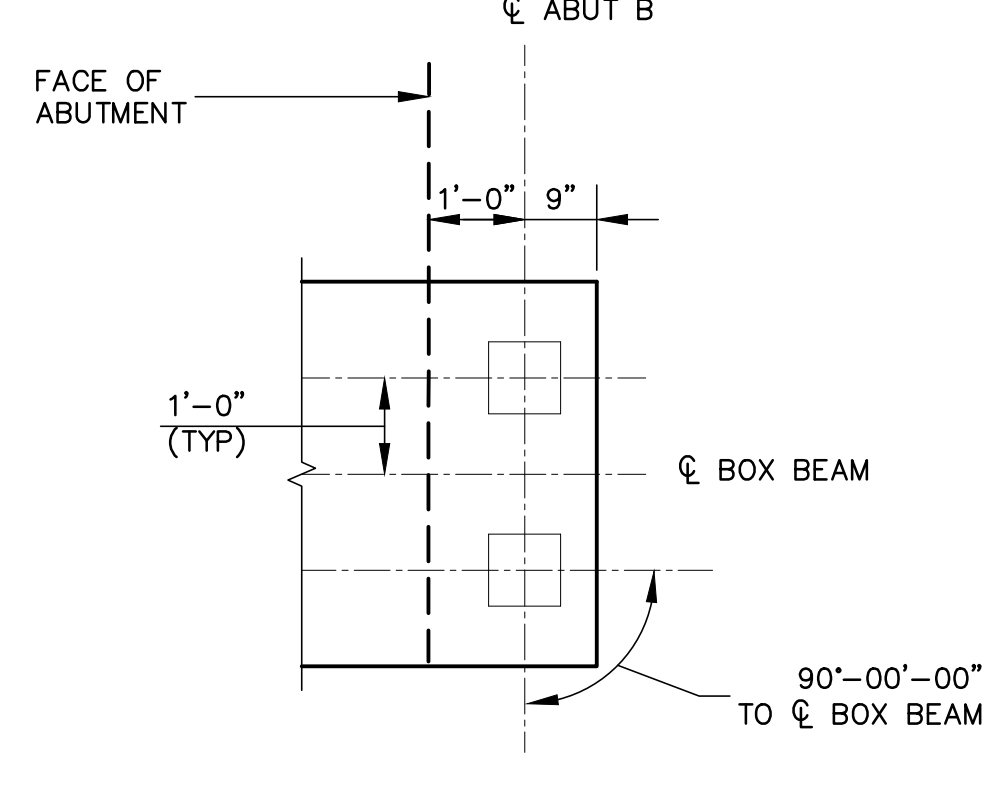


Bearing Layout (Abut B) (4 Ft Beam)
Scale: 1/2"=1'-0"









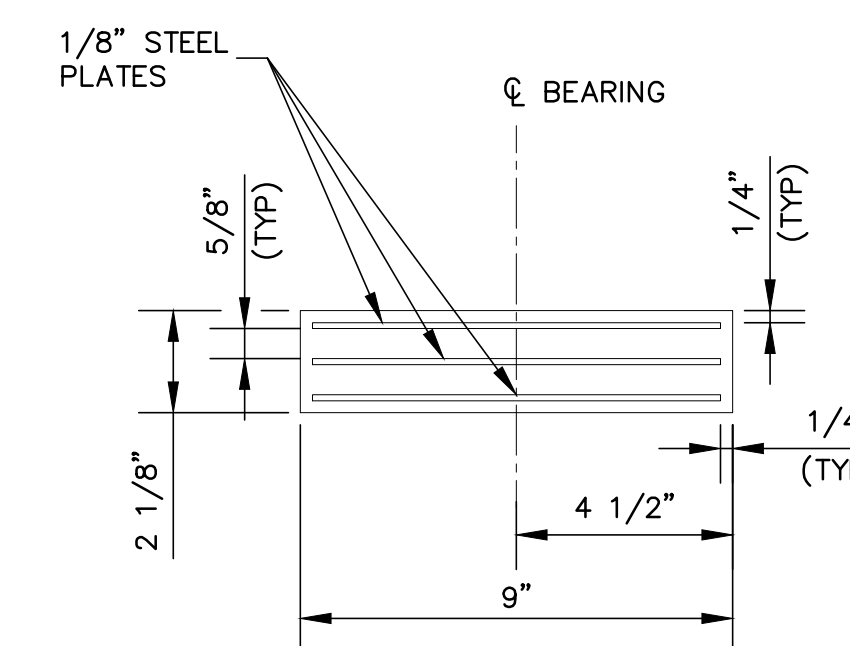


Section
Scale: 3"=1'-0"

		6/13/17 date
CIVIL/ENVIRONMENTAL/STRUCTURAL		ISSUED FOR CONSTRUCTION
Portsmouth, NH • Manchester, NH • Portland, ME 603/431-6196 • 603/627-0708 • 207/541-4223		no.
		revision
designed by: LBK/OGK	drawn by: LBK/BGP	approved by: JLG
date: June 2017	project no: -----	file name: S-19.dwg
Town of Exeter Department of Public Works		scale:
Court Street Little River Bridge Replacement		drawing no. B-19
Bearing and Joint Details		sheet: 20 of 34

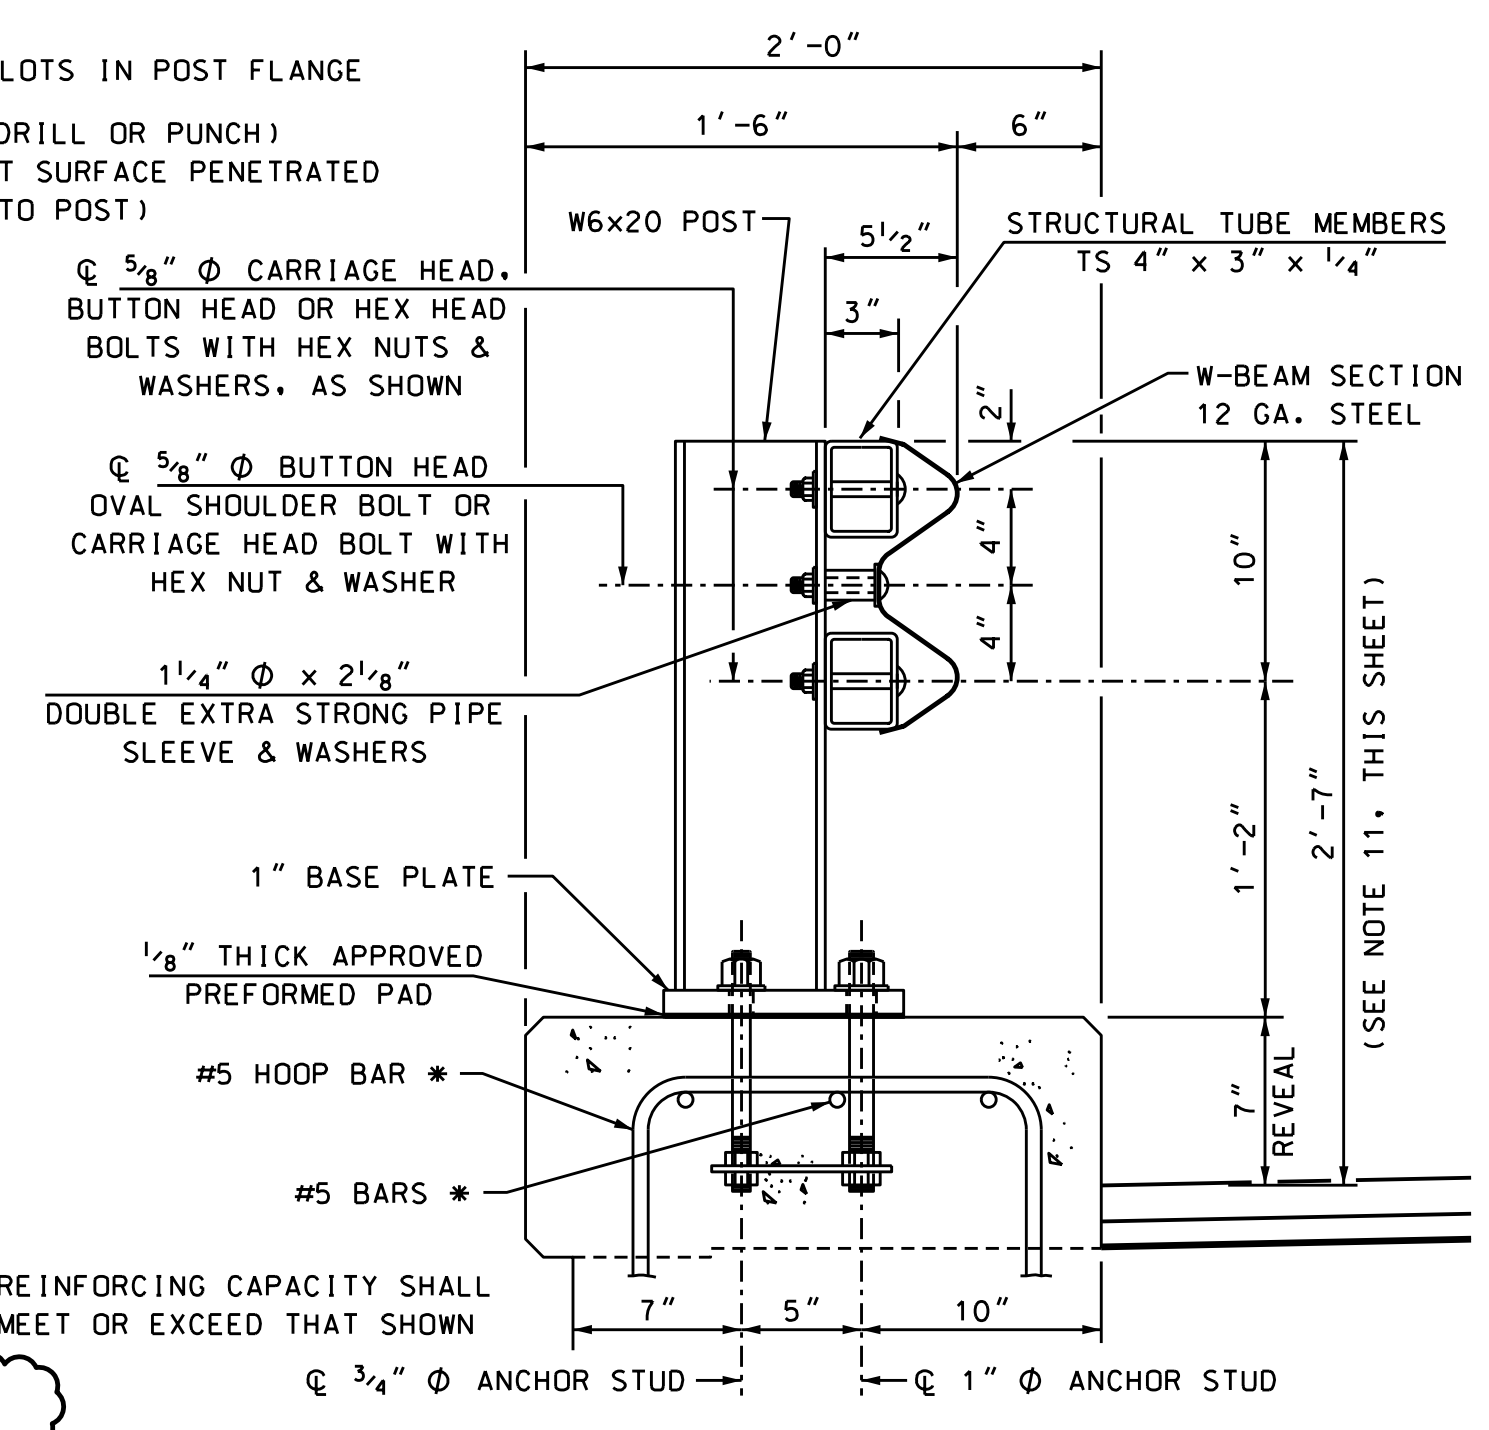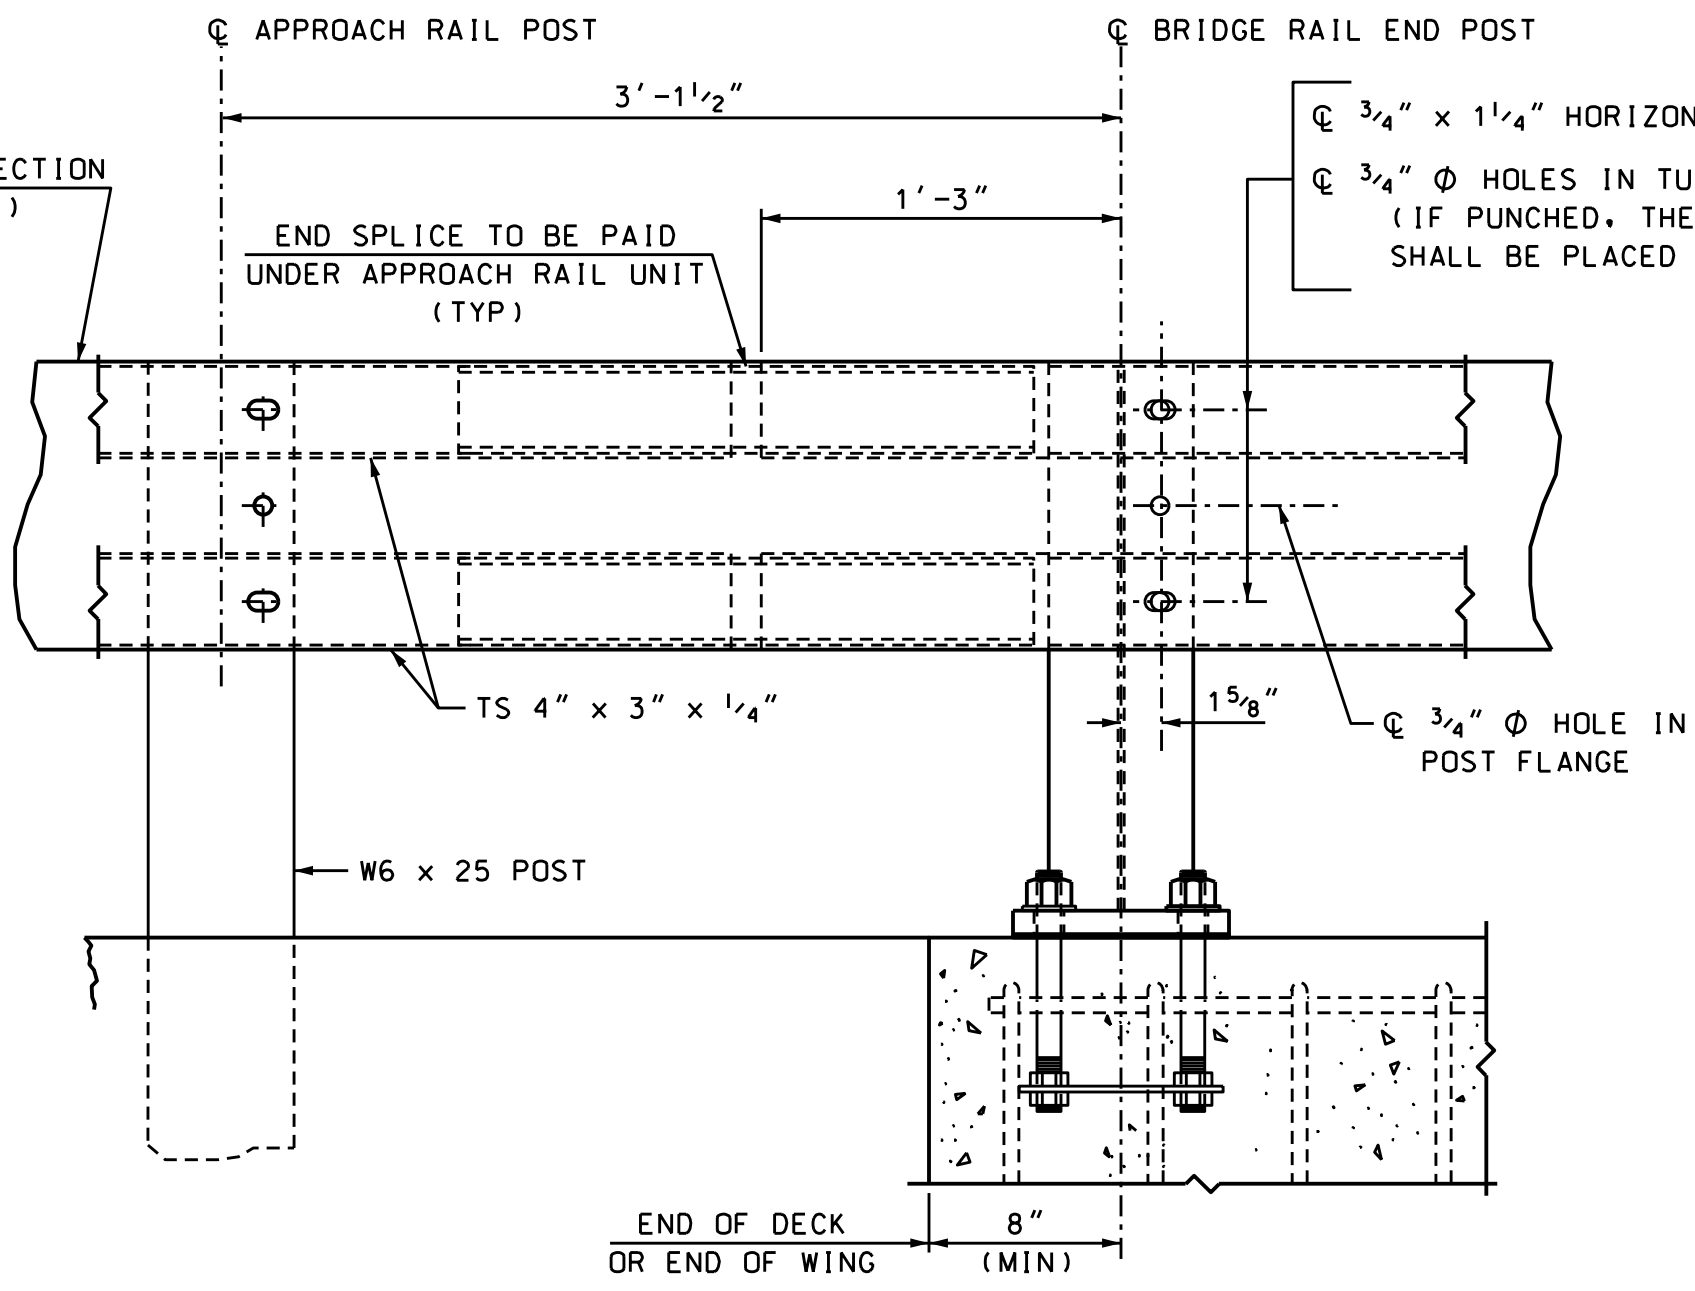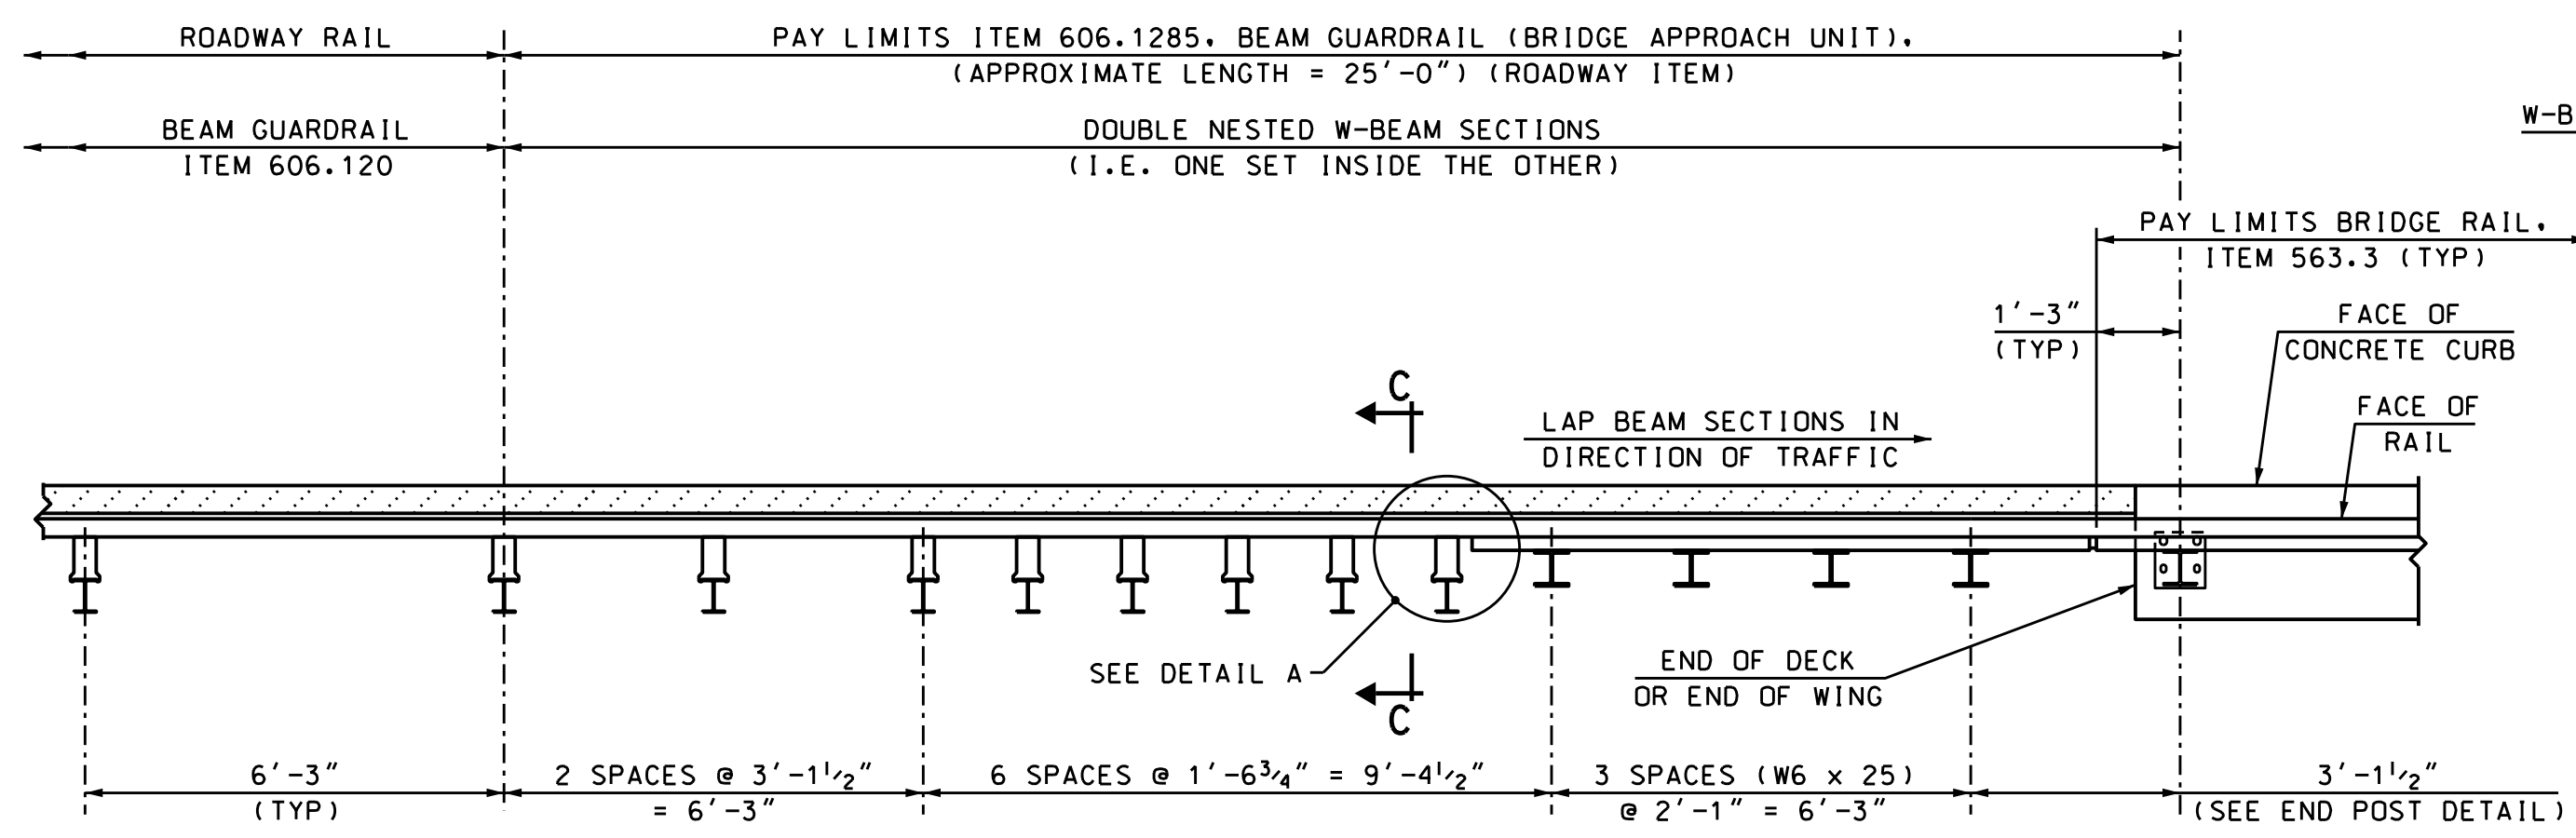

- GENERAL NOTES**
- BRIDGE RAIL T101 SHALL NOT BE USED ON NATIONAL HIGHWAY SYSTEMS.
 - BRIDGE RAIL T101 WAS SUCCESSFULLY CRASHED TESTED FOR NCHRP 350 (@ HEIGHT OF 2'-3"), TL-3 PER FHWA MAY 30, 1997 MEMORANDUM. USE OF THIS SYSTEM SHALL BE FOR POSTED SPEEDS ≤ 45 mph.
 - ITEM 563.3, BRIDGE RAIL T101, SHALL INCLUDE POSTS, BASE PLATES, ANCHOR PLATES, ANCHOR STUDS, PREFORMED PADS, RAIL ASSEMBLY BOLTS, NUTS, WASHERS, STRUCTURAL TUBING, SPLICE BARS, PIPE SLEEVES AND W-BEAM SECTIONS.
 - ASTM A572 GRADE 50 : POSTS AND BASE PLATES
 - ASTM A500 GRADE B : STRUCTURAL TUBING
 - ASTM A36 : PIPE SLEEVES, RAIL SPLICE BARS AND ANCHOR PLATES
 - ASTM A449 : ANCHOR STUDS WITH STANDARD NUTS AND HARDENED STEEL COMMERCIAL TYPE A PLAIN WIDE WASHERS
 - A307 : RAIL BOLTS, NUTS, AND WASHERS
 - AASHTO M180 TYPE II : W-BEAM SECTIONS
 - ALL STEEL COMPONENTS SHALL BE GALVANIZED AFTER FABRICATION IN CONFORMANCE WITH AASHTO M232 (ASTM A153) AND AASHTO M111 (ASTM A123). GALVANIZED SURFACES SHALL HAVE A UNIFORM APPEARANCE AND GALVANIZED MATERIAL SHALL BE PROPERLY STORED.
 - STRUCTURAL TUBING SHALL BE SUPPLIED AS ONE PIECE FOR BRIDGE RAIL 40 FEET OR LESS IN LENGTH. IN OTHER CASES, TUBING SHALL BE SPLICED WITH A SPLICE BAR (SEE SPLICE BAR DETAILS). NO TRANSVERSE BUTT WELDS ARE PERMITTED ON RAIL TUBING WITHIN A CONTINUOUS LENGTH.
 - EACH PIECE OF RAIL TUBING SHALL BE ATTACHED TO A MINIMUM OF THREE POSTS.
 - FOR BRIDGE RAIL POST SPACING, SEE BRIDGE RAIL LAYOUT. THE MAXIMUM BRIDGE RAIL POST SPACING SHALL BE 8'-4". POST SPACING OF 8'-4" OR 6'-3" IS RECOMMENDED WHENEVER POSSIBLE FOR USE WITH 25' SECTIONS OF STANDARD W-BEAM RAIL.
 - PREFORMED BEARING PADS SHALL CONFORM TO AASHTO M251.
 - NUTS FOR THREADED ANCHOR STUDS CONNECTING THE BASE PLATE TO THE CONCRETE SHALL BE TIGHTENED TO A SNUG FIT AND GIVEN AN ADDITIONAL 1/8" TURN.
 - OTHER TYPES OF OFFSET BLOCKS MAY BE SUBSTITUTED FOR THOSE SHOWN. SEE NOTES IN STANDARD PLAN GR-2 (BEAM GUARDRAIL STANDARD SECTION - STEEL POSTS & HARDWARE DETAILS) OF THE HIGHWAY DESIGN STANDARD PLANS FOR ROAD CONSTRUCTION.
 - WHERE SIDEWALK IS PRESENT, 2'-7" SHALL BE MEASURED FROM THE TOP OF SIDEWALK ELEVATION AT THE BASE OF THE RAIL.

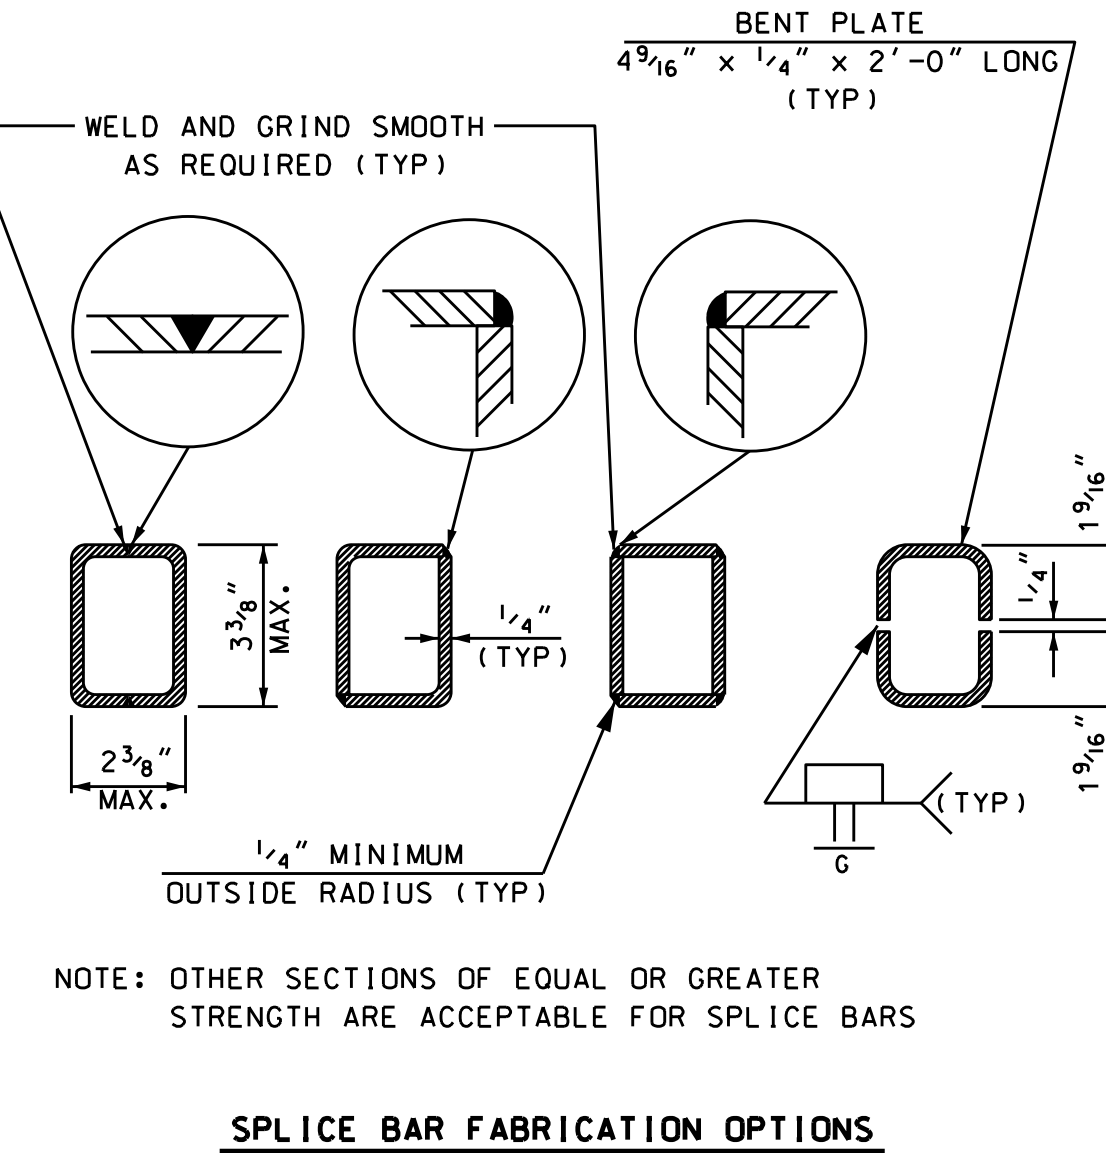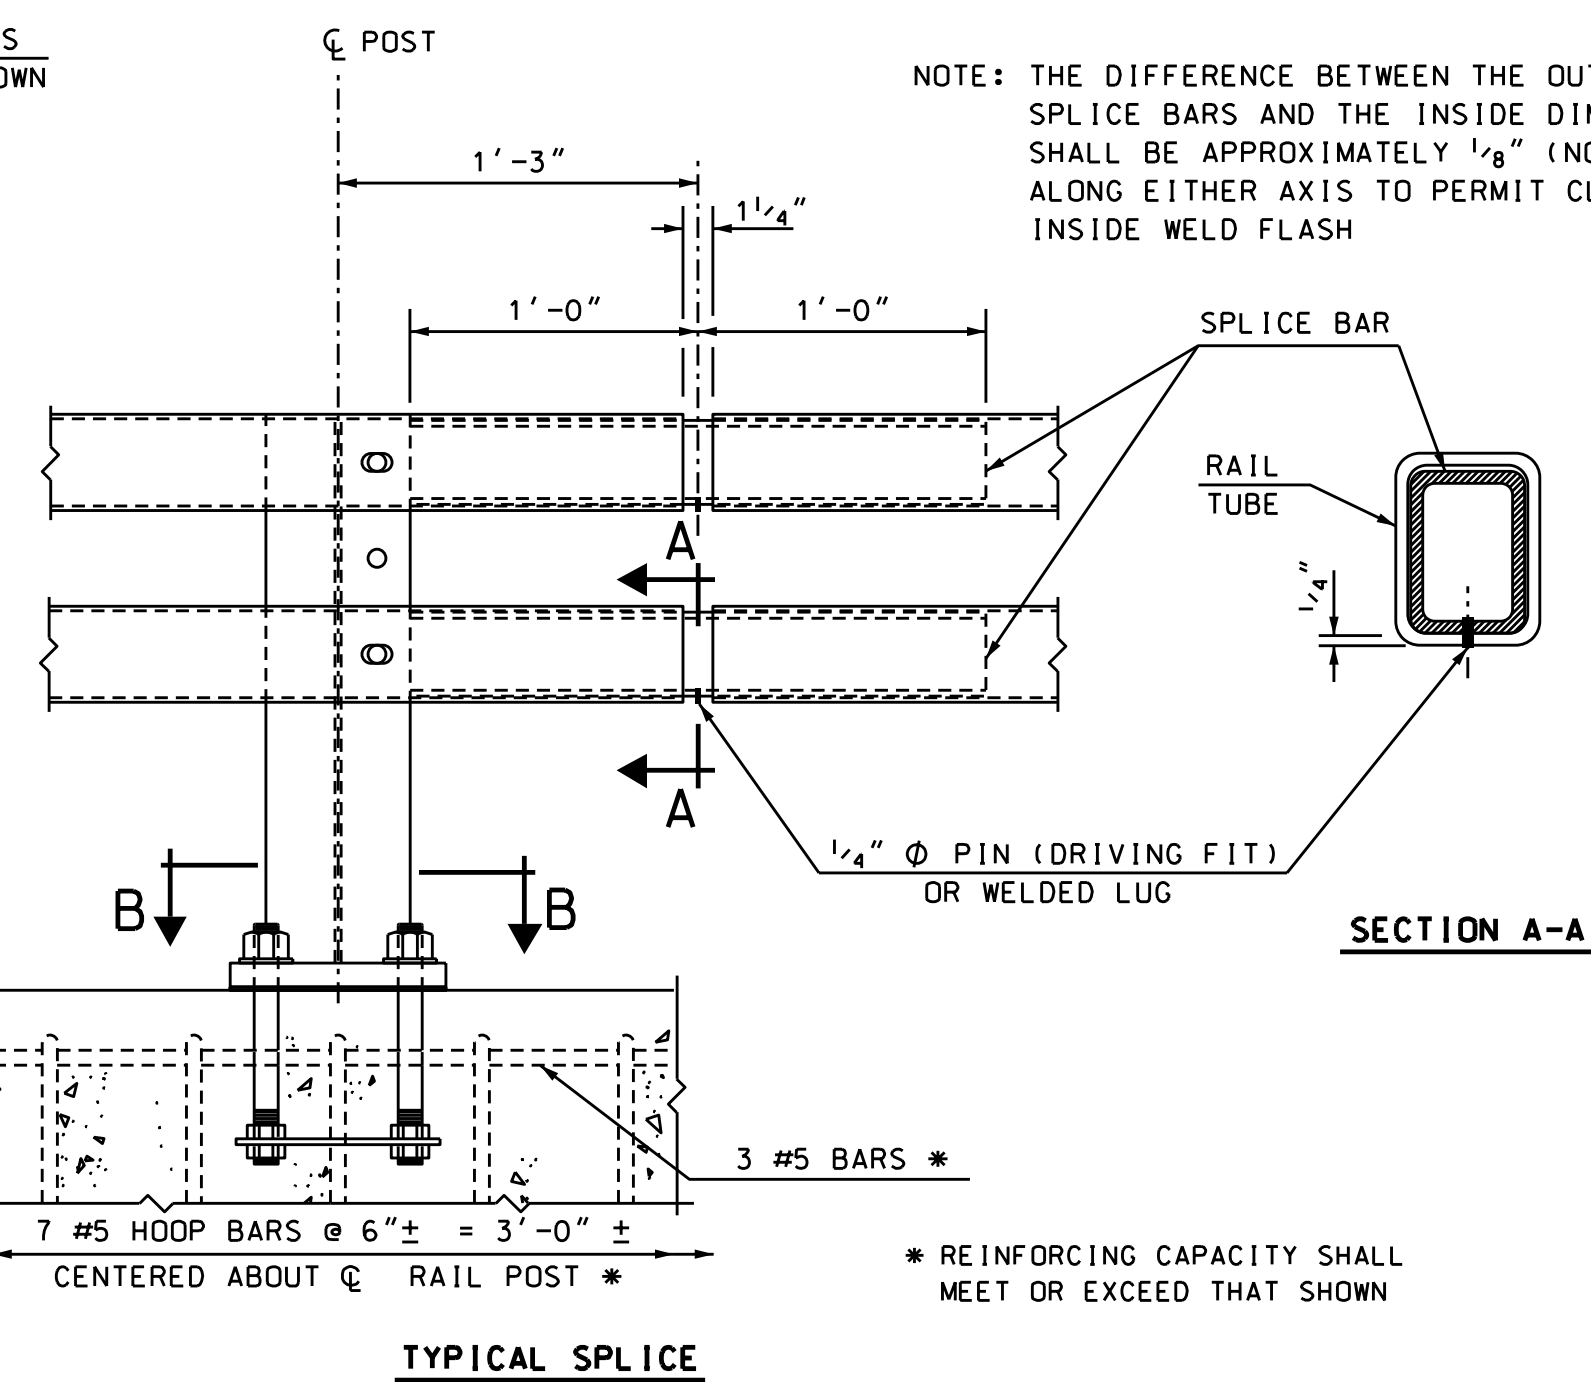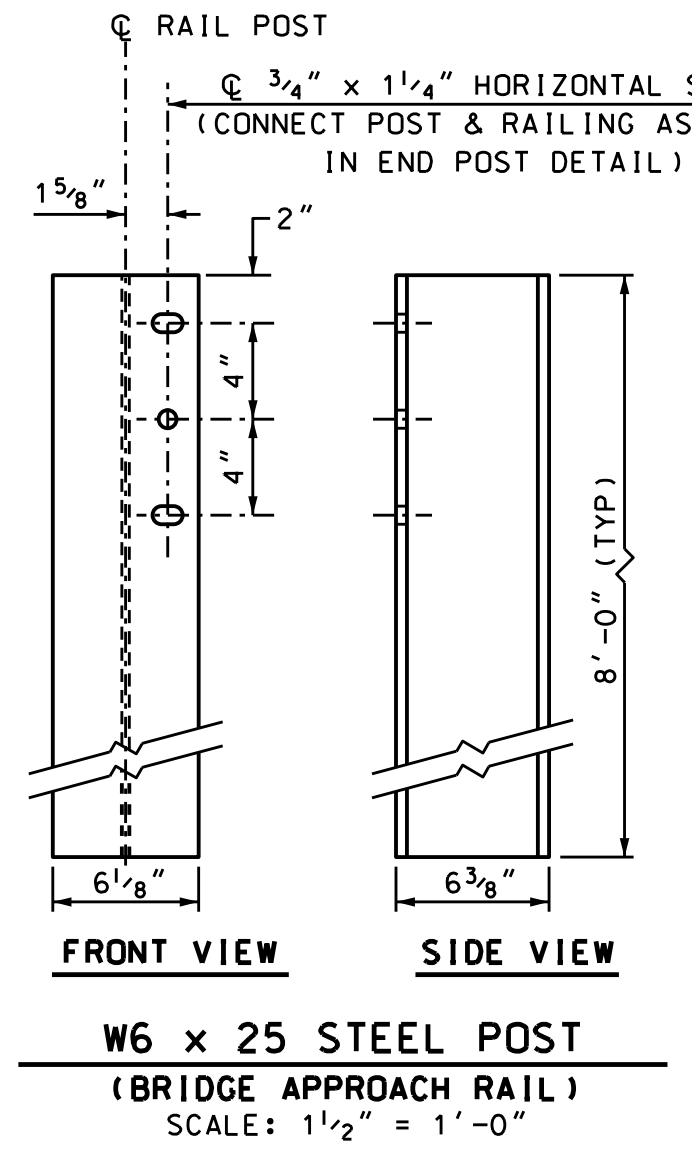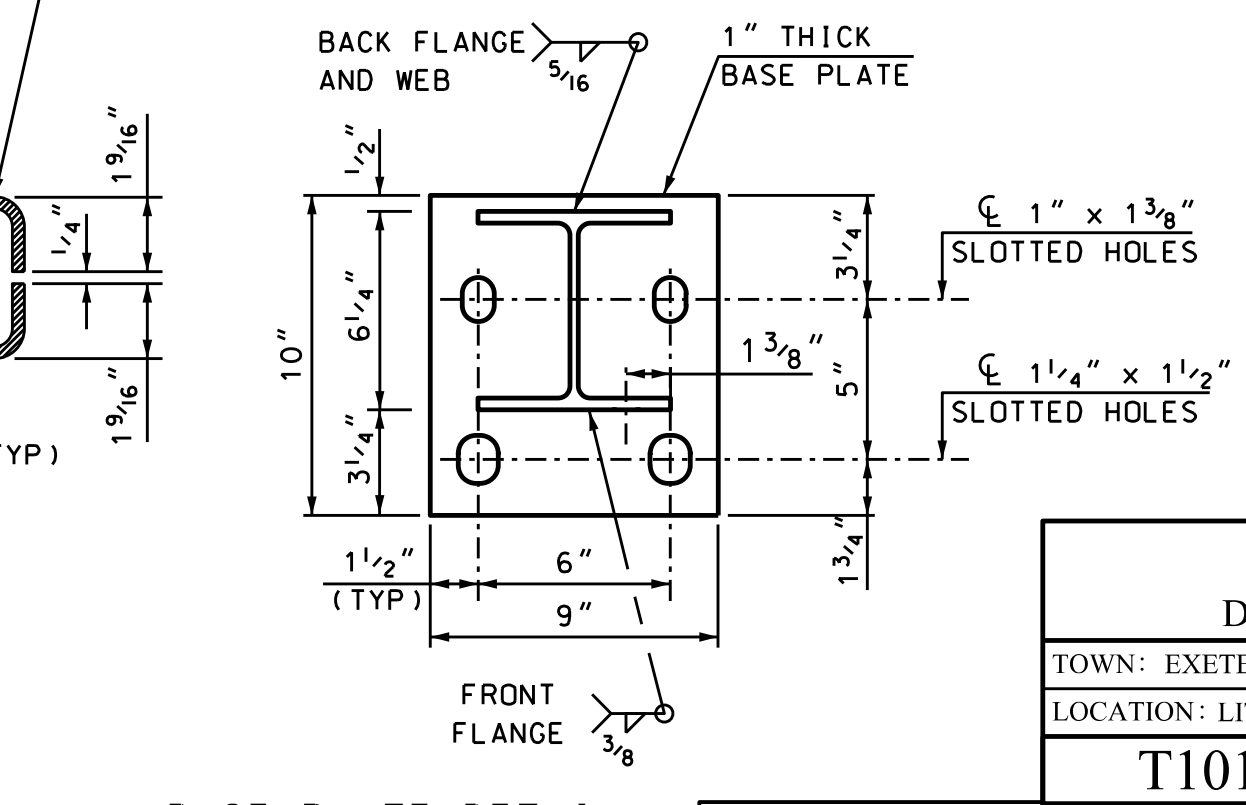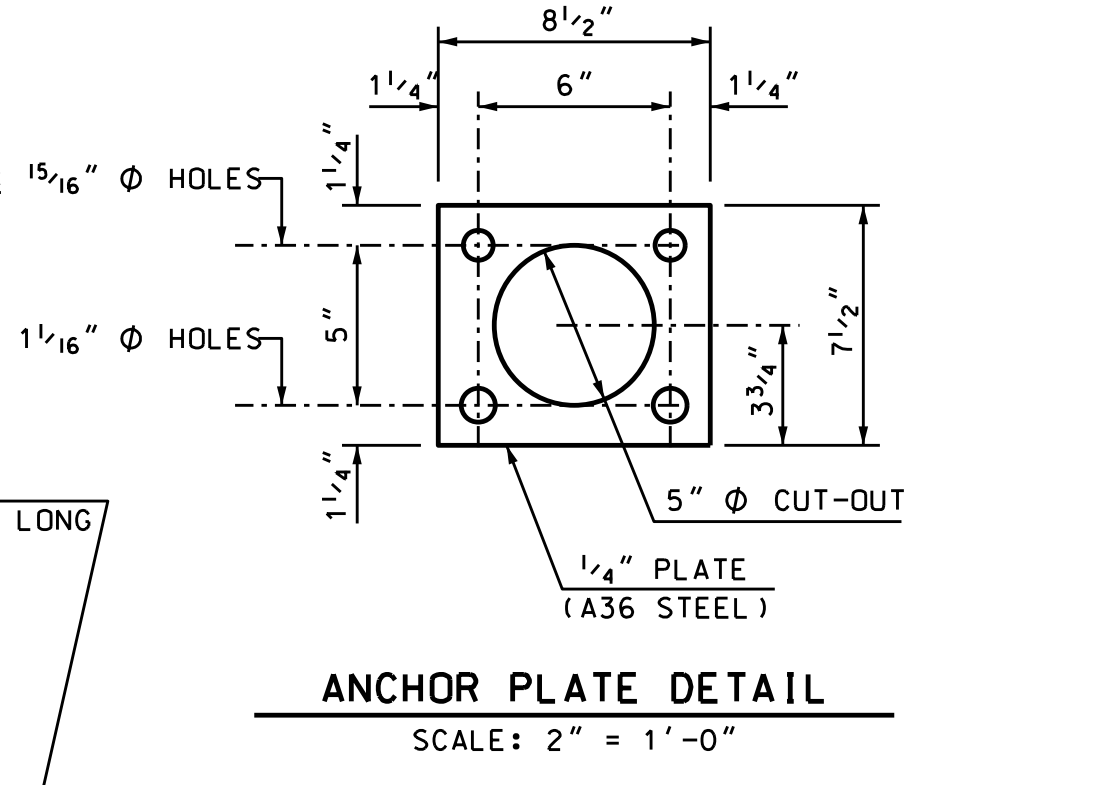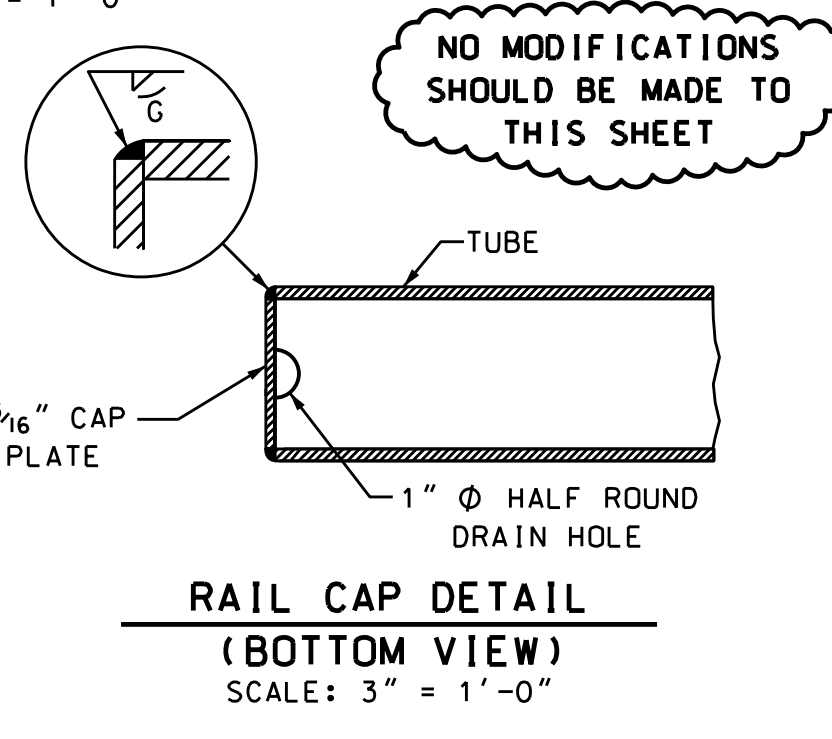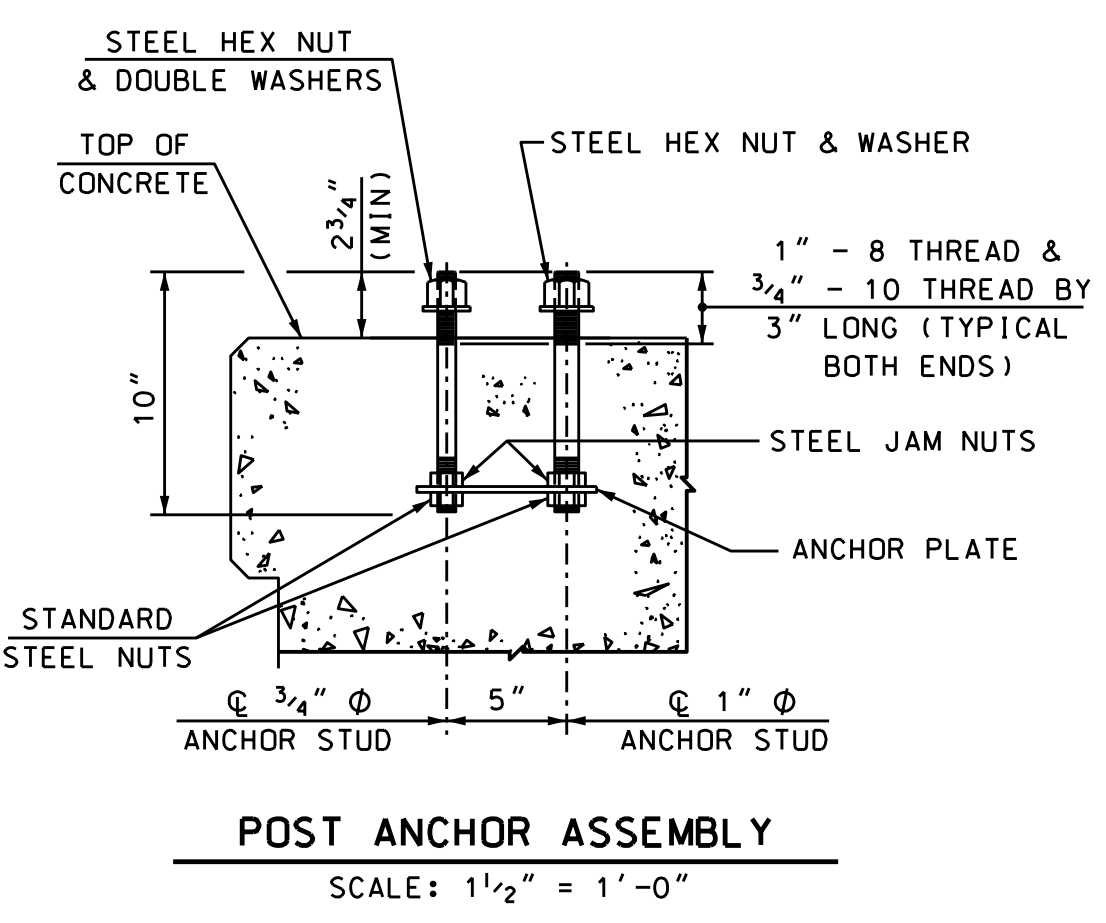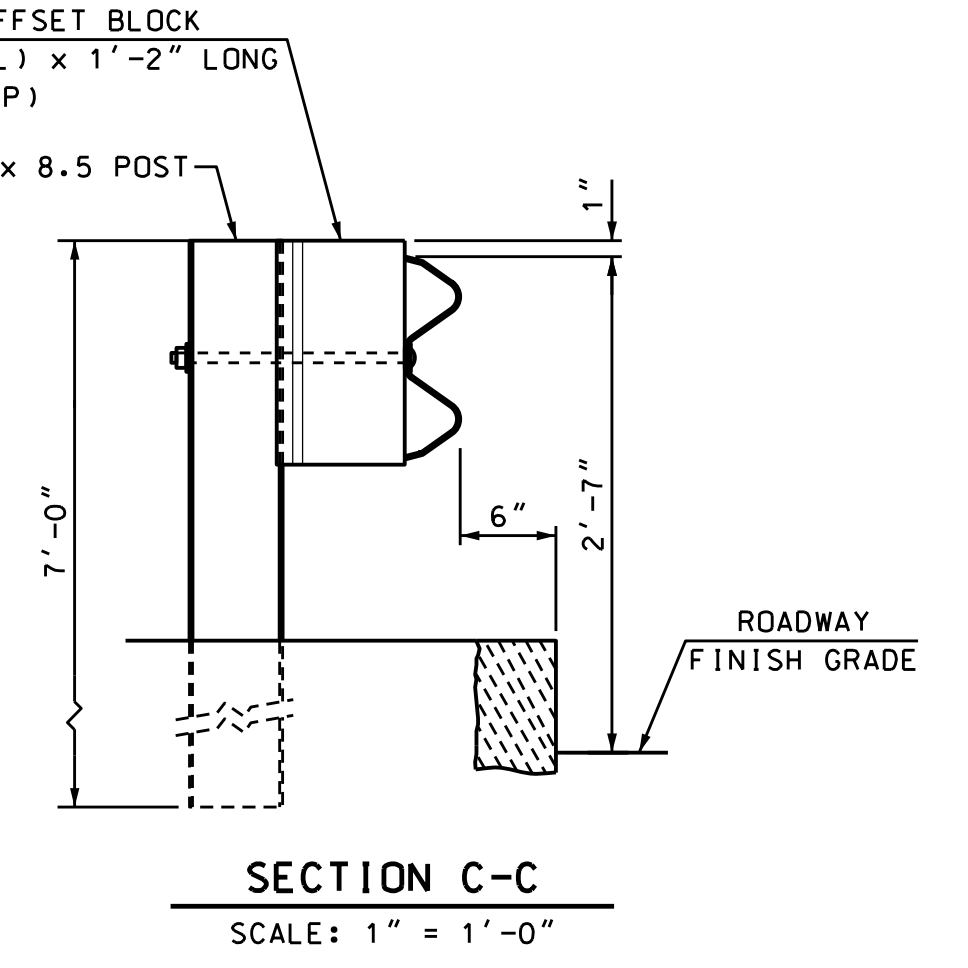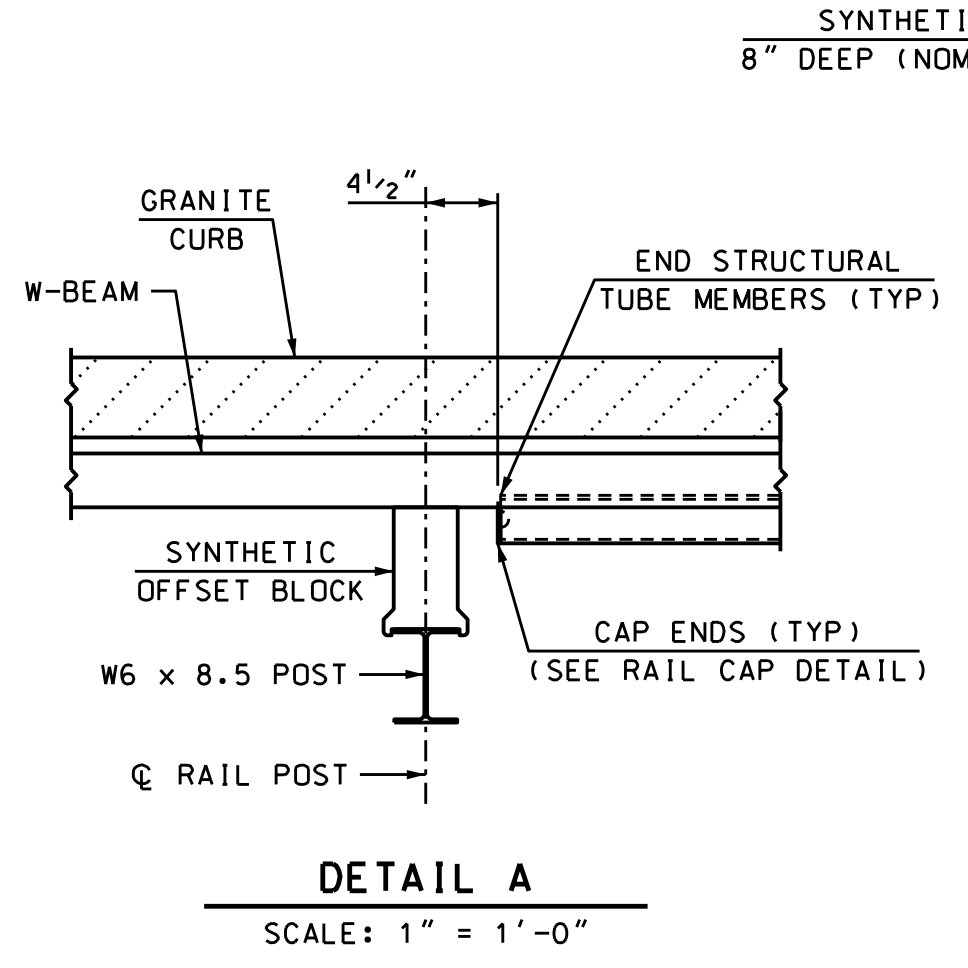

SPLICE BAR DETAILS
NOT TO SCALE

(GALVANIZED - 7" CURB REVEAL)

STATE OF NEW HAMPSHIRE
DEPARTMENT OF TRANSPORTATION * BUREAU OF BRIDGE DESIGN

TOWN: EXETER
BRIDGE NO.: 095/063
STATE PROJECT

LOCATION: LITTLE RIVER CROSSING AT COURT STREET


T101 BRIDGE & APPROACH RAIL (STEEL POSTS)

REVISIONS AFTER PROPOSAL	DATE	BY	DATE	BY	DATE
1	ADDED T3 RAIL DETAILS	1/30/13	DESIGNED	NHDOT	3/90
			CHECKED	NHDOT	1/10
			CHECKED	NHDOT	1/10
			CHECKED	JLG	11/15
			ISSUE DATE	1/20/10	
			REV. DATE	3/30/14	


BRIDGE SHEET 20 OF 21
FILE NUMBER
SHEET NO. 21
TOTAL SHEETS 35

CMA ENGINEERS


SUBDIRECTORY	DGN LOCATOR	SHEET SCALE
		AS NOTED

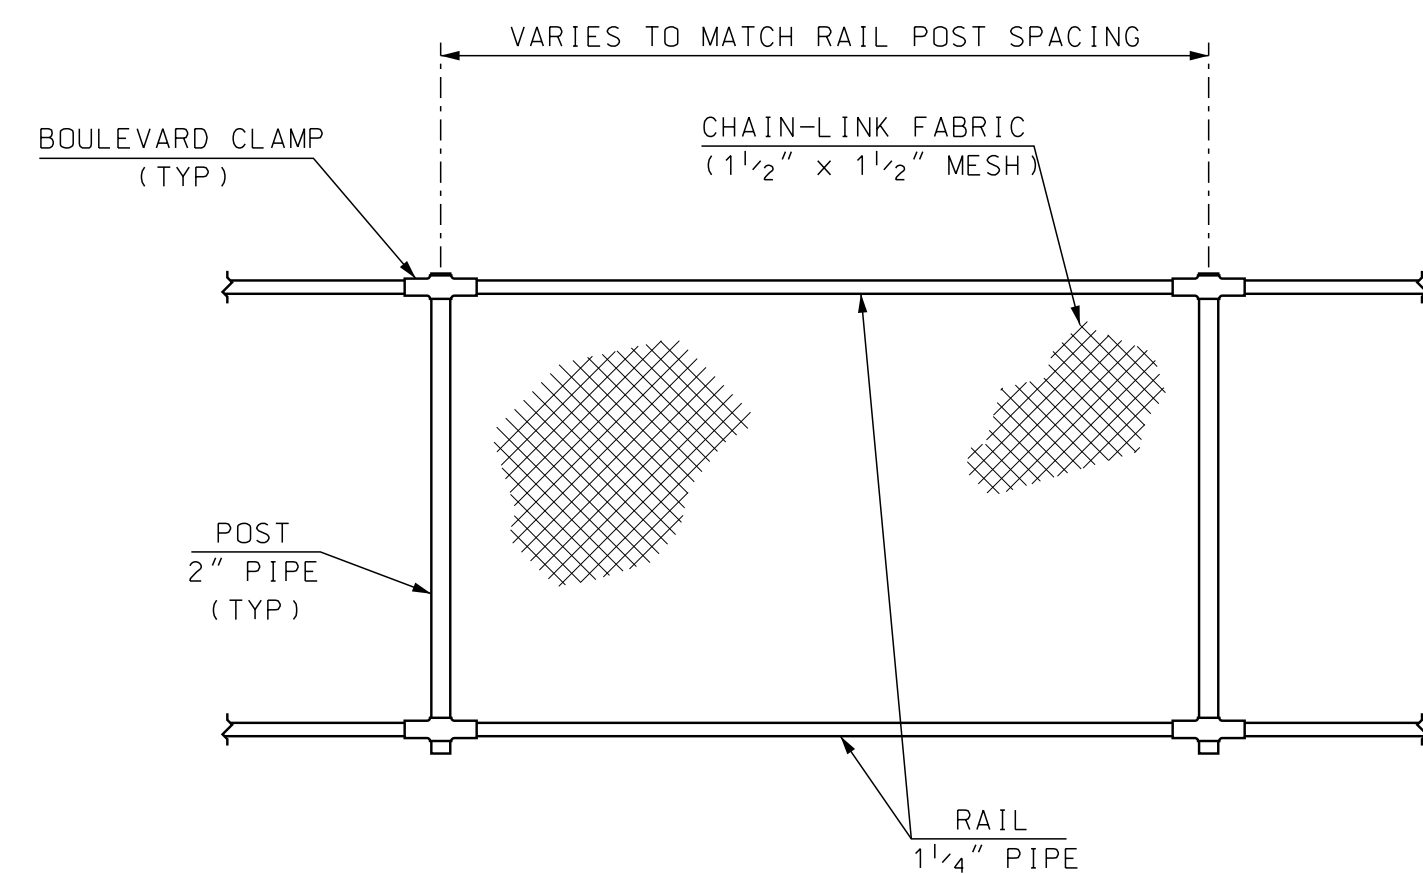


ELEVATION - SNOW SCREENING
SCALE: 1/2" = 1'-0"

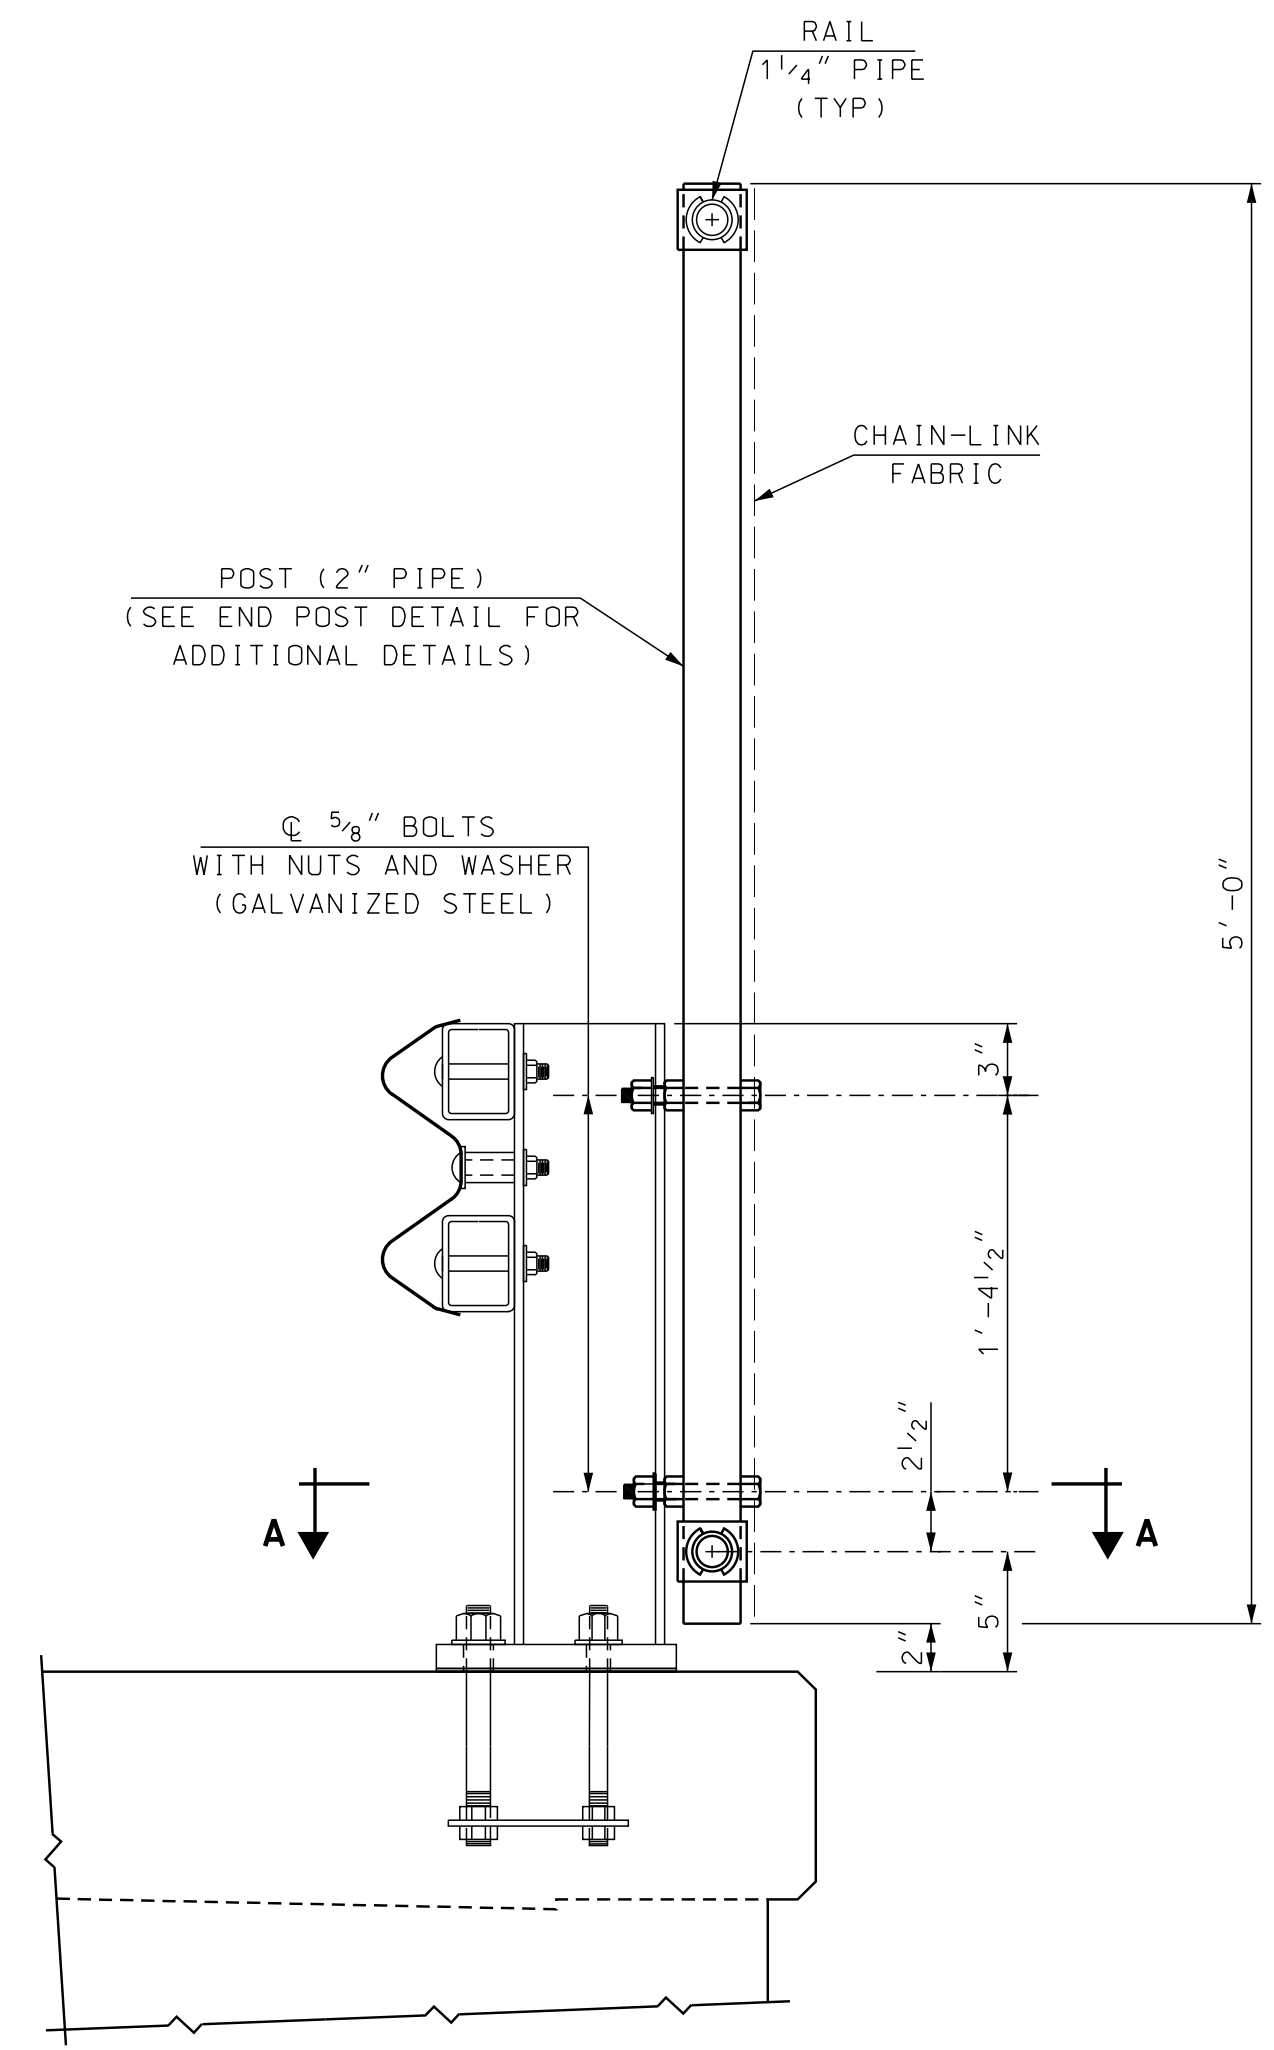


TYPICAL SECTION (T101 BRIDGE RAIL)
SCALE: 1/2" = 1'-0"

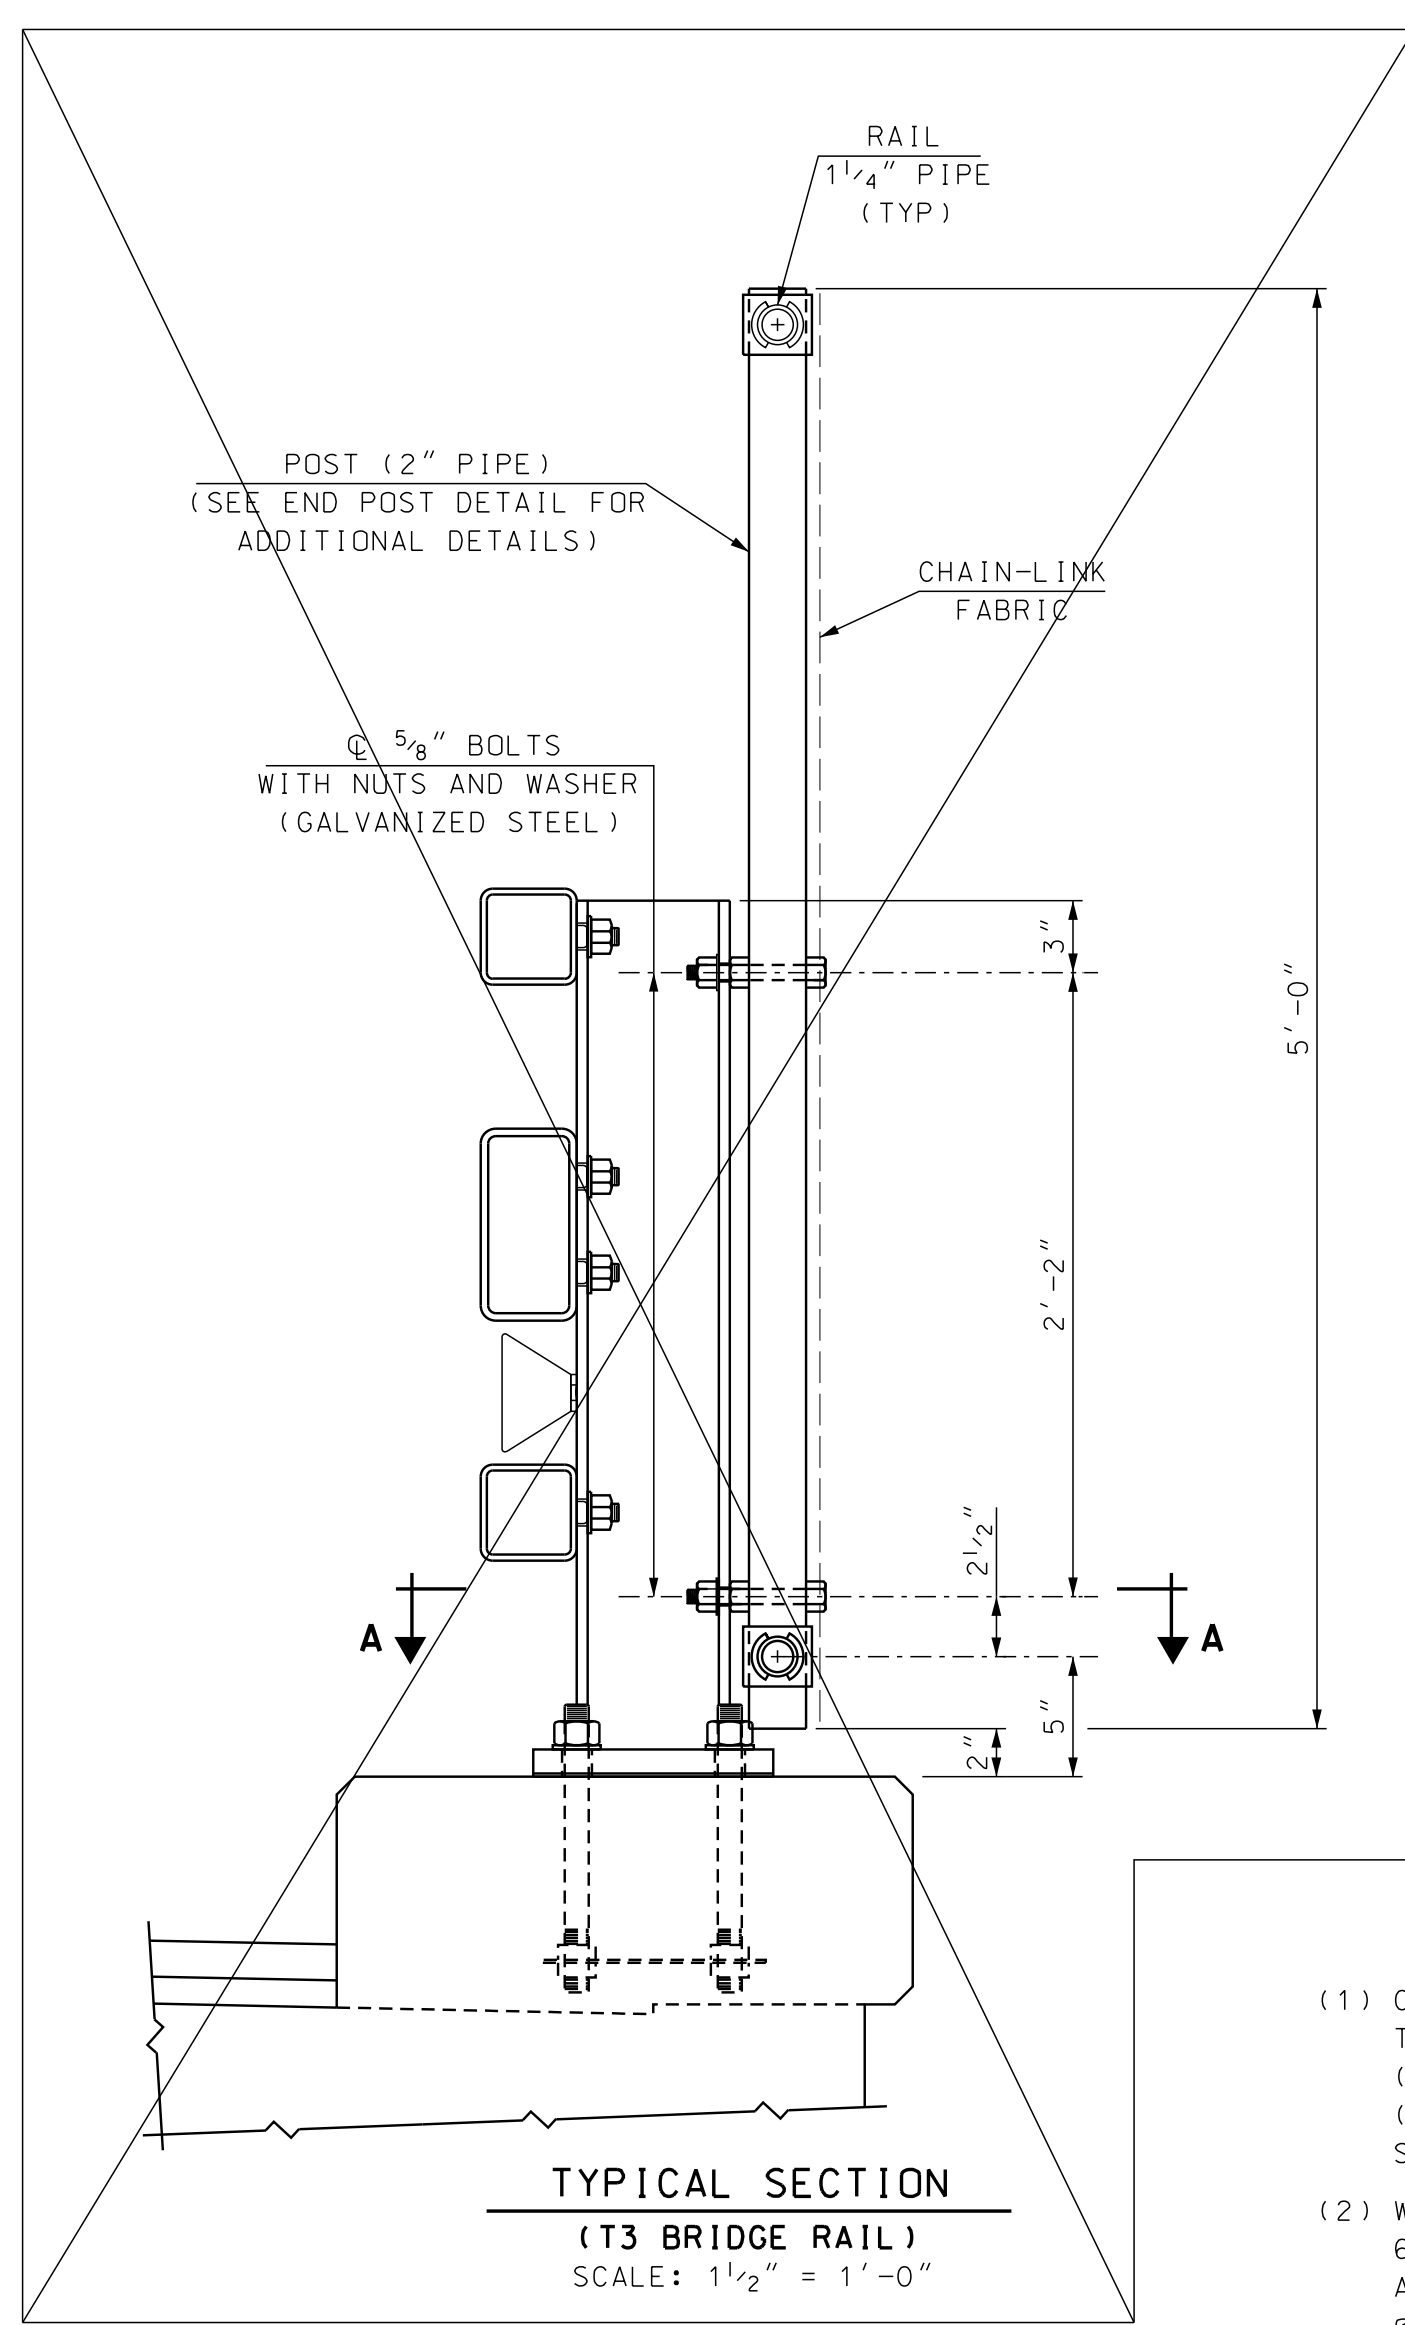


TYPICAL SECTION (T3 BRIDGE RAIL)
SCALE: 1/2" = 1'-0"

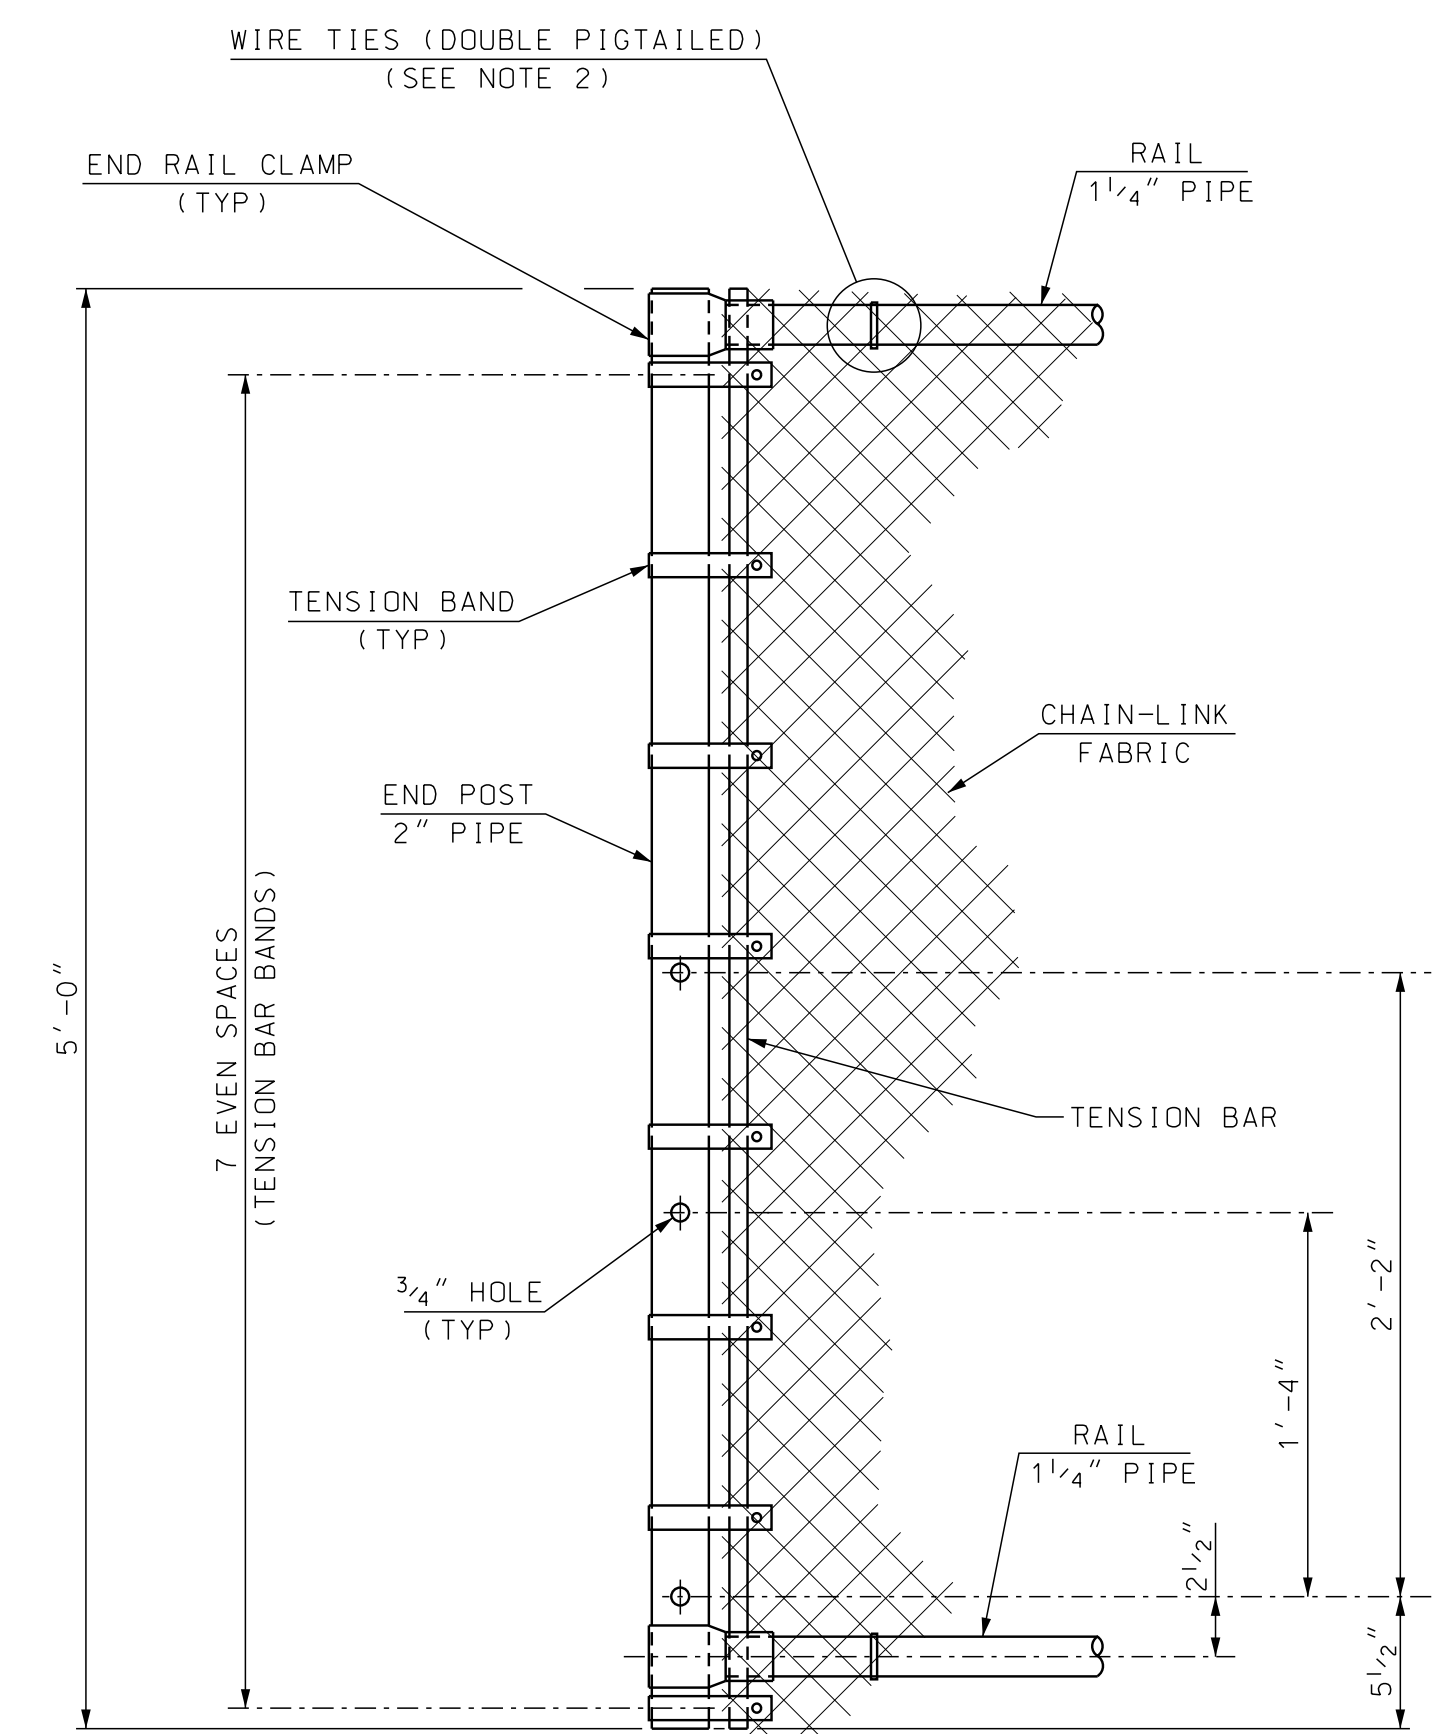


END POST DETAIL
SCALE: 1/2" = 1'-0"

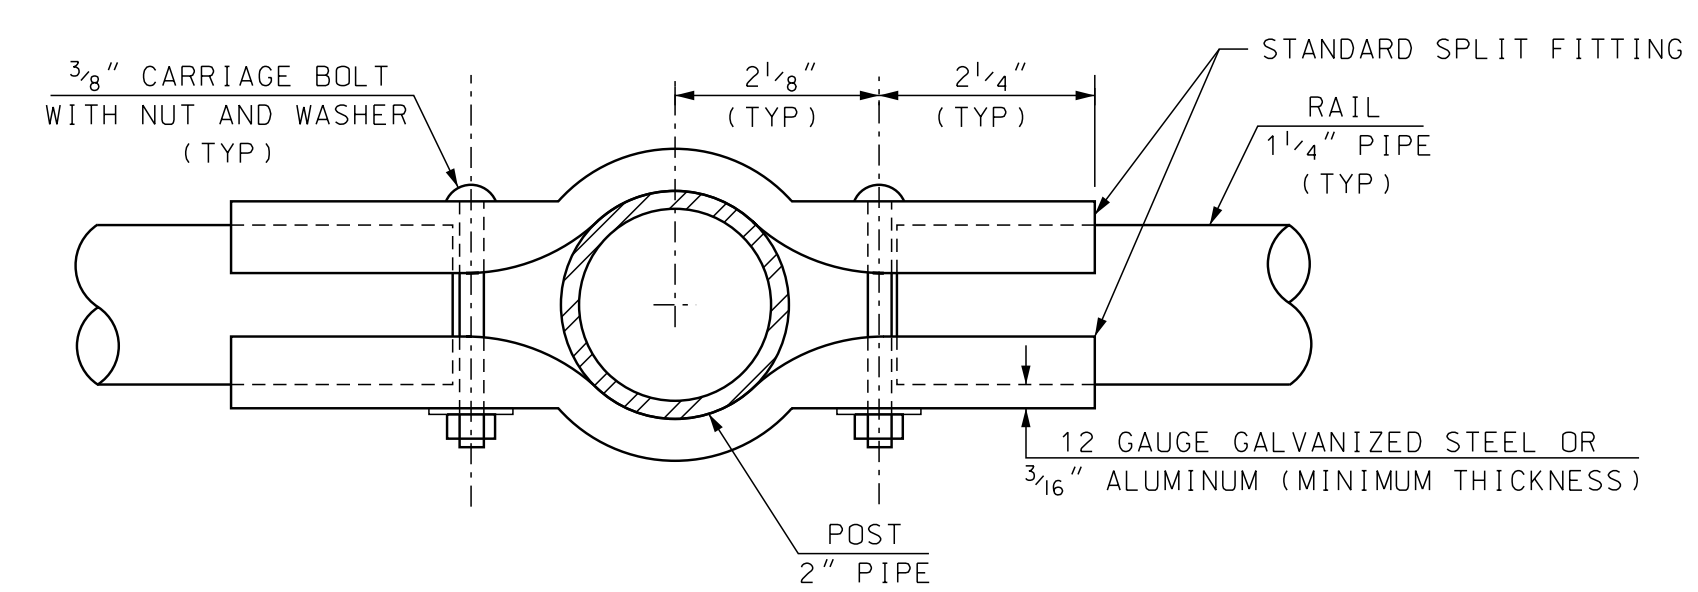


BOULEVARD CLAMP DETAIL
SCALE: 6" = 1'-0"

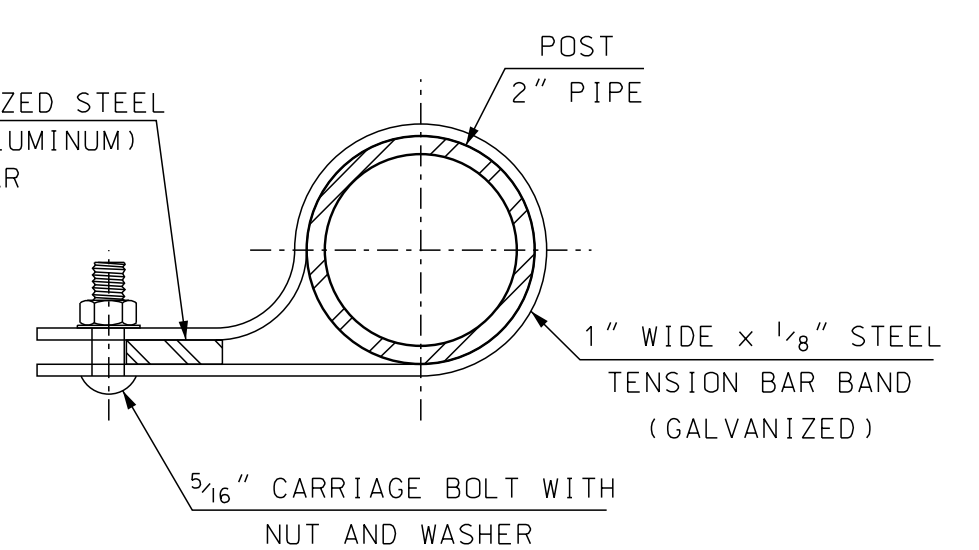


TENSION BAND DETAIL
SCALE: 6" = 1'-0"

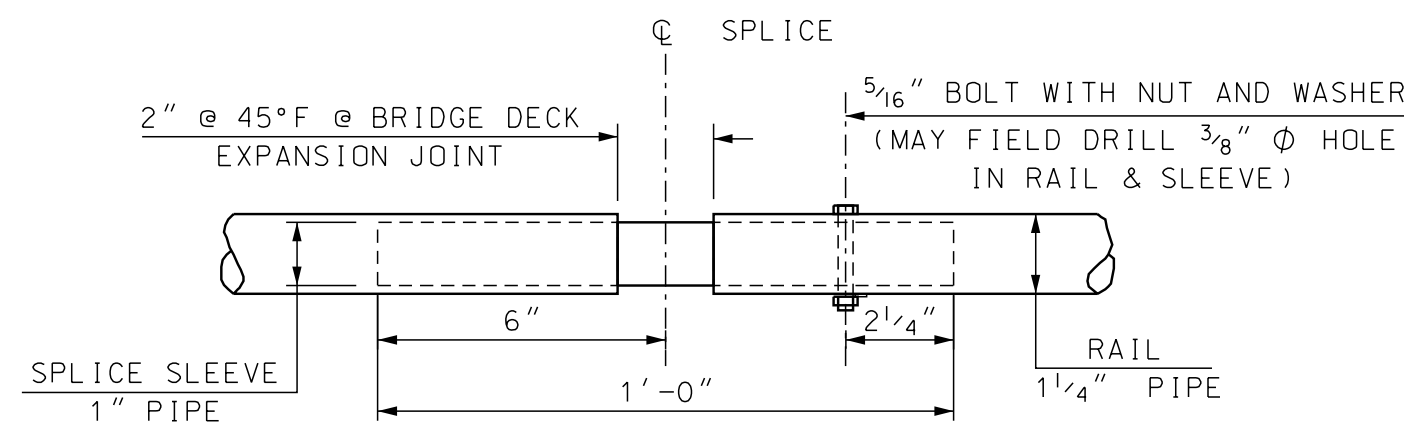


RAIL SPLICE DETAIL
SCALE: 3" = 1'-0"

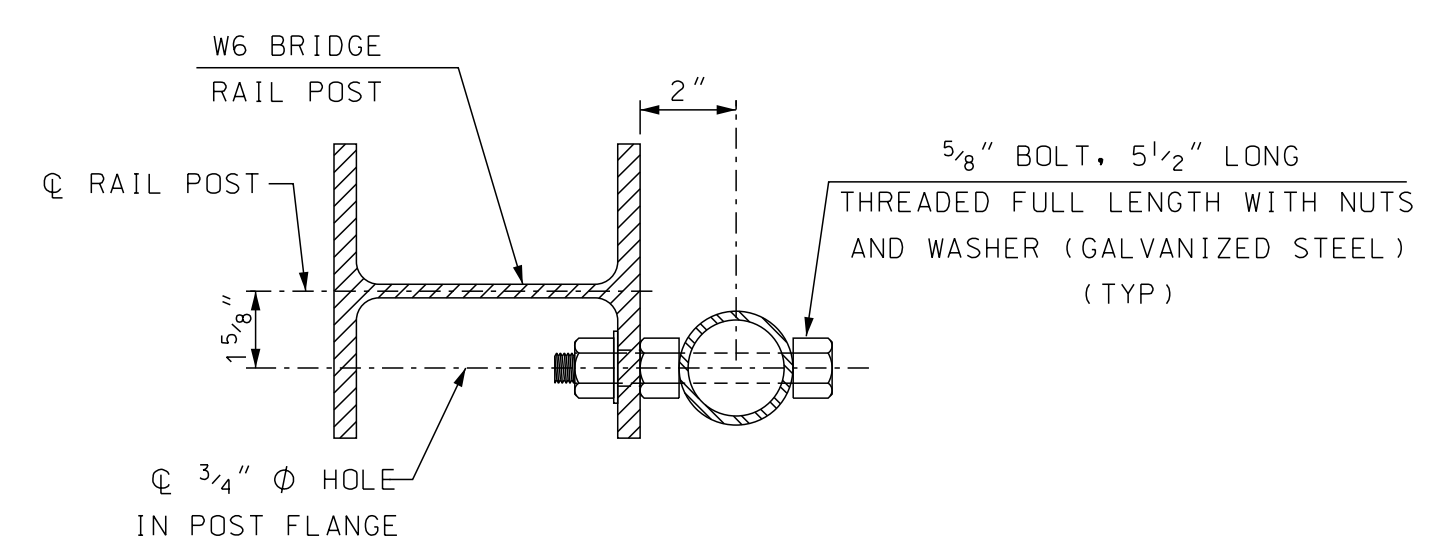

SECTION A-A (AT INTERIOR POST)
SCALE: 3" = 1'-0"

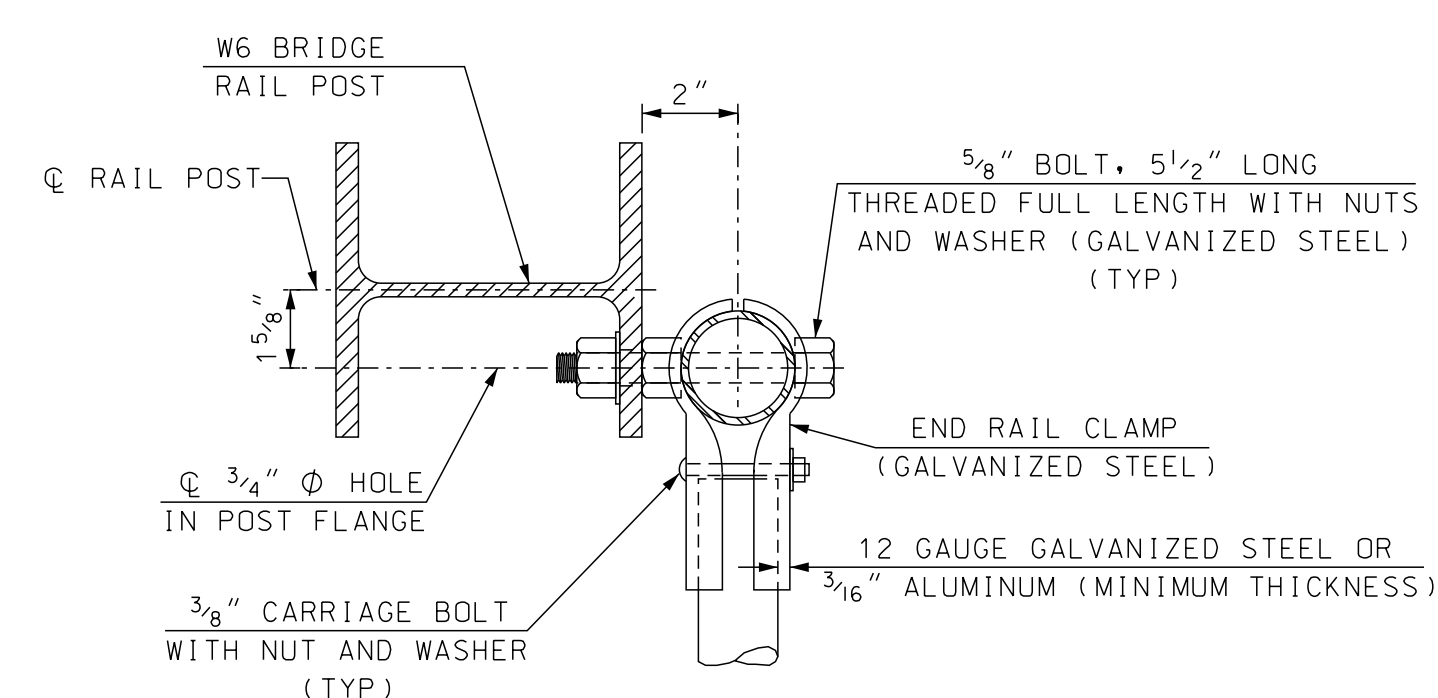


SECTION A-A (AT END POST)
SCALE: 3" = 1'-0"

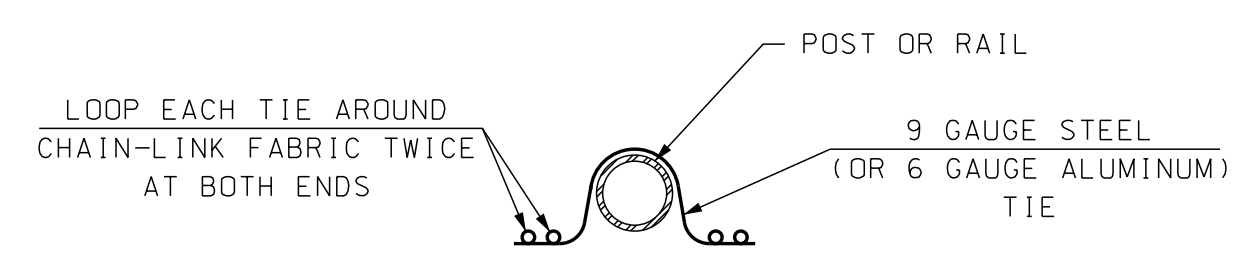


DOUBLE PIGTAILED TIE
NOT TO SCALE

- GENERAL NOTES**
- CHAIN-LINK FABRIC SHALL BE 9 GAUGE STEEL, ZINC-COATED CONFORMING TO AASHTO M 181, TYPE I, CLASS D (ASTM A 392), ALUMINUM-COATED CONFORMING TO AASHTO M 181, TYPE II (ASTM A 491) OR 6 GAUGE ALUMINUM ALLOY CONFORMING TO AASHTO M 181, TYPE III (ASTM F 1183). CHAIN-LINK FABRIC SHALL BE KNUCKLED ON TOP AND BOTTOM. THE SIZE OF WIRE MESH (FABRIC) SHALL BE 1 1/2".
 - WIRE TIES SHALL BE STANDARD ROUND 9 GAUGE ZINC- OR ALUMINUM-COATED STEEL OR 6 GAUGE ALUMINUM ALLOY CONFORMING TO ASTM F 626. ALL TIES SHALL BE WRAPPED AROUND CHAIN-LINK FABRIC TWICE (DOUBLE PIGTAILED) AT BOTH ENDS. SPACE TIES @ 6" O.C. TO BOTTOM RAIL AND @ 12" O.C. TO ALL POSTS AND OTHER RAILS.
 - POST AND RAIL PIPE SHALL BE HOT-DIP GALVANIZED STEEL CONFORMING TO AASHTO M 181, GRADE 1 (ASTM F 1083) OR ALUMINUM ALLOY CONFORMING TO AASHTO M 181 (ASTM B 429, ALLOY 6063-T6). ALL PIPE SHALL BE SCHEDULE 40, STANDARD WEIGHT. NOMINAL PIPE SIZES ARE SHOWN IN THE DRAWINGS.
 - TENSION BARS, BAR BANDS, BOULEVARD AND END RAIL CLAMPS SHALL BE STEEL OR ALUMINUM ALLOY CONFORMING TO AASHTO M 181 (ASTM F 626). STEEL COMPONENTS SHALL BE HOT-DIP GALVANIZED IN ACCORDANCE WITH AASHTO M 111 (ASTM A 123) OR AASHTO M 232 (ASTM A 153) AS APPLICABLE.
 - ALL BOLTS AND NUTS SHALL BE STEEL CONFORMING TO ASTM A 307 AND ASTM A 563 GRADE A RESPECTIVELY. WASHERS SHALL BE HARDENED STEEL COMMERCIAL TYPE A PLAIN AND SHALL MEET THE DIMENSIONAL REQUIREMENTS OF ANSI B18.22. ALL BOLTS, NUTS AND WASHERS SHALL BE HOT-DIP GALVANIZED IN ACCORDANCE WITH AASHTO M 111 (ASTM A 123) OR AASHTO M 232 (ASTM A 153) AS APPLICABLE.
 - RAIL SPLICES SHALL BE PROVIDED AT BRIDGE DECK EXPANSION JOINT(S) AND BRIDGE RAIL SPLICES AS DIRECTED BY THE CONTRACT ADMINISTRATOR.
 - RAIL MAY BE FIELD CUT (SAWN) TO FIT POST SPACING. GALVANIZED RAIL, CUT OR DRILLED AS ALLOWED, SHALL BE TOUCHED-UP IN ACCORDANCE WITH 563.3.2.2.3.
 - ALL COSTS FOR CHAIN-LINK FABRIC, POSTS, RAILS AND APPURTENANCES SHALL BE INCLUDED IN ITEM 563.353, BRIDGE RAIL T101 WITH SNOW SCREENING.
 - SEE BRIDGE RAIL SHEET FOR ADDITIONAL DETAILS.

STATE OF NEW HAMPSHIRE									
DEPARTMENT OF TRANSPORTATION * BUREAU OF BRIDGE DESIGN									
TOWN: EXETER			BRIDGE NO.: 095/063			STATE PROJECT			
LOCATION: LITTLE RIVER CROSSING AT COURT STREET									
SNOW SCREEN WITH T101 BRIDGE RAIL									
REVISIONS		BY		DATE		BY		DATE	
1	ADDED T3 RAIL DETAILS	1/30/13	DESIGNED	NHDOT	8/10	CHECKED	NHDOT	8/10	
			DRAWN	NHDOT	8/10	CHECKED	NHDOT	8/10	
			QUANTITIES	LBK	11/15	CHECKED	JLJG	11/15	
ISSUE DATE		2/98		FEDERAL PROJECT NO.		SHEET NO.		TOTAL SHEETS	
REV. DATE		12/20/13				22		34	

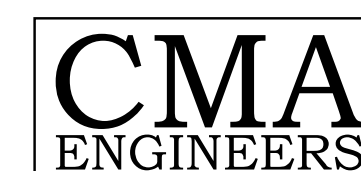

SUBDIRECTORY	DGN LOCATOR	SHEET SCALE
		AS NOTED

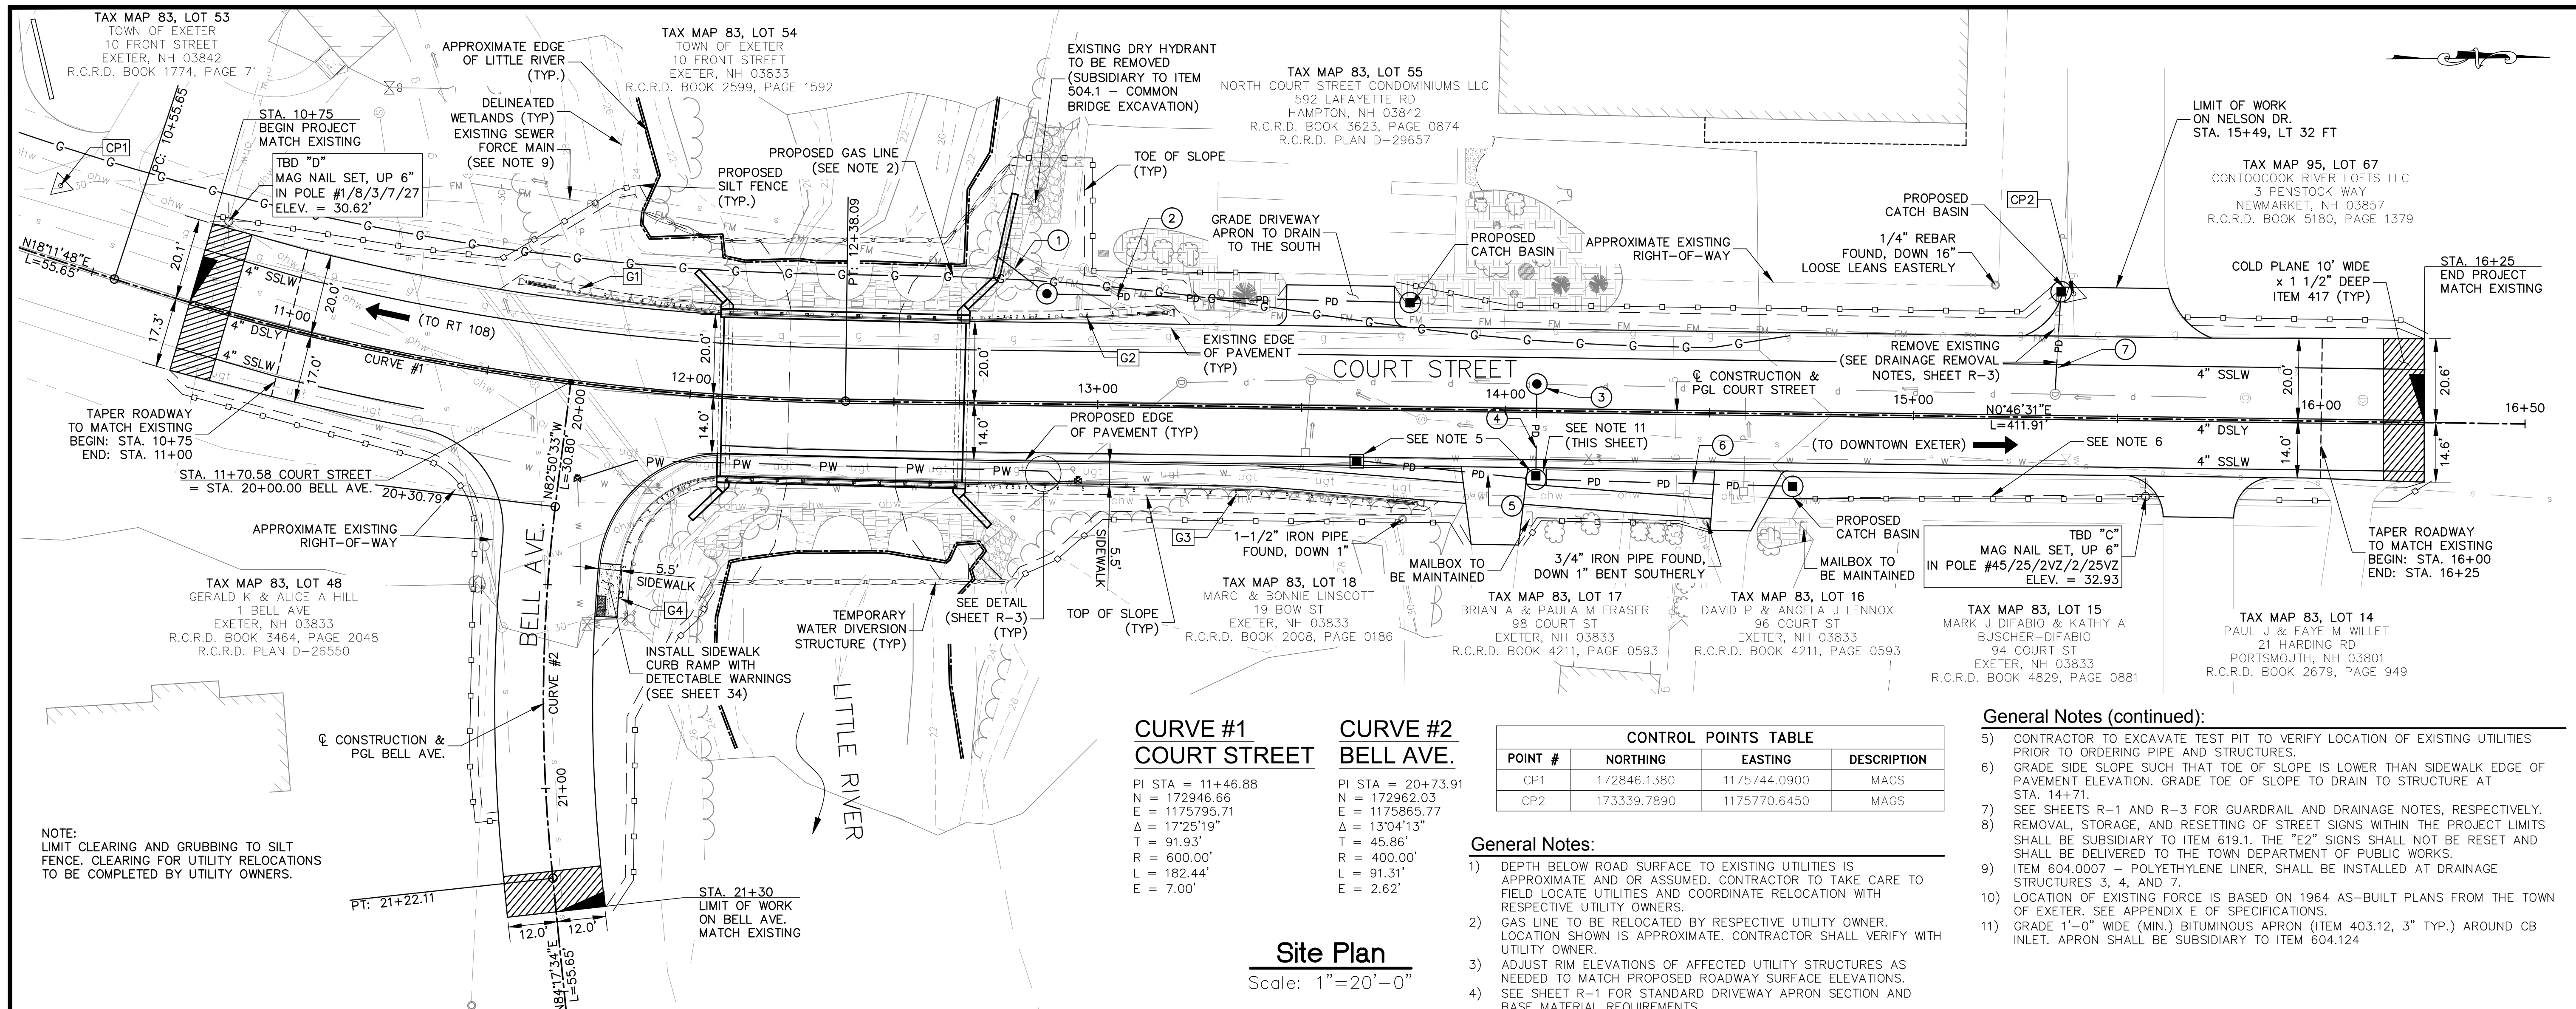

**CURVE #1
COURT STREET**
 PI STA = 11+46.88
 N = 172946.66
 E = 1175795.71
 Δ = 17°25'19"
 T = 91.93'
 R = 600.00'
 L = 182.44'
 E = 7.00'


**CURVE #2
BELL AVE.**
 PI STA = 20+73.91
 N = 172962.03
 E = 1175865.77
 Δ = 13°04'13"
 T = 45.86'
 R = 400.00'
 L = 91.31'
 E = 2.62'

POINT #	NORTHING	EASTING	DESCRIPTION
CP1	172846.1380	1175744.0900	MAGS
CP2	173339.7890	1175770.6450	MAGS

- General Notes:**
- DEPTH BELOW ROAD SURFACE TO EXISTING UTILITIES IS APPROXIMATE AND OR ASSUMED. CONTRACTOR TO TAKE CARE TO FIELD LOCATE UTILITIES AND COORDINATE RELOCATION WITH RESPECTIVE UTILITY OWNERS.
 - GAS LINE TO BE RELOCATED BY RESPECTIVE UTILITY OWNER. LOCATION SHOWN IS APPROXIMATE. CONTRACTOR SHALL VERIFY WITH UTILITY OWNER.
 - ADJUST RIM ELEVATIONS OF AFFECTED UTILITY STRUCTURES AS NEEDED TO MATCH PROPOSED ROADWAY SURFACE ELEVATIONS. SEE SHEET R-1 FOR STANDARD DRIVEWAY APRON SECTION AND BASE MATERIAL REQUIREMENTS.


- General Notes (continued):**
- CONTRACTOR TO EXCAVATE TEST PIT TO VERIFY LOCATION OF EXISTING UTILITIES PRIOR TO ORDERING PIPE AND STRUCTURES.
 - GRADE SIDE SLOPE SUCH THAT TOE OF SLOPE IS LOWER THAN SIDEWALK EDGE OF PAVEMENT ELEVATION. GRADE TOE OF SLOPE TO DRAIN TO STRUCTURE AT STA. 14+71.
 - SEE SHEETS R-1 AND R-3 FOR GUARDRAIL AND DRAINAGE NOTES, RESPECTIVELY.
 - REMOVAL, STORAGE, AND RESETTING OF STREET SIGNS WITHIN THE PROJECT LIMITS SHALL BE SUBSIDIARY TO ITEM 619.1. THE "E2" SIGNS SHALL NOT BE RESET AND SHALL BE DELIVERED TO THE TOWN DEPARTMENT OF PUBLIC WORKS.
 - ITEM 604.0007 - POLYETHYLENE LINER, SHALL BE INSTALLED AT DRAINAGE STRUCTURES 3, 4, AND 7.
 - LOCATION OF EXISTING FORCE IS BASED ON 1964 AS-BUILT PLANS FROM THE TOWN OF EXETER. SEE APPENDIX E OF SPECIFICATIONS.
 - GRADE 1'-0" WIDE (MIN.) BITUMINOUS APRON (ITEM 403.12, 3" TYP.) AROUND CB INLET. APRON SHALL BE SUBSIDIARY TO ITEM 604.124

Site Plan
 Scale: 1"=20'-0"

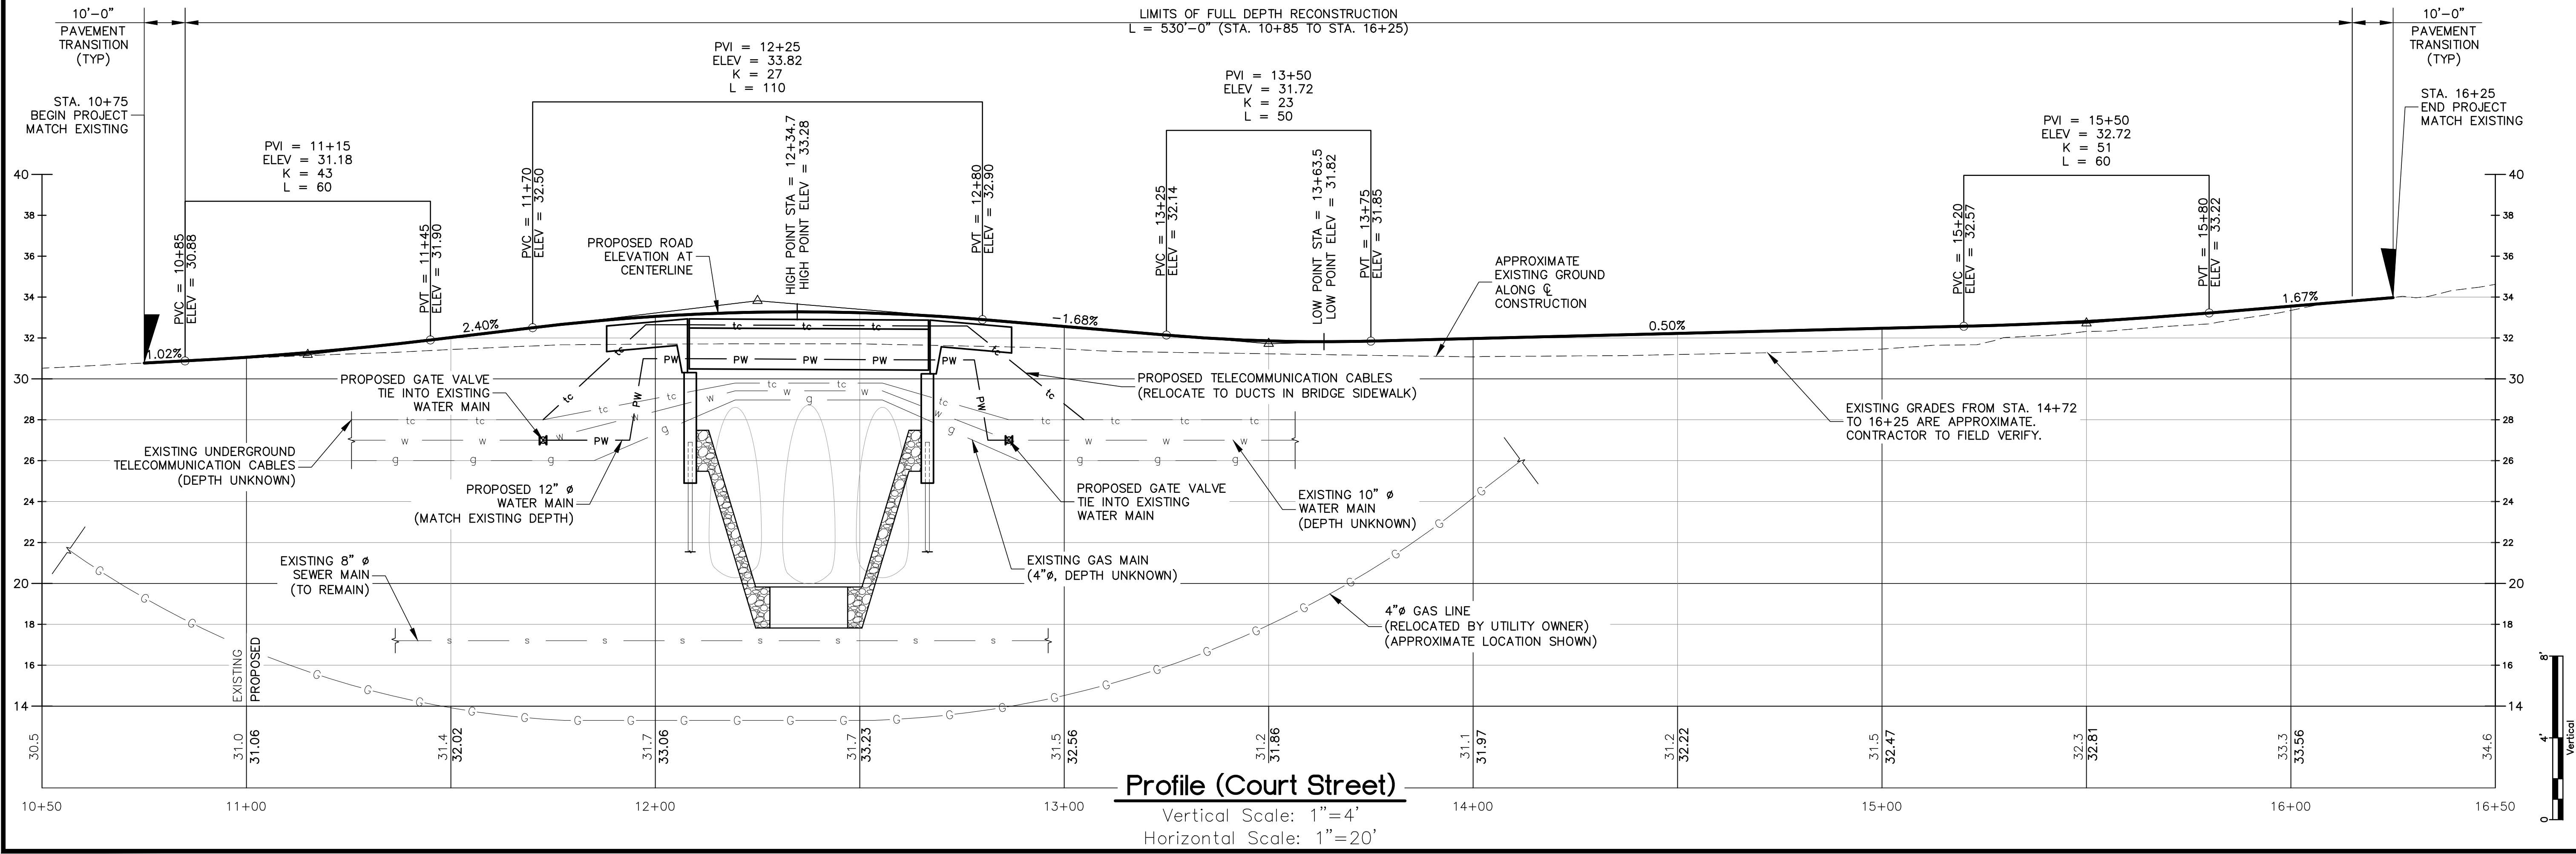


Profile (Court Street)
 Vertical Scale: 1"=4'
 Horizontal Scale: 1"=20'


designed by: LBK/OGK	date: June 2017	project no: R-2	drawing no: R-2
drawn by: LBK/BGP	file name: R-2.dwg	approved by: JLG	sheet: 24 of 34
<p>Town of Exeter Department of Public Works Court Street Little River Bridge Replacement Roadway Plan and Profile (Sheet 1 of 2)</p>			
<p>CMA ENGINEERS CIVIL/ENVIRONMENTAL/STRUCTURAL Portsmouth, NH • Manchester, NH • Portland, ME 603/431-6196 • 603/627-0708 • 207/541-4223 c m a e n g i n e e r s . c o m</p>			

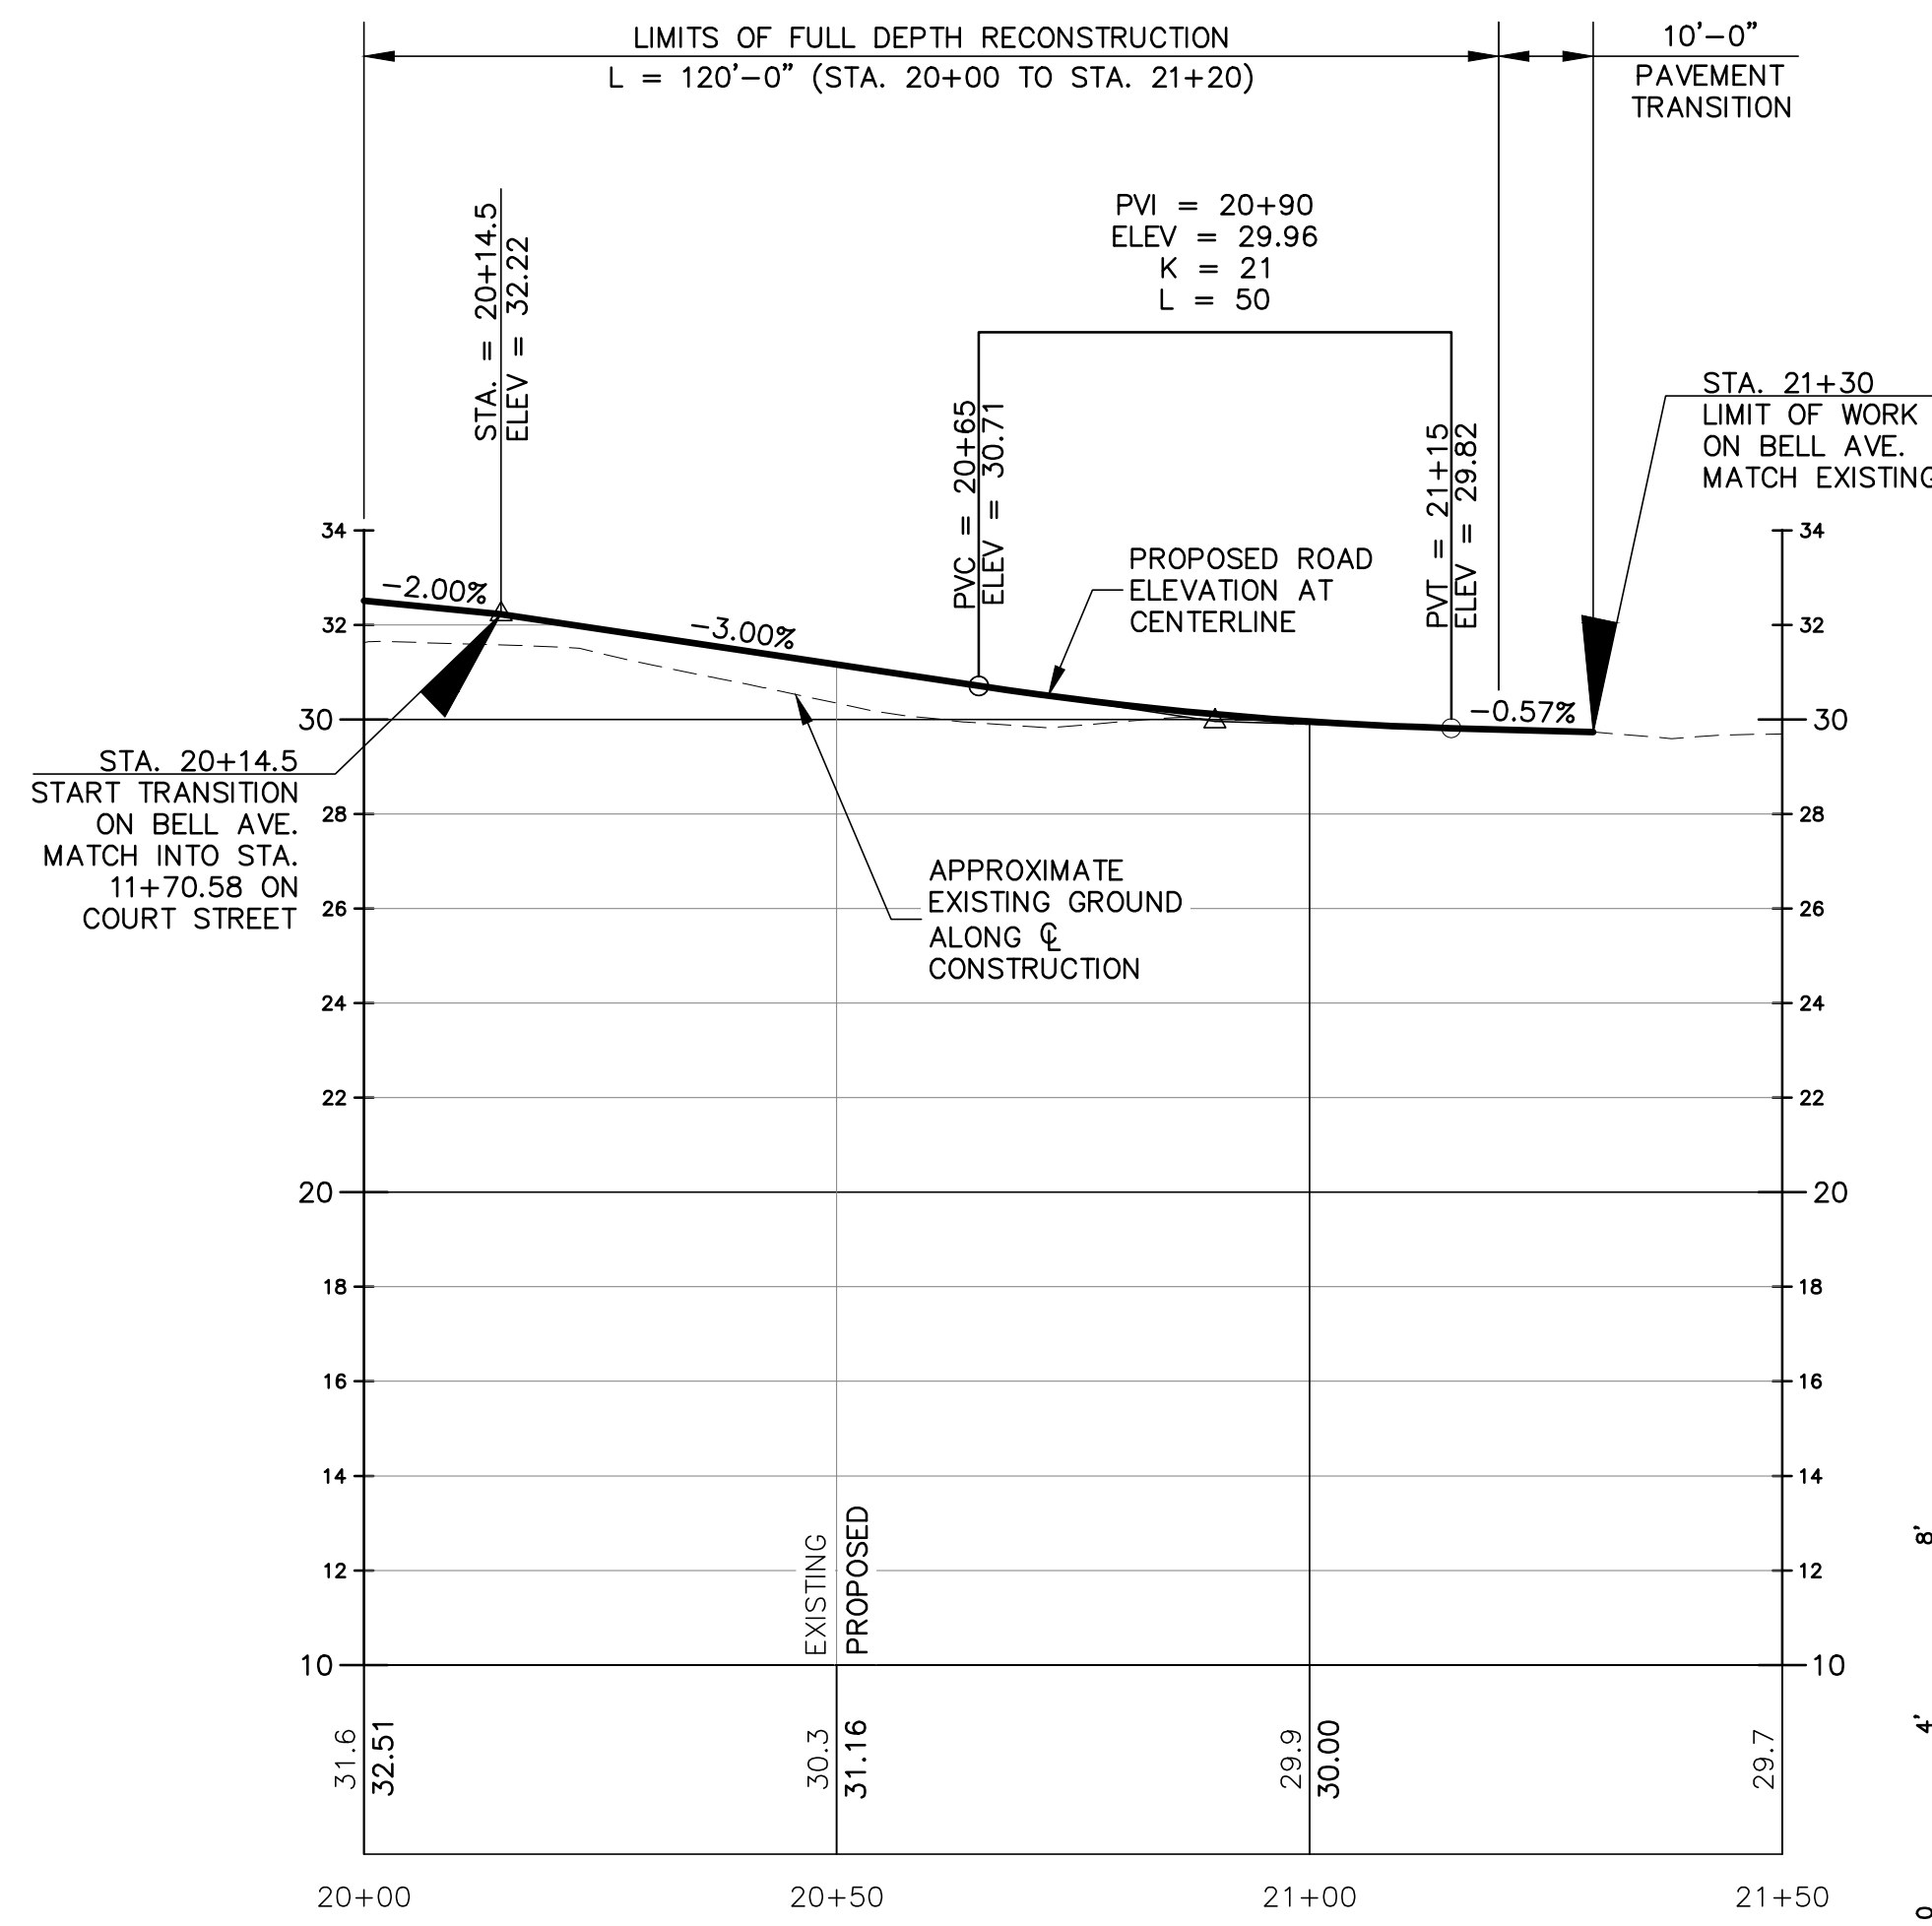

Profile (Bell Ave.)
 Vertical Scale: 1"=4'
 Horizontal Scale: 1"=20'

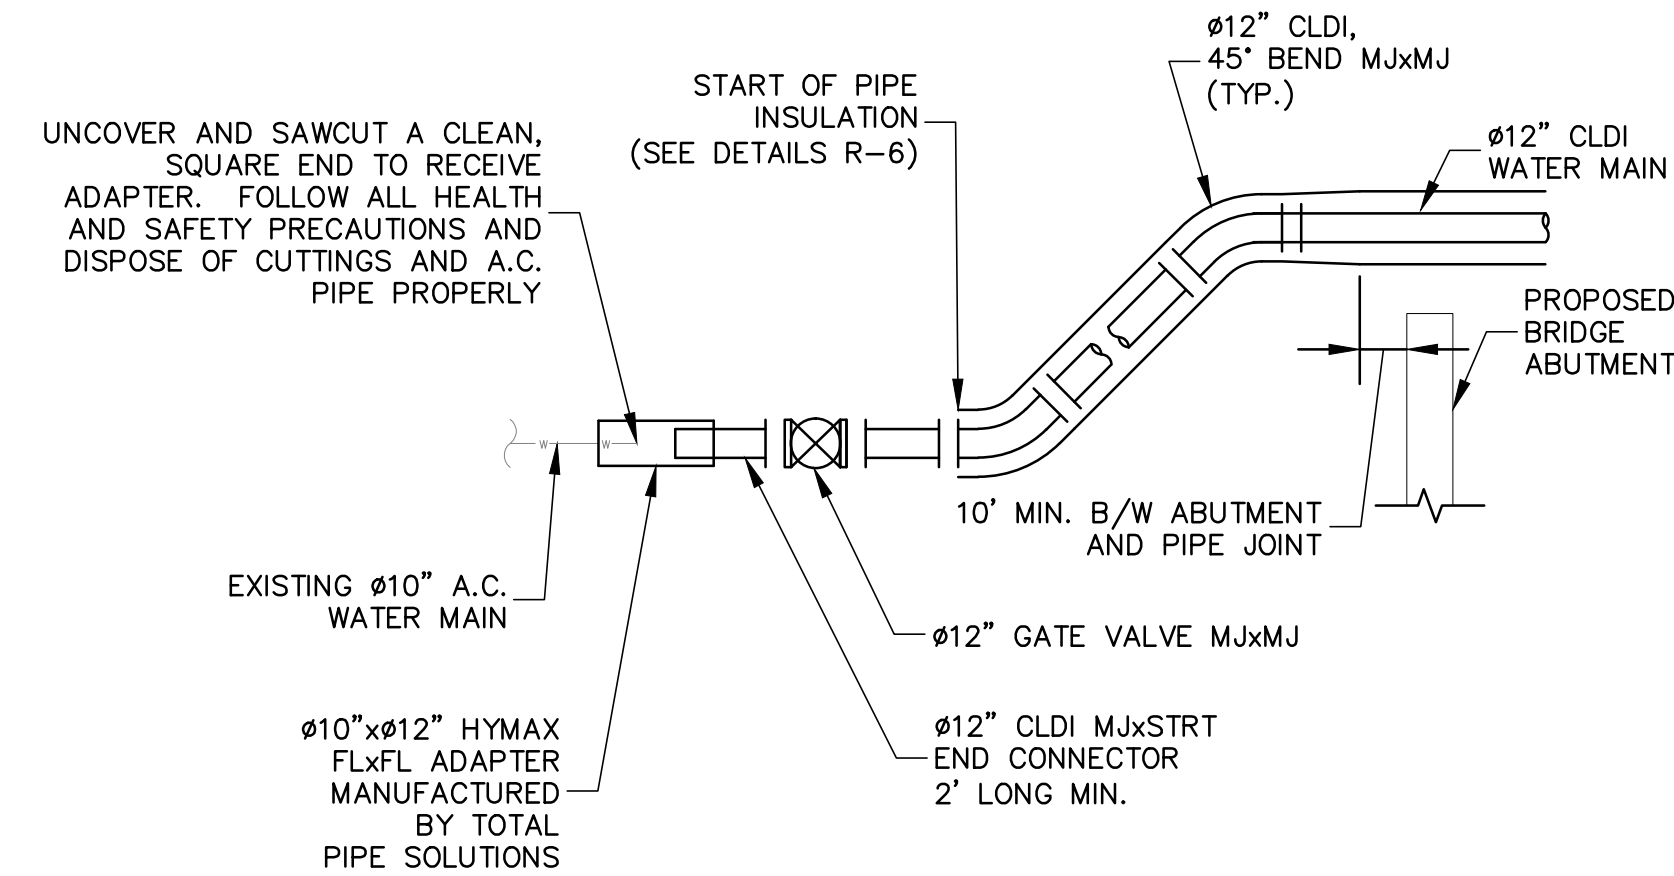


Detail A (2 Typ)
 Not to Scale

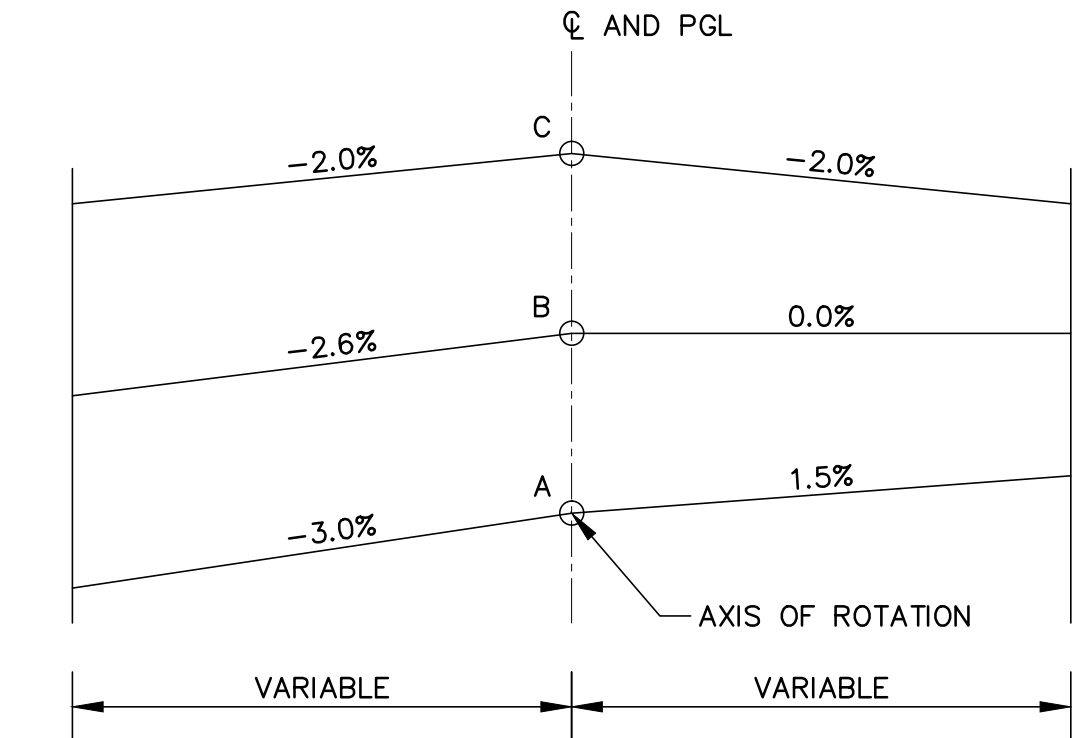

Superelevation Break Points
 Not to Scale

CURVE NO.	A	B	C
1	10+75	11+07	11+50

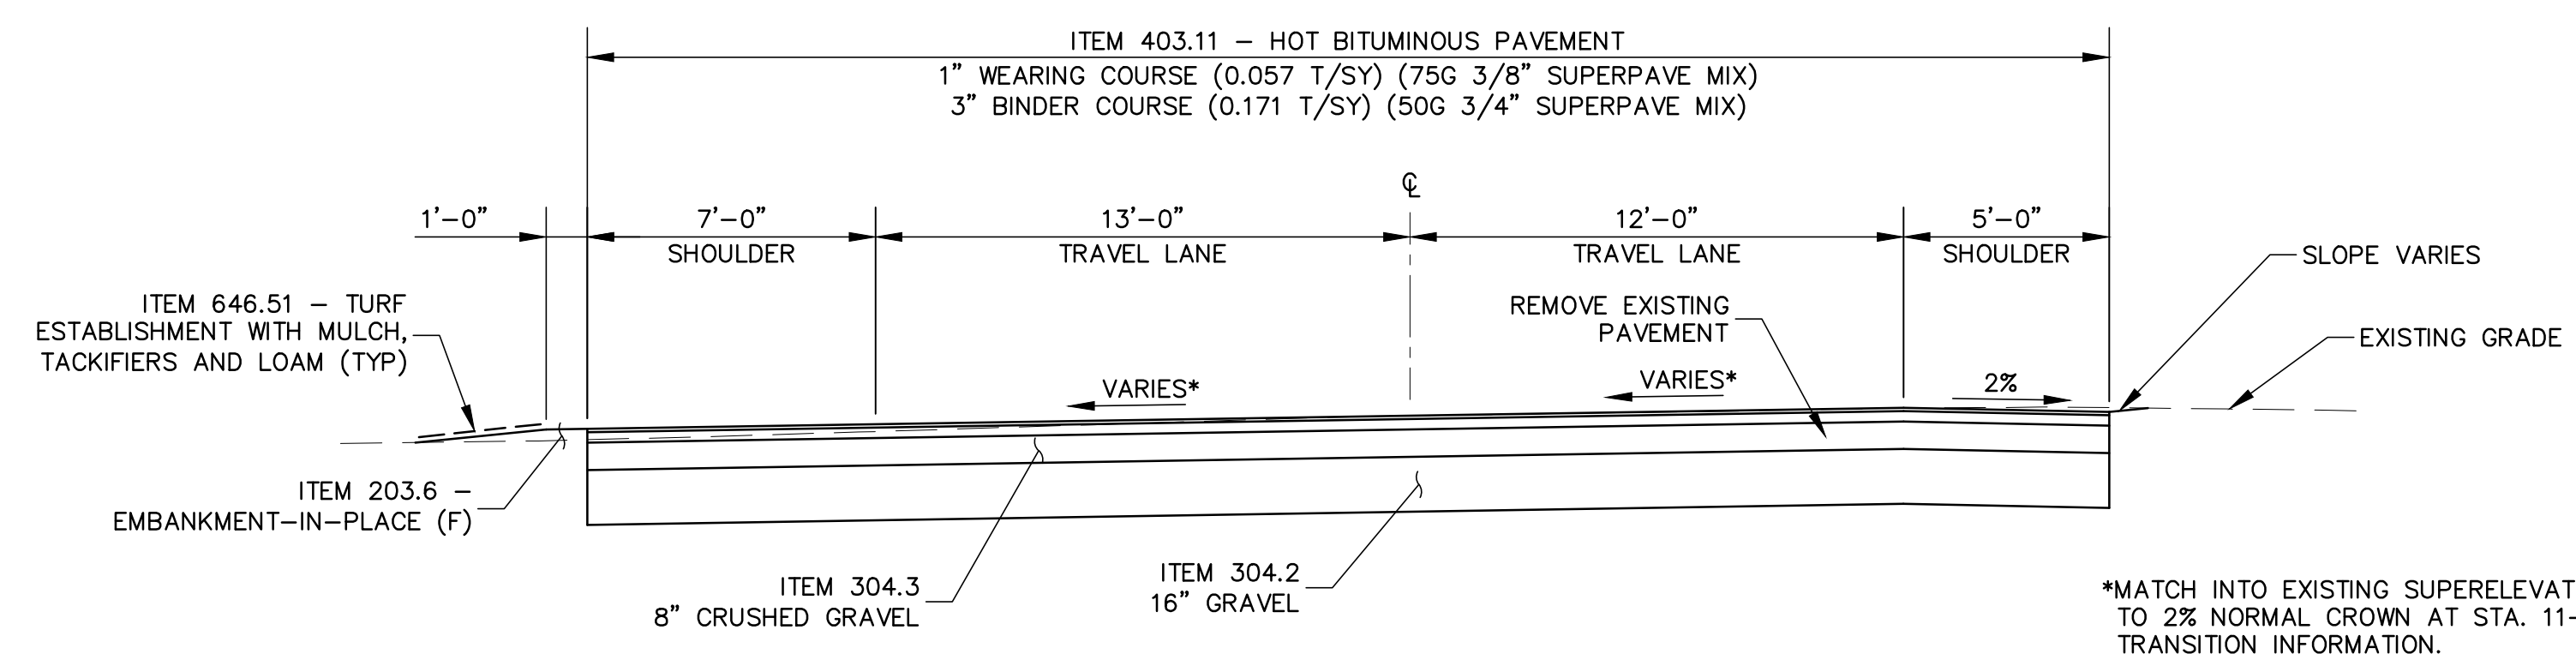

Typical Section (Superelevation)
 Not to Scale

Drainage Notes:


- STA 12+75, LT 35.8 FT TO STA 12+87, LT 27.0 FT
 INSTALL 14 FT OF 12" RC PIPE
 INSTALL 4" I.D. DMH, 12+87, RT 27.0 FT
 12" INV. IN: 25.40'
 12" INV. OUT: 25.15'
 RIM: 31.00'
- STA 12+87, LT 27.0 FT TO STA 13+76, LT 26.0 FT
 INSTALL 86 FT OF 12" RC PIPE
 INSTALL 4" I.D. CB-B, 13+76, LT 26.0 FT
 12" INV. OUT: 26.25'
 RIM: 30.25'
- INSTALL 5" D.I. DMH, 14+08, LT 6.5 FT
 12" INV. IN: 26.25' (SEE DRAINAGE NOTE 3)
 30" INV. IN: 23.65' ± (EX.) (SEE DRAINAGE NOTE 2)
 30" INV. OUT: 23.65' ± (EX.) (SEE DRAINAGE NOTE 2)
 RIM: 31.85'
- STA 14+08, LT 6.5 FT TO STA 14+08, RT 16.9 FT
 INSTALL 20 FT OF 12" RC PIPE
 INSTALL 4" I.D. CB-B, 14+08, RT 16.9 FT
 (WITH ECCENTRIC TOP, ROTATE PER PLANS)
 12" INV. IN: 26.80' (SOUTH)
 12" INV. IN: 26.80' (NORTH)
 12" INV. OUT: 26.80'
 RIM: 31.40'
- STA 13+64, RT 13.0 FT TO STA 14+08, RT 16.9 FT
 INSTALL 41 FT OF 12" RC PIPE
 INSTALL DROP INLET TYPE D-B, 13+64, RT 13.0 FT
 12" INV. OUT: 27.65'
 RIM: 31.50'
- STA 14+08, RT 16.9 FT TO STA 14+71, RT 17.8 FT
 INSTALL 60 FT OF 12" RC PIPE
 INSTALL 4" I.D. CB-B, 14+71, RT 17.8 FT
 12" INV. OUT: 27.10'
 RIM: 30.80'
- STA 15+35, LT 7.0 FT TO STA 15+36, LT 30.8 FT
 INSTALL 21 FT OF 12" RC PIPE
 (CONNECT TO EX. DMH (SUBSIDIARY))
 12" INV. = 25.45' (SEE DRAINAGE NOTE 3)
 INSTALL 4" I.D. CB-B, 15+36, LT 30.8 FT
 12" INV. IN: 25.95' ± (EX.) (SEE DRAINAGE NOTE 2)
 12" INV. OUT: 25.70' (SEE DRAINAGE NOTE 2)
 RIM: 31.45'

Drainage Removal Notes:

- CONTRACTOR TO HAVE ENGINEER VERIFY ALL DRAINAGE STRUCTURES AND PIPING LISTED BELOW, PRIOR TO REMOVAL.
- DRAINAGE STRUCTURES TO BE REMOVED:
 STA. 13+06 LT 22.4'
 STA. 13+51 RT 11.0'
 STA. 14+59 RT 19.2'
 STA. 15+35 LT 21.8'
- ALL PIPING CONNECTED TO STRUCTURES BEING REMOVED SHALL ALSO BE REMOVED UNLESS PIPING WILL BE RECONNECTED TO A NEW STRUCTURE.




Drainage Notes:

- CONTRACTOR TO FIELD VERIFY ELEVATIONS OF EXISTING 30" RCP DRAINAGE LINE WHERE IT IS BEING TIED INTO. ADJUST PROPOSED PIPE INVERTS AND DRAINAGE STRUCTURES AS NEEDED BASED ON ANY DIFFERENCE BETWEEN ACTUAL AND ASSUMED ELEVATIONS.
- INV. IN AND INV. OUT ELEVATIONS SHALL BE SET BASED ON EXISTING PIPE INV. ELEVATIONS WHERE THE PROPOSED STRUCTURE INTERSECTS THE EXISTING PIPE.
- INV. OF PROPOSED 12" RC PIPE SHALL BE SET SUCH THAT THE CROWN EL. IS ABOVE OR MATCHES THE HIGHEST CROWN EL. OF THE 30" RC PIPES PRESENT AT THE SAME MANHOLE.

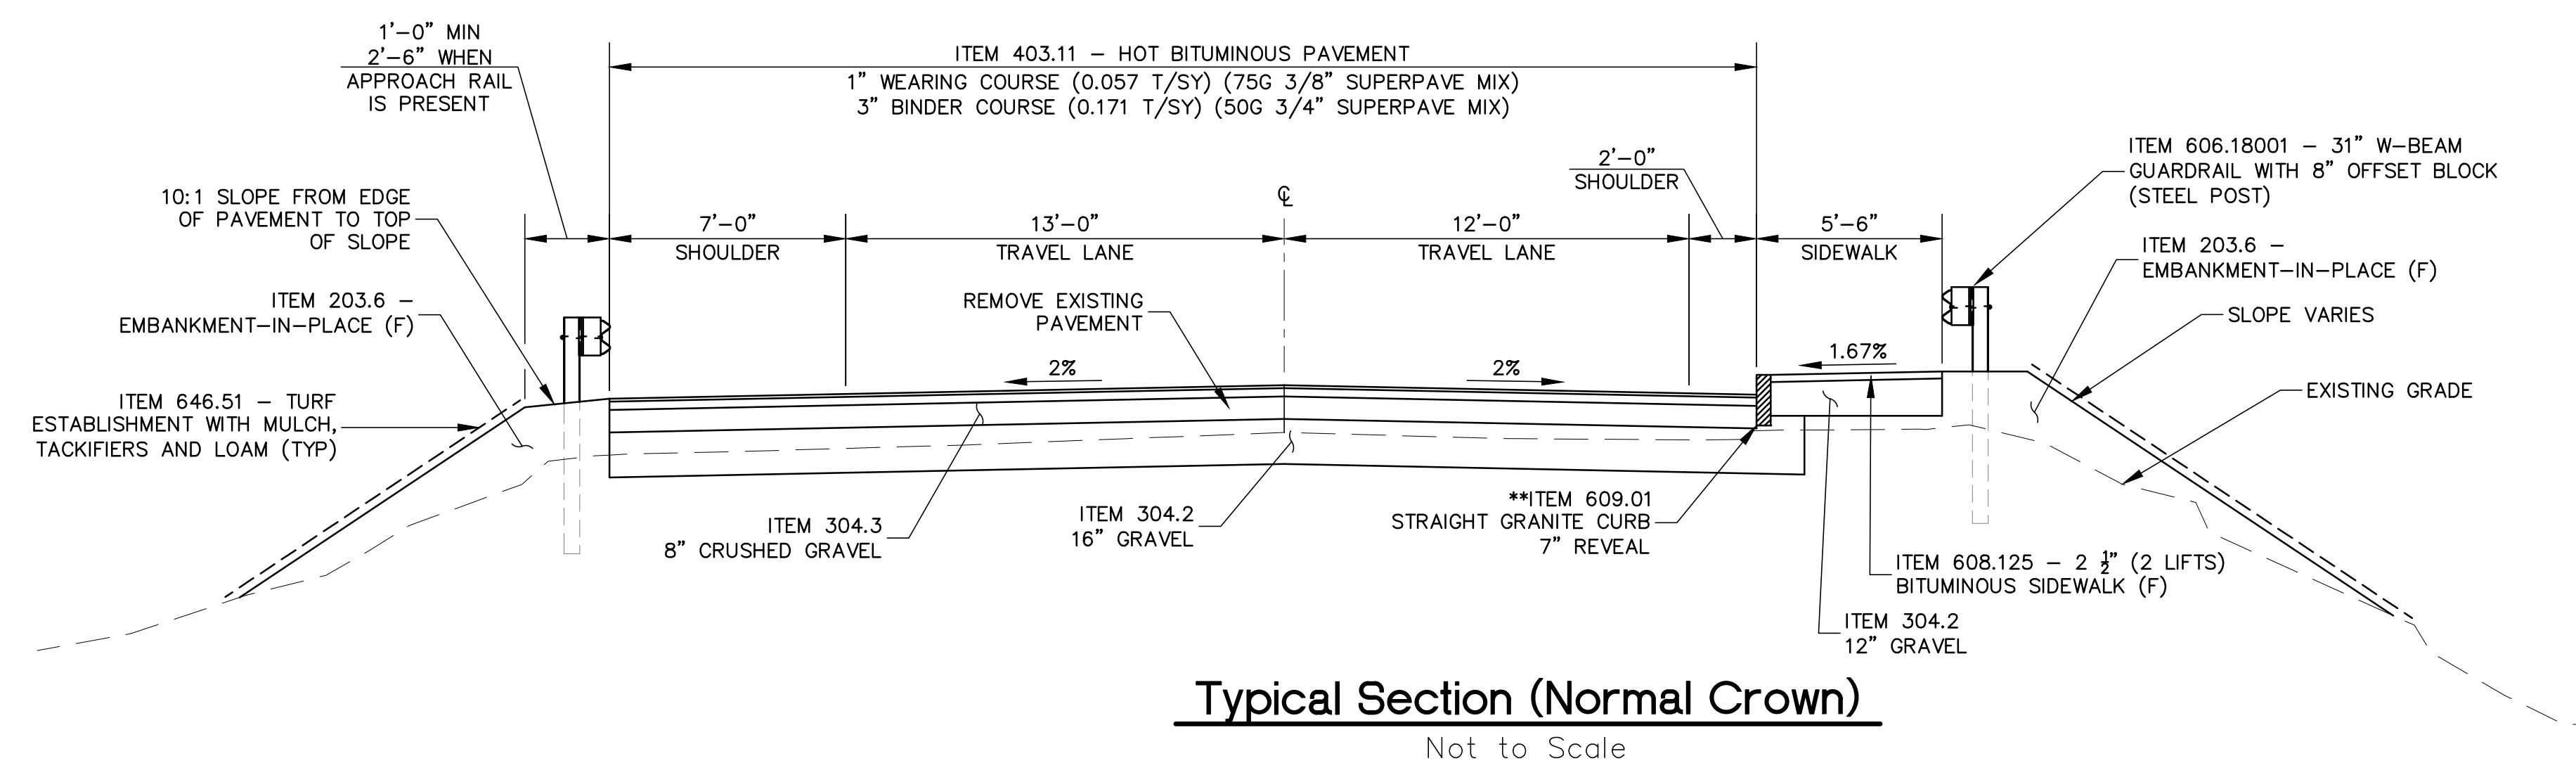




Typical Section (Normal Crown)
 Not to Scale

		6/13/17 JLG date
ISSUED FOR CONSTRUCTION A		no.
CIVIL/ENVIRONMENTAL/STRUCTURAL CMA ENGINEERS Portsmouth, NH • Manchester, NH • Portland, ME 603/431-6196 • 603/627-0708 • 207/541-4223 c m a e n g i n e e r s . c o m		revision
designed by: LBK/OKK	drawn by: LBK/BGP	approved by: JLG
date: June 2017	project no.: R-3	file name: R-3.dwg
Town of Exeter Department of Public Works Court Street Little River Bridge Replacement Roadway Plan and Profile (Sheet 2 of 2)		scale: 20' = 1"
drawing no. R-3		
sheet: 25 of 34		

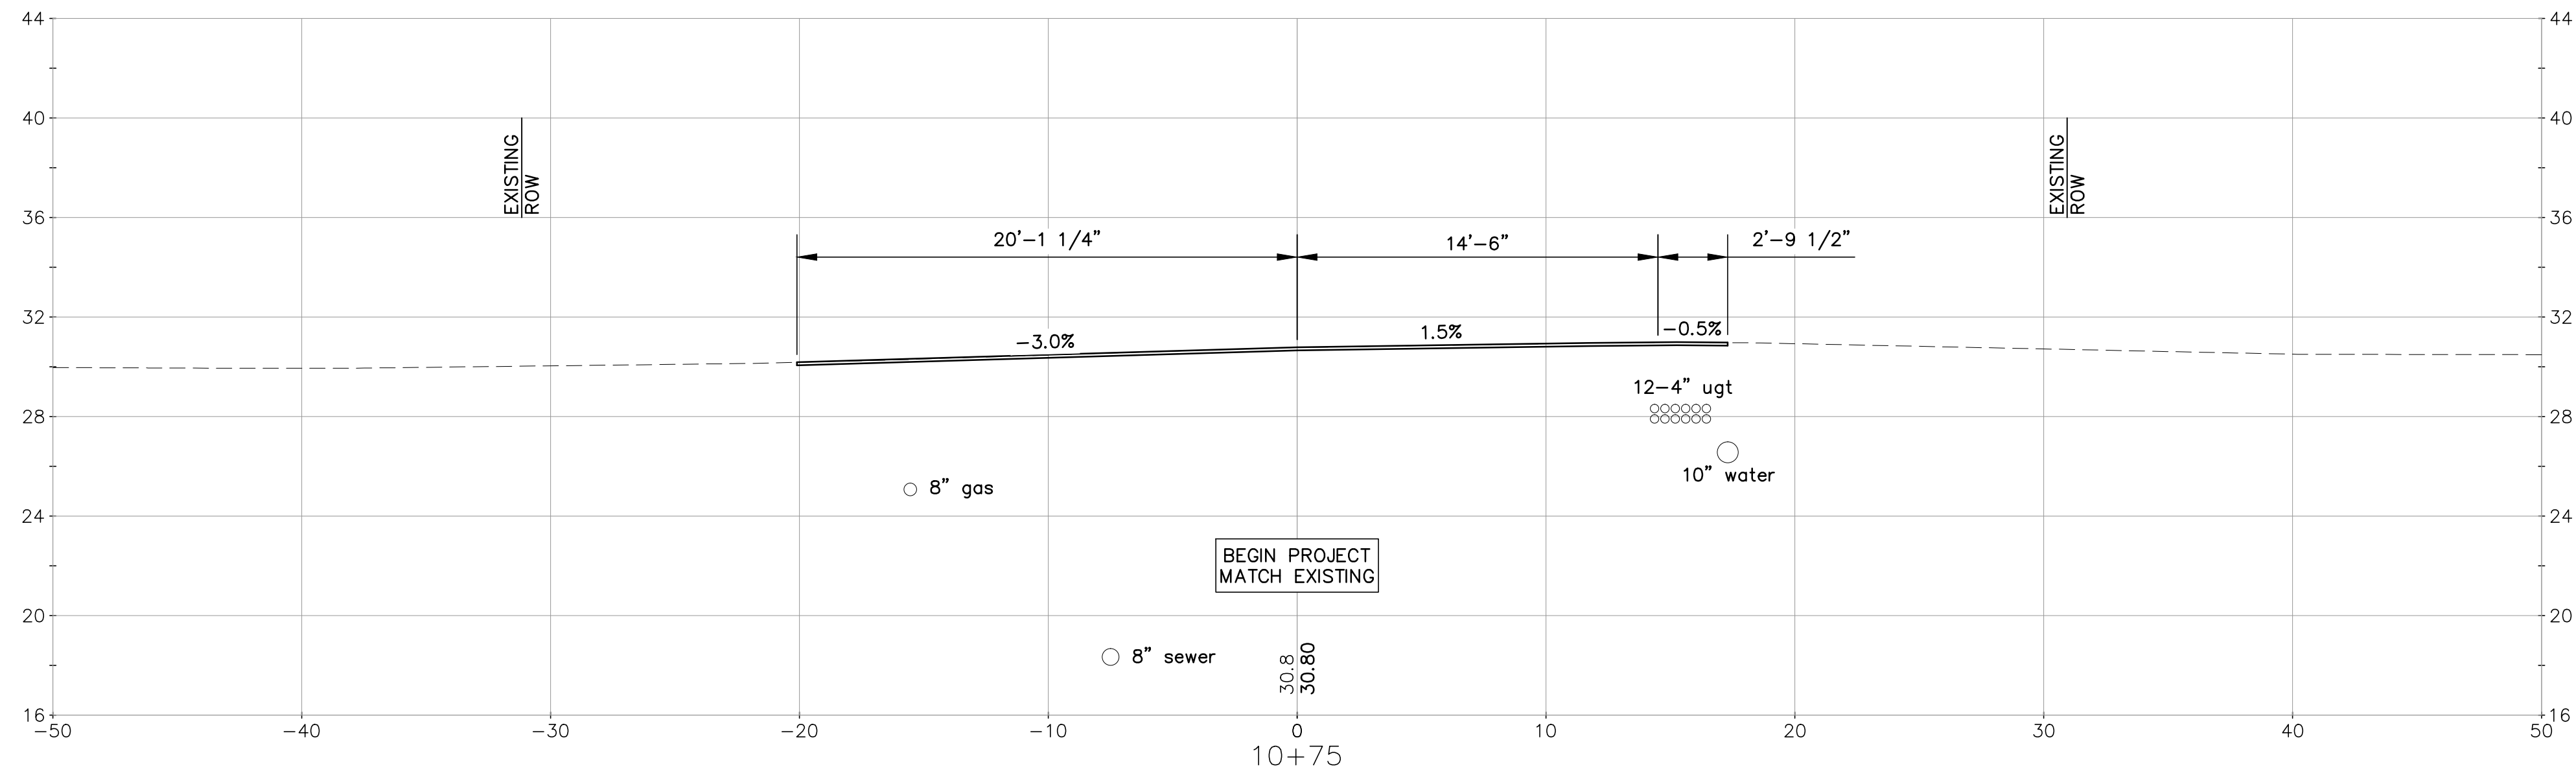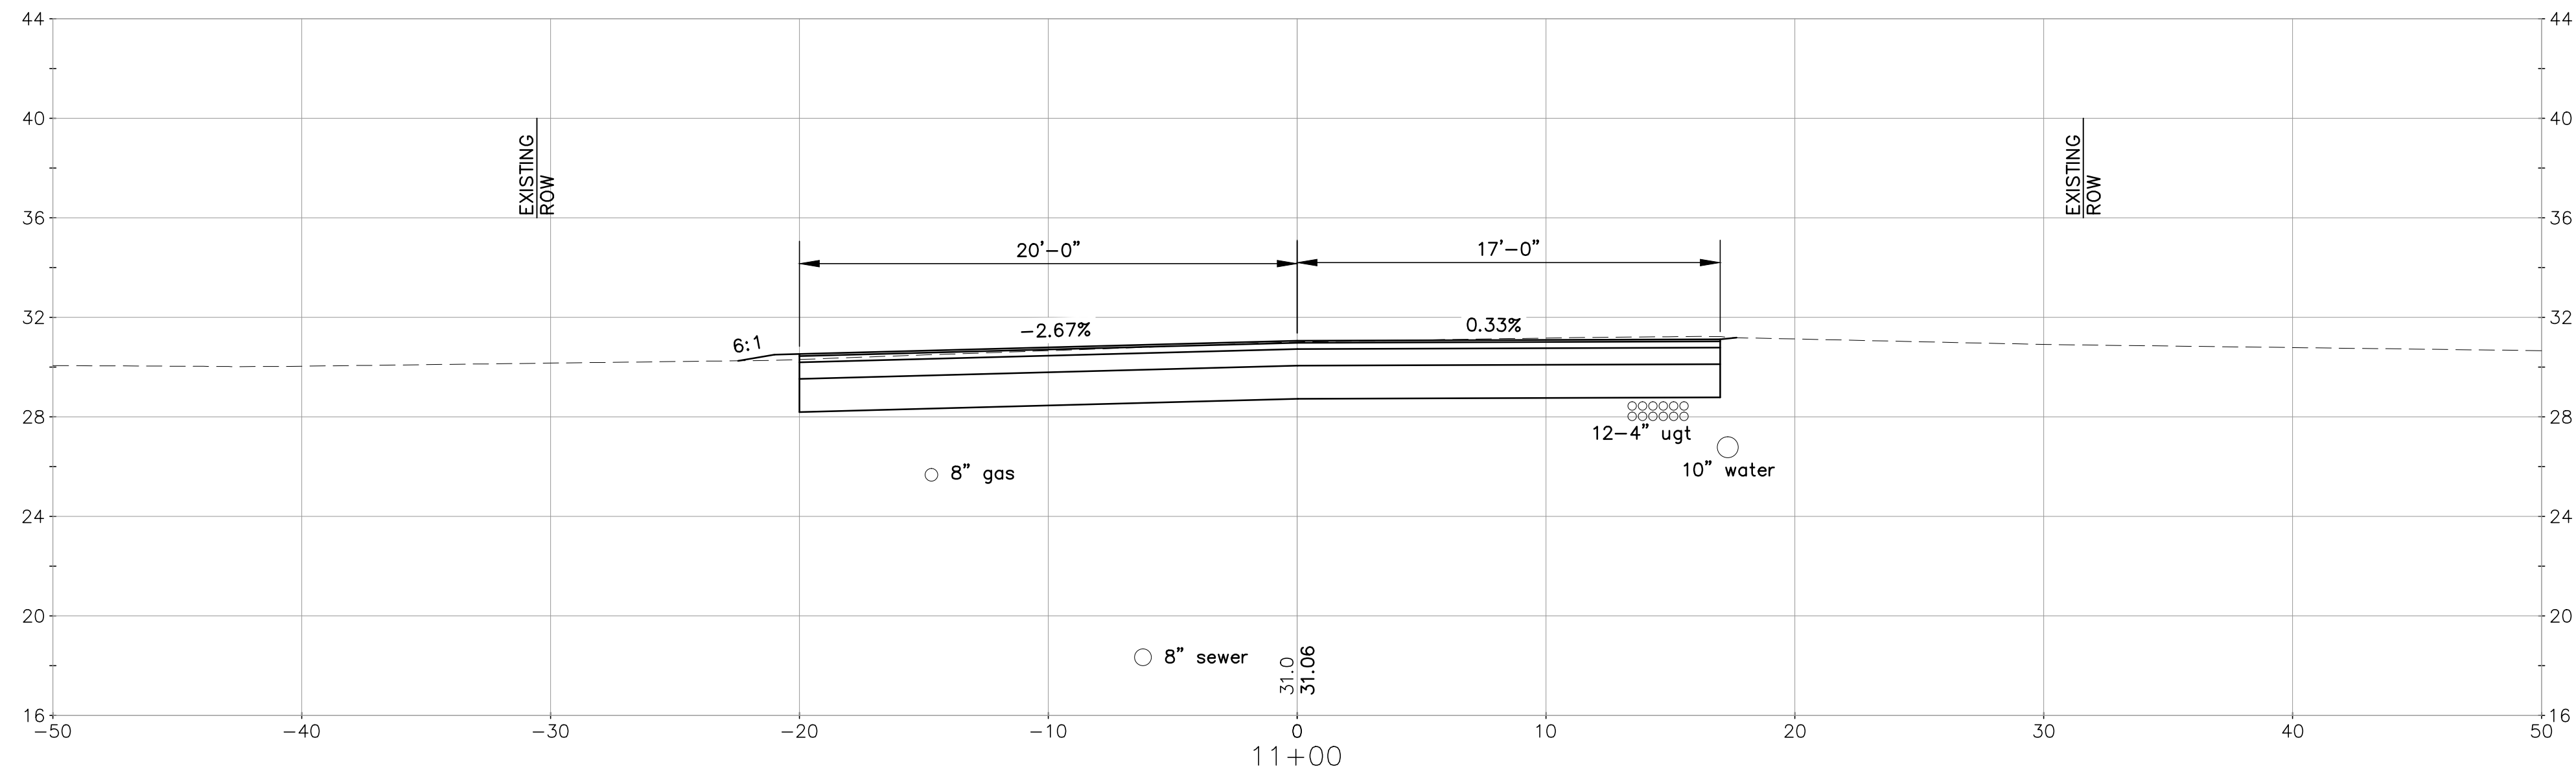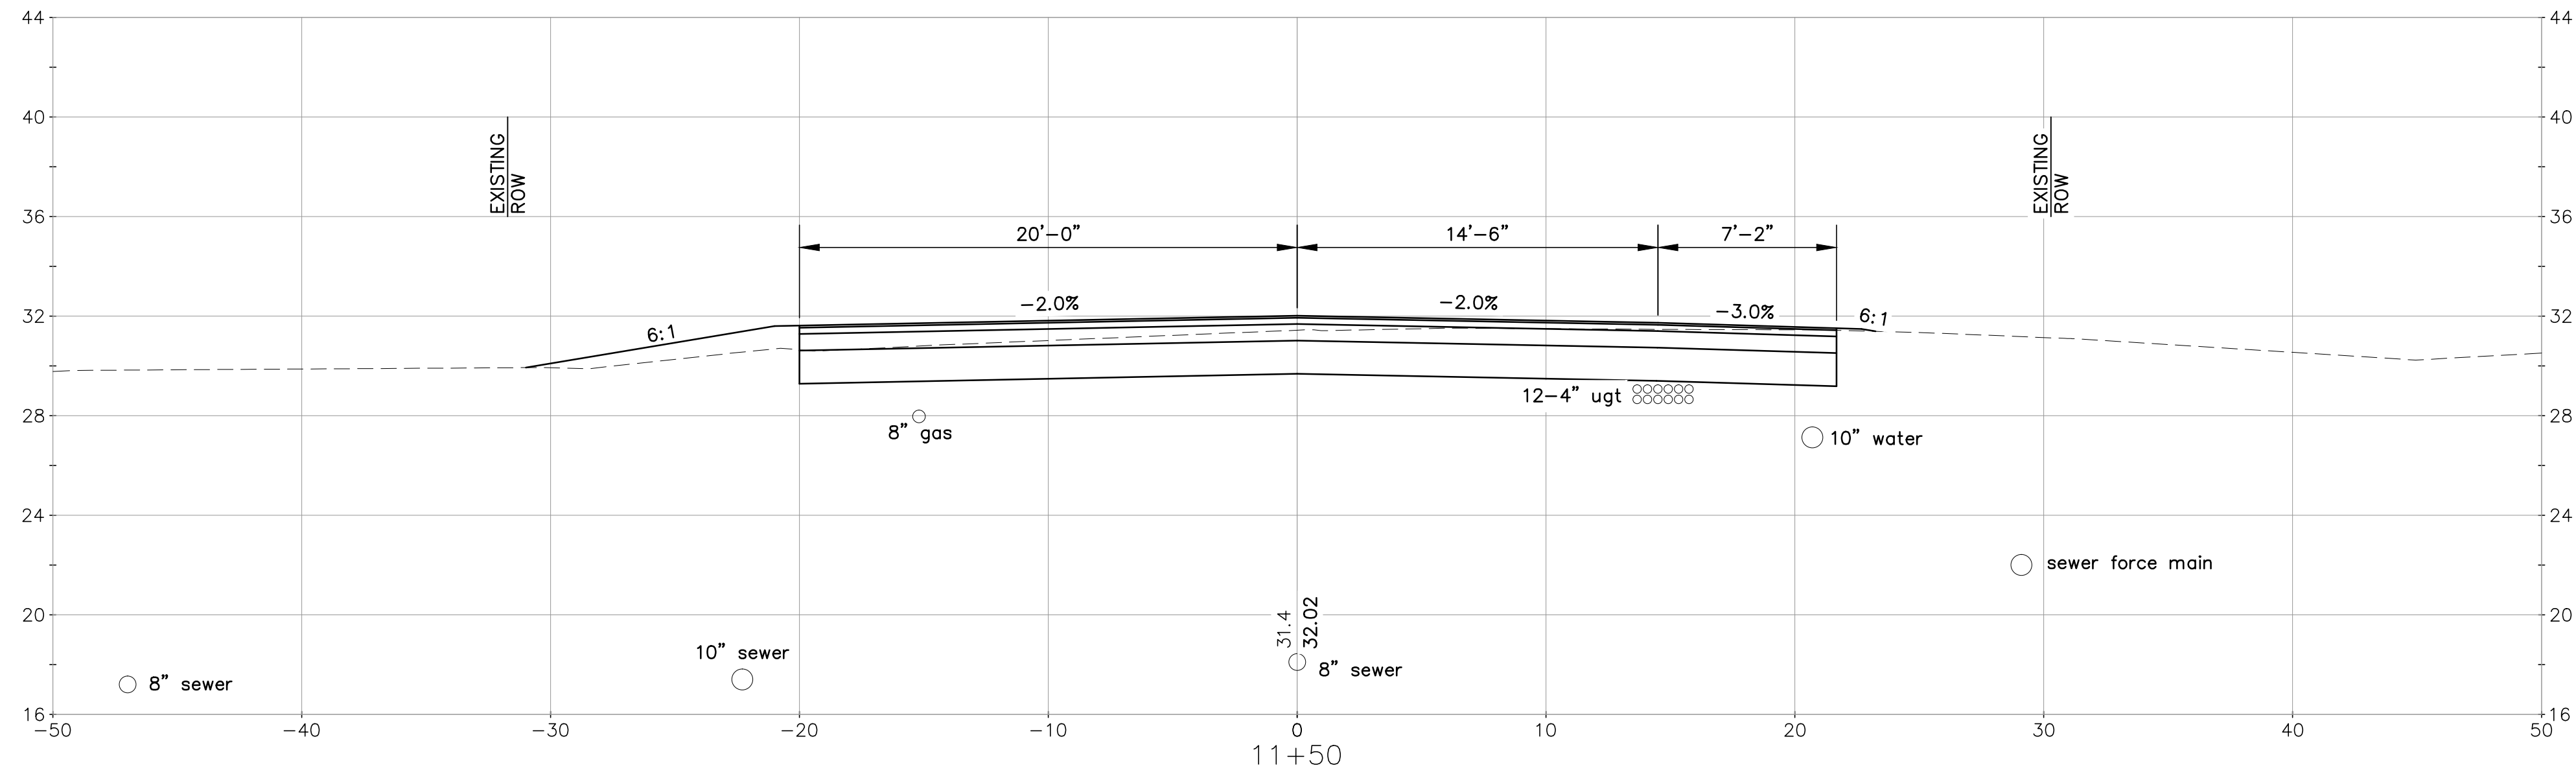

NOTE:
DEPTH BELOW ROAD SURFACE TO EXISTING UTILITIES IS APPROXIMATE AND OR ASSUMED. CONTRACTOR TO TAKE CARE TO FIELD LOCATE UTILITIES AND COORDINATE RELOCATION WITH RESPECTIVE UTILITY OWNERS.


designed by: LBK/OGK		date: June 2017	
drawn by: LBK/BGP		project no: -----	
approved by: JLG		file name: R-4.dwg	
scale:			
Town of Exeter Department of Public Works Court Street Little River Bridge Replacement Cross Sections (Sheet 1 of 4)			
drawing no. R-4		revision A ISSUED FOR CONSTRUCTION	
sheet: 26 of 34		no. 6/13/17 date by JLG	

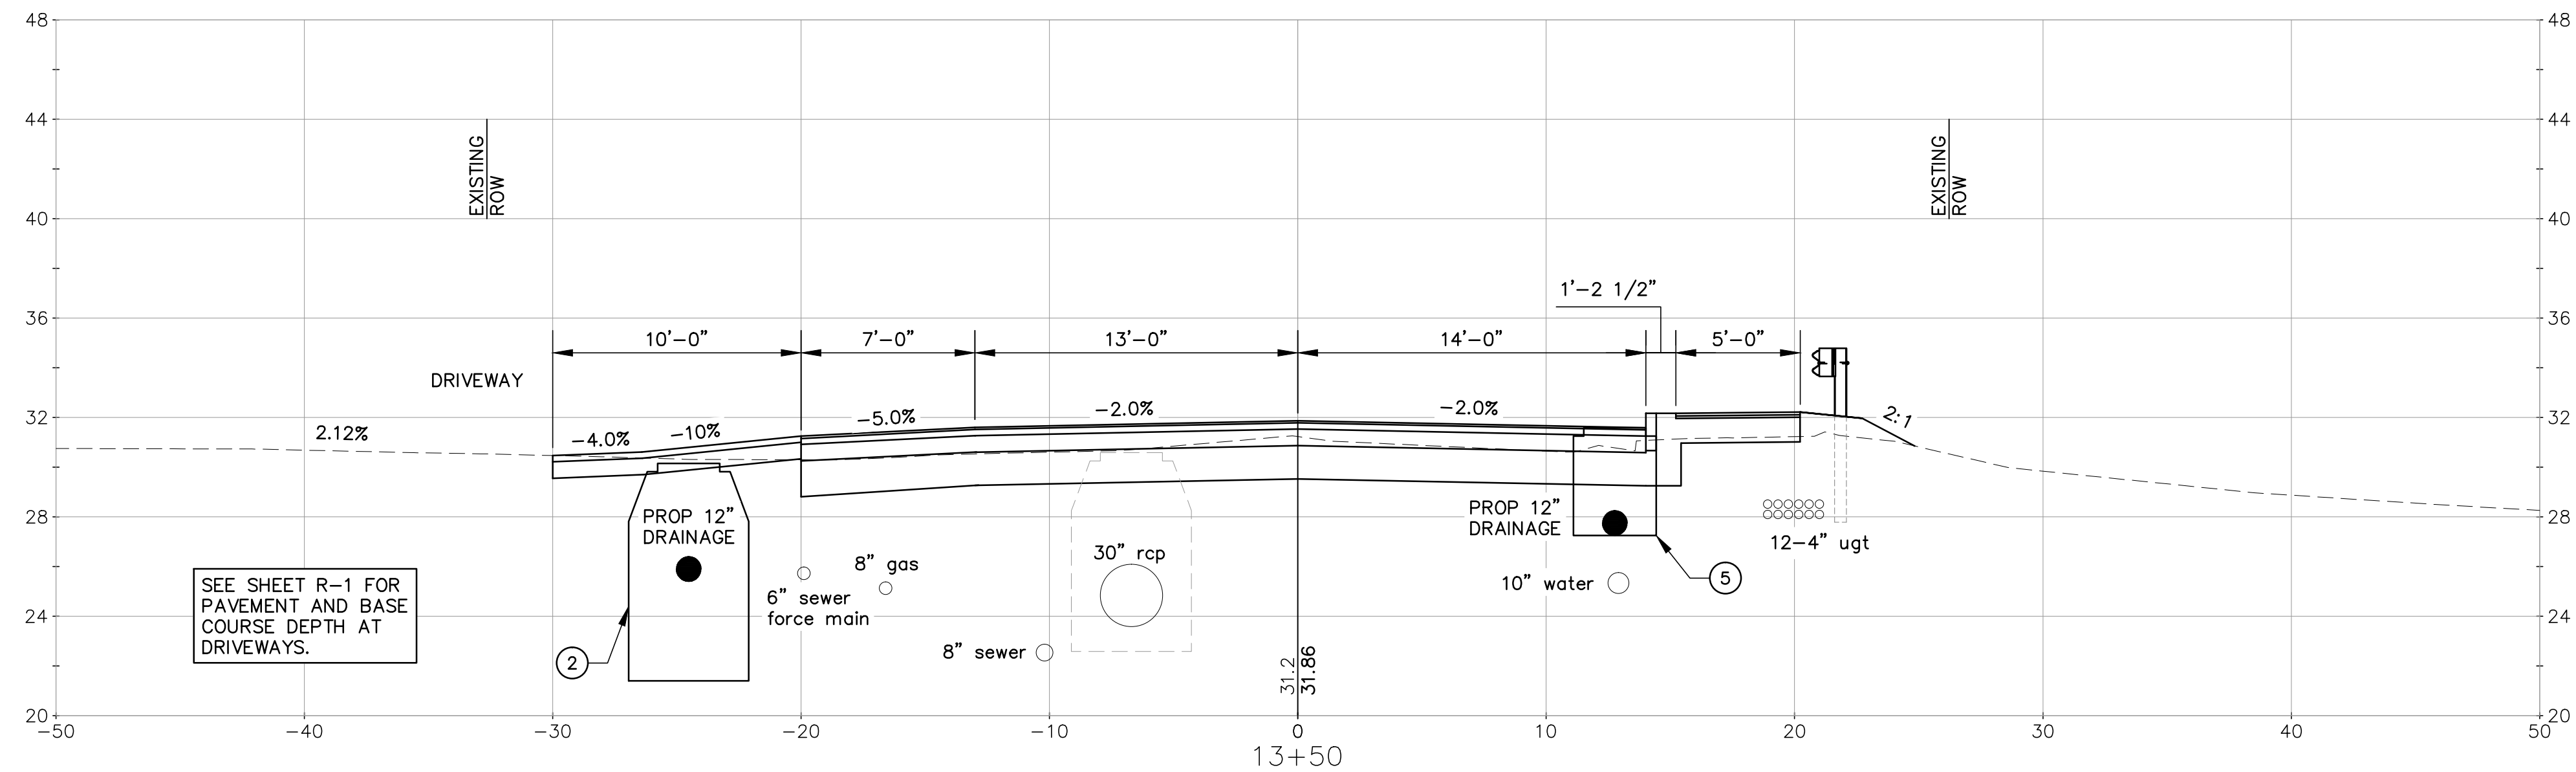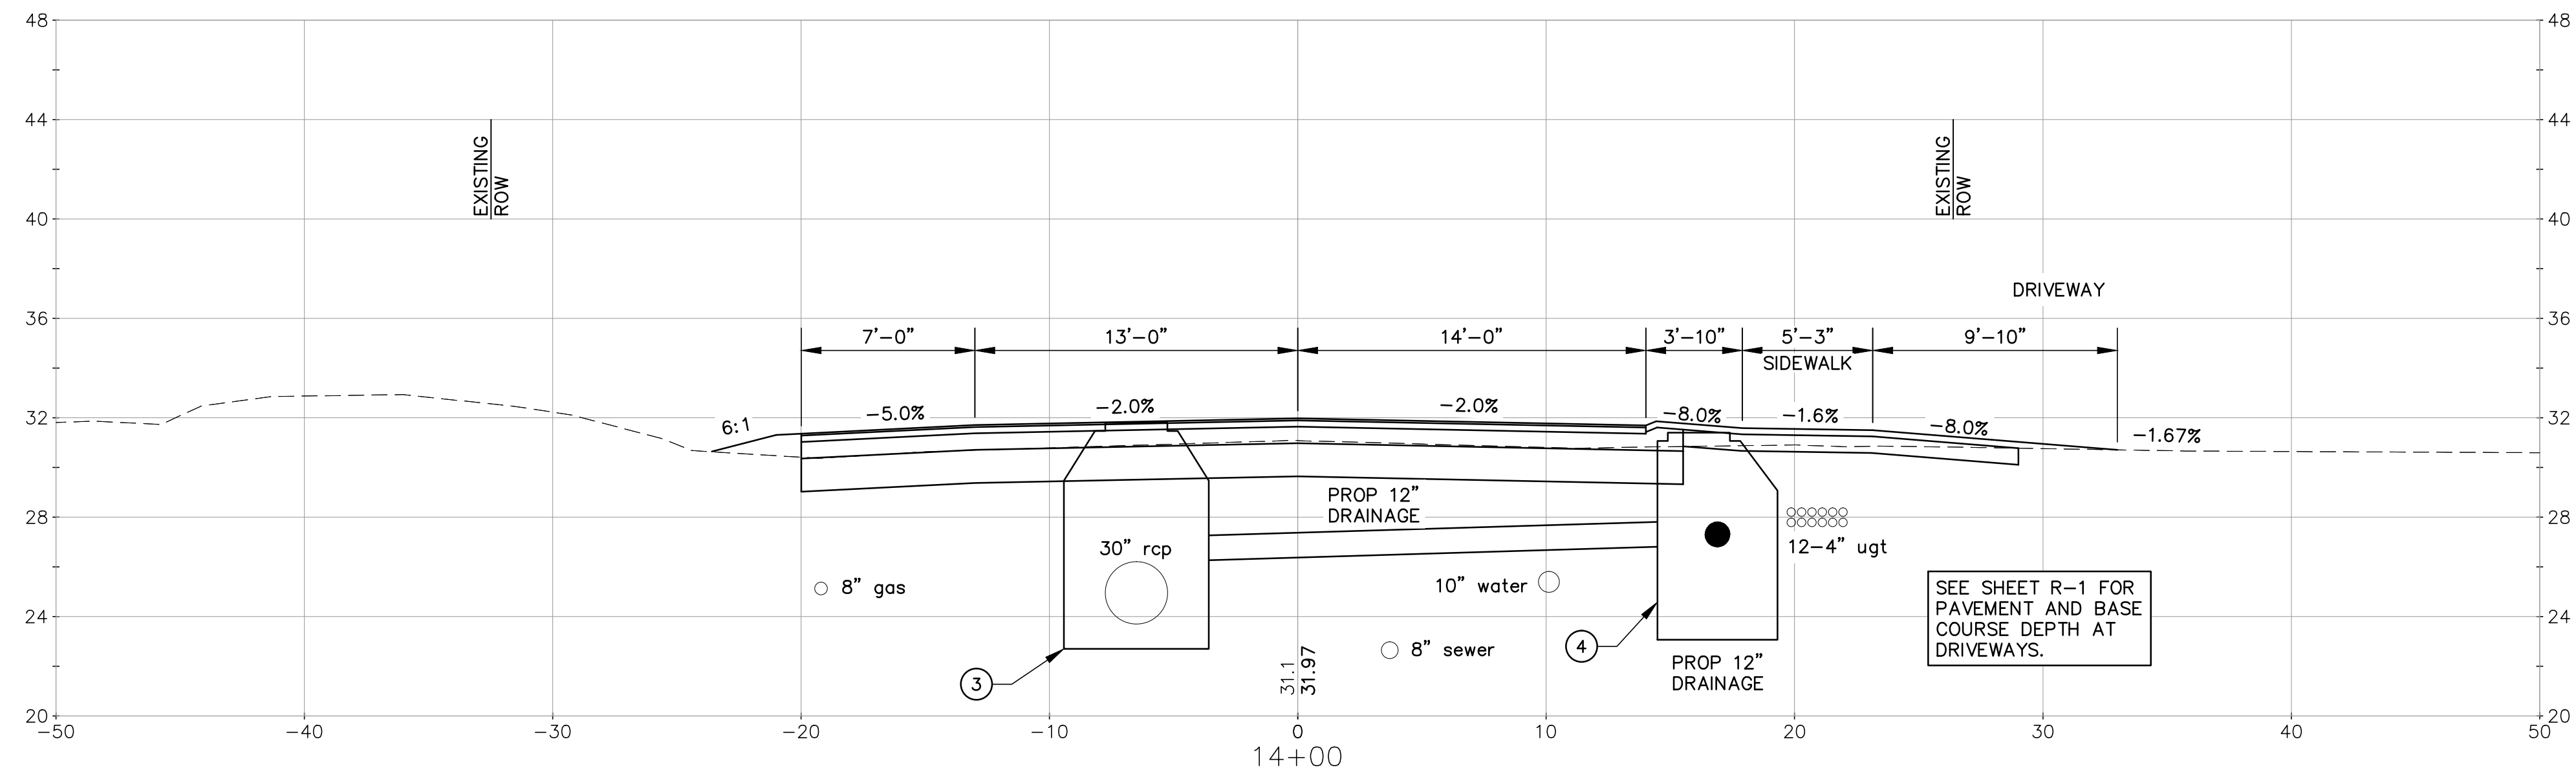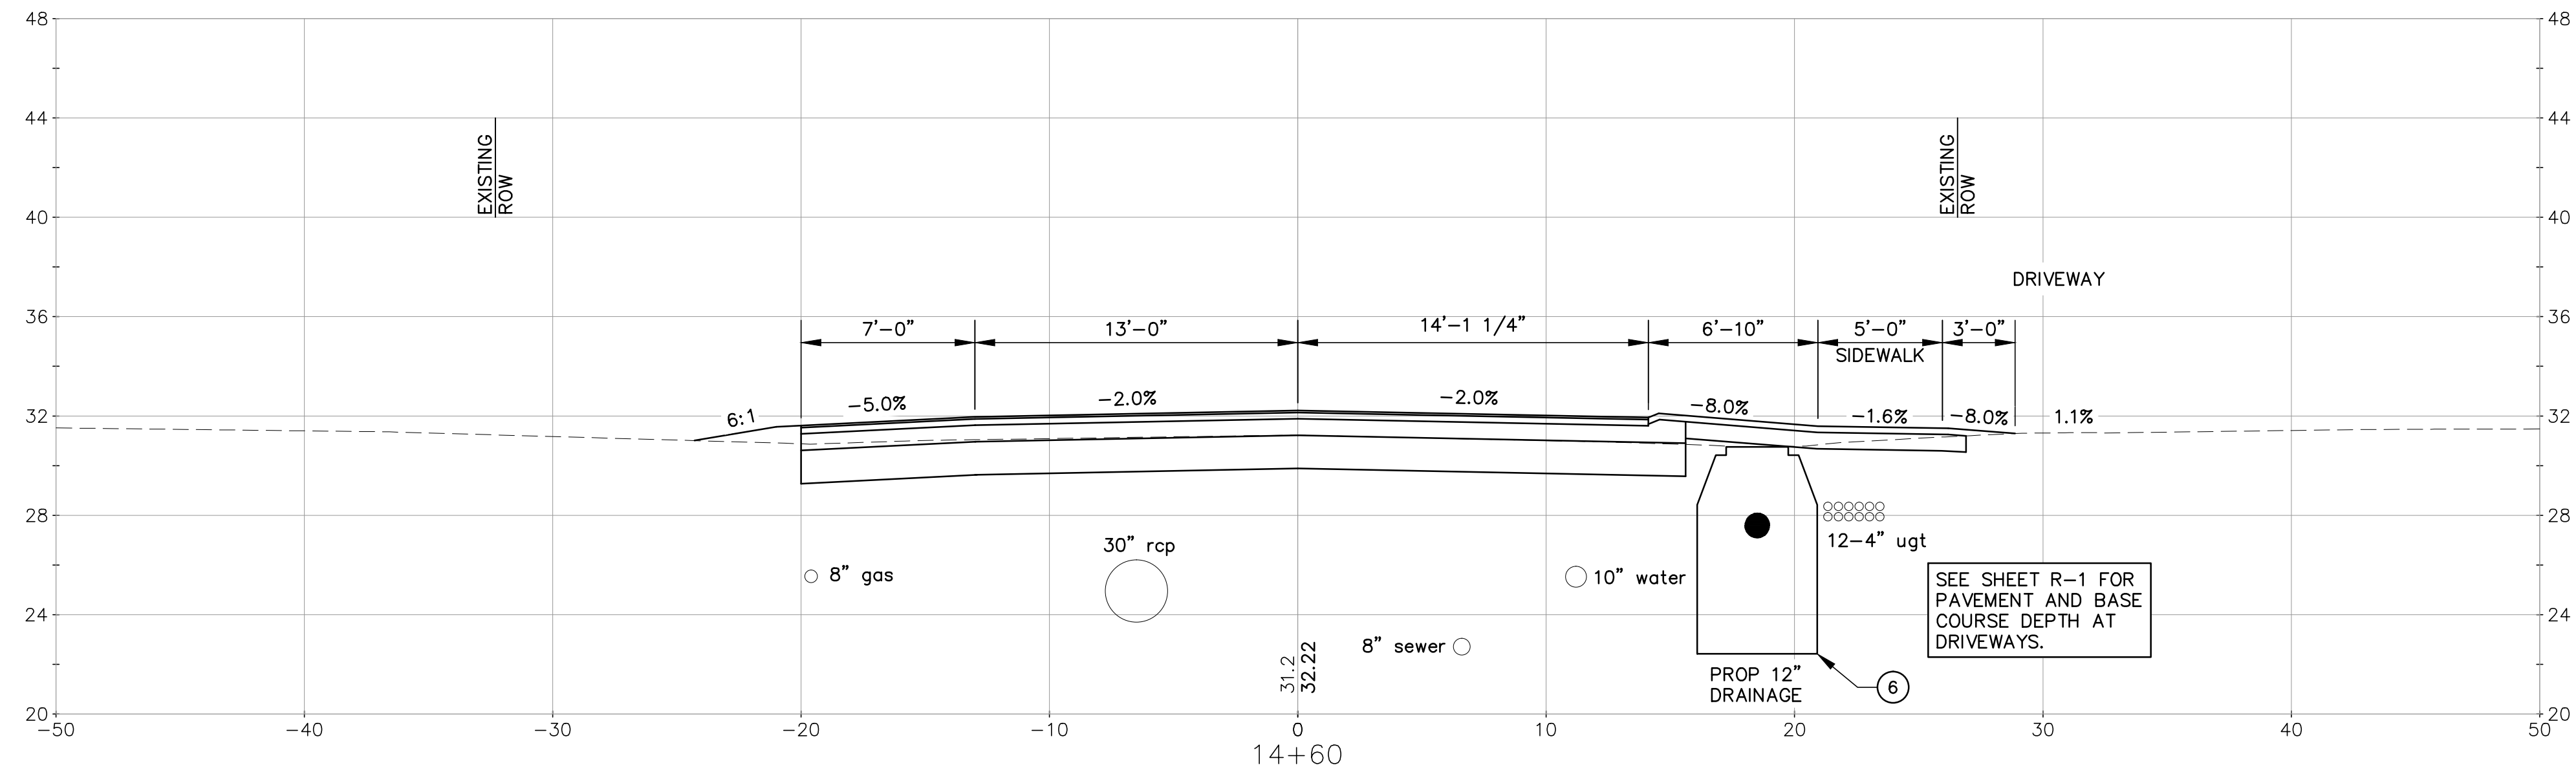

NOTE:
DEPTH BELOW ROAD SURFACE TO EXISTING UTILITIES IS APPROXIMATE AND OR ASSUMED. CONTRACTOR TO TAKE CARE TO FIELD LOCATE UTILITIES AND COORDINATE RELOCATION WITH RESPECTIVE UTILITY OWNERS.

no.	revision	date	by
A	ISSUED FOR CONSTRUCTION	6/13/17	JLG





CMA ENGINEERS
CIVIL/ENVIRONMENTAL/STRUCTURAL
Portland, ME 603/431-6196
Manchester, NH 603/627-0708
Portsmouth, NH 603/431-4223
c m a e n g i n e e r s . c o m

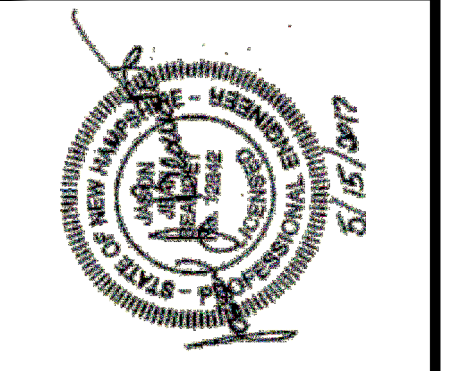

date:	June 2017	scale:	
designed by:	LBK/OGK	drawn by:	LBK/BGP
project no:		approved by:	JLG
file name:	R-6.dwg		

Town of Exeter
Department of Public Works
Court Street
Little River Bridge Replacement
Cross Sections
(Sheet 3 of 4)

drawing no.
R-6
sheet: 28 of 34

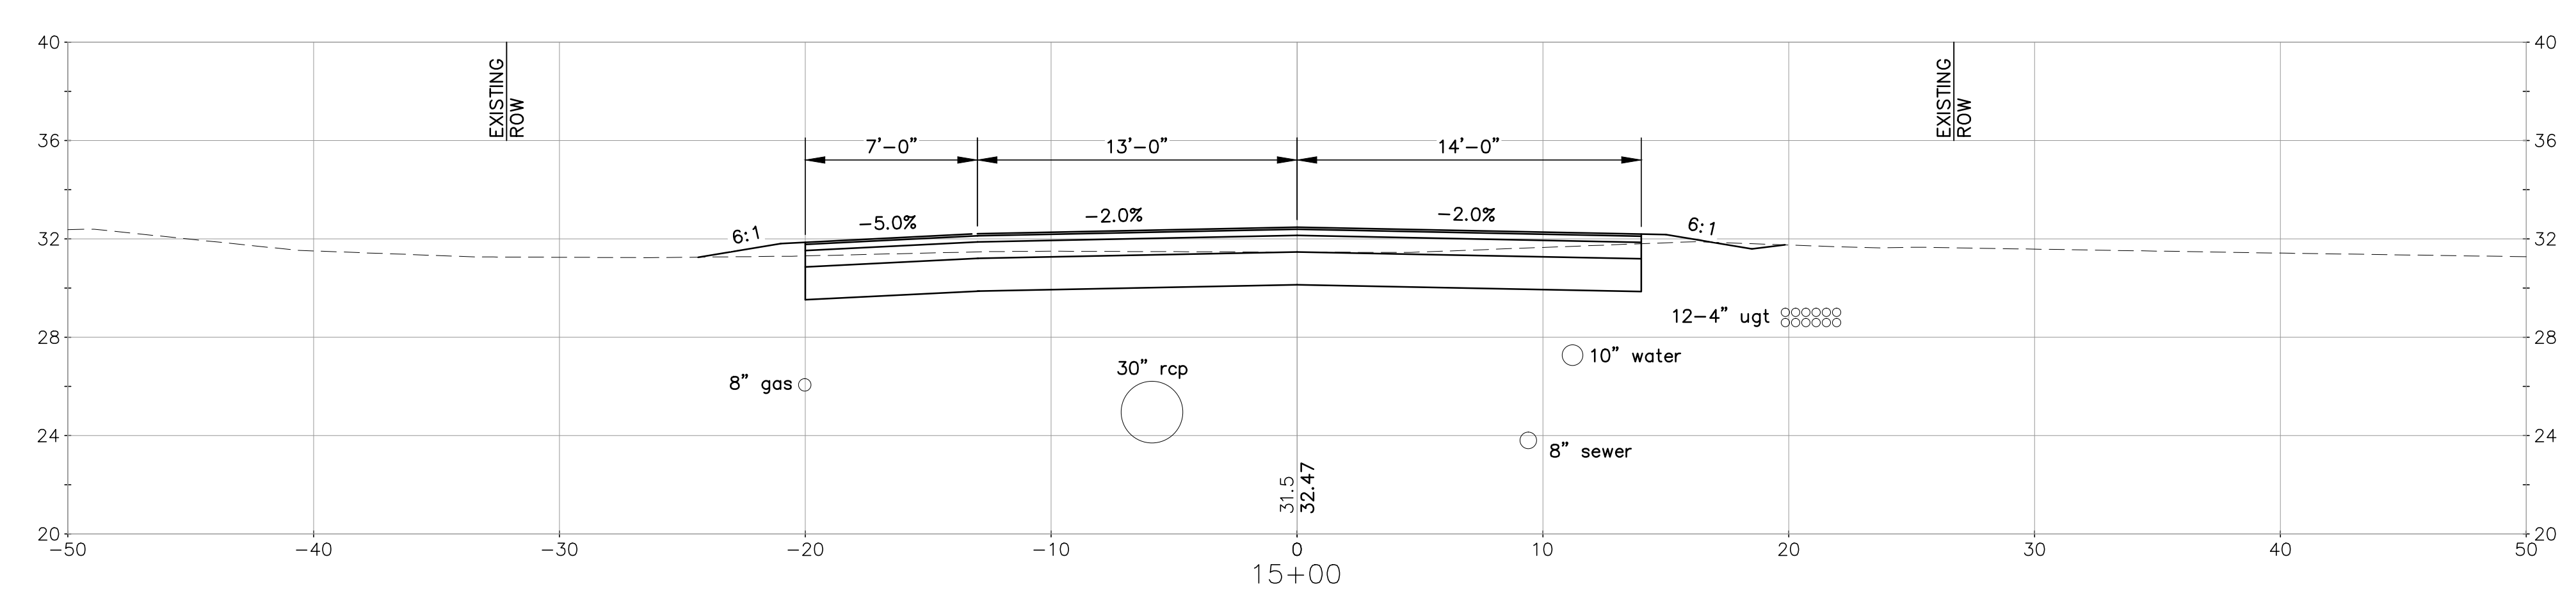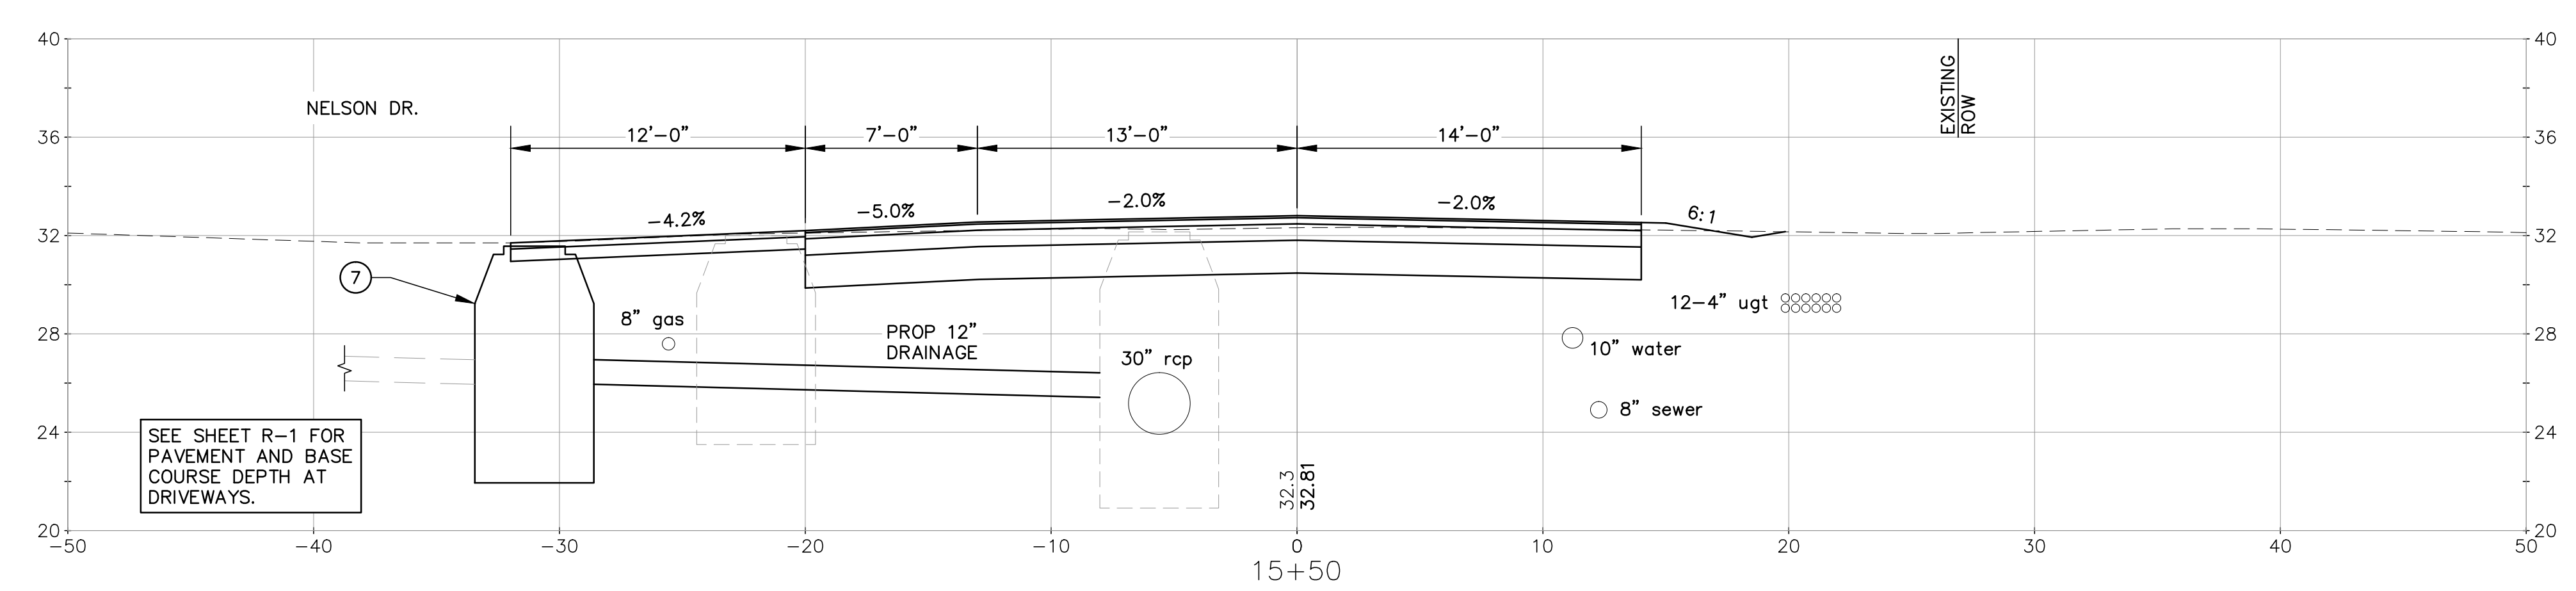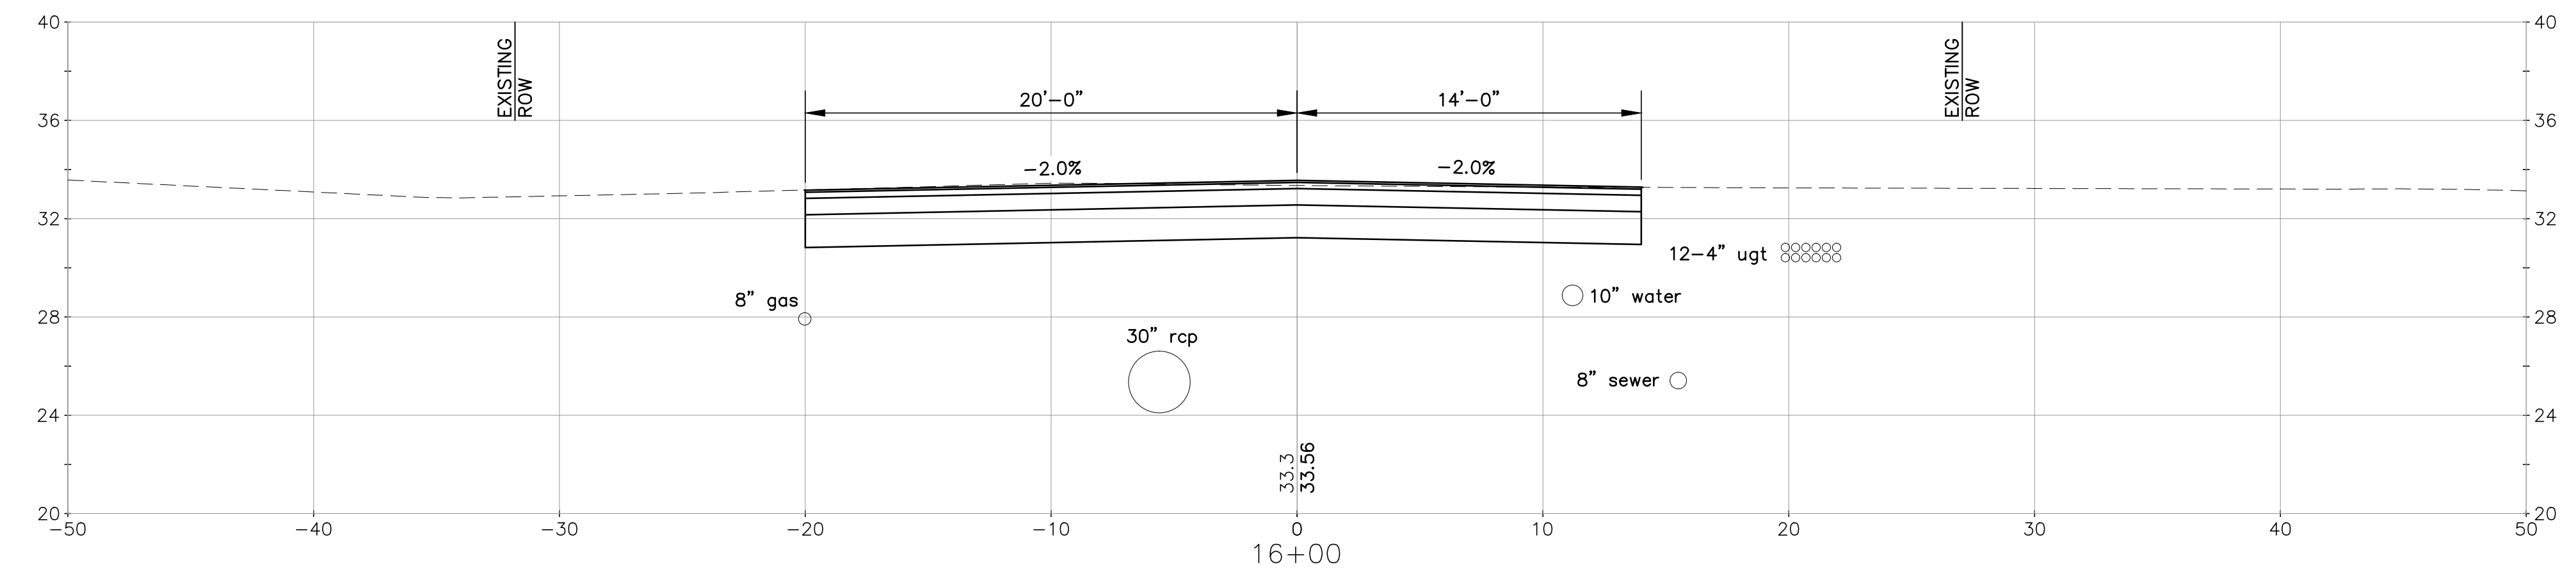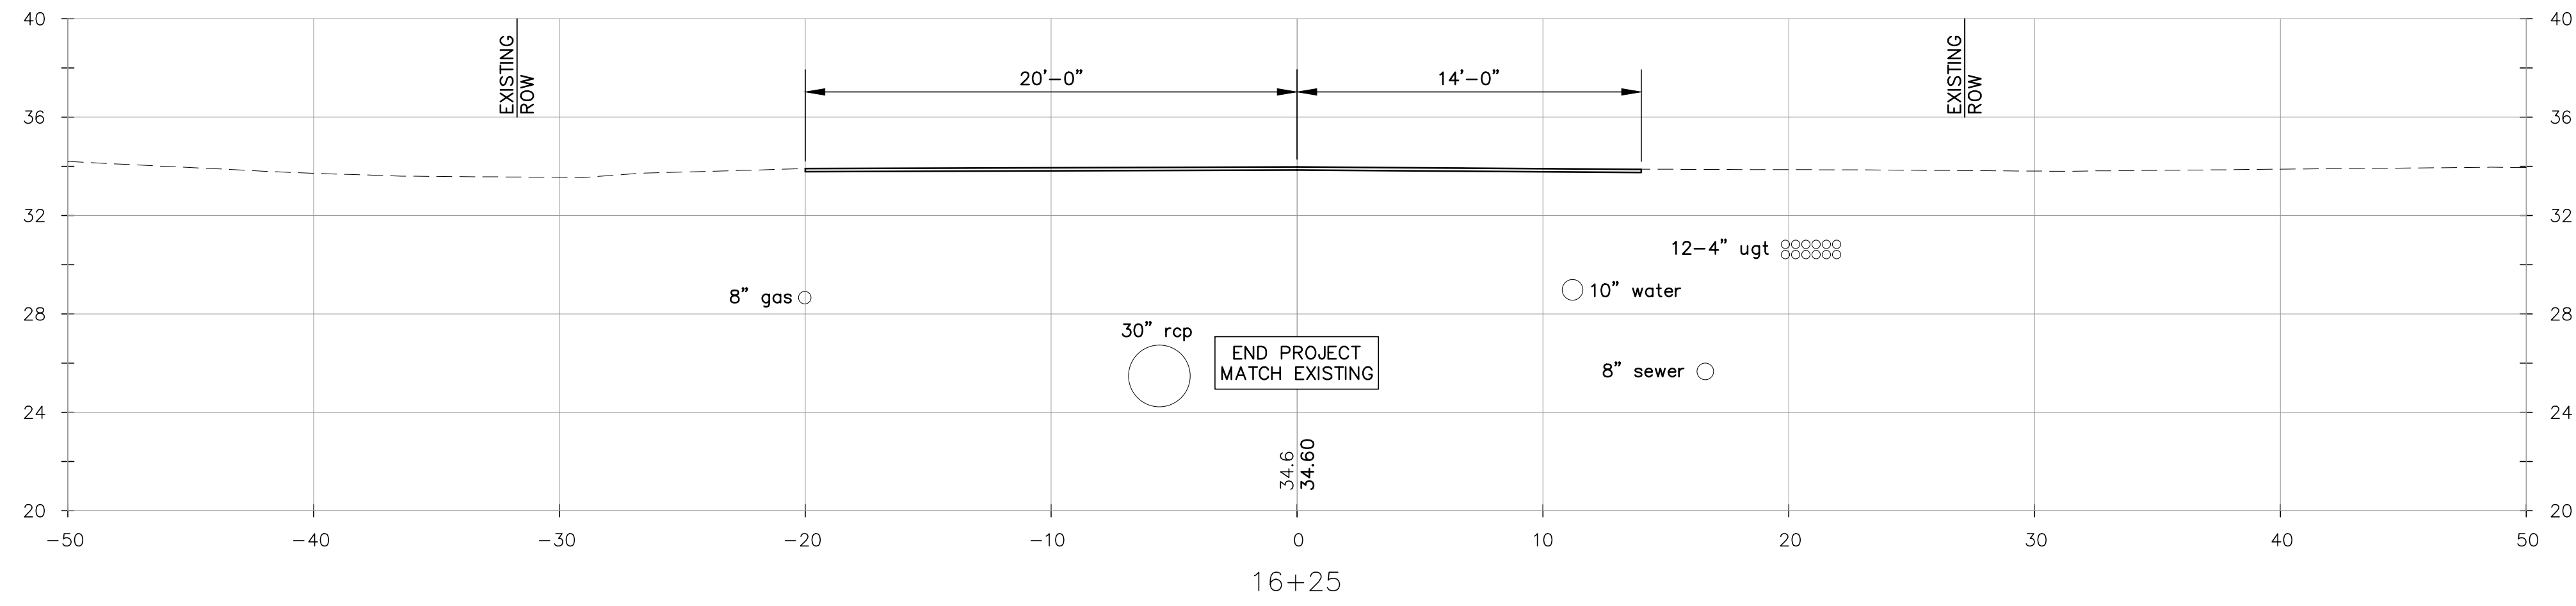

NOTE:
DEPTH BELOW ROAD SURFACE TO EXISTING UTILITIES IS APPROXIMATE AND OR ASSUMED. CONTRACTOR TO TAKE CARE TO FIELD LOCATE UTILITIES AND COORDINATE RELOCATION WITH RESPECTIVE UTILITY OWNERS.

		Portsmouth, NH • Manchester, NH • Portland, ME 603/431-6196 • 603/627-0708 • 207/541-4223 c m a e n g i n e e r s . c o m	
		designed by: LBK/OGK drawn by: LBK/BGP approved by: JLG scale:	
date: June 2017 project no:		file name: R-5.dwg	
Town of Exeter Department of Public Works		Court Street Little River Bridge Replacement Cross Sections (Sheet 4 of 4)	
drawing no. R-7		issued for construction	
sheet: 29 of 34		no. A revision date 6/13/17 by JLG	

Water Main Notes:








- WATER MAIN PIPE AND APPURTENANCES SHALL BE NEWLY MANUFACTURED MATERIALS FREE FROM DEFECTS AND BLEMISHES AND SHALL MEET THE LATEST STANDARDS OF THE AMERICAN WATER WORKS ASSOCIATION (AWWA), AS OUTLINED IN THE NEW HAMPSHIRE DEPARTMENT OF ENVIRONMENTAL SERVICES CERTIFIED RULES, ENV-WS 307, TABLE 307-1. APPLICABLE AWWA STANDARDS INCLUDE, BUT ARE NOT LIMITED TO, THE FOLLOWING:
 - C600 (1999 OR LATEST) INSTALLATION OF DUCTILE-IRON MAINS AND THEIR APPURTENANCES
 - C104/A21.4 (2003 OR LATEST) AMERICAN NATIONAL STANDARD FOR CEMENT-MORTAR LINING FOR DUCTILE-IRON PIPE AND FITTINGS FOR WATER
 - C110/A21.10 (2003 OR LATEST) AMERICAN NATIONAL STANDARD FOR DUCTILE-IRON AND GRAY-IRON FITTINGS, 3 IN. THROUGH 48 IN., FOR WATER AND OTHER LIQUIDS
 - C111/A21.11 (2000 OR LATEST) AMERICAN NATIONAL STANDARD FOR RUBBER-GASKET JOINTS FOR DUCTILE-IRON AND GRAY-IRON PRESSURE PIPE AND FITTINGS
 - C116/A21.16 (2003 OR LATEST) AMERICAN NATIONAL STANDARD FOR PROTECTIVE FUSION-BONDED EPOXY COATINGS INTERNAL & EXTERNAL IRON/GRAY-IRON FITTINGS
 - C150/A21.50 (2002 OR LATEST) AMERICAN NATIONAL STANDARD FOR THE THICKNESS DESIGN OF DUCTILE-IRON PIPE
 - C153/A21.53 (2000 OR LATEST) AMERICAN NATIONAL STANDARD FOR DUCTILE-IRON COMPACT FITTINGS, 2 IN. THROUGH 16 IN., FOR WATER AND OTHER LIQUIDS
 - C500 (2002 OR LATEST) GATE VALVES FOR WATER AND SEWERAGE SYSTEMS
 - C502 (1994 OR LATEST) DRY-BARREL FIRE HYDRANTS
 - C503 (1997 OR LATEST) WET-BARREL FIRE HYDRANTS
 - C509 (2001 OR LATEST) RESILIENT-SEATED GATE VALVES FOR WATER AND SEWERAGE SYSTEMS
 - C651-86 (1999 OR LATEST) DISINFECTING WATER MAINS
 - AWWA C600, SECTION 4, OR EQUIVALENT, FOR PRESSURE TESTING WATER MAINS.
- THE EXISTING WATER MAIN IS 10-INCH CEMENT LINED DUCTILE IRON (C.L.D.I.) PIPE. ADJACENT PIPE SECTIONS INCLUDE ASBESTOS CONCRETE (A.C.) PIPE. THE CONTRACTOR SHALL FOLLOW ALL PREVAILING HEALTH AND SAFETY STANDARDS FOR CUTTING, REMOVAL AND DISPOSAL OF PORTIONS OF THE AC PIPE THAT ARE TO BE PERMANENTLY REMOVED.
- NEW WATER MAIN SHALL BE BURIED A MINIMUM OF 6'-0" TO TOP OF PIPE AND LAID AT A CONSTANT GRADE. WHERE TOP OF WATER MAIN IS LESS THAN 6'-0" BELOW FINISHED GRADE, THE CONTRACTOR SHALL INSTALL RIGID INSULATION IN CONFORMANCE WITH WATER MAIN TRENCH DETAIL ON SHEET R-8 UNTIL THE WATER MAIN DEPTH IS AT, OR EXCEEDS, 6'-0".
- CONTRACTOR SHALL USE RESTRAINT SYSTEMS ON ALL VALVES AND FITTINGS UNLESS OTHERWISE NOTED ON THE PLANS.
- ALL GATE VALVES SHALL HAVE RESTRAINED MECHANICAL JOINTS AND SHALL OPEN LEFT.
- EXISTING CURB BOXES AND/OR OTHER CASTINGS DISTURBED OR RELOCATED BY CONSTRUCTION ACTIVITIES SHALL BE ADJUSTED TO MATCH FINAL GRADE, UNLESS OTHERWISE DIRECTED BY THE ENGINEER.
- WHERE WATER MAIN IS LESS THAN 6'-0" HORIZONTALLY FROM A STRUCTURE, THE CONTRACTOR SHALL INSTALL 2 INCHES OF RIGID INSULATION ALONG THE SIDE WALL OF THE WATER MAIN TRENCH A MINIMUM OF 10'-0" HORIZONTALLY BEYOND THE CENTERLINE OF THE STRUCTURE IN BOTH DIRECTIONS TO PROTECT THE WATER MAIN FROM FREEZING.

Insulated Pipe Notes:

- DUCTILE IRON PIPE SHALL BE TR FLEX, RESTRAINED JOINT PIPE WITH 2.16" OF CLOSED CELL POLYURETHANE INSULATION WRAPPED IN A SEAMLESS, HDPE JACKET. NO TAPE CASINGS WILL BE ALLOWED
- PIPING AND INSULATION SHALL BE INSTALLED PER MANUFACTURERS RECOMMENDATIONS.
- ALL FITTINGS SHALL HAVE RESTRAINED, MECHANICAL JOINTS AND INSULATED WITH FIELD APPLIED INSULATION COVERS.
- NO PIPING SHALL BE INSTALLED IN STANDING WATER. TRENCHES SHALL BE MAINTAINED DRY UNTIL FINAL FIELD CLOSURE IS COMPLETE.

- THE CONTRACTOR SHALL MAINTAIN WATER SERVICE TO RESIDENTS AT ALL TIMES. DISRUPTION OF WATER SERVICE TO RESIDENTS REQUIRES COORDINATION BY THE CONTRACTOR WITH THE TOWN'S PUBLIC WORKS DIRECTOR AND THE ENGINEER AT LEAST 72 HOURS PRIOR TO THE PLANNED INTERRUPTION OF SERVICE.
- THE CONTRACTOR IS RESPONSIBLE FOR TAKING DETAILED MEASUREMENTS OF THE EXACT LOCATION OF ALL BURIED WATER DISTRIBUTION PIPING AND APPURTENANCES INSTALLED BY THE CONTRACTOR INCLUDING PIPE, GATE VALVES, TRANSITION FITTINGS, BENDS, AND SHALL RECORD THE MEASUREMENTS ON AS-BUILT PLANS OR RECORD DRAWINGS. THE AS BUILT PLANS OR RECORD DRAWINGS OF THE WATER DISTRIBUTION PIPING AND APPURTENANCES SHALL INCLUDE THE FOLLOWING INFORMATION:
 - PRECISELY-MEASURED DIMENSIONS TO ALL TRANSITION FITTINGS;
 - PRECISELY-MEASURED DIMENSIONS TO ALL "ON-LINE" GATE VALVES;
 - PRECISELY-MEASURED DIMENSIONS TO ALL BENDS AND/OR PRINCIPAL CHANGES IN PIPE DIRECTION;

NOTE: "PRECISELY-MEASURED" MEANS OF SUFFICIENT ACCURACY TO LOCATE THE PIPING OR APPURTENANCE TO WITHIN 1 FOOT ACCURACY, RECORDED TO THE NEAREST 0.5 FOOT.
- THE CONTRACTOR SHALL SUPPLY THE TOWN OF EXETER WITH ONE ORIGINAL AND ONE COPY OF THE AS-BUILT PLAN OR RECORD DRAWING OF THE NEW WATER DISTRIBUTION PIPING INSTALLATION.
- CONTRACTOR SHALL FLUSH AND CHLORINATE THE NEW WATER DISTRIBUTION PIPING SYSTEM BEFORE ACTIVATING INTO SERVICE. THE NEW WATER DISTRIBUTION PIPES AND APPURTENANCES SHALL BE FLUSHED TO REMOVE ANY DIRT OR OTHER CONTAMINANTS, AND TESTED PER THE TOWN OF EXETER REQUIREMENTS AS SPECIFIED IN SPECIAL PROVISION 611.3.12 - PRESSURE AND LEAKAGE TESTING OF THE TECHNICAL SPECIFICATIONS.
- THE CONTRACTOR SHALL PERFORM A LEAKAGE TEST OF THE NEW PIPING SYSTEM BEFORE SYSTEM USE. THE DISTRIBUTION SYSTEM SHALL BE CHECKED FOR LEAKAGE BY CONDUCTING A SUSTAINED PRESSURE TEST PER THE TOWN OF EXETER REQUIREMENTS AS SPECIFIED IN SPECIAL PROVISION 611.3.13 - DISINFECTION OF THE TECHNICAL SPECIFICATIONS.

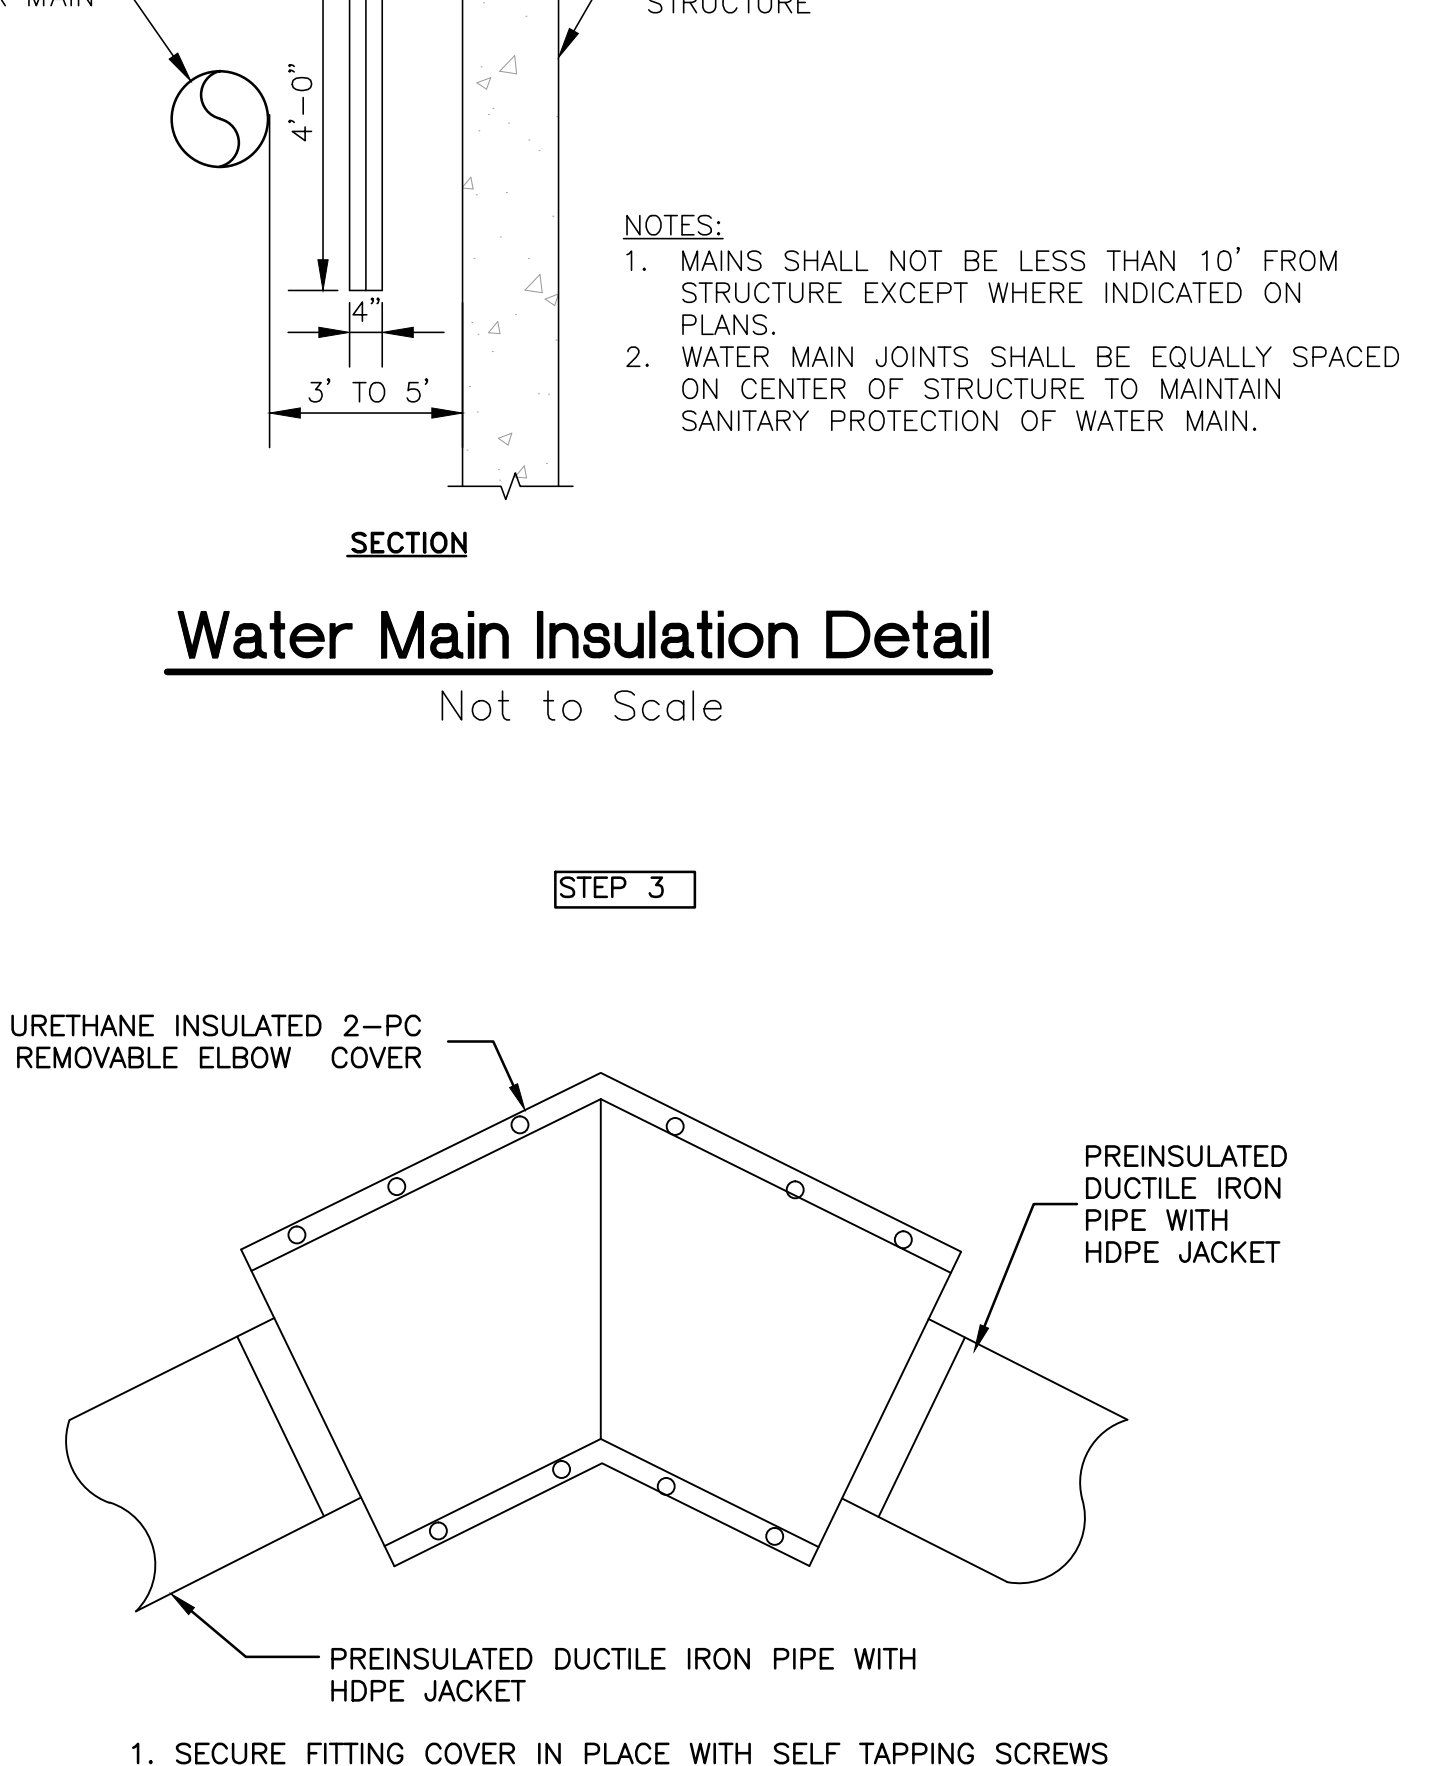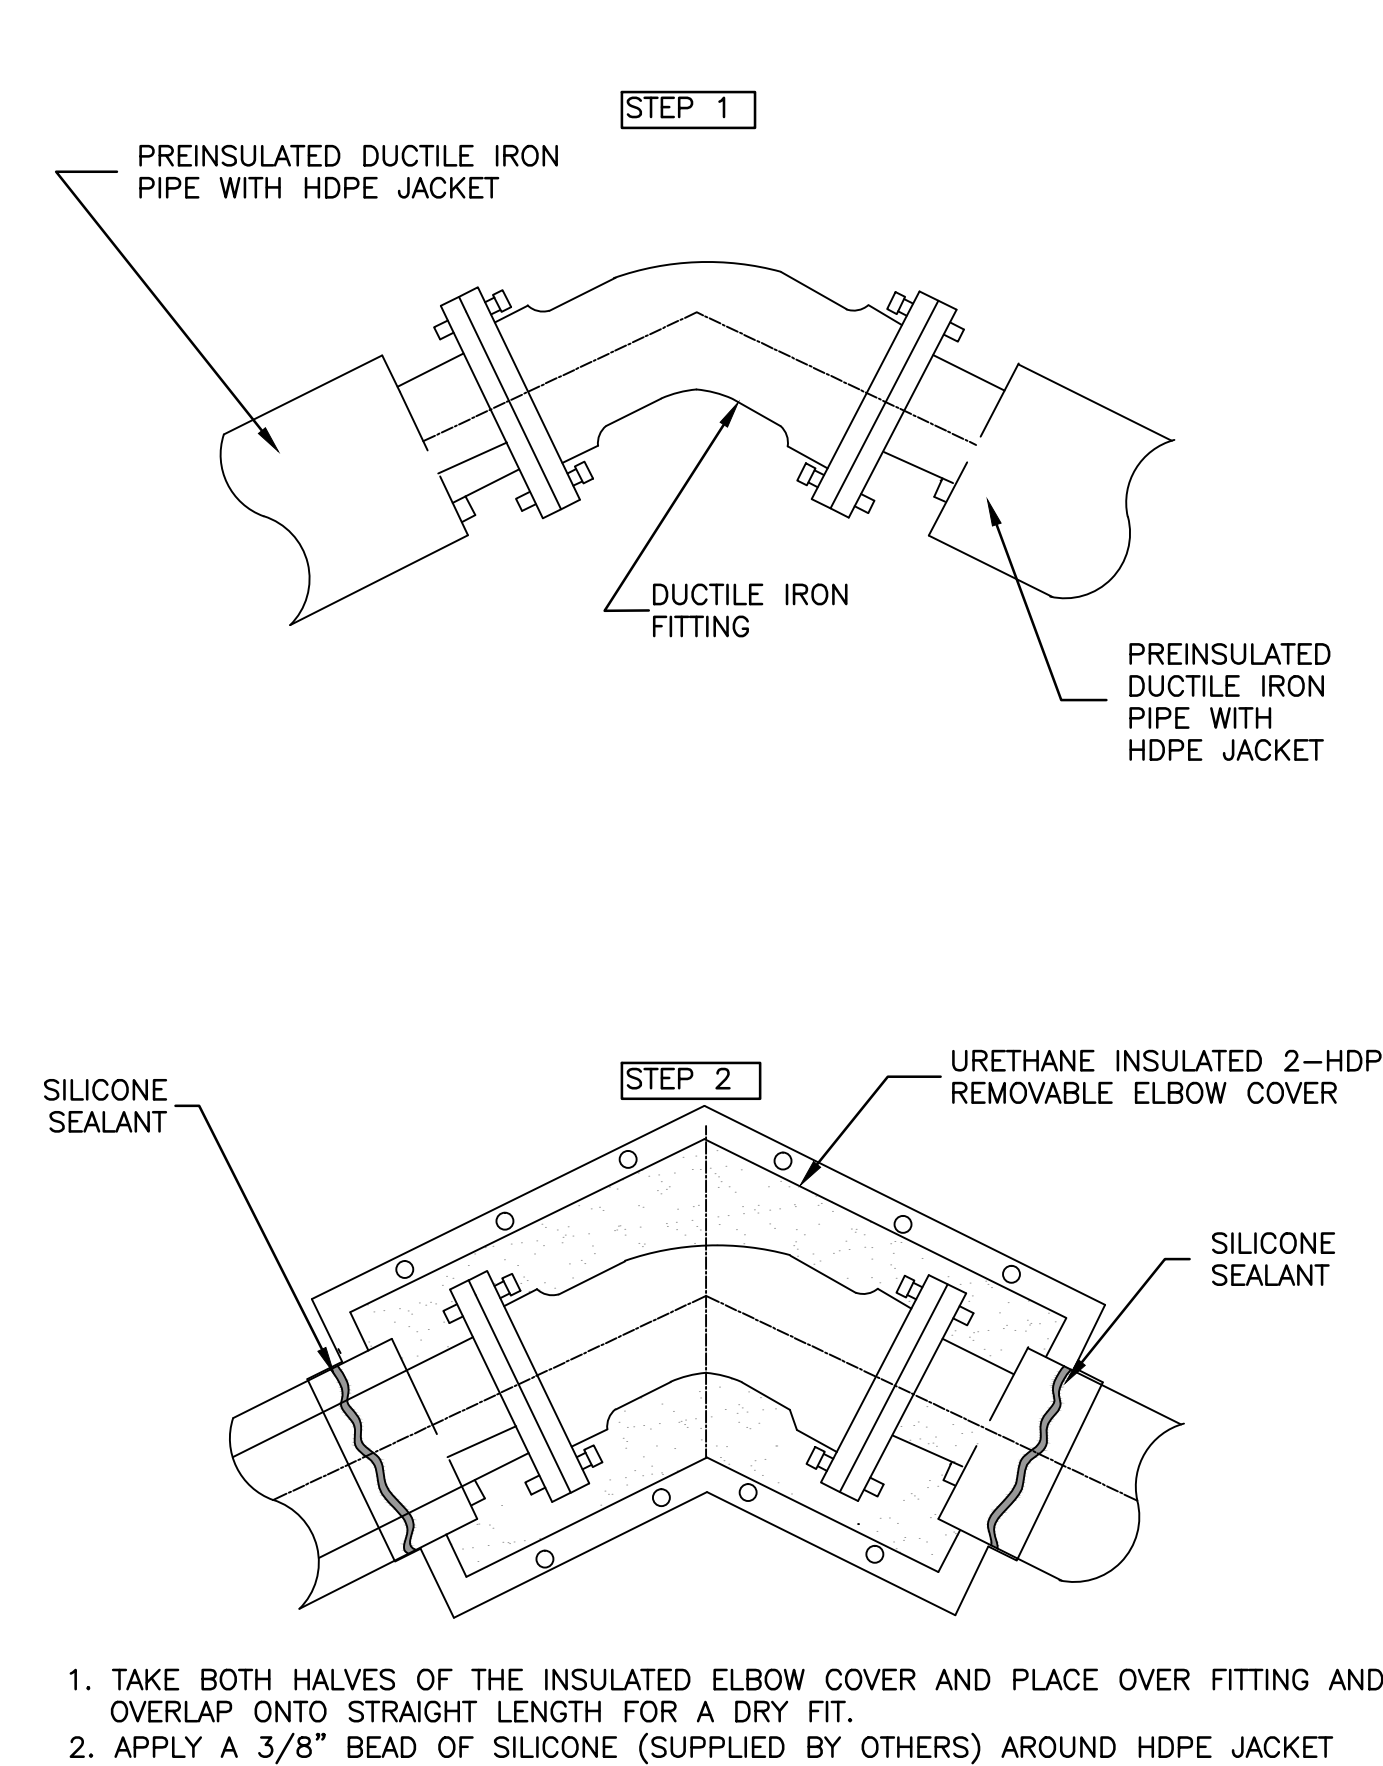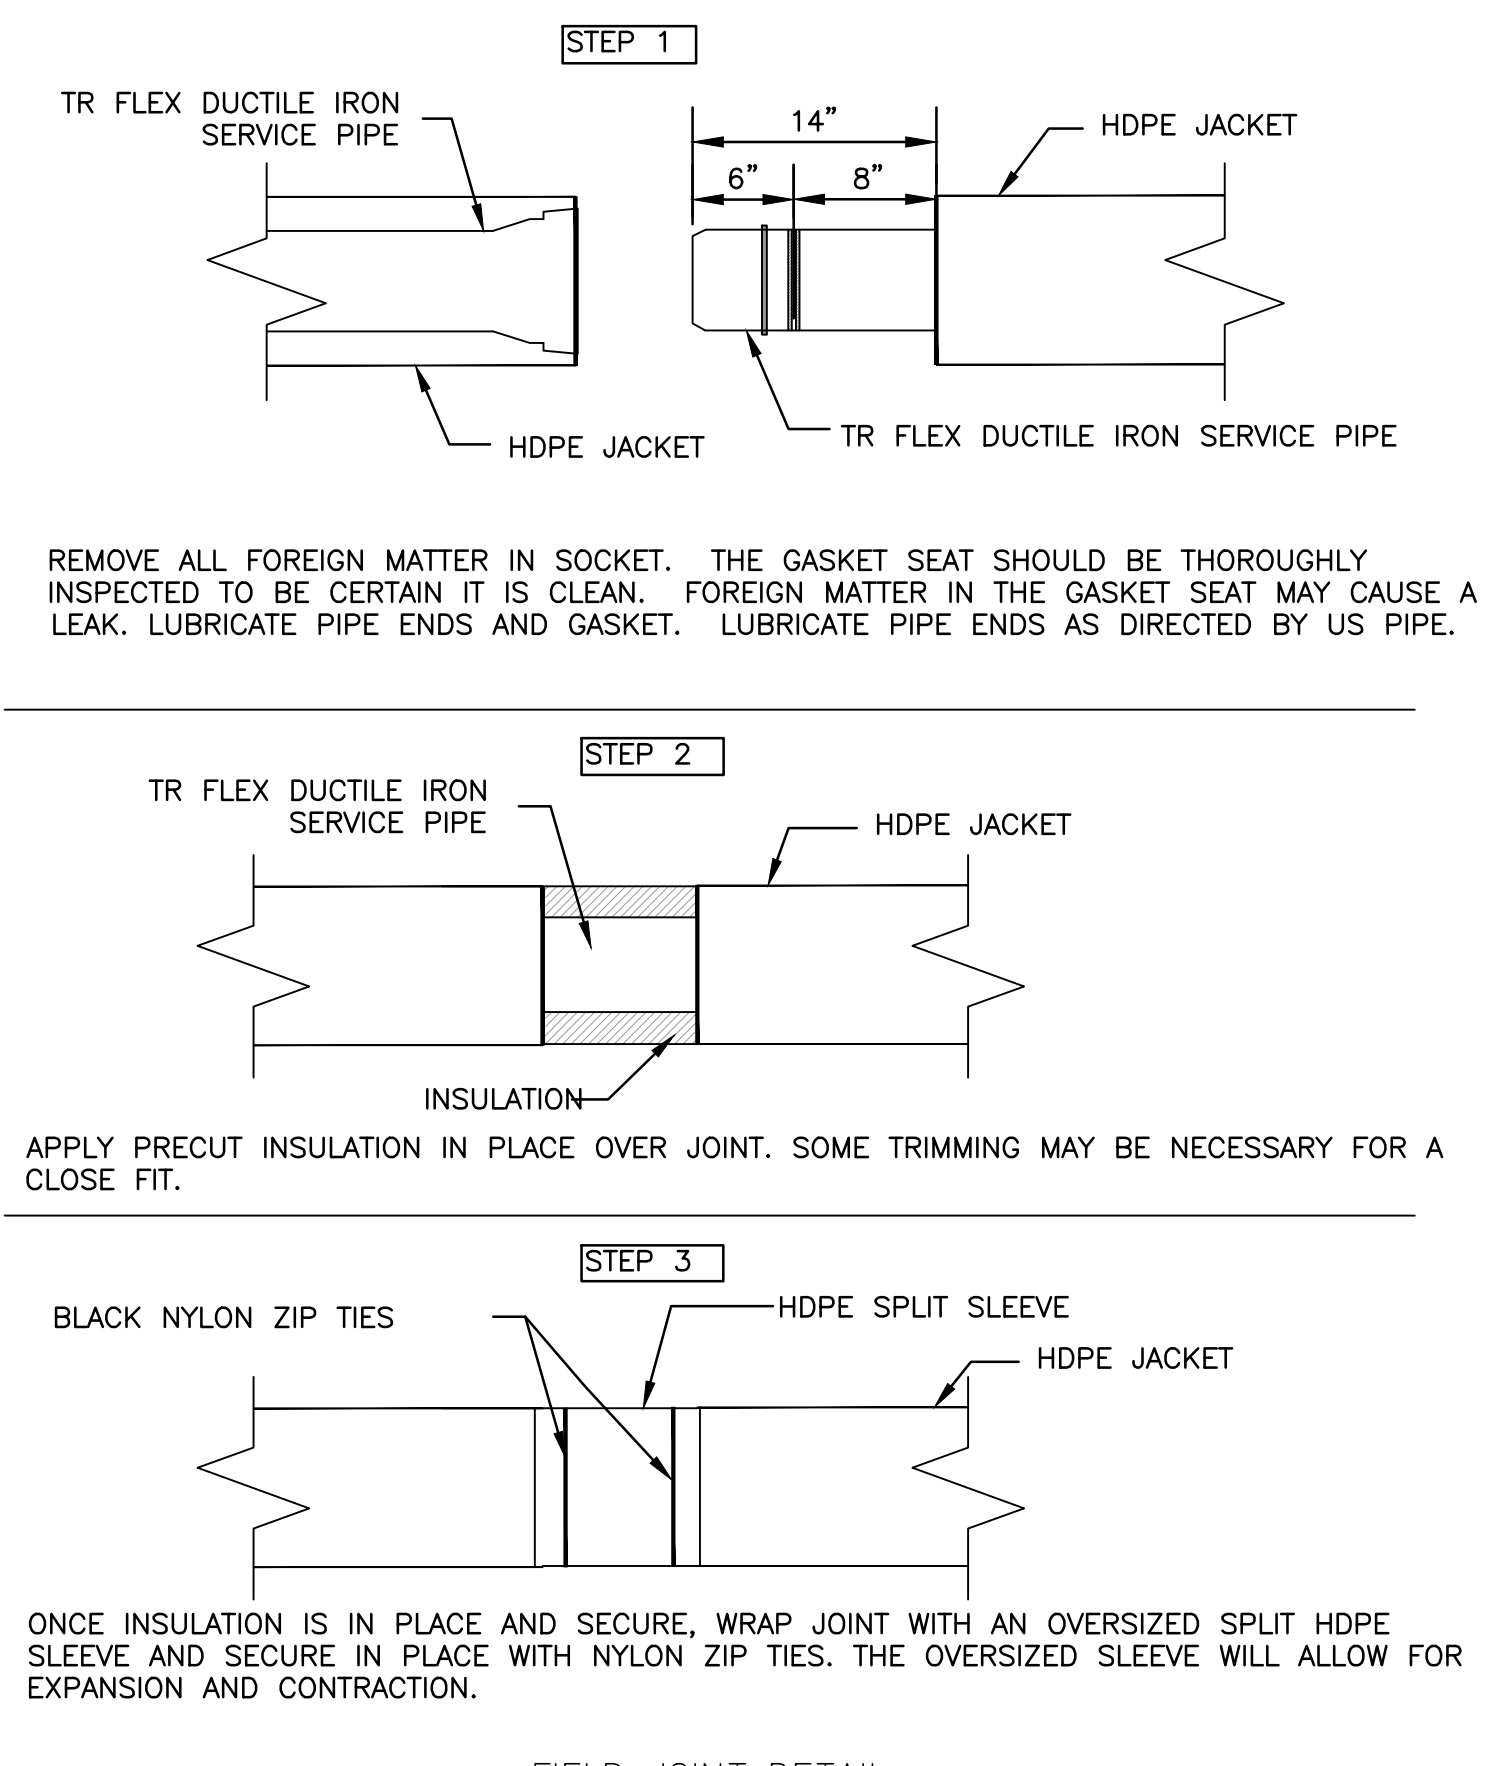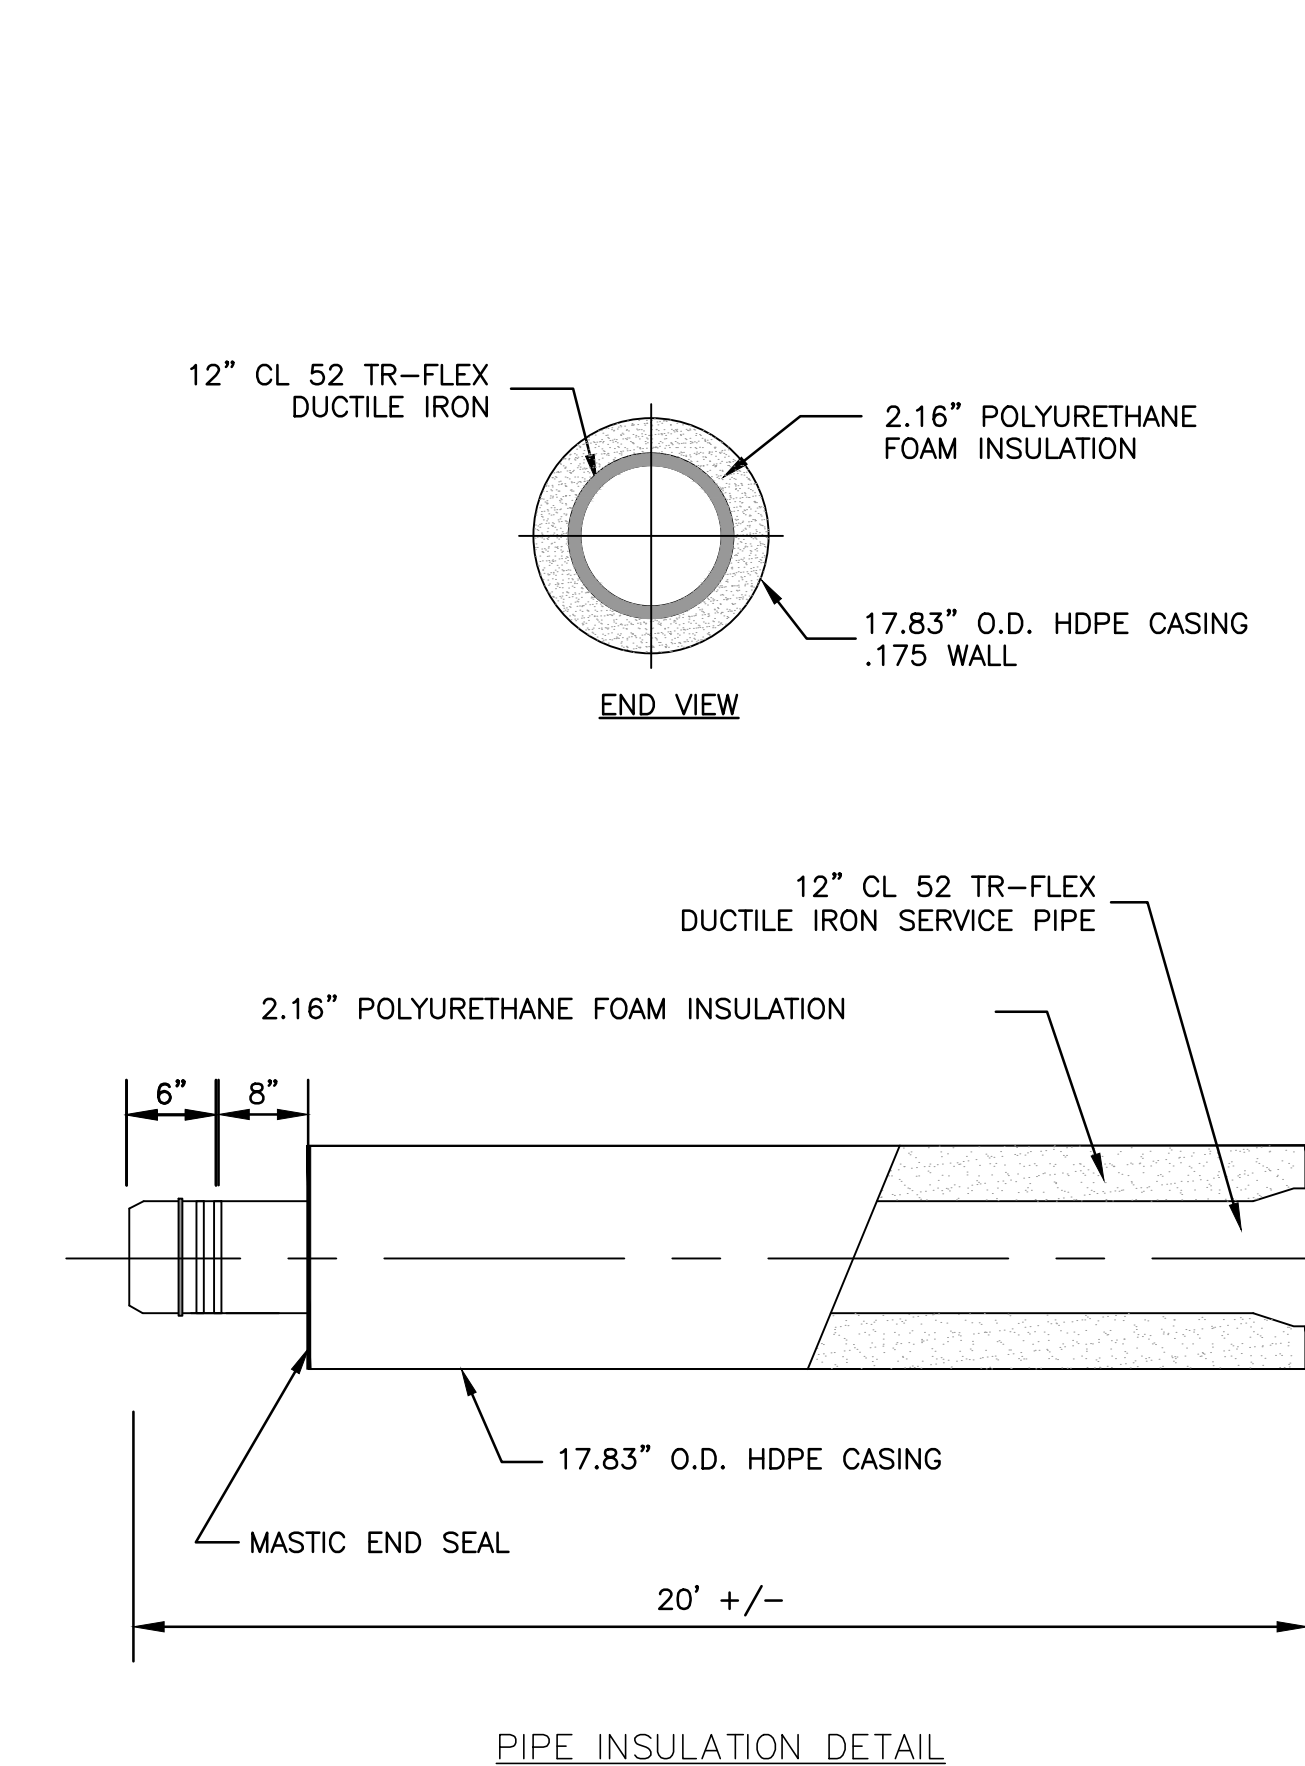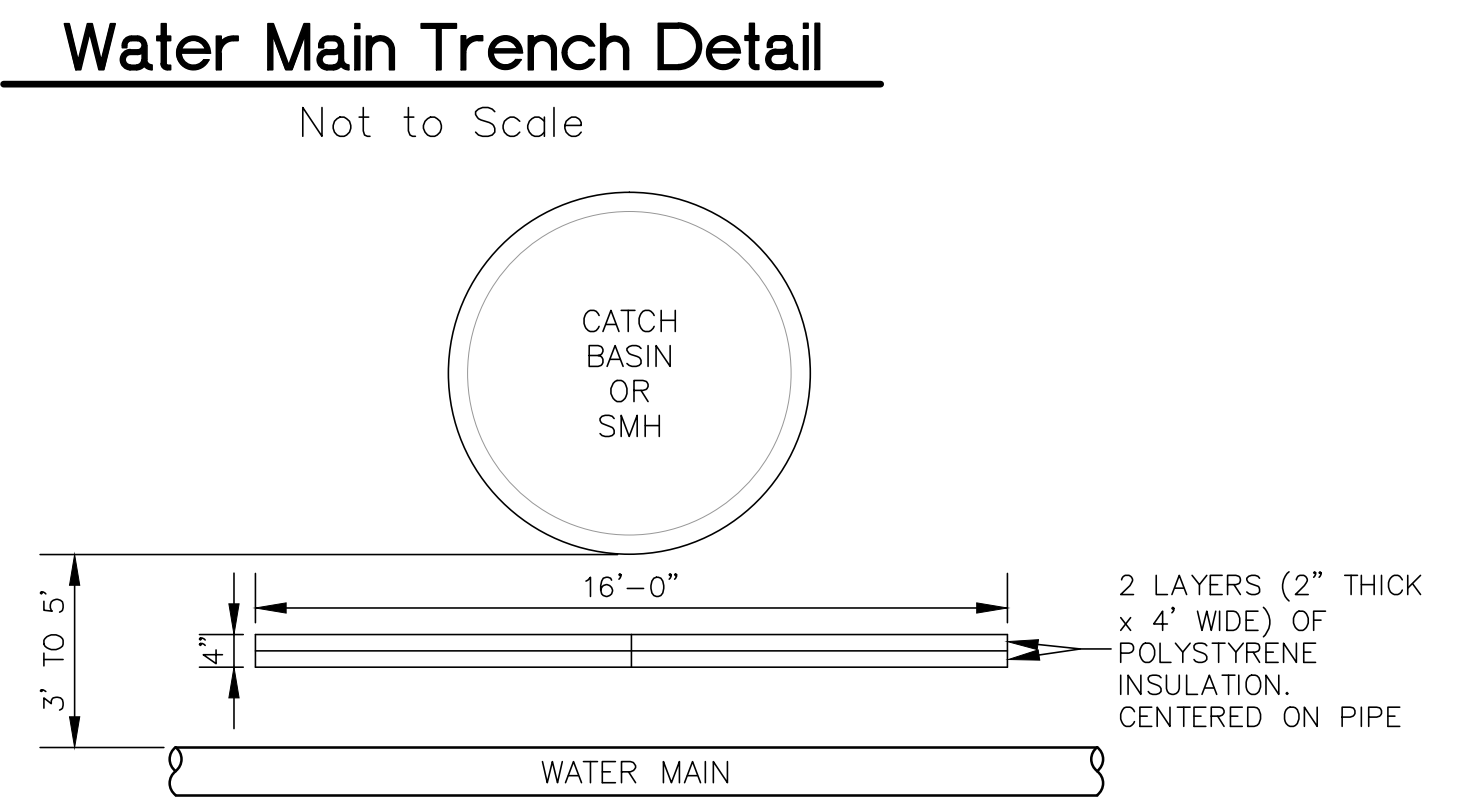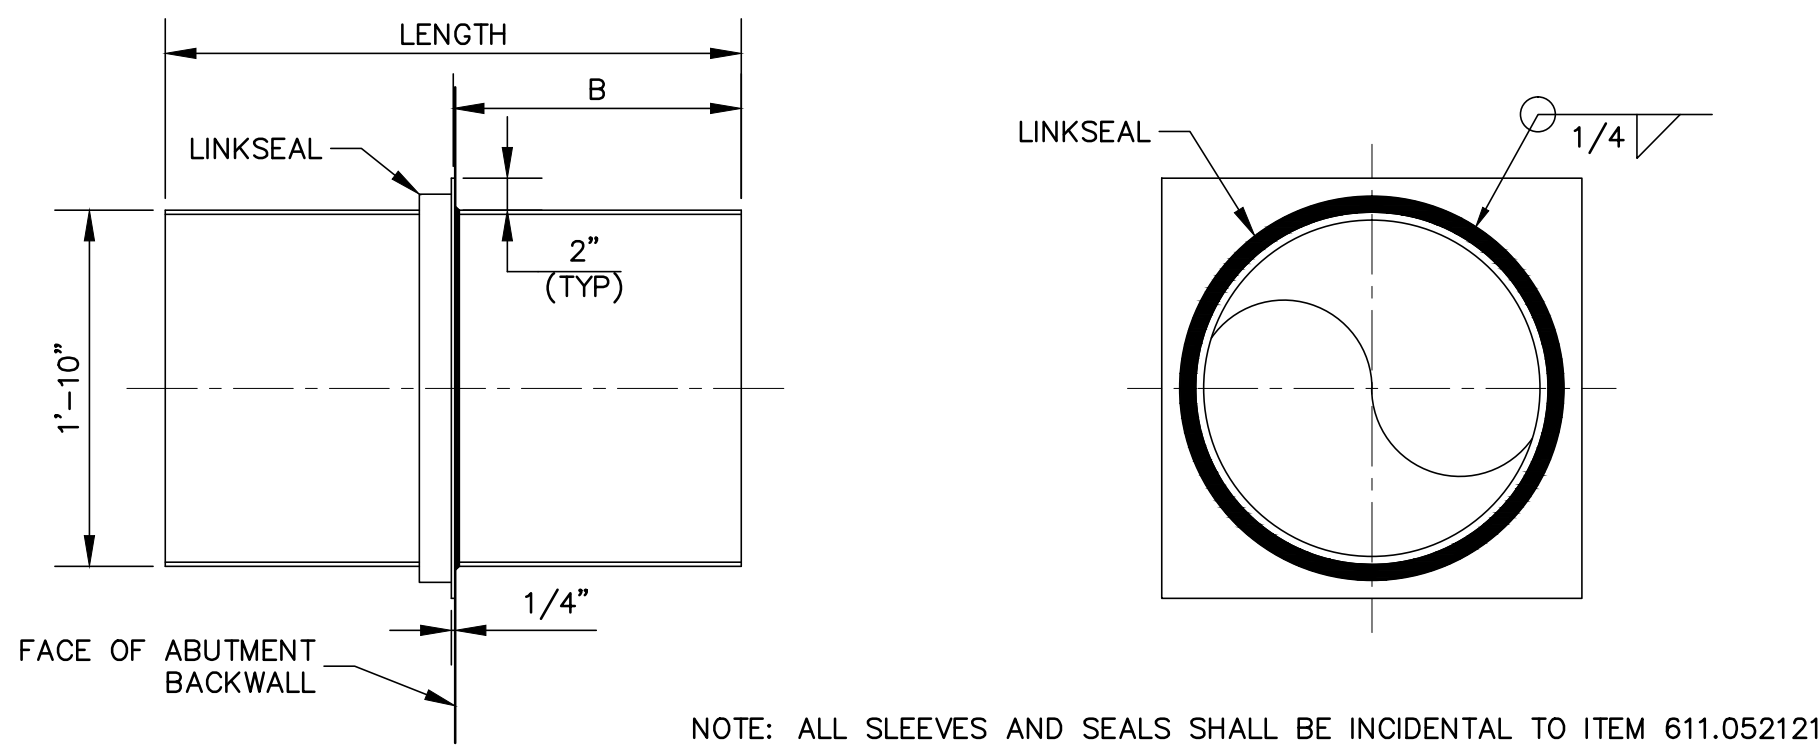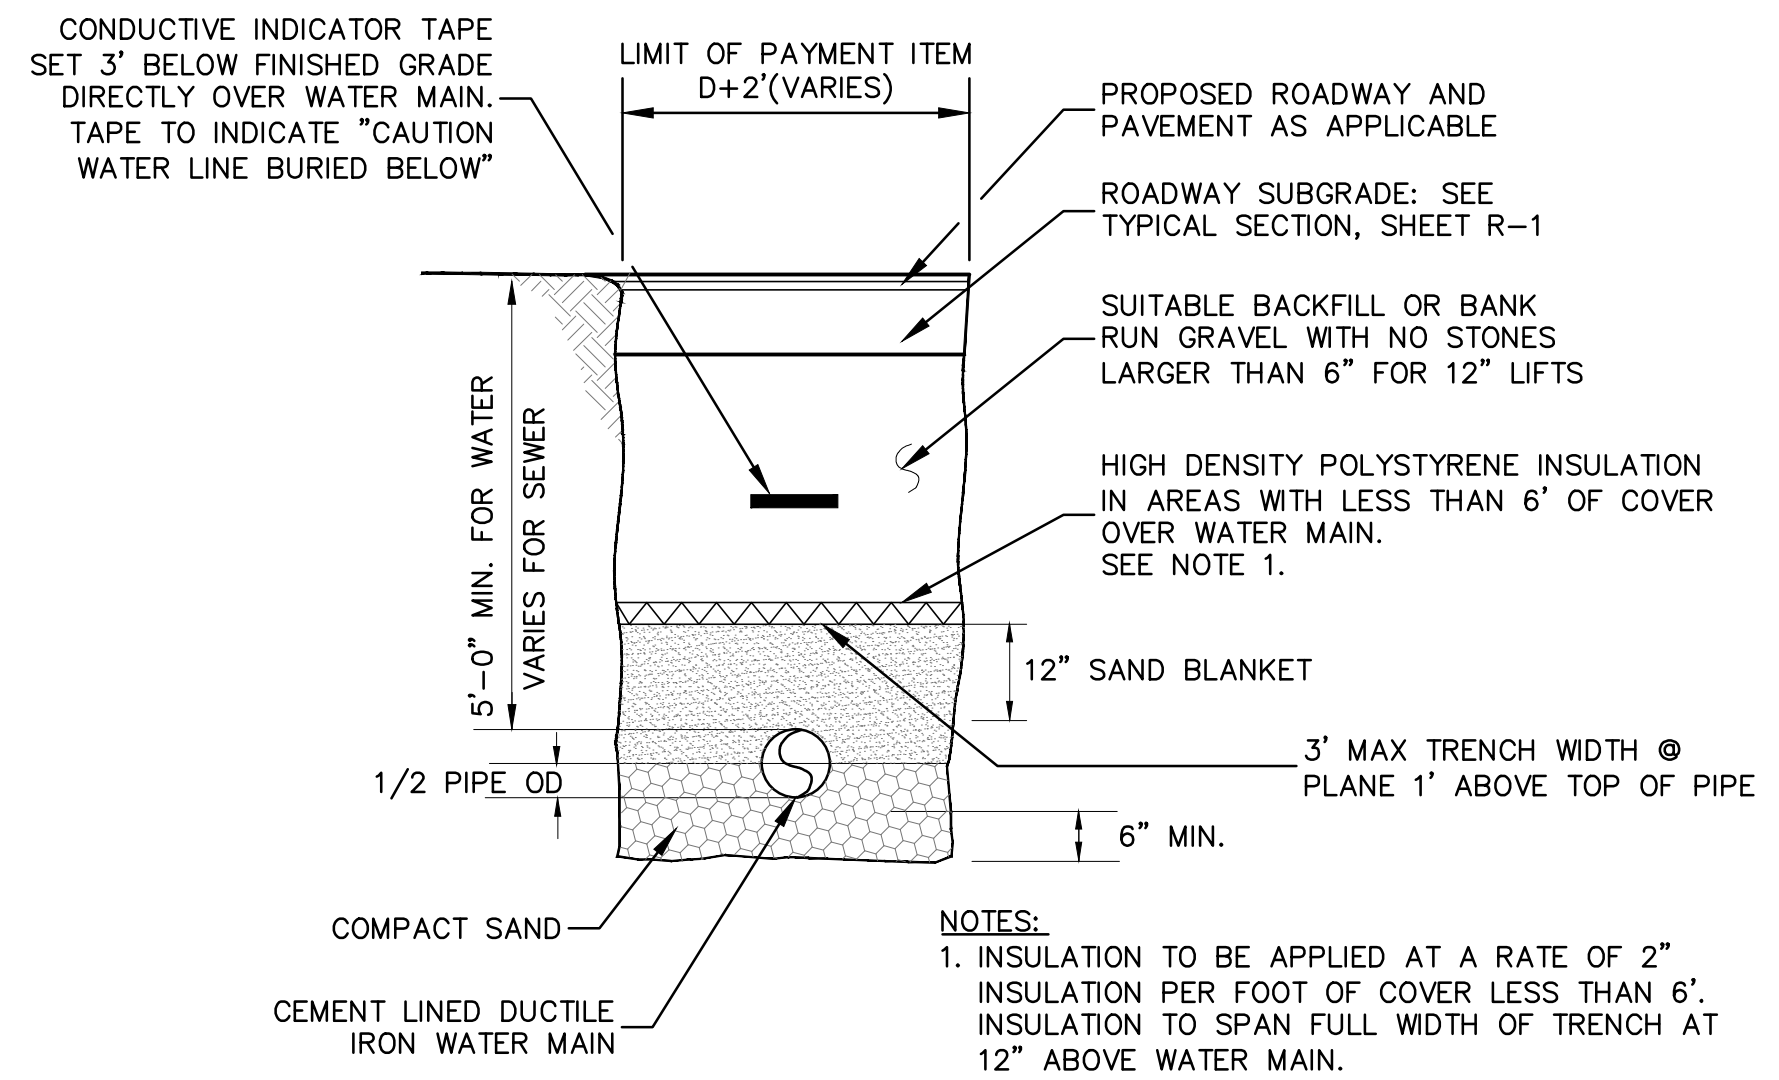


Water Main Pipe Insulation Details


Not to Scale

FIELD APPLIED FITTING COVER DETAIL


designed by: LBK/OGK	date: June 2017	drawn by: LBK/BGP	project no.:	file name: R-8.dwg	approved by: JLG	scale:
<p>Town of Exeter Department of Public Works Court Street Little River Bridge Replacement Road and Utility Details</p>						
drawing no. R-8						
sheet: 30 of 34						
<p>CMA ENGINEERS CIVIL/ENVIRONMENTAL/STRUCTURAL Portsmouth, NH, Manchester, NH, Portland, ME 603/431-8196 • 603/627-0708 • 207/841-4223 c m a e n g i n e e r s . c o m</p>						<p>ISSUED FOR CONSTRUCTION</p> <p>revision</p> <p>6/13/17</p> <p>JLG</p> <p>date</p> <p>by</p>

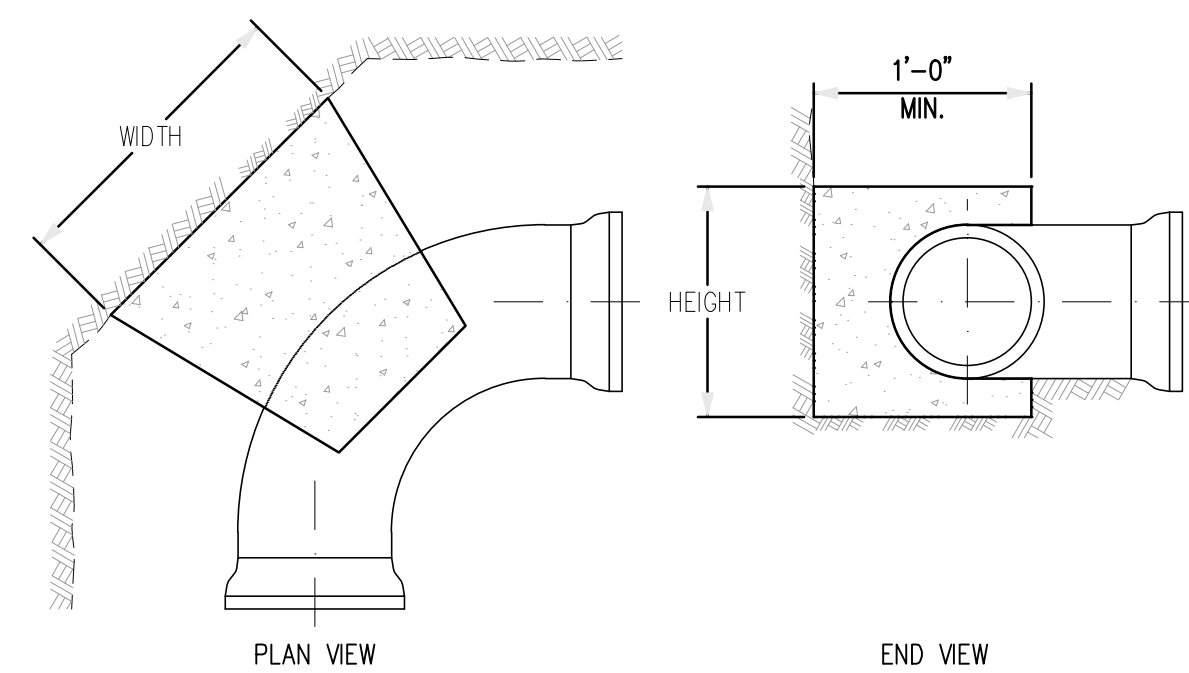

90° BEND THRUST BLOCK DIMENSIONING					
PIPE SIZE	WIDTH (FT-IN)	HEIGHT (FT-IN)	PIPE SIZE	WIDTH (FT-IN)	HEIGHT (FT-IN)
4 NPS	2'-3"	1'-3"	14 NPS	7'-3"	3'-6"
6 NPS	3'-3"	1'-9"	16 NPS	8'-3"	4'-0"
8 NPS	4'-3"	2'-3"	18 NPS	9'-3"	4'-6"
10 NPS	5'-3"	2'-6"	20 NPS	10'-6"	5'-0"
12 NPS	6'-0"	3'-3"	24 NPS	12'-6"	6'-0"

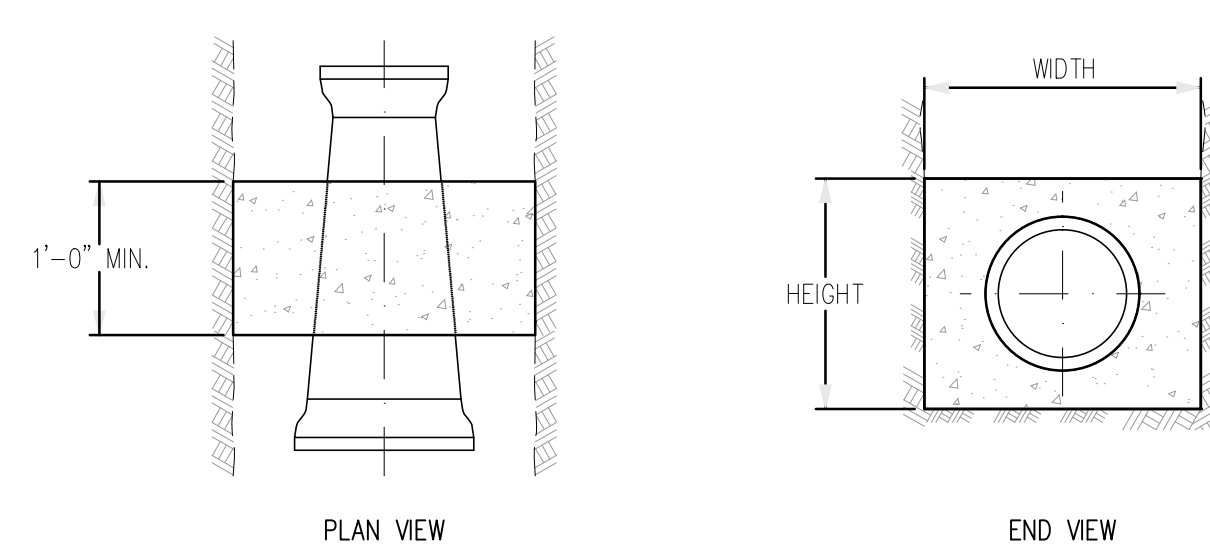


REDUCER THRUST BLOCK DIMENSIONING					
SIZE	WIDTH (FT-IN)	HEIGHT (FT-IN)	SIZE	WIDTH (FT-IN)	HEIGHT (FT-IN)
6x4 NPS	1'-6"	1'-6"	16x8 NPS	4'-6"	4'-6"
8x4 NPS	2'-3"	2'-3"	16x10 NPS	4'-0"	4'-0"
8x6 NPS	1'-9"	1'-9"	16x12 NPS	3'-6"	3'-6"
10x6 NPS	2'-6"	2'-6"	20x12 NPS	5'-0"	5'-0"
10x8 NPS	2'-0"	2'-0"	20x16 NPS	4'-0"	4'-0"
12x6 NPS	3'-3"	3'-3"	24x12 NPS	6'-6"	6'-6"
12x8 NPS	3'-0"	3'-0"	24x16 NPS	5'-9"	5'-9"
12x10 NPS	2'-3"	2'-3"	24x20 NPS	4'-6"	4'-6"

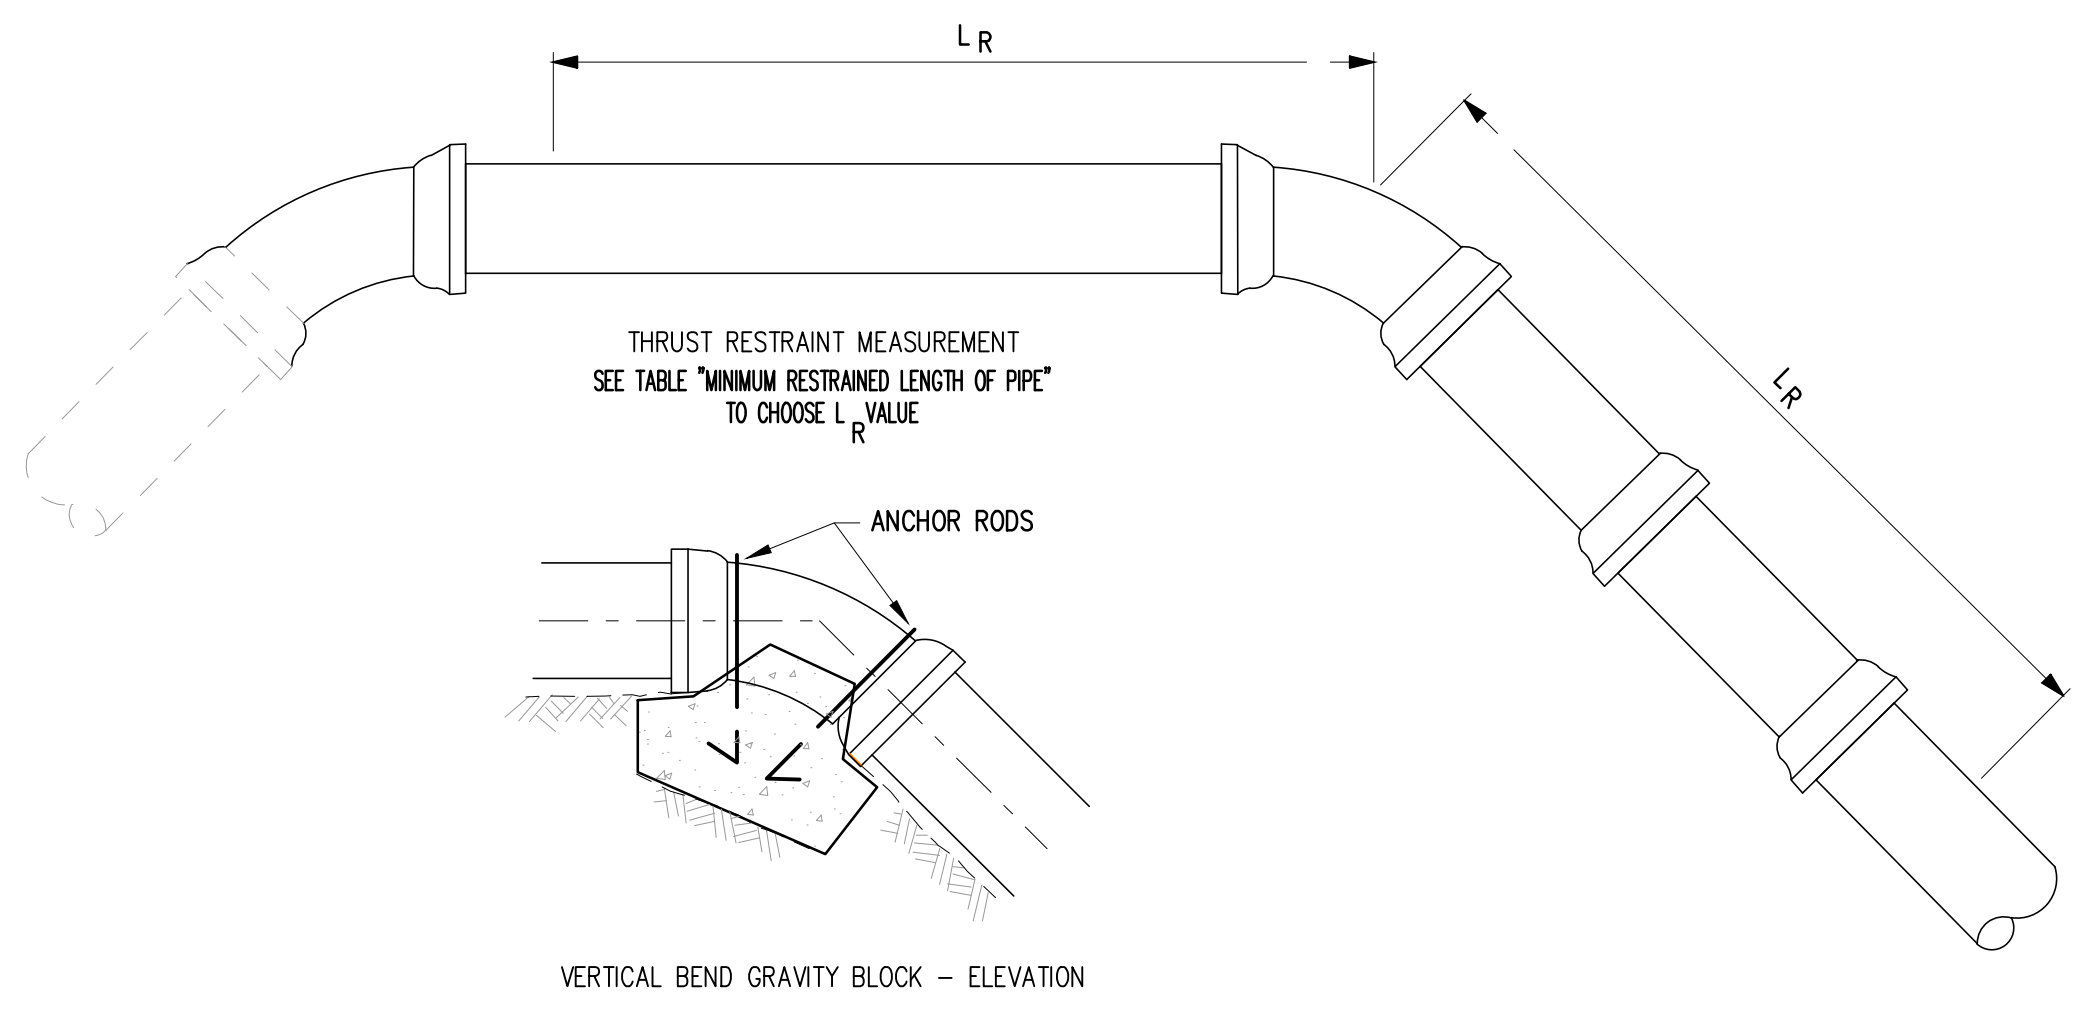


MINIMUM RESTRAINED LENGTH OF PIPE (L) FOR VERTICAL BENDS										
VERTICAL UPWARD BENDS - NPS (FT.)										
FITTING	4 NPS	6 NPS	8 NPS	10 NPS	12 NPS	14 NPS	16 NPS	18 NPS	20 NPS	24 NPS
11 1/4'	1.5	2.0	3.0	3.0	4.0	4.0	5.0	5.0	6.0	6.5
22 1/2'	1.5	2.0	3.0	3.0	4.0	4.0	5.0	5.0	6.0	7.0
45'	3.0	4.0	5.5	6.5	8.0	9.0	10.0	10.5	11.5	13.5
90'	7.0	10.0	12.5	15.5	18.5	20.5	23.0	26.0	28.0	32.5
VERTICAL DOWNWARD BENDS - NPS (FT.)										
FITTING	4 NPS	6 NPS	8 NPS	10 NPS	12 NPS	14 NPS	16 NPS	18 NPS	20 NPS	24 NPS
11 1/4'	3.5	5.0	6.5	8.0	9.5	10.5	12.0	13.0	14.5	17.0
22 1/2'	7.0	10.0	13.0	15.5	18.5	21.0	24.0	26.5	29.0	34.0
45'	14.5	20.5	27.0	32.5	38.5	44.0	49.0	54.5	60.0	70.0
90'	35.0	49.5	64.0	78.0	92.0	105.0	118.5	131.5	144.5	169.0

NOTE: FOR POLYETHYLENE WRAPPED PIPE, MULTIPLY VALUES IN TABLE BY 1.45
NOTE: FOR PVC PIPE MULTIPLY VALUES IN TABLE BY 1.15

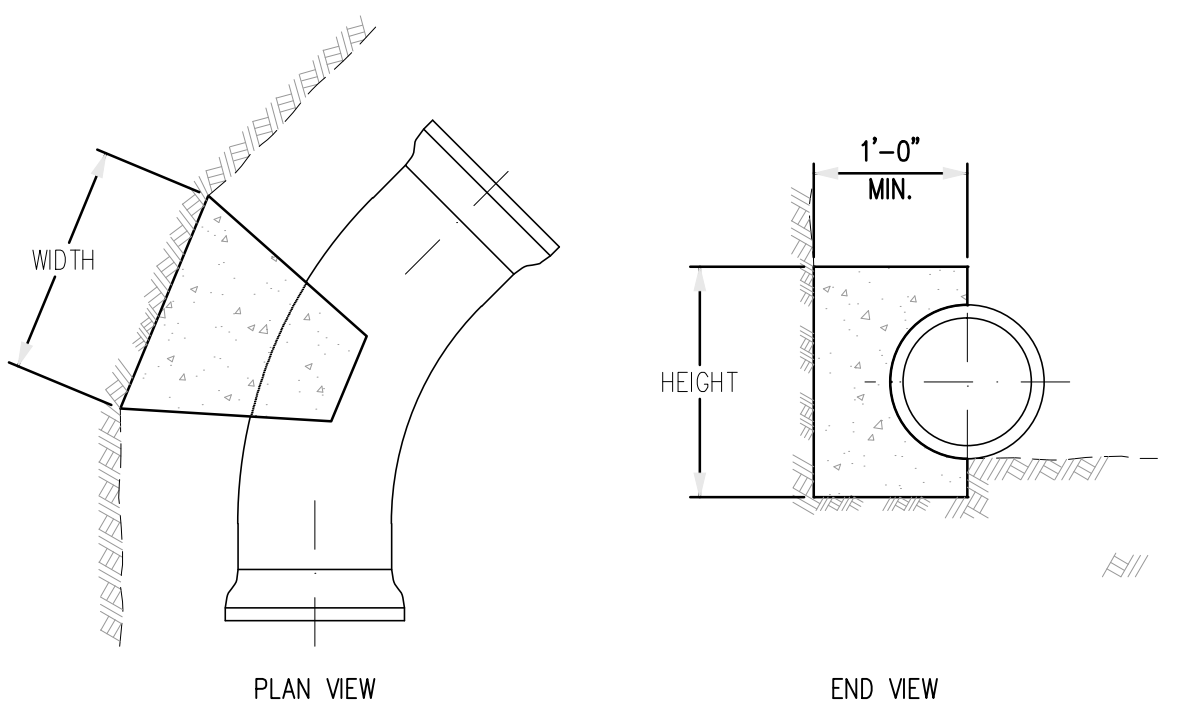

45° BEND THRUST BLOCK DIMENSIONING					
PIPE SIZE	WIDTH (FT-IN)	HEIGHT (FT-IN)	PIPE SIZE	WIDTH (FT-IN)	HEIGHT (FT-IN)
4 NPS	2'-0"	0'-9"	14 NPS	5'-3"	2'-6"
6 NPS	2'-6"	1'-3"	16 NPS	5'-9"	3'-3"
8 NPS	3'-3"	1'-9"	18 NPS	7'-3"	3'-3"
10 NPS	4'-0"	2'-0"	20 NPS	7'-3"	4'-0"
12 NPS	4'-6"	2'-3"	24 NPS	8'-9"	4'-6"

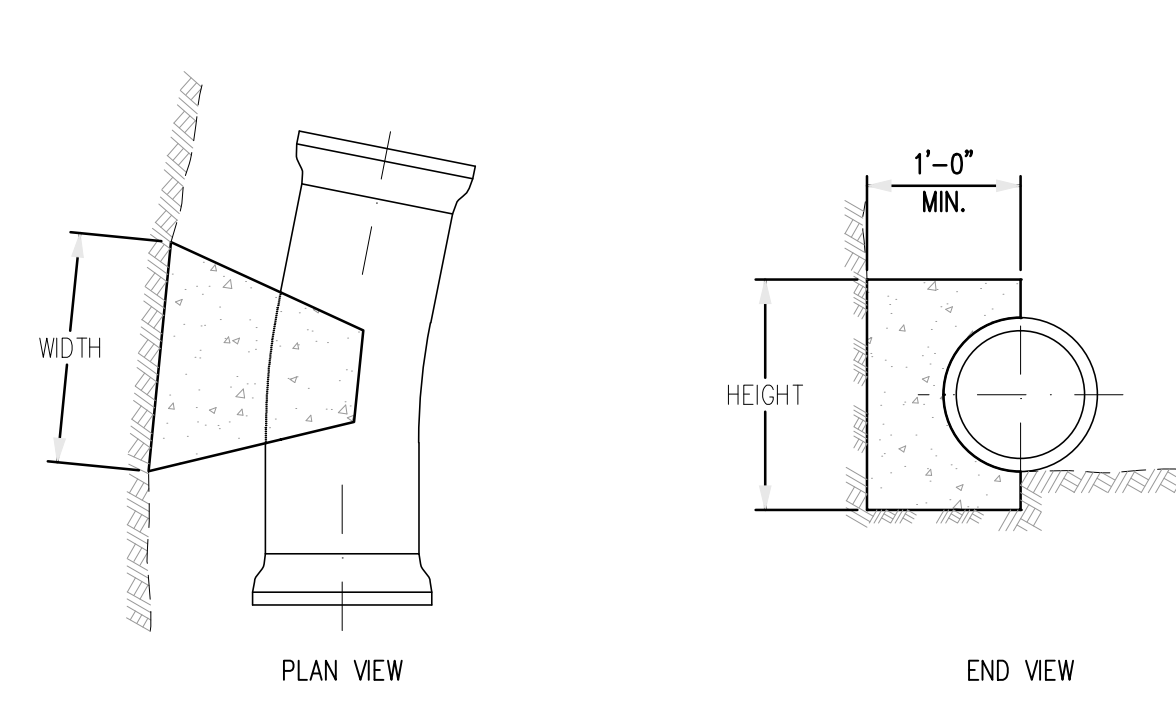

11 1/2° BEND THRUST BLOCK DIMENSIONING					
PIPE SIZE	WIDTH (FT-IN)	HEIGHT (FT-IN)	PIPE SIZE	WIDTH (FT-IN)	HEIGHT (FT-IN)
4 NPS	1'-0"	0'-6"	14 NPS	3'-0"	1'-3"
6 NPS	1'-3"	0'-9"	16 NPS	3'-3"	1'-9"
8 NPS	1'-9"	0'-9"	18 NPS	3'-6"	1'-9"
10 NPS	2'-0"	1'-0"	20 NPS	3'-6"	2'-0"
12 NPS	2'-3"	1'-3"	24 NPS	4'-6"	2'-3"


ANCHOR ROD SCHEDULE FOR GRAVITY BLOCKS		
PIPE SIZE	RODS	MIN. EMBEDMENT LENGTH
4 NPS	1 - (3)	6"
6 NPS	1 - (3)	6"
8 NPS	2 - (4)	6"
10 NPS	2 - (4)	6"
12 NPS	2 - (5)	7"
14 NPS	2 - (6)	8"
16 NPS	2 - (6)	8"
18 NPS	2 - (7)	10"
20 NPS	2 - (8)	11"
24 NPS	2 - (9)	12"

NUMBERS IN PARENTHESIS ARE BAR SIZES MARKED IN EIGHTHS OF INCHES


THRUST BLOCK NOTES:

- SEE SPECIAL PROVISION 611 - WATER MAIN INSTALLATION FOR ADDITIONAL INFORMATION ON THRUST RESTRAINT REQUIREMENTS.
- THRUST RESTRAINT USING THRUST BLOCKS OR RESTRAINED LENGTHS ARE SHOWN ON THESE SHEETS. THRUST BLOCKS, RESTRAINED JOINTS USING TIE RODS OR RETAINER GLANDS ARE ALL ACCEPTABLE METHODS; HOWEVER, THE THRUST RESTRAINT METHOD SELECTED SHALL BE APPROVED BY THE ENGINEER.
- IF THE OWNER OF THE WATER SYSTEM ALLOWS A METHOD THAT RESTRAINS INDIVIDUAL JOINTS, EACH JOINT THAT FALLS WITHIN THE MINIMUM RESTRAINED LENGTH, MEASURED FROM THE CENTER OF THE FITTING, AS SHOWN ON THESE SHEETS SHALL BE RESTRAINED, AND SHALL WITHSTAND THE MAXIMUM PRESSURE APPLIED TO THE SYSTEM.
- CLASS B CONCRETE SHALL NOT BE PLACED UNDERWATER. THE CONTRACTOR SHALL Dewater the excavation to install the thrust blocks in the dry.
- CONCRETE FOR THRUST BLOCKS SHALL NOT BE ALLOWED TO COVER OR INTERFERE WITH JOINT OR RESTRAINT HARDWARE. PLASTIC SHEETING OR BUILDING FELT MAY BE PLACED OVER PIPE OR FITTINGS TO PREVENT CONCRETE FROM ADHERING TO SURFACES.
- FOR BENDS, BEARING AREA SHALL BE PARALLEL TO THE EDGE OF THE FITTING AT THE FITTING MIDPOINT.
- FOR TEES, BEARING AREA SHALL BE PERPENDICULAR TO THE BRANCH (SINGLE LEG) AXIS.
- FOR REDUCERS, BEARING AREA SHALL BE PERPENDICULAR TO THE FITTING AXIS. THE MINIMUM THICKNESS ALONG THE FITTING AXIS SHALL BE 1'-0" OR THE LENGTH BETWEEN THE BELLS, WHICHEVER IS SMALLER.
- THRUST BLOCK ANCHOR RODS SHALL MEET THE REQUIREMENTS OF SECTION 530.2.5 OF THE MHDOT STANDARD SPECIFICATIONS. ALL EMBEDDED RODS SHALL HAVE STANDARD AGI HOOKS ON EACH END, AND SHALL HAVE A MINIMUM OF 3" CONCRETE COVER IN ALL DIRECTIONS.
- THRUST RESTRAINT FOR SIZES OVER 24 NPS AND/OR FOR OTHER FITTINGS NOT SHOWN ON THESE SHEETS WILL BE AS SHOWN IN THE CONTRACT DOCUMENTS.
- THRUST BLOCK SIZES AND MINIMUM RESTRAINED LENGTHS SHOWN ON THESE SHEETS ARE BASED UPON THE FOLLOWING ASSUMED CONDITIONS:
 - 1.5 SAFETY FACTOR
 - 5 FT DEPTH OF COVER
 - 200 PSI WATER SYSTEM TEST PRESSURE
 - 30n SOIL FRICTION ANGLE
 - 90 LBS/FT³ SOIL UNIT WEIGHT
 - IF SOILS ARE POORER THEN REFER TO REFERENCES
- FOR INSTALLATIONS NOT MEETING THE CONDITIONS OF NOTE 8, THE CONTRACTOR SHALL SUBMIT CALCULATIONS TO THE ENGINEER FOR APPROVAL OF RESTRAINT LENGTH CHOSEN.
- TO DETERMINE REQUIRED SIZES FOR DIFFERENT TEST PRESSURES, MULTIPLY THE DIMENSION BY A FACTOR OF THE SPECIFIC VALUE DIVIDED BY THE STANDARD VALUE.

EXAMPLE: GRAVITY BLOCK VOLUME FOR 12 NPS 45' BEND WITH 100 PSI TEST PRESSURE:
WIDTH = 3'-3"
HEIGHT = 1'-7"
VOLUME REQUIRED 134 FT³ X (100/200) = 67 FT³

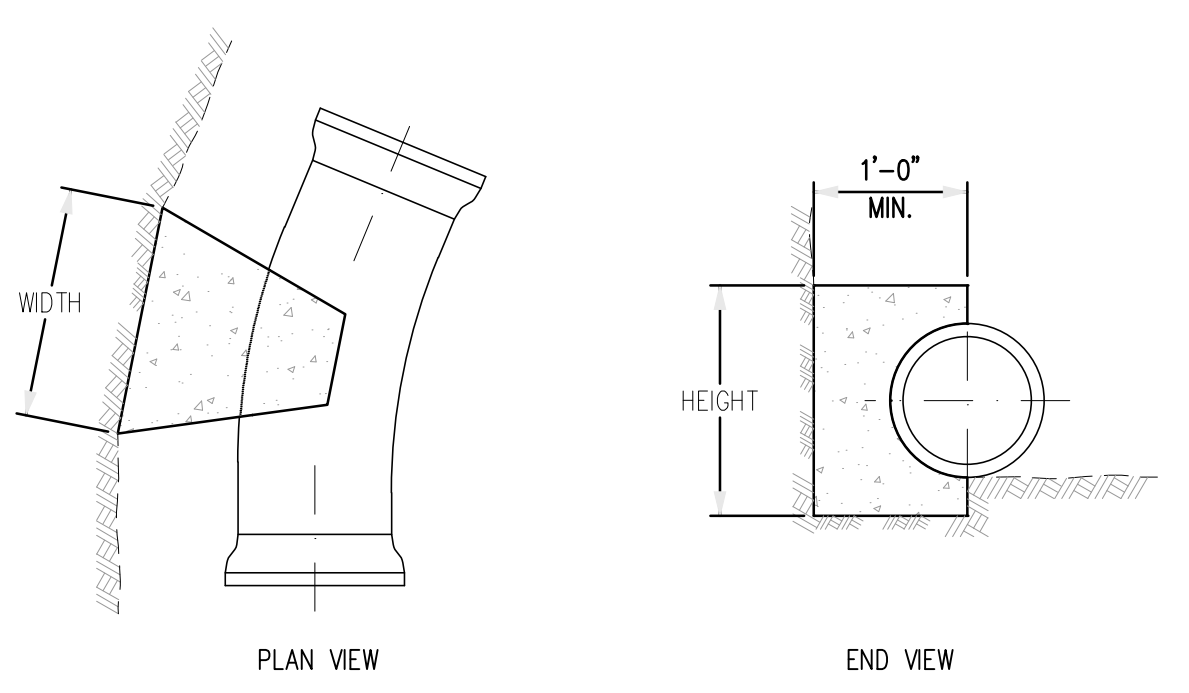

22 1/2° BEND THRUST BLOCK DIMENSIONING					
PIPE SIZE	WIDTH (FT-IN)	HEIGHT (FT-IN)	PIPE SIZE	WIDTH (FT-IN)	HEIGHT (FT-IN)
4 NPS	1'-3"	0'-9"	14 NPS	3'-6"	2'-0"
6 NPS	2'-0"	0'-9"	16 NPS	4'-6"	2'-3"
8 NPS	2'-3"	1'-3"	18 NPS	5'-0"	2'-6"
10 NPS	3'-0"	1'-3"	20 NPS	5'-0"	3'-0"
12 NPS	3'-3"	1'-9"	24 NPS	6'-3"	3'-3"

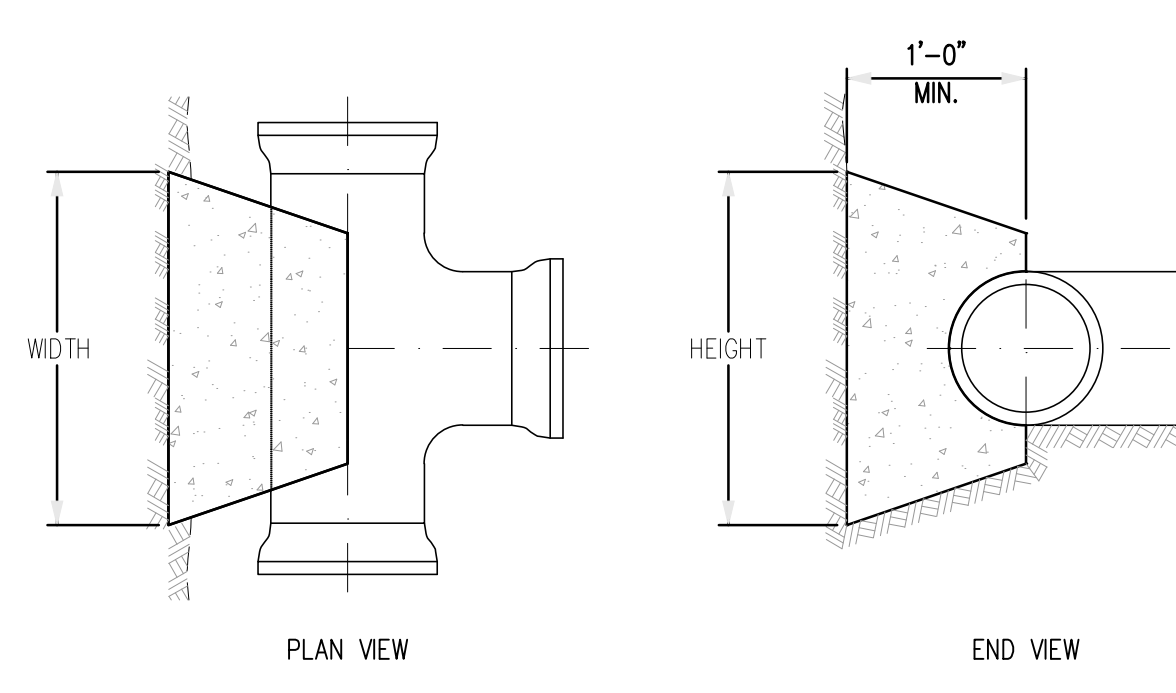

TEE/DEAD END THRUST BLOCK DIMENSIONING					
PIPE SIZE	WIDTH (FT-IN)	HEIGHT (FT-IN)	PIPE SIZE	WIDTH (FT-IN)	HEIGHT (FT-IN)
4 NPS	2'-0"	1'-0"	14 NPS	5'-6"	3'-3"
6 NPS	3'-0"	1'-3"	16 NPS	6'-6"	3'-6"
8 NPS	3'-3"	2'-0"	18 NPS	7'-6"	4'-0"
10 NPS	4'-3"	2'-3"	20 NPS	8'-6"	4'-3"
12 NPS	5'-3"	2'-6"	24 NPS	10'-3"	5'-3"

HORIZONTAL THRUST BLOCKS-MINIMUM RESTRAINED LENGTH OF PIPE (FT-IN) L _R										
FITTING	4 NPS	6 NPS	8 NPS	10 NPS	12 NPS	14 NPS	16 NPS	18 NPS	20 NPS	24 NPS
11 n BEND	1'-3"	2'-0"	2'-6"	3'-0"	3'-6"	4'-0"	4'-6"	5'-0"	5'-6"	6'-3"
22 n BEND	1'-3"	2'-0"	2'-6"	3'-0"	3'-6"	4'-0"	4'-6"	5'-0"	5'-6"	6'-6"
45n BEND	3'-0"	4'-0"	5'-3"	6'-3"	7'-6"	8'-6"	9'-6"	10'-6"	11'-6"	13'-6"
90n BEND	7'-0"	9'-9"	12'-6"	15'-6"	18'-0"	20'-0"	23'-0"	25'-6"	28'-0"	32'-6"
DEAD END	8'-6"	12'-6"	16'-0"	19'-3"	23'-0"	26'-0"	29'-6"	33'-0"	36'-0"	42'-0"

NOTE: PVC PIPE WILL TYPICALLY HAVE SLIGHTLY GREATER RESTRAINED LENGTH
NOTE: FOR POLYETHYLENE WRAPPED PIPE, MULTIPLY VALUES IN TABLE BY 1.45

MINIMUM GRAVITY BLOCK VOLUMES FOR VERTICAL BENDS (CU.FT.)										
FITTING	4 NPS	6 NPS	8 NPS	10 NPS	12 NPS	14 NPS	16 NPS	18 NPS	20 NPS	24 NPS
11 1/4'	4	11	18	25	35	46	60	74	92	131
22 1/2'	11	18	32	49	67	92	120	148	184	261
45'	18	35	64	95	134	180	233	293	360	512
90'	32	67	117	177	247	332	431	540	664	950




CMA ENGINEERS
 CIVIL/ENVIRONMENTAL/STRUCTURAL
 Portsmouth, NH • Manchester, NH • Portland, ME
 603/431-6196 • 603/627-0708 • 207/541-4223
 c.m.a.e.n.g.i.n.e.e.r.s.c.o.m.

designed by: LK/OGK
 drawn by: LK/BGP
 approved by: JLG
 date: June 2017
 project no.:
 file name: R-11.dwg
 scale:

Town of Exeter
 Department of Public Works
 Court Street
 Little River Bridge Replacement
 Thrust Block Details


drawing no. R-9
 sheet: 31 of 34

ISSUED FOR CONSTRUCTION
 A no. 6/13/17 JLG by date revision

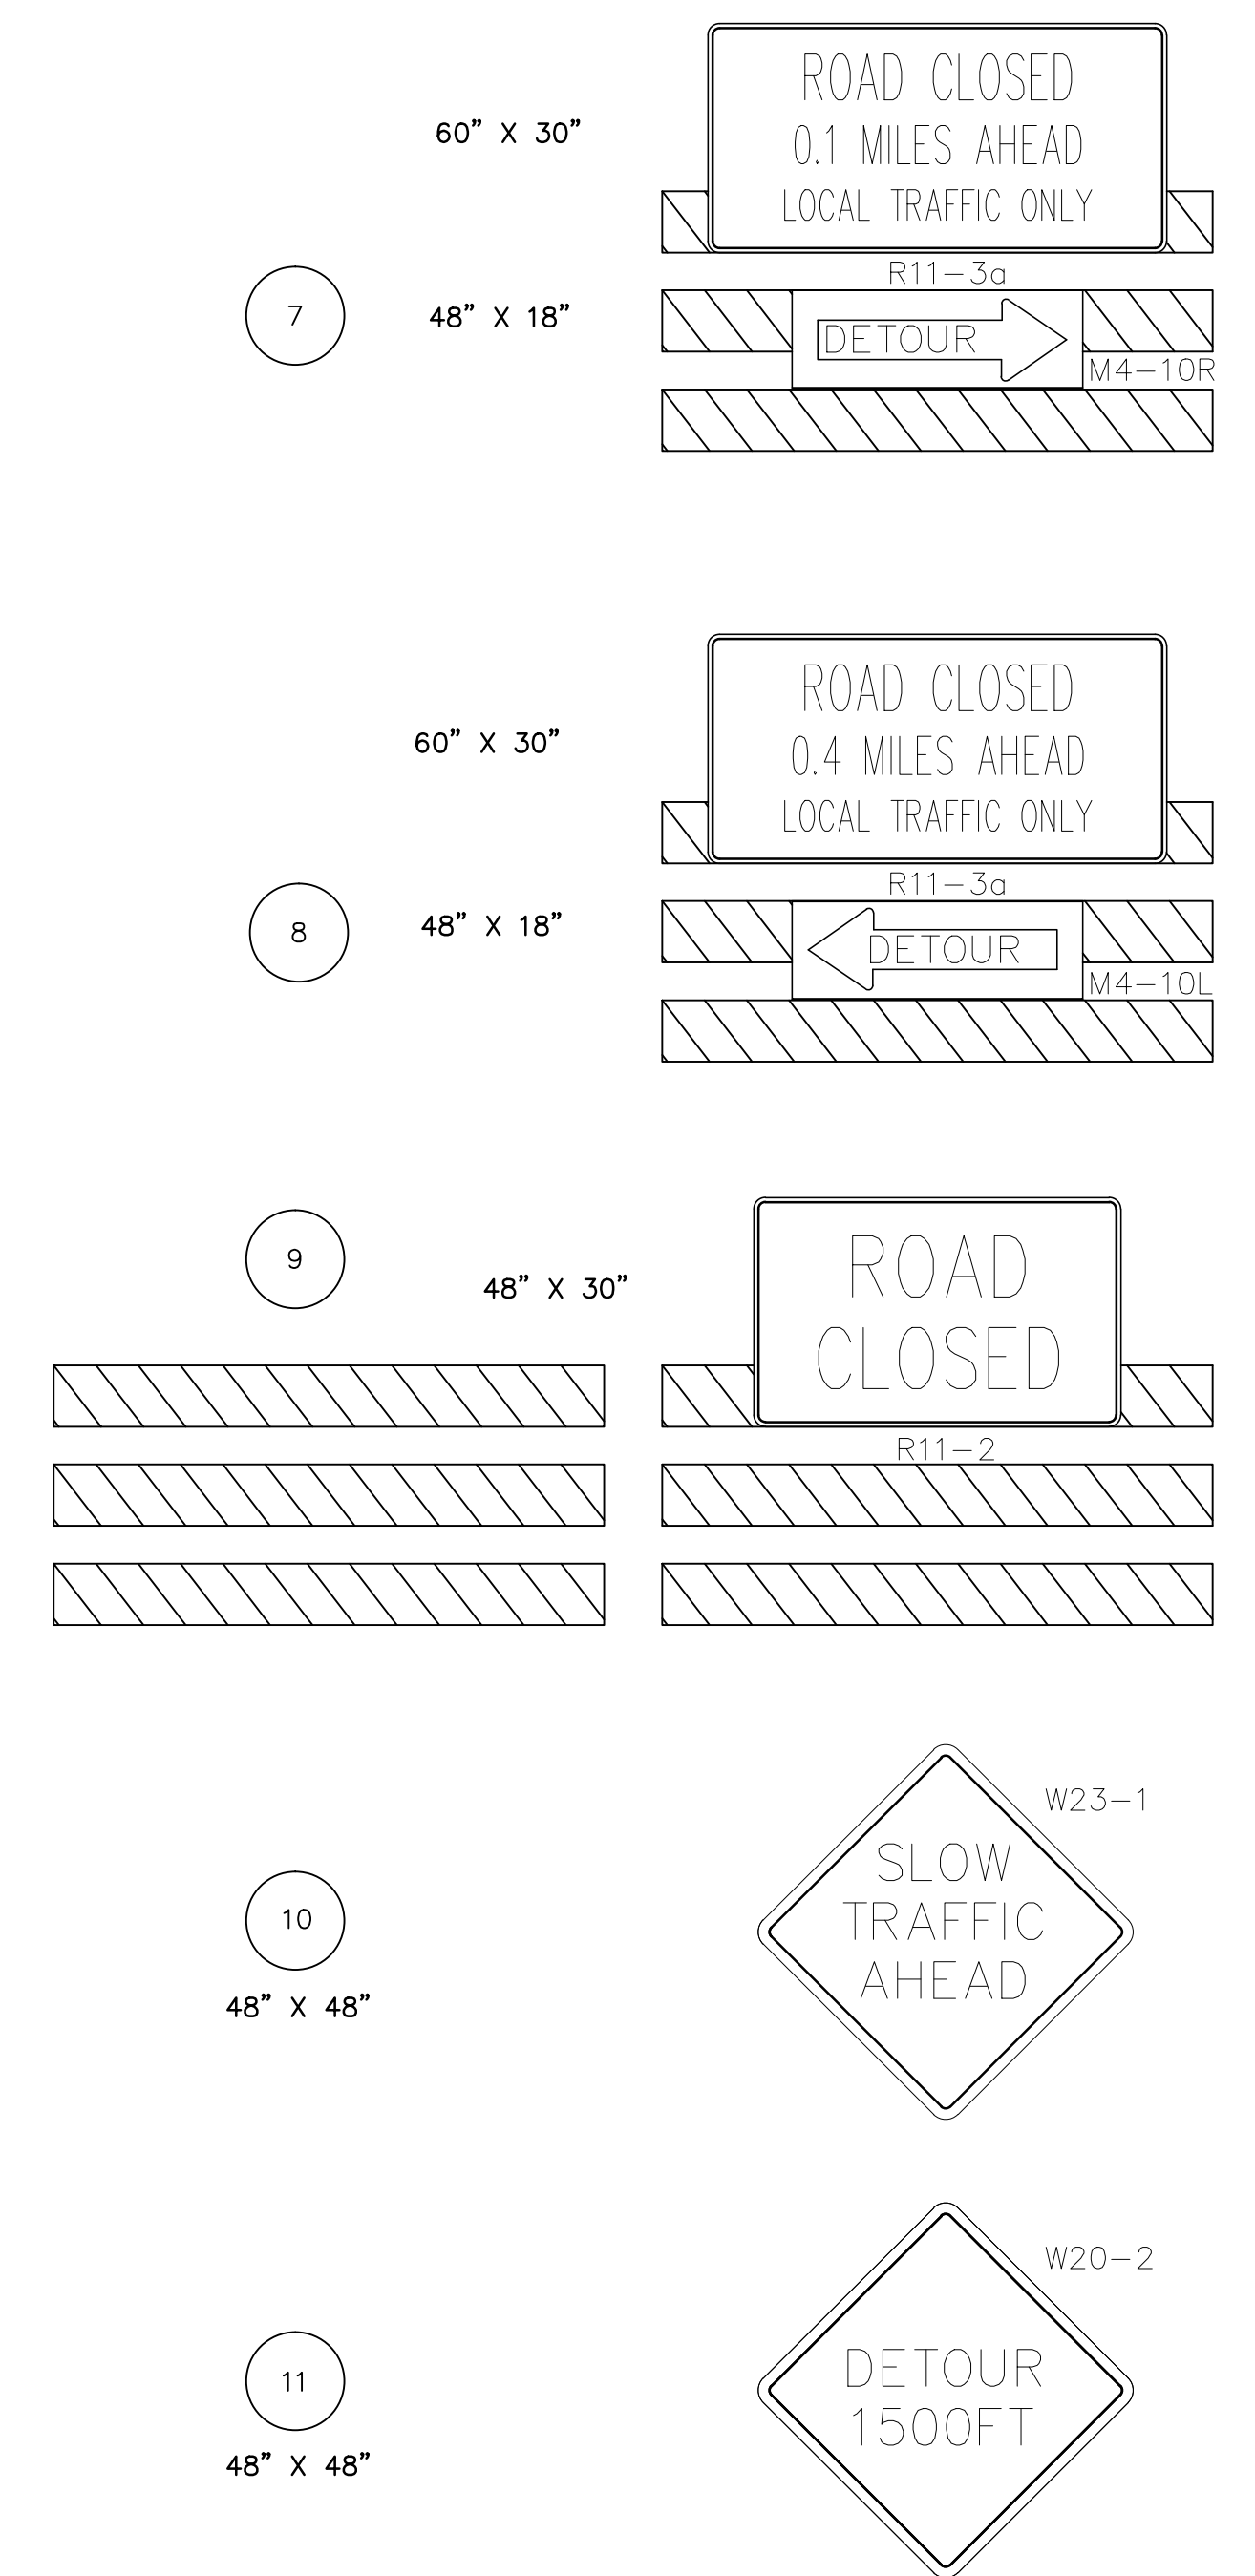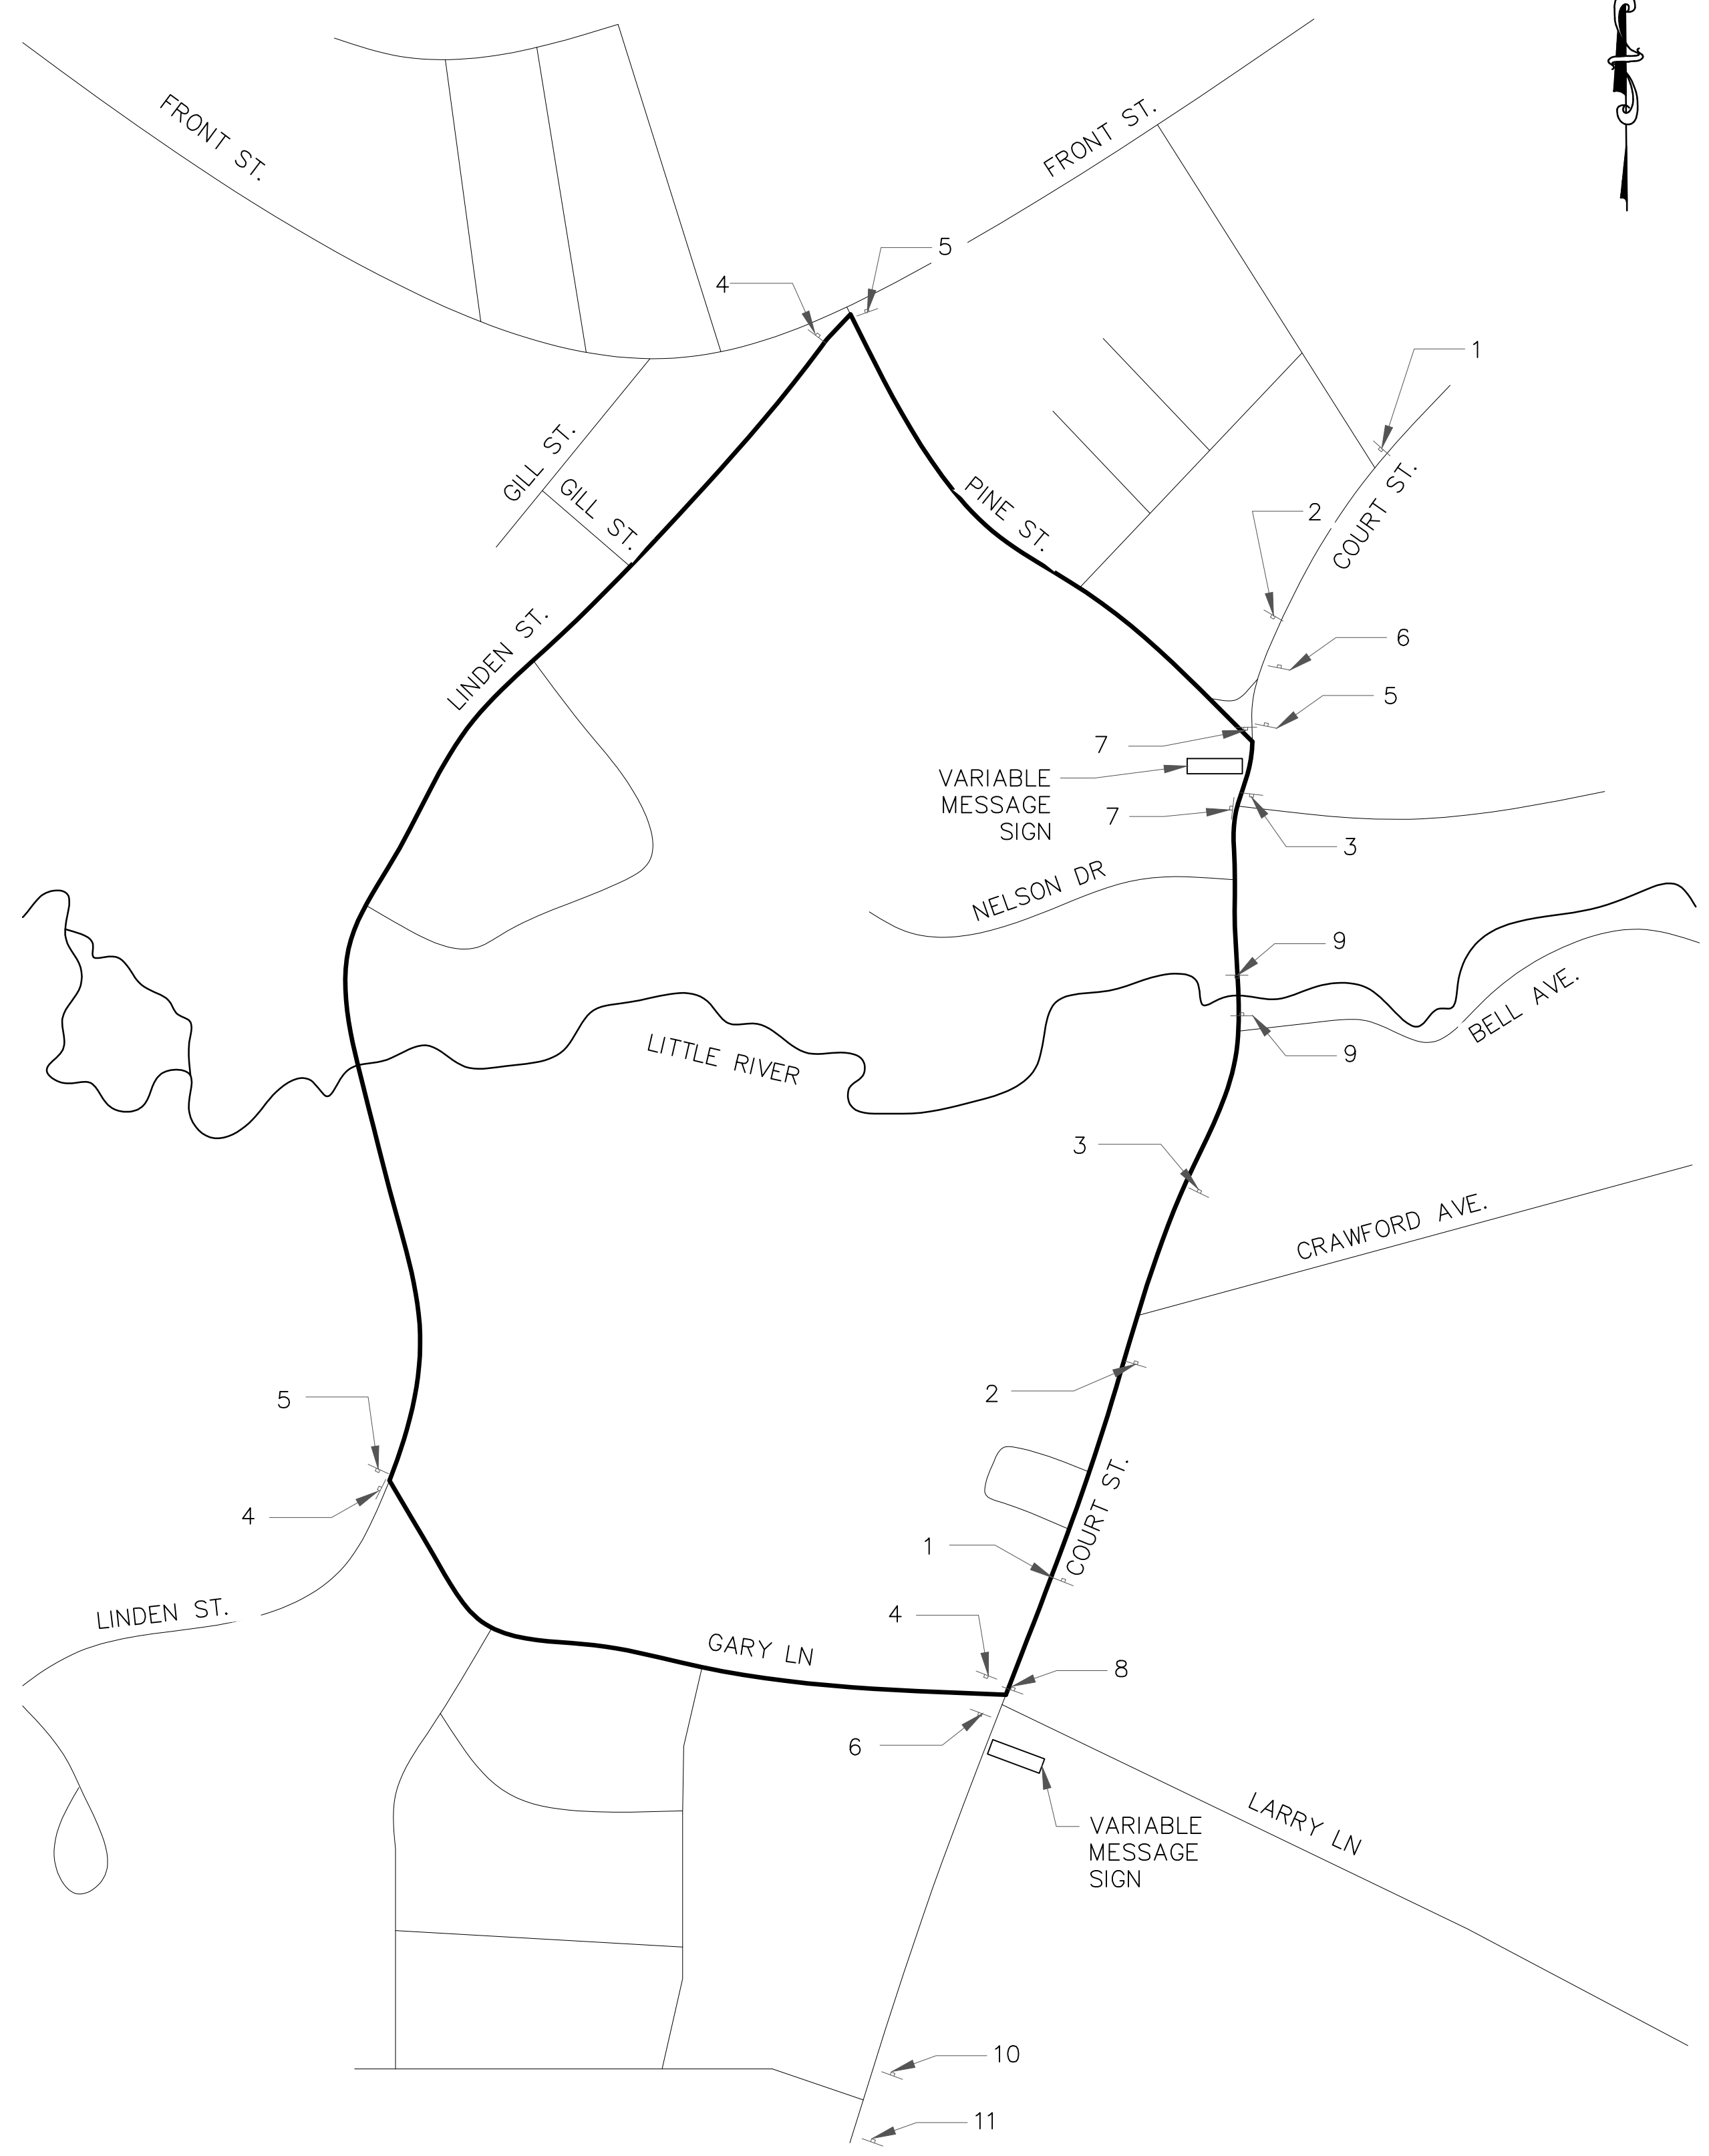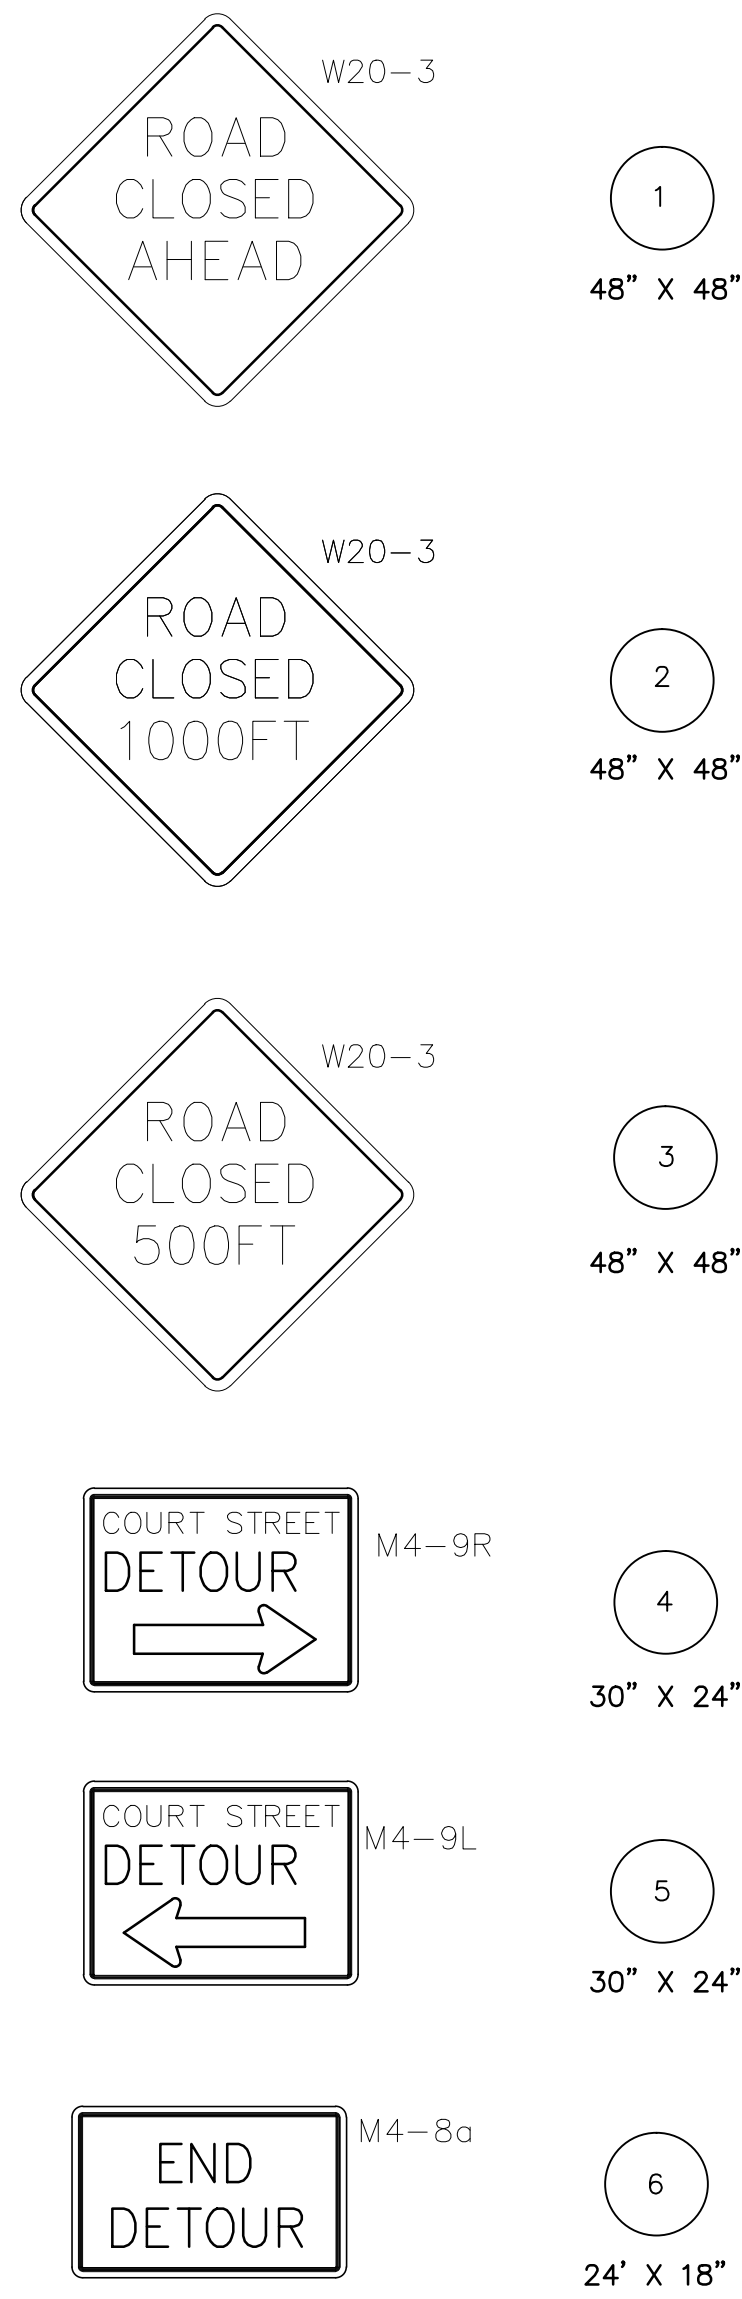


- NOTES:
1. DETOUR SHALL BE SET IN COMPLIANCE WITH THE MUTCD 2009 EDITION AND THE NHDOT STANDARD SPECIFICATIONS, SECTION 619.
 2. 30 LINEAR FT OF TEMPORARY CONCRETE BARRIER SHALL BE PLACED TO BLOCK THE ROADWAY DIRECTLY BEHIND THE TYPE III BARRICADES (#9).
 3. CONTRACTOR IS RESPONSIBLE FOR SUPPLYING AND MAINTAINING ALL SIGNS REQUIRED FOR DETOUR.
 4. SIGNS SHALL BE REMOVED OR COVERED DURING PERIODS IN WHICH THEY ARE NOT REQUIRED.
 5. LAYOUT SHOWN IS NOT TO SCALE AND IS A SUGGESTED LAYOUT.
 6. CONTRACTOR SHALL SUBMIT A TRAFFIC CONTROL PLAN FOR APPROVAL PRIOR TO ANY WORK.
 7. TOTAL ESTIMATED SIGN AREA: 239.5 SF
 8. ALL COST FOR TRAFFIC CONTROL DEVICES INCLUDING PLACEMENT, RELOCATION, AND REMOVAL OF SIGNS SHALL BE INCLUDED IN ITEM 619.1 - MAINTENANCE OF TRAFFIC.
 9. THE CONTRACTOR SHALL COORDINATE ALL WORK WITH THE TOWN OF EXETER PUBLIC WORKS, FIRE AND POLICE DEPARTMENTS, AND ENGINEER AT LEAST 14 DAYS PRIOR TO IMPLEMENTING AND ROAD CLOSURES OR DETOURS.
 10. THE CONTRACTOR SHALL PLACE PORTABLE MESSAGE BOARDS (PMB'S) AS INDICATED ON THE PLANS AT LEAST 7 DAYS IN ADVANCE OF ROAD CLOSURES AND DETOURS.
 11. ACCESS TO EXISTING DRIVES SHALL BE MAINTAINED AT ALL TIMES. IN THE EVENT THAT MAJOR WORK MUST BE DONE AT DRIVES THAT PRECLUDES FULL ACCESS, THE CONTRACTOR IS TO COORDINATE THE WORK WITH THE OWNER TO MINIMIZE INCONVENIENCED.


 CIVIL/ENVIRONMENTAL/STRUCTURAL		Portsmouth, NH • Manchester, NH • Portland, ME 603.431-8196 • 603.627-0708 • 207.541-4223	c m a e n g i n e e r s . c o m
designed by: LBK/OGK	drawn by: LBK/BGP	approved by: JLG	date: June 2017
project no: ---	file name: 023 - Traffic Plan.dwg	scale: ---	drawing no: R-10
Town of Exeter Department of Public Works	Court Street Little River Bridge Replacement	Court Street Traffic Control Plan	sheet: 32 of 34
ISSUED FOR CONSTRUCTION			revision A no.
6/13/17			date JLG by

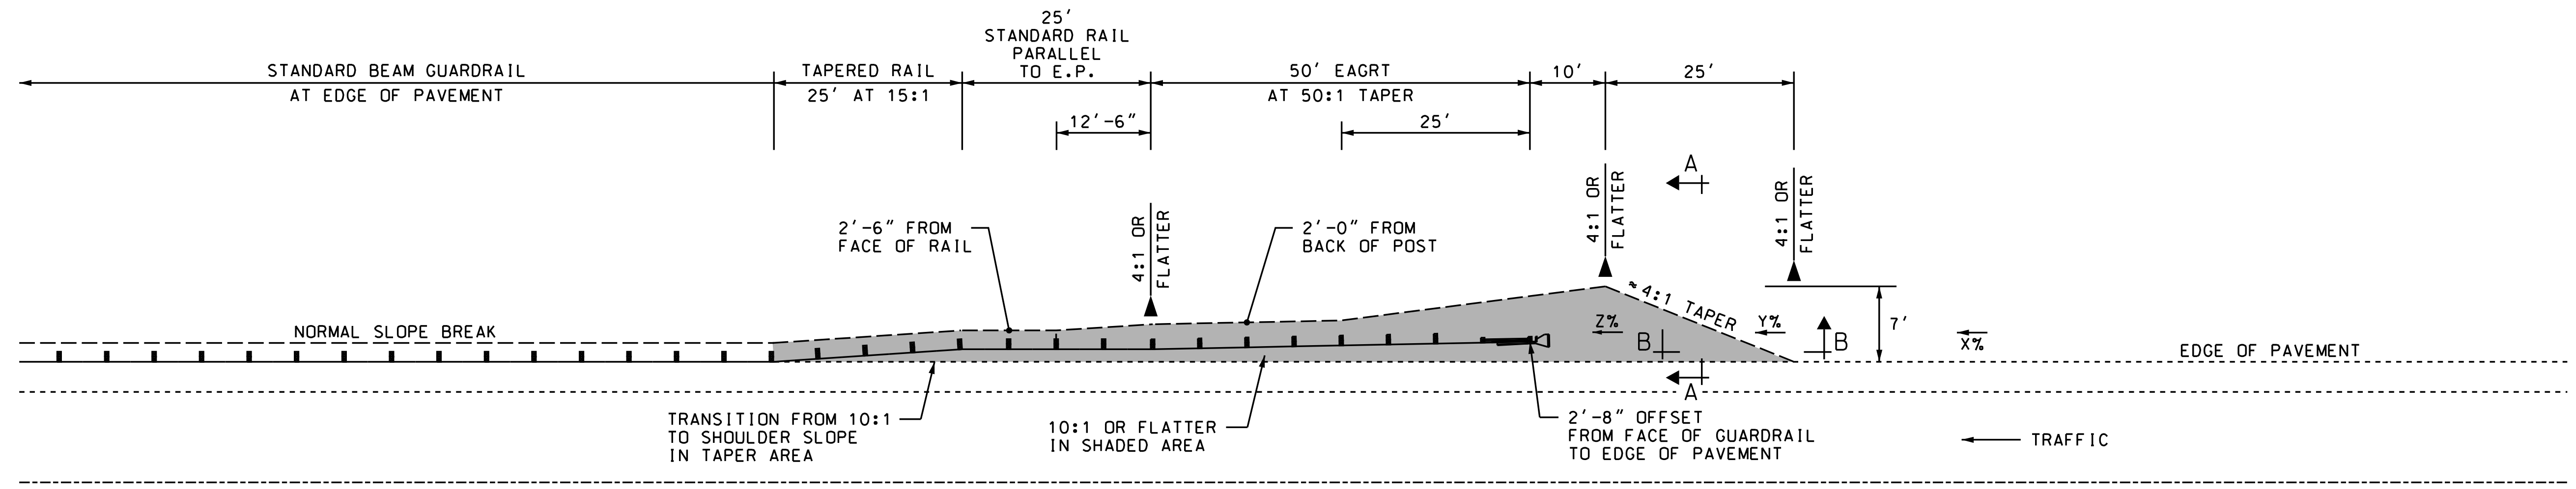

50' EAGRT UNIT

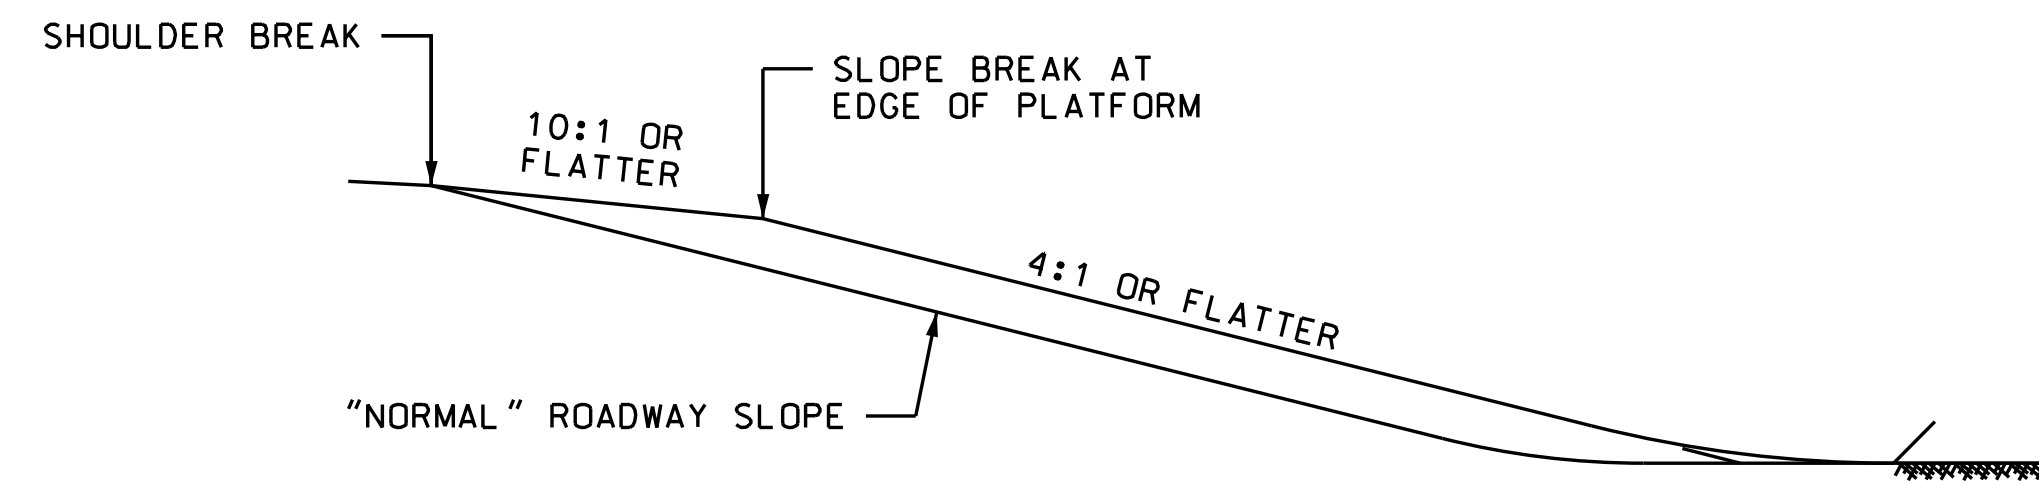


SECTION A-A
PLATFORM SLOPE GRADING

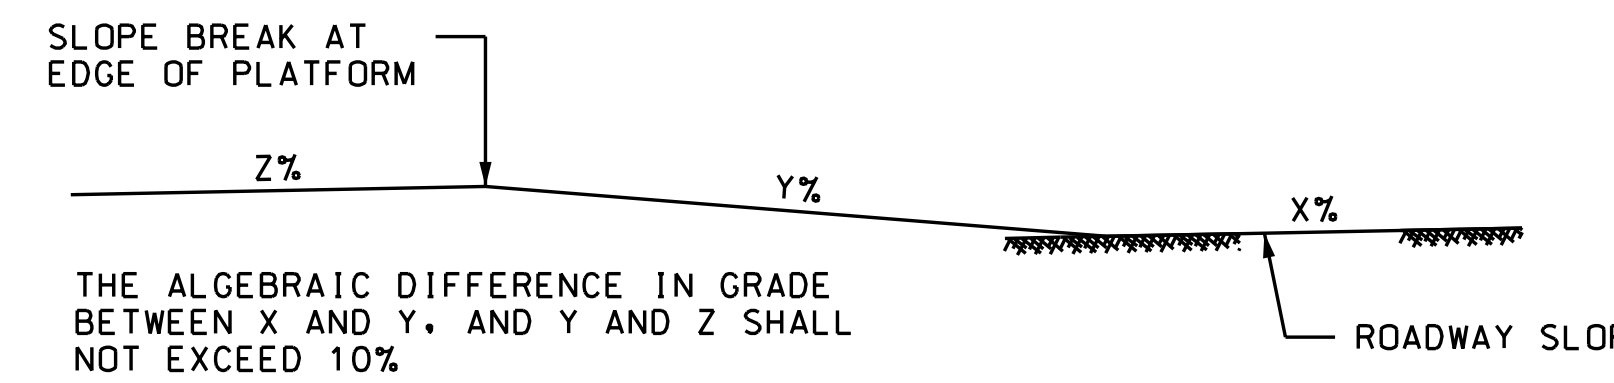

SECTION B-B
PLATFORM APPROACH GRADING

X: LONGITUDINAL GRADE OF ROADWAY SLOPE IN ADVANCE OF PLATFORM
 Y: LONGITUDINAL GRADE OF PLATFORM APPROACH
 Z: LONGITUDINAL GRADE OF PLATFORM

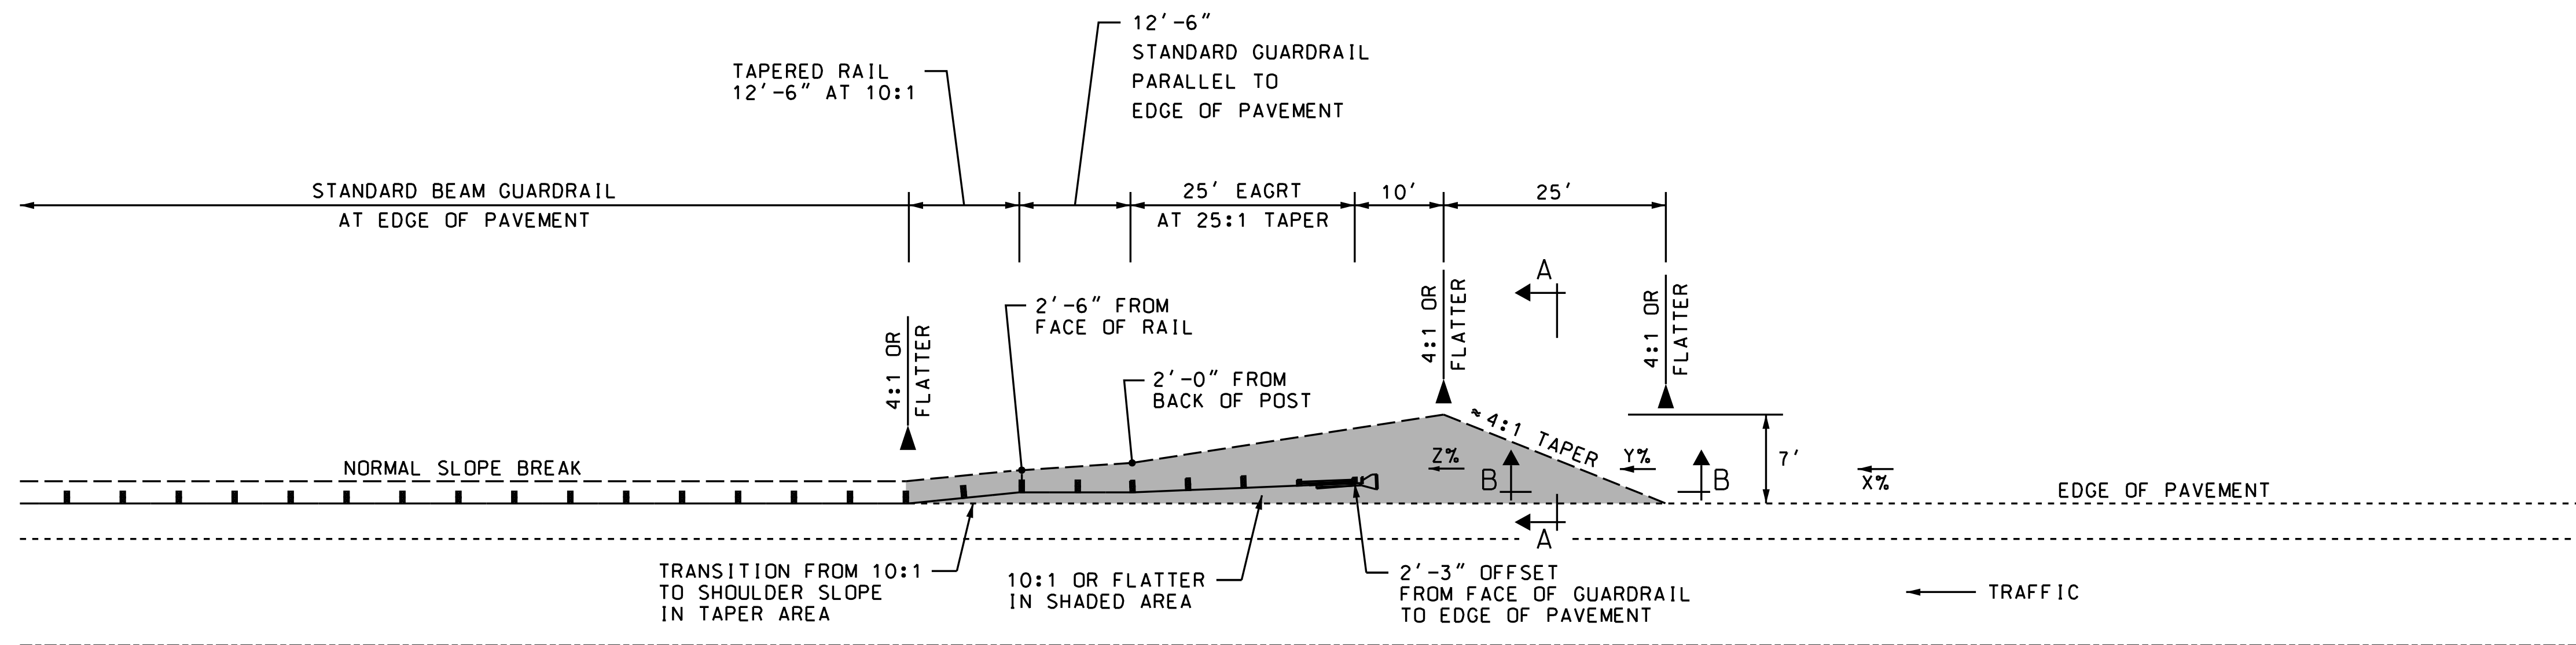


25' EAGRT UNIT


CMA
ENGINEERS

REVISION DATE	DGN	STATE PROJECT NO.	SHEET NO.	TOTAL SHEETS
11/24/14			33	34


STATE OF NEW HAMPSHIRE
 DEPARTMENT OF TRANSPORTATION • BUREAU OF HIGHWAY DESIGN
**ALTERNATIVE PLATFORM FOR
 OFFSET ENERGY ABSORBING
 GUARDRAIL TERMINAL (EAGRT)**

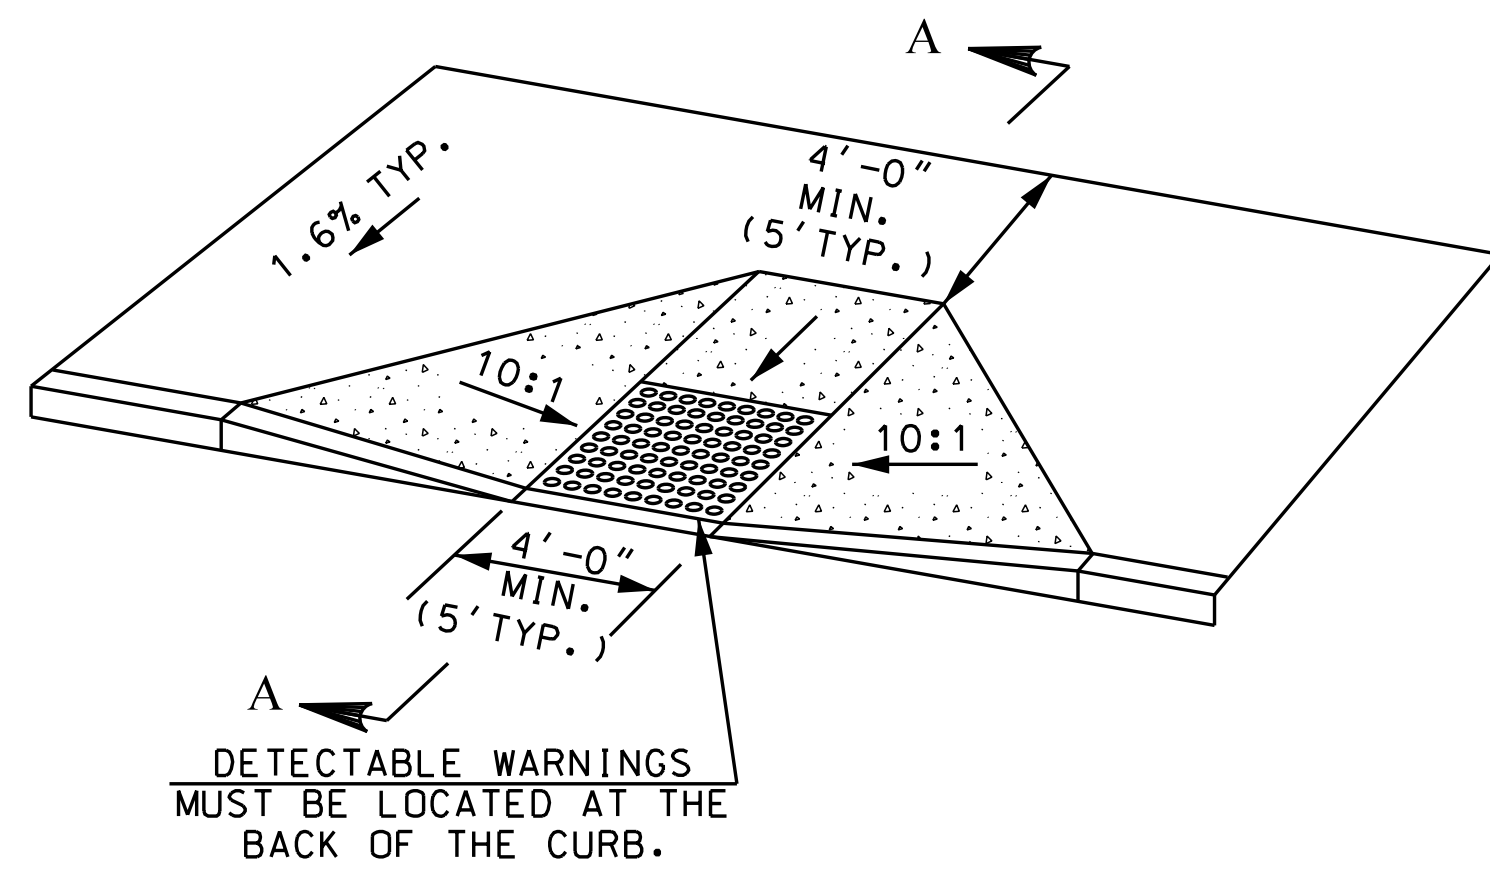


PERPENDICULAR CURB RAMP DETAIL

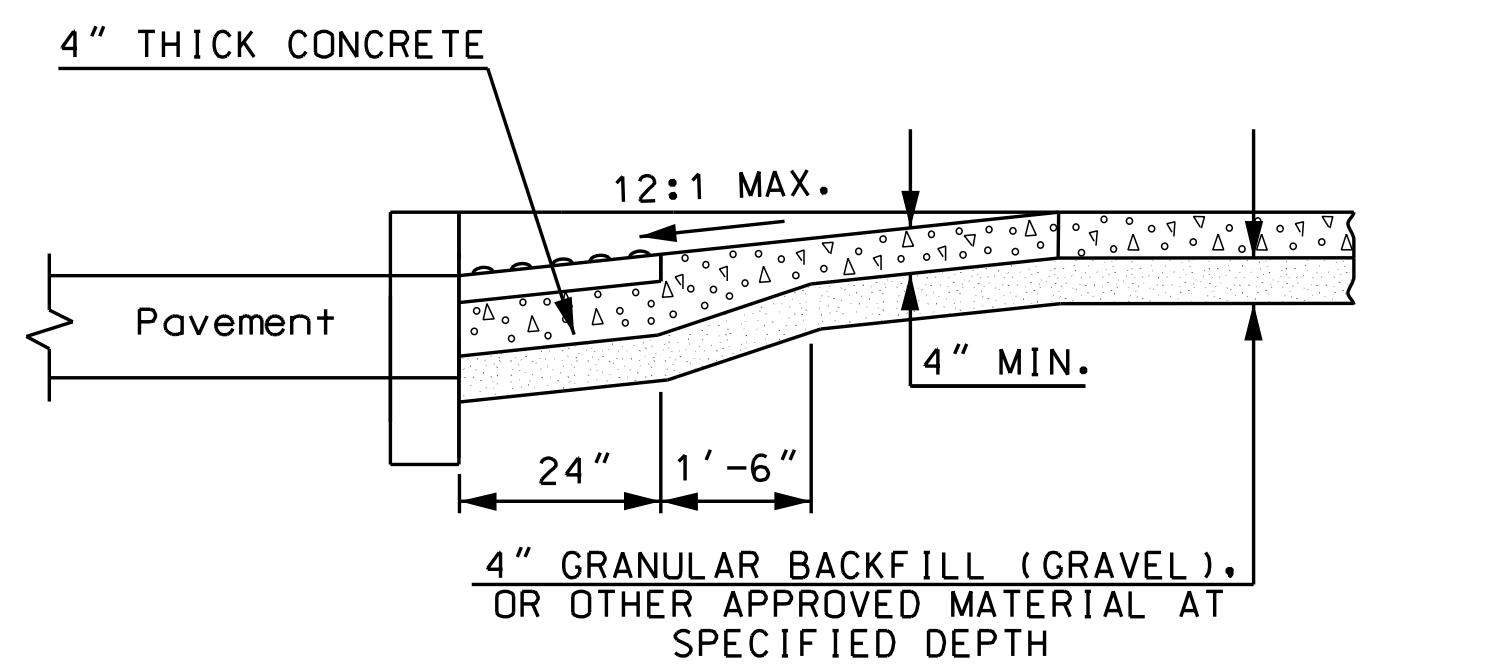


SECTION A-A

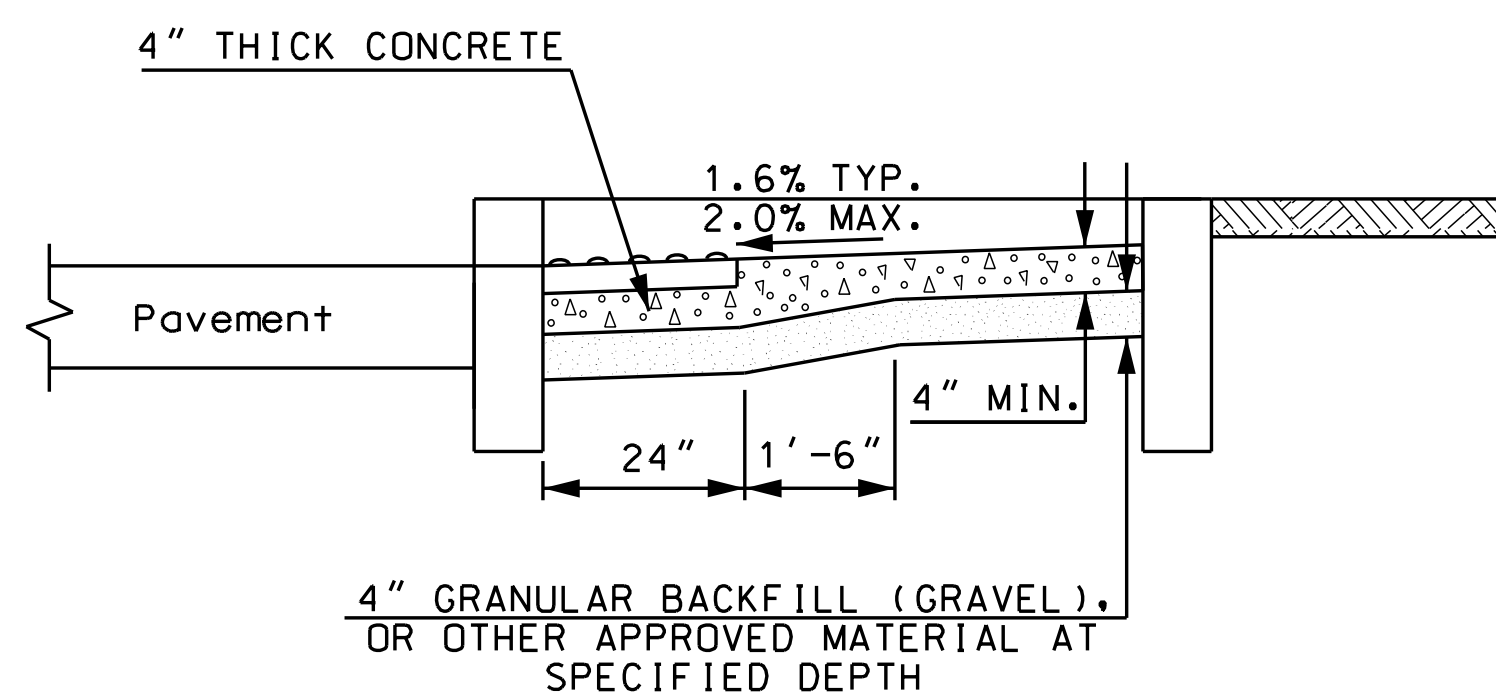

SECTION B-B

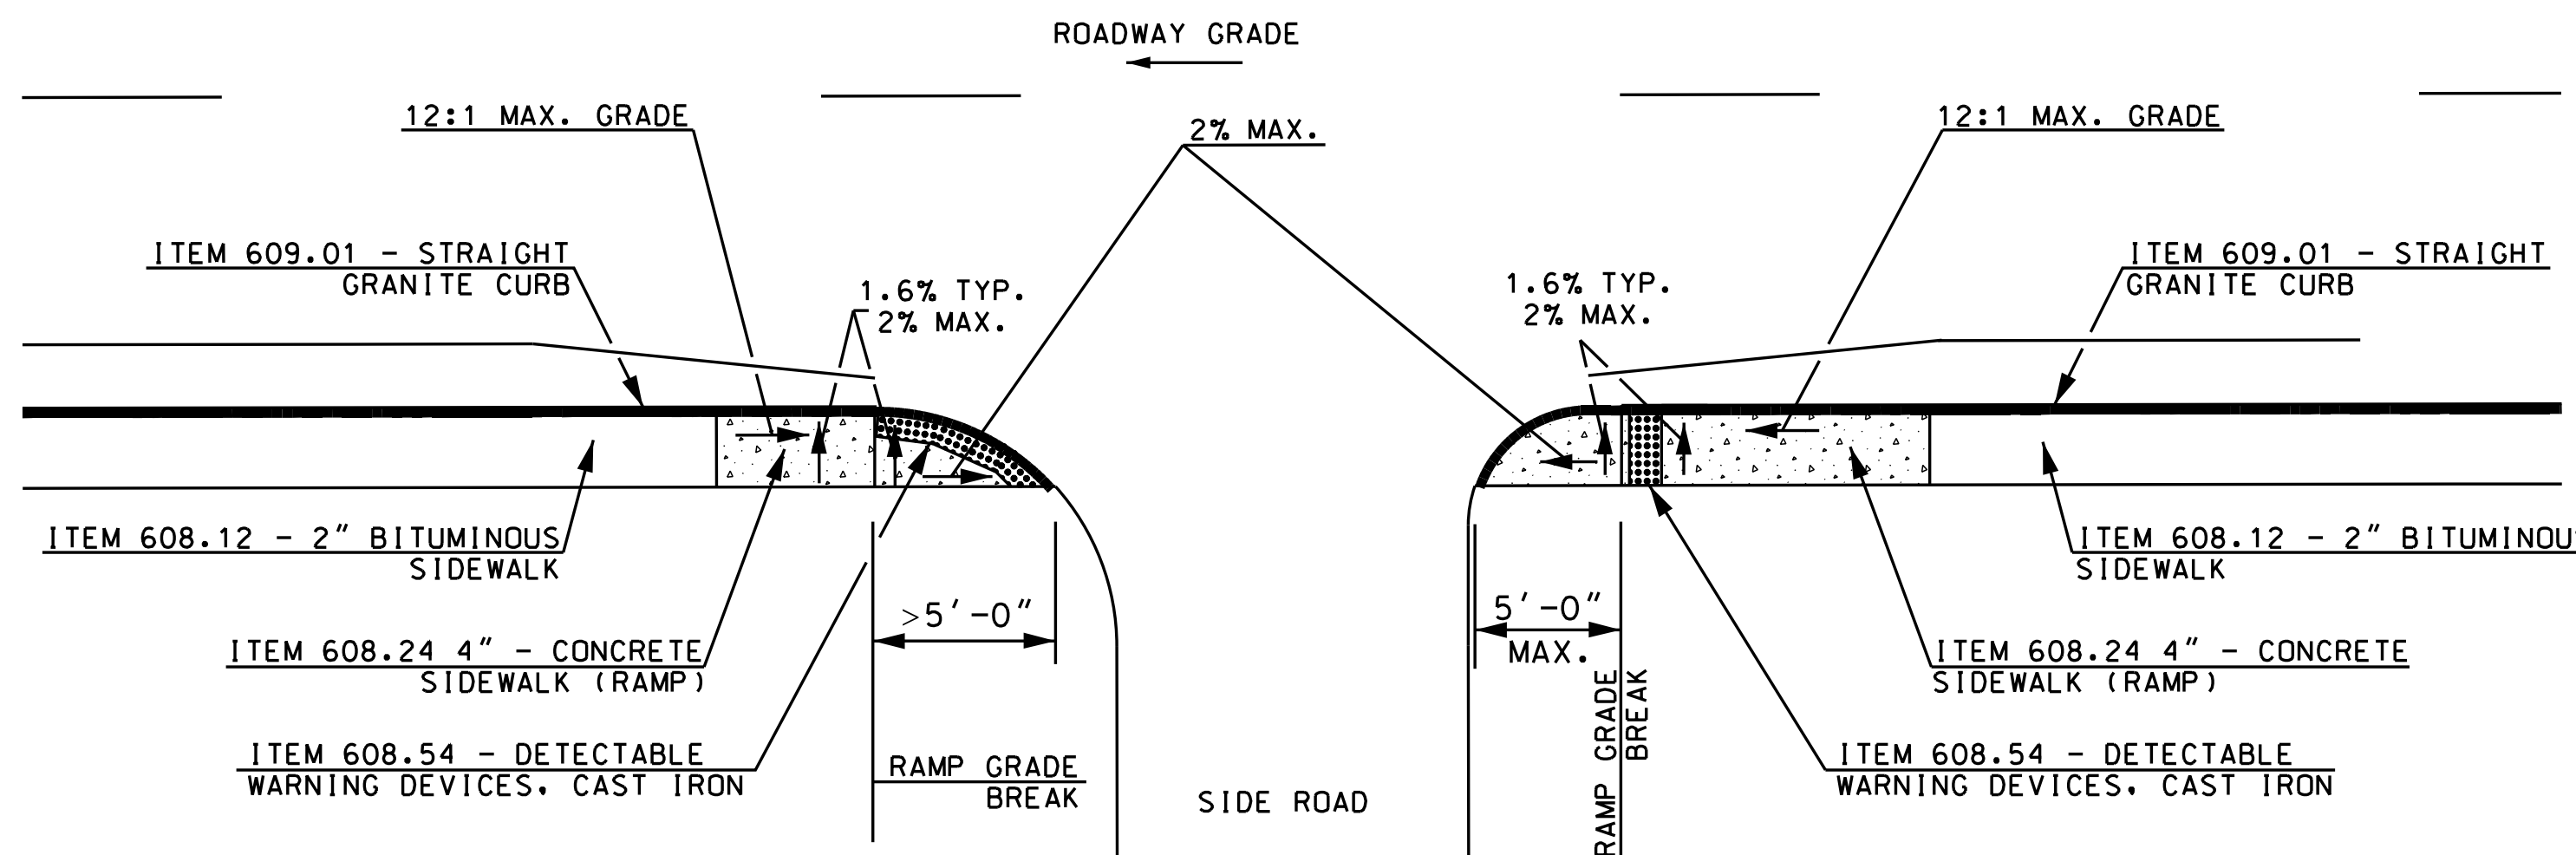

PERPENDICULAR RAMP WITH GRASS PANEL
* LENGTH OF RAMP VARIES WITH SLOPE & WIDTH OF GRASS PANEL

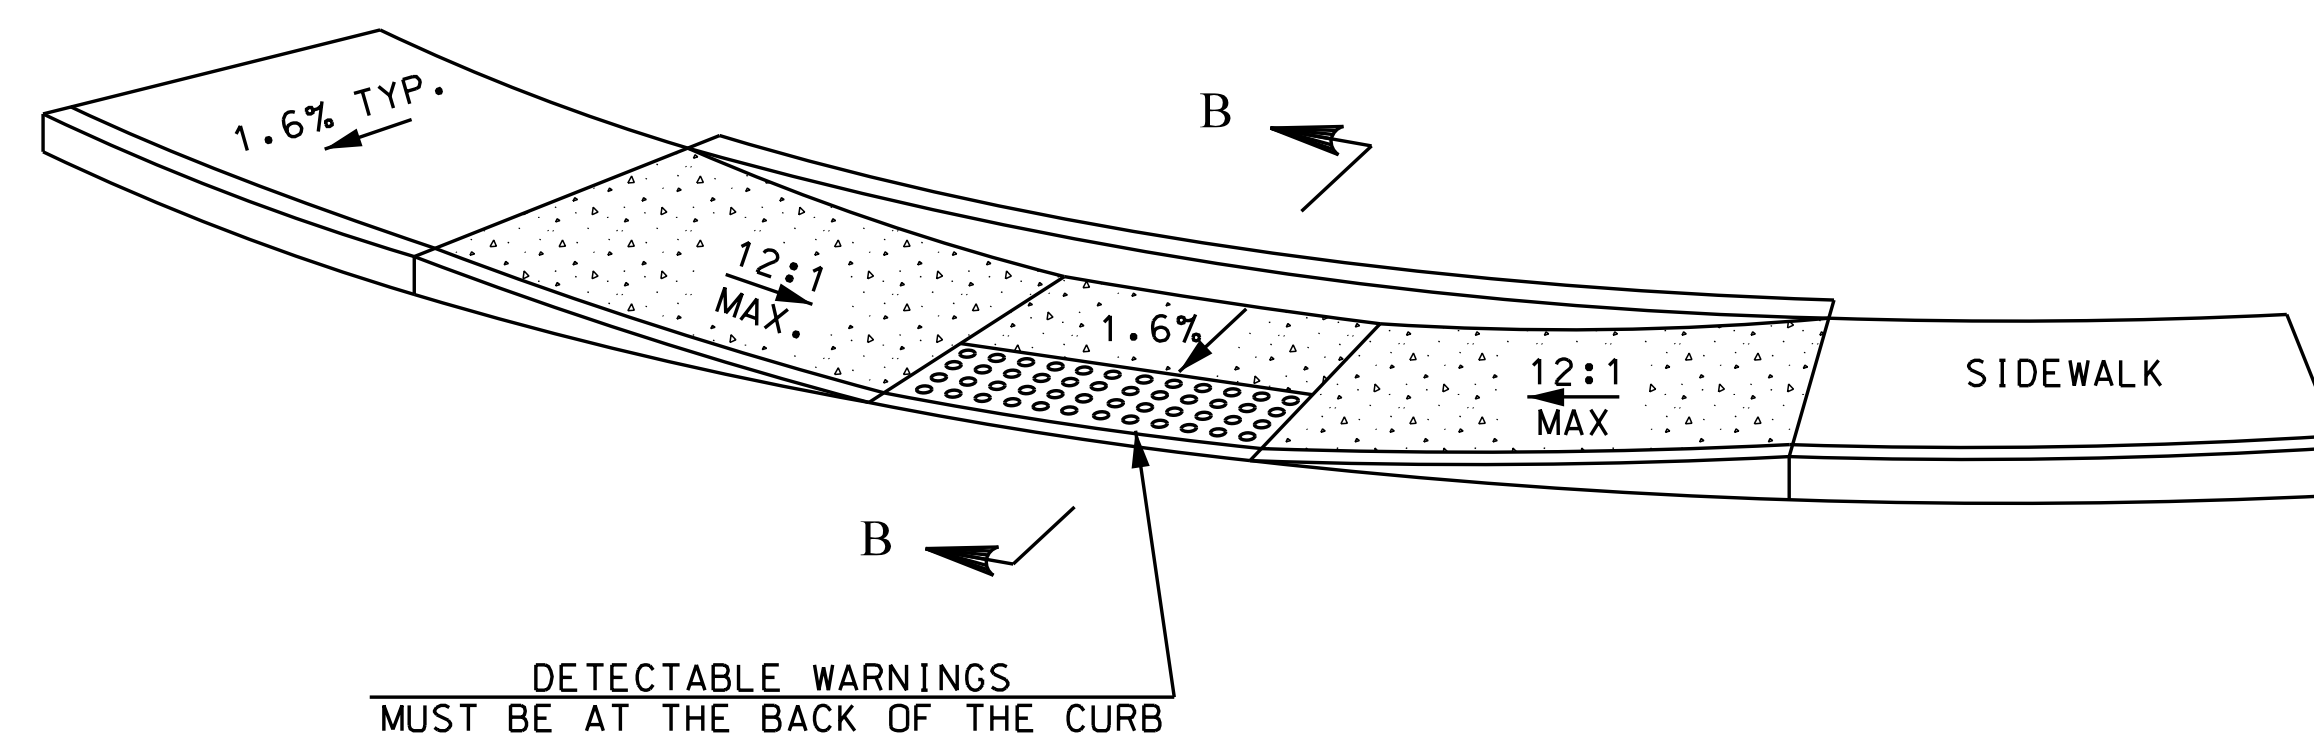

PARALLEL CURB RAMP DETAIL

TRANSITION RAMPS:

BLENDED TRANSITIONS HAVE A RUNNING SLOPE GREATER THAN 2% BUT LESS THAN 5%. CURB RAMPS HAVE A RUNNING SLOPE OF 5% MIN. TO 8.33% MAX. SIDEWALK, BLENDED TRANSITIONS, AND CURB RAMPS HAVE A MAX. CROSS SLOPE OF 2%.

ALL GRADE BREAKS BETWEEN LANDINGS, RAMPS, AND BLENDED TRANSITIONS SHALL BE PERPENDICULAR TO THE DIRECTION OF TRAVEL.

IF IT IS NECESSARY TO USE SIDEWALK WIDTHS 5'-0" OR LESS, PROVIDE A WIDENED AREA A MINIMUM OF 5'-0" WIDE BY 5'-0" LONG SPACED AT INTERVALS OF 200' MAXIMUM TO ALLOW FOR USERS TO PASS EACH OTHER.

PROVIDE DETECTABLE WARNING SURFACES ANYTIME THAT A CURB RAMP, BLENDED TRANSITION, OR LANDING CONNECTS TO A STREET. PLACEMENT FOR DETECTABLE WARNING SURFACES ARE AS FOLLOWS:

PERPENDICULAR CURB RAMPS:


WHERE BOTH ENDS OF THE BOTTOM GRADE ARE LESS THAN 5'-0" FROM THE BACK OF THE CURB, LOCATE THE DETECTABLE WARNING PANELS ON THE RAMP SURFACE AT THE BOTTOM OF THE RAMP. WHERE EITHER END OF THE BOTTOM GRADE IS GREATER THAN 5'-0" FROM THE BACK OF THE CURB, LOCATE THE DETECTABLE WARNINGS AT THE BOTTOM OF THE LANDING.

PARALLEL CURB RAMPS:

LOCATE THE DETECTABLE WARNING SURFACES AT THE BACK OF THE CURB ALONG THE EDGE OF THE LANDING.

FOR BLENDED TRANSITIONS AND LANDINGS:

LOCATE THE DETECTABLE WARNING SURFACES AT THE BACK OF THE CURB.

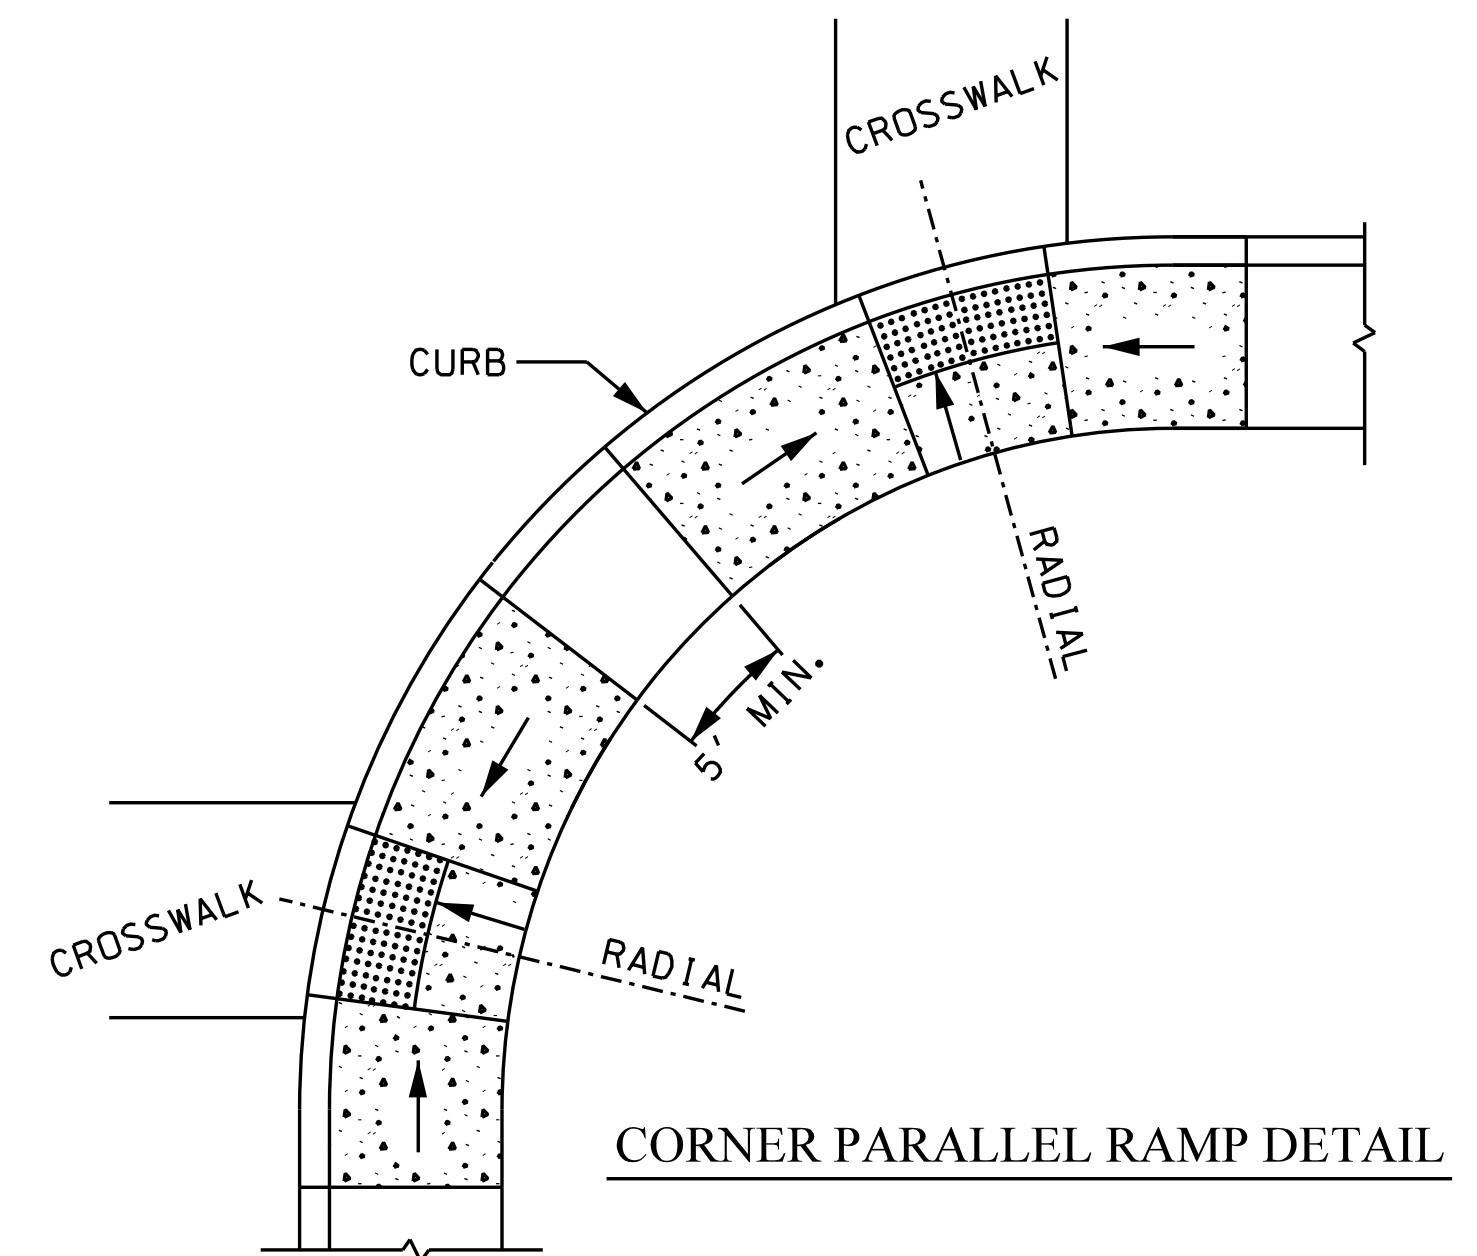



CORNER PARALLEL RAMP DETAIL

THE ORDER OF PREFERENCE FOR LOCATION OF CORNER RAMPS:

1. TWO SEPARATE RAMPS LOCATED ON TANGENT SIDEWALK AREA IMMEDIATELY OUTSIDE OF CORNER RADIUS.
2. TWO SEPARATE RAMPS SEPARATED BY 5' MINIMUM AS SHOWN ABOVE.
3. SINGLE RAMP SERVING TWO CROSSWALKS.


GENERAL NOTES

1. THE MAXIMUM RUNNING SLOPE OF ANY SIDEWALK CURB RAMP IS 12:1, THE MAXIMUM CROSS SLOPE IS 2%. THE SLOPE OF THE LANDING SHALL NOT EXCEED 2% IN ANY DIRECTION.
RAMP RUNNING SLOPE EXCEPTION: A GREATER THAN 8.33% RAMP RUNNING GRADE IS ALLOWED WHERE THE ROADWAY AND THE SIDEWALK(S) ARE PARALLEL AND VERY CLOSE TOGETHER, WITH THE SAME GRADE, AND USING A GRADE OF 8.33% WOULD RESULT IN A RAMP LENGTH LONGER THAN 15'. IN THOSE CIRCUMSTANCES USE A MAXIMUM RAMP LENGTH OF 15' AND THE ALLOWABLE RUNNING SLOPE OF THE RAMP(S) IS GREATER THAN 8.33%.
2. TRANSITIONS SHALL BE FLUSH AND FREE OF ABRUPT CHANGES. ROADWAY SHOULDER SLOPES ADJOINING SIDEWALK CURB RAMPS SHALL BE A MAXIMUM OF 5% (FULL WIDTH) FOR A DISTANCE OF 2 FT. FROM THE ROADWAY CURBLINE.
3. INTERCEPT DRAINAGE ALONG THE CURB IN ADVANCE OF SIDEWALK CURB RAMPS OR LANDINGS. CATCH BASINS, MANHOLES, ETC. SHALL NOT BE LOCATED IN, OR AT THE BASE OF, SIDEWALK CURB RAMPS OR LANDINGS.
4. THE BOTTOM OF THE SIDEWALK CURB RAMP OR LANDING, EXCLUSIVE OF THE FLARED SIDES, SHALL BE WHOLLY CONTAINED WITHIN THE CROSSWALK MARKINGS.
5. THE SURFACE OF A PERPENDICULAR SIDEWALK CURB RAMP OR THE LANDING OF A PARALLEL SIDEWALK CURB RAMP SHALL CONTRAST VISUALLY WITH THE ADJOINING SIDEWALK SURFACE, EITHER ASPHALT/LIGHT-COLORED CONCRETE OR LIGHT-COLORED CONCRETE/DARK-STAINED CONCRETE. THE CONCRETE SURFACE SHALL BE SLIP RESISTANT.
6. DETECTABLE WARNING PANELS SHALL BE THE FULL WIDTH OF THE LANDING, BLENDED TRANSITION, OR CURB RAMP THEY ARE A PART OF AND SHALL BE A MINIMUM OF 2 FEET IN DEPTH. THE ROWS OF TRUNCATED DOMES SHALL BE ALIGNED PERPENDICULAR TO THE GRADE BREAK BETWEEN THE RAMP, BLENDED TRANSITION, OR LANDING AND THE STREET.

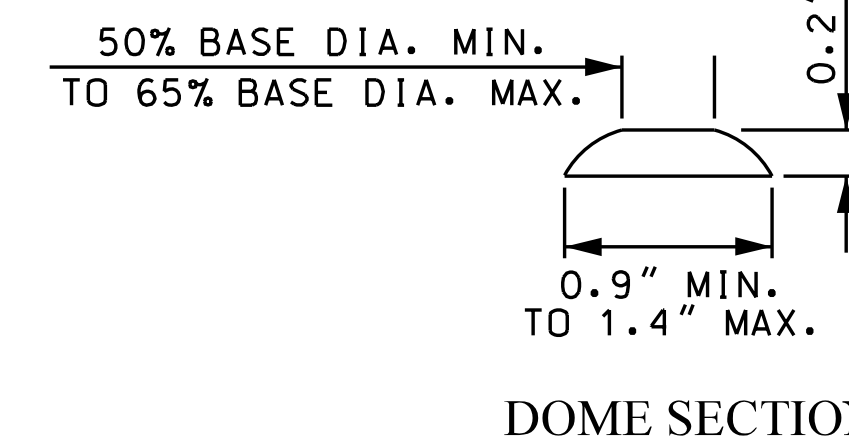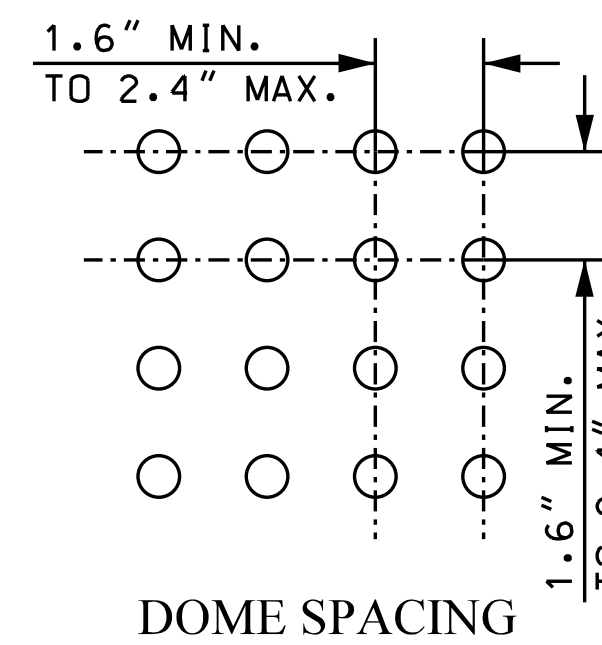


CMA ENGINEERS

STATE OF NEW HAMPSHIRE			
DEPARTMENT OF TRANSPORTATION • BUREAU OF HIGHWAY DESIGN			
SIDEWALK CURB RAMPS WITH DETECTABLE WARNINGS			
DGN	STATE PROJECT NO.	SHEET NO.	TOTAL SHEETS
		34	34

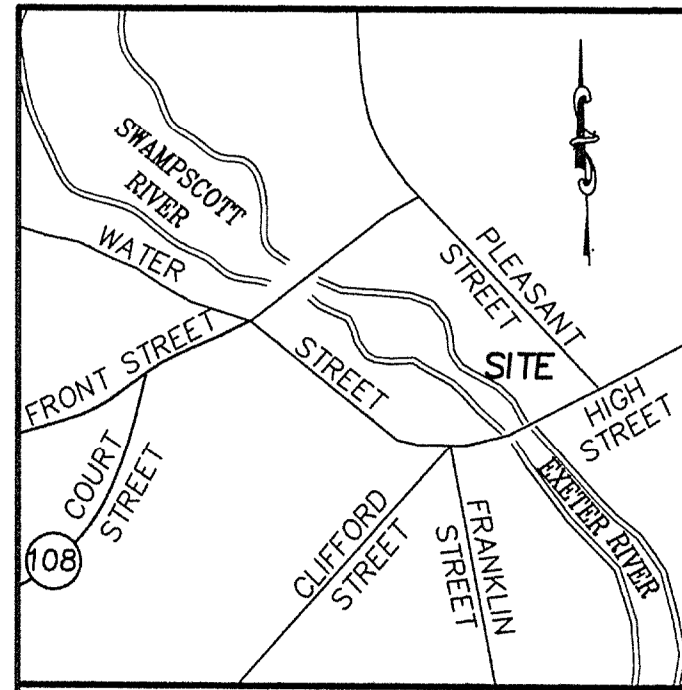


LOCUS MAP
NOT TO SCALE

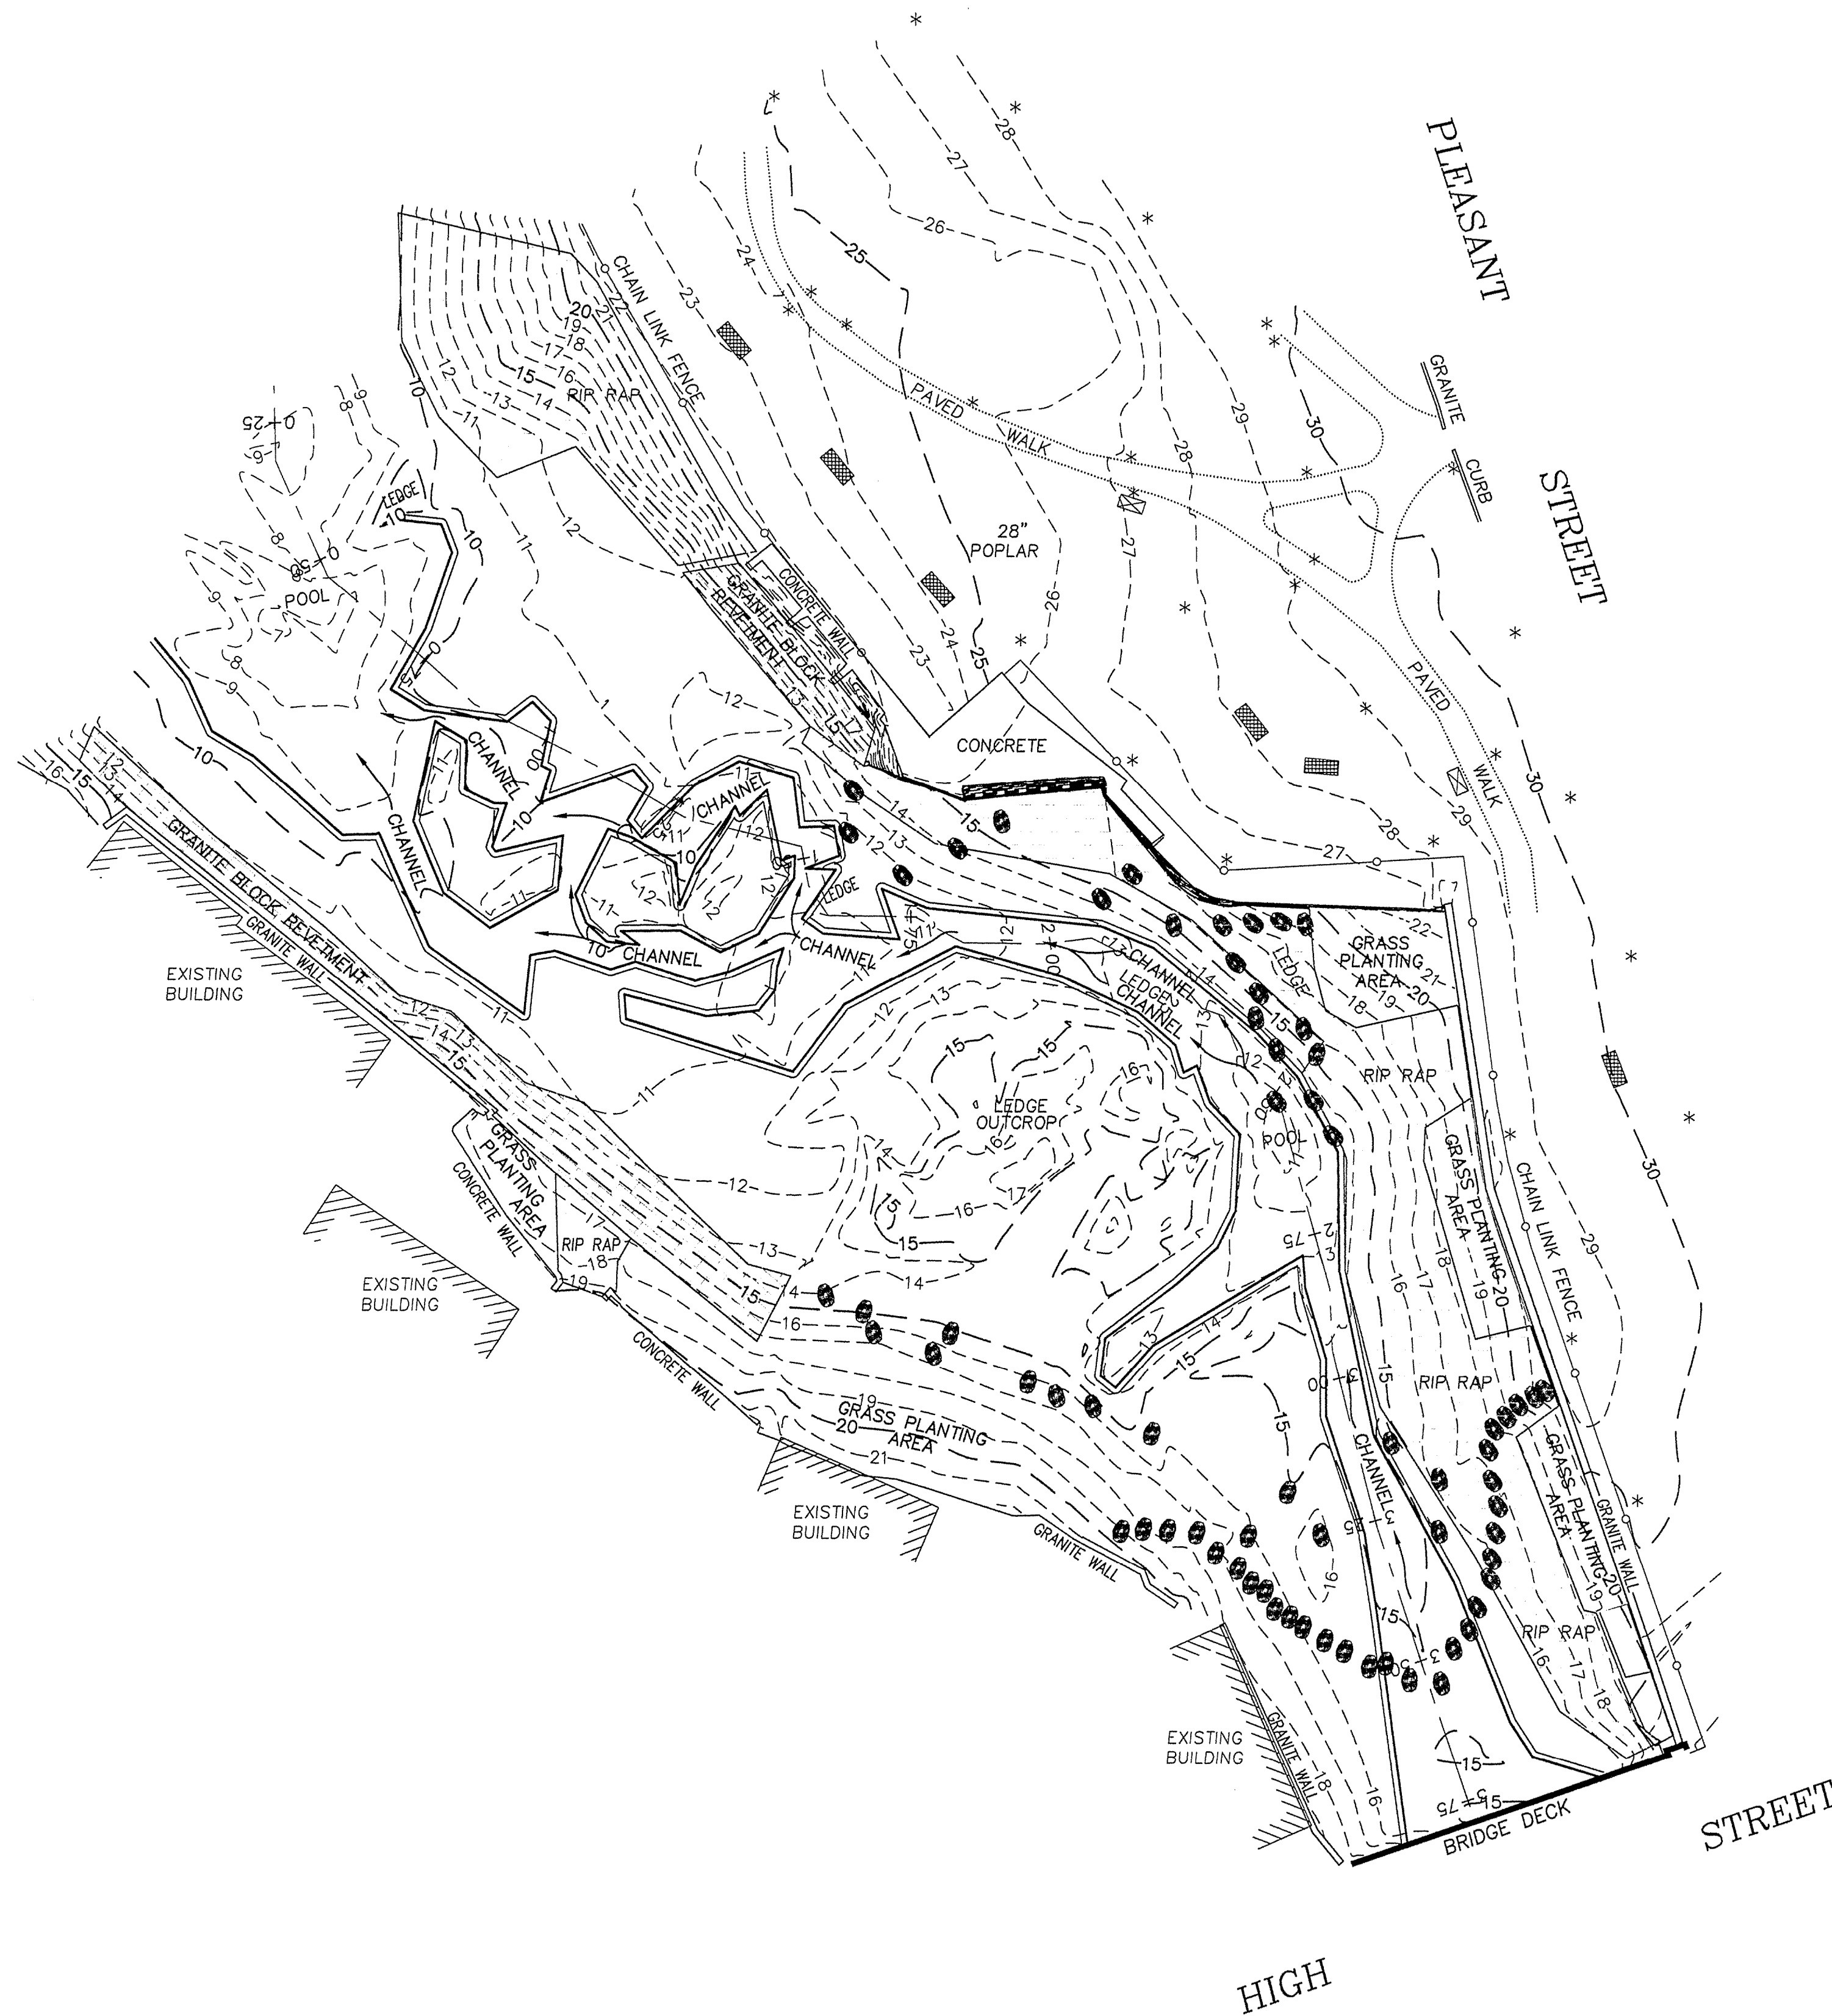

LEGEND

- PARK BENCH
- IRRIGATION CONTROL BOX
- SPRINKLER HEAD
- BOULDER
- CHAIN LINK FENCE

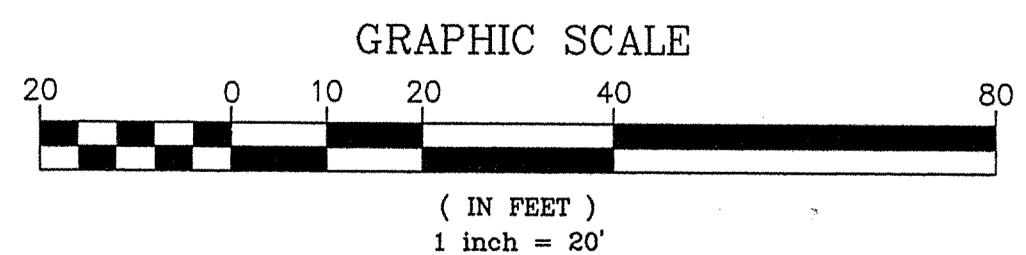


NOTES:
1) THE ELEVATIONS SHOWN HEREON ARE BASED ON NORTH AMERICAN VERTICAL DATUM OF 1988.

NEW HAMPSHIRE
GEODETIC GRID


I CERTIFY:
THAT THIS ACTUAL SURVEY WAS MADE
ON THE GROUND ON SEPTEMBER 28, 2016.

THAT THIS SURVEY CONFORMS TO THE
REQUIREMENTS FOR ACCURACY FOR
N.H. URBAN SURVEY.

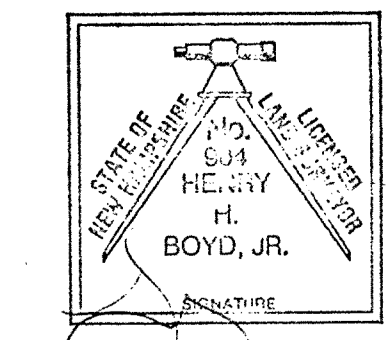


LICENSED LAND SURVEYOR DATE 10-11-2016


AS BUILT PLAN		
IN EXETER, N.H.		
SHOWING EXISTING CONDITIONS OFF OF PLEASANT STREET & HIGH STREET		
PREPARED FOR SUMCO ECO CONTRACTING 16 FRONT STREET, SUITE 209, SALEM, MA 01970		
MILLENNIUM ENGINEERING INC. ENGINEERS AND LAND SURVEYORS P.O. BOX 745 13 HAMPTON ROAD EXETER, NH 03833 PHONE:(603)778-0528 FAX:(603)772-0689 WWW.MEI-NH.COM		
SCALE: 1"=20'	DRWN. BY: P.D.B.	PROJECT: E161877
DATE: OCT. 05, 2016	CHKD. BY: H.H.B.	SHEET: 1 OF 3

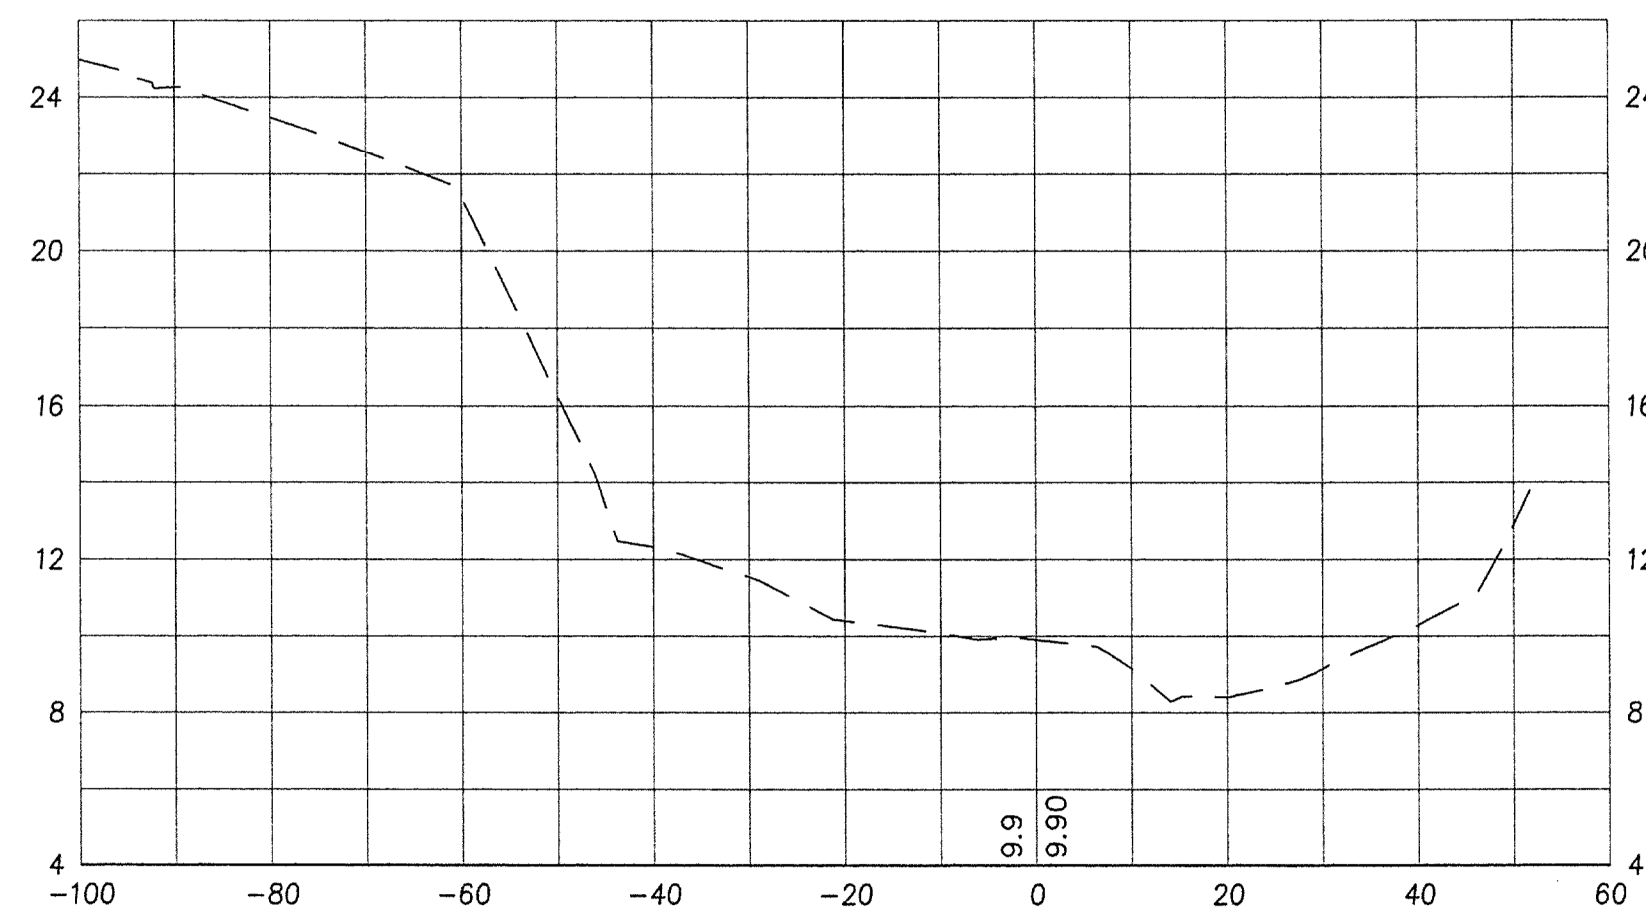


0+75

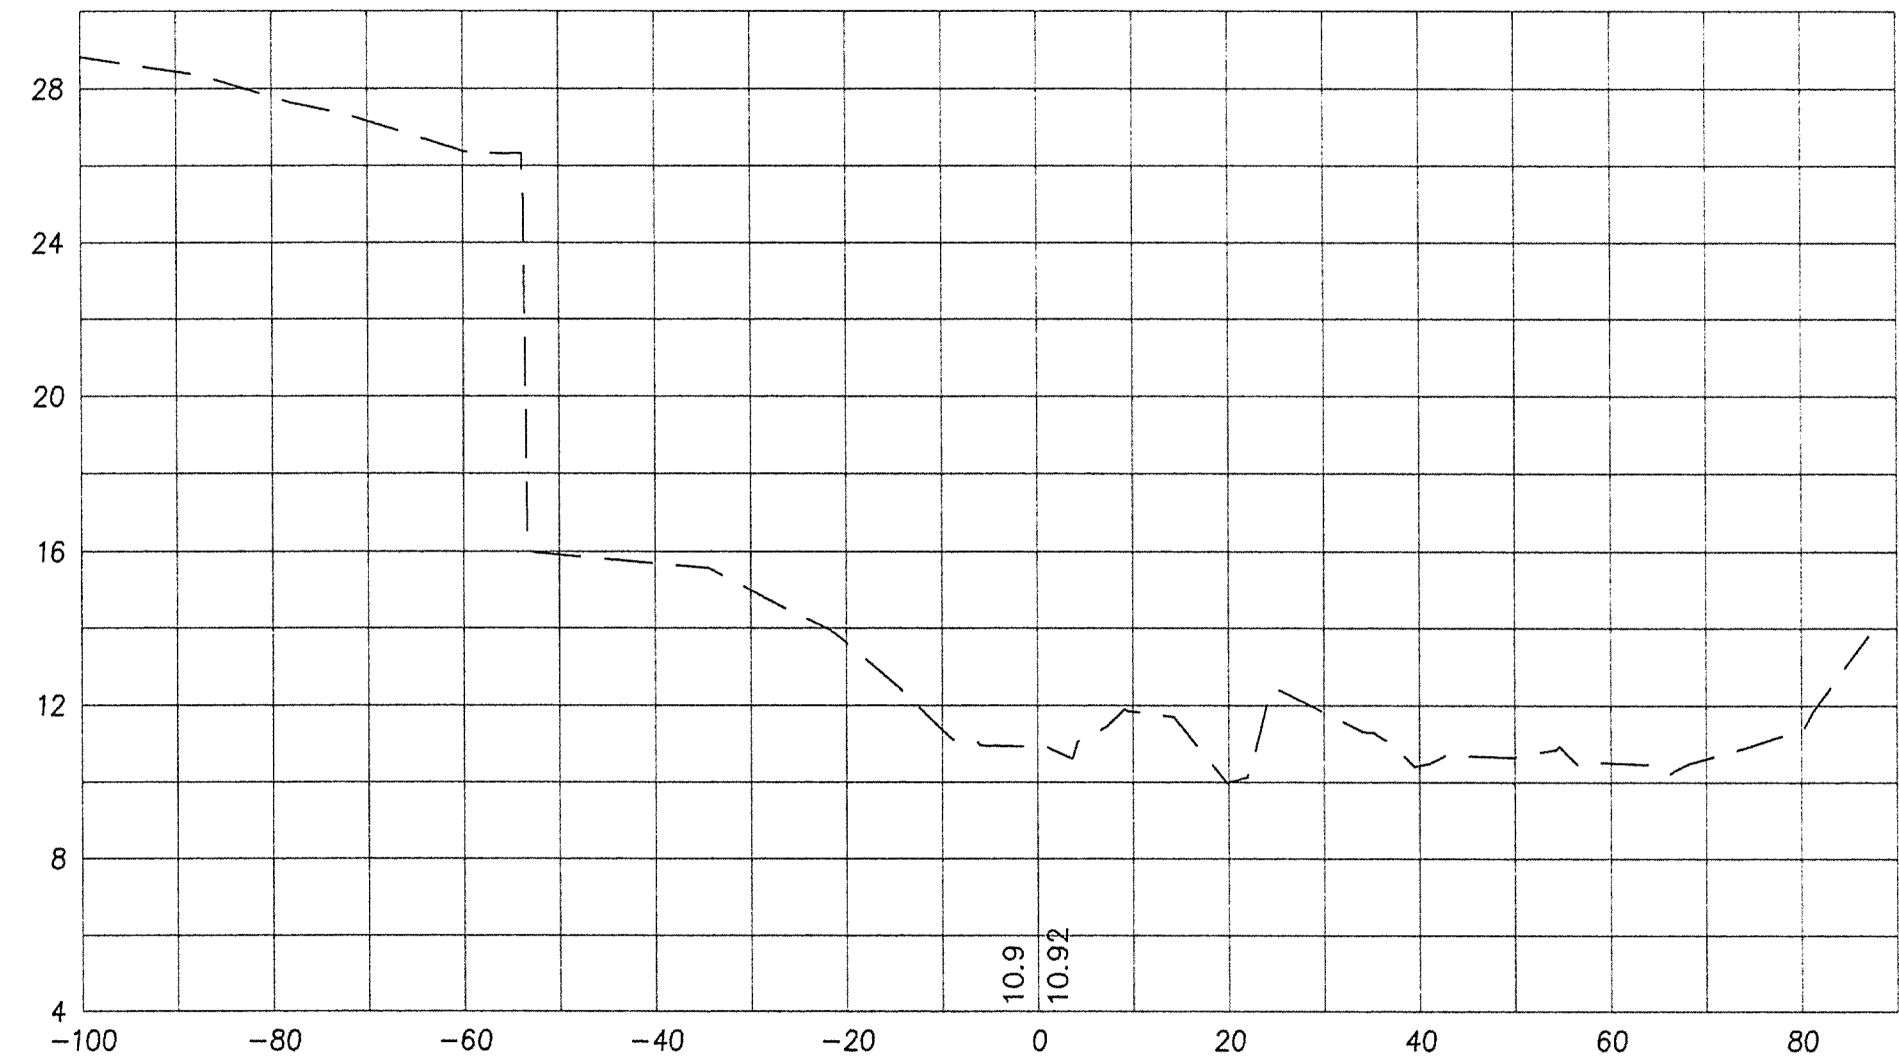


1+50

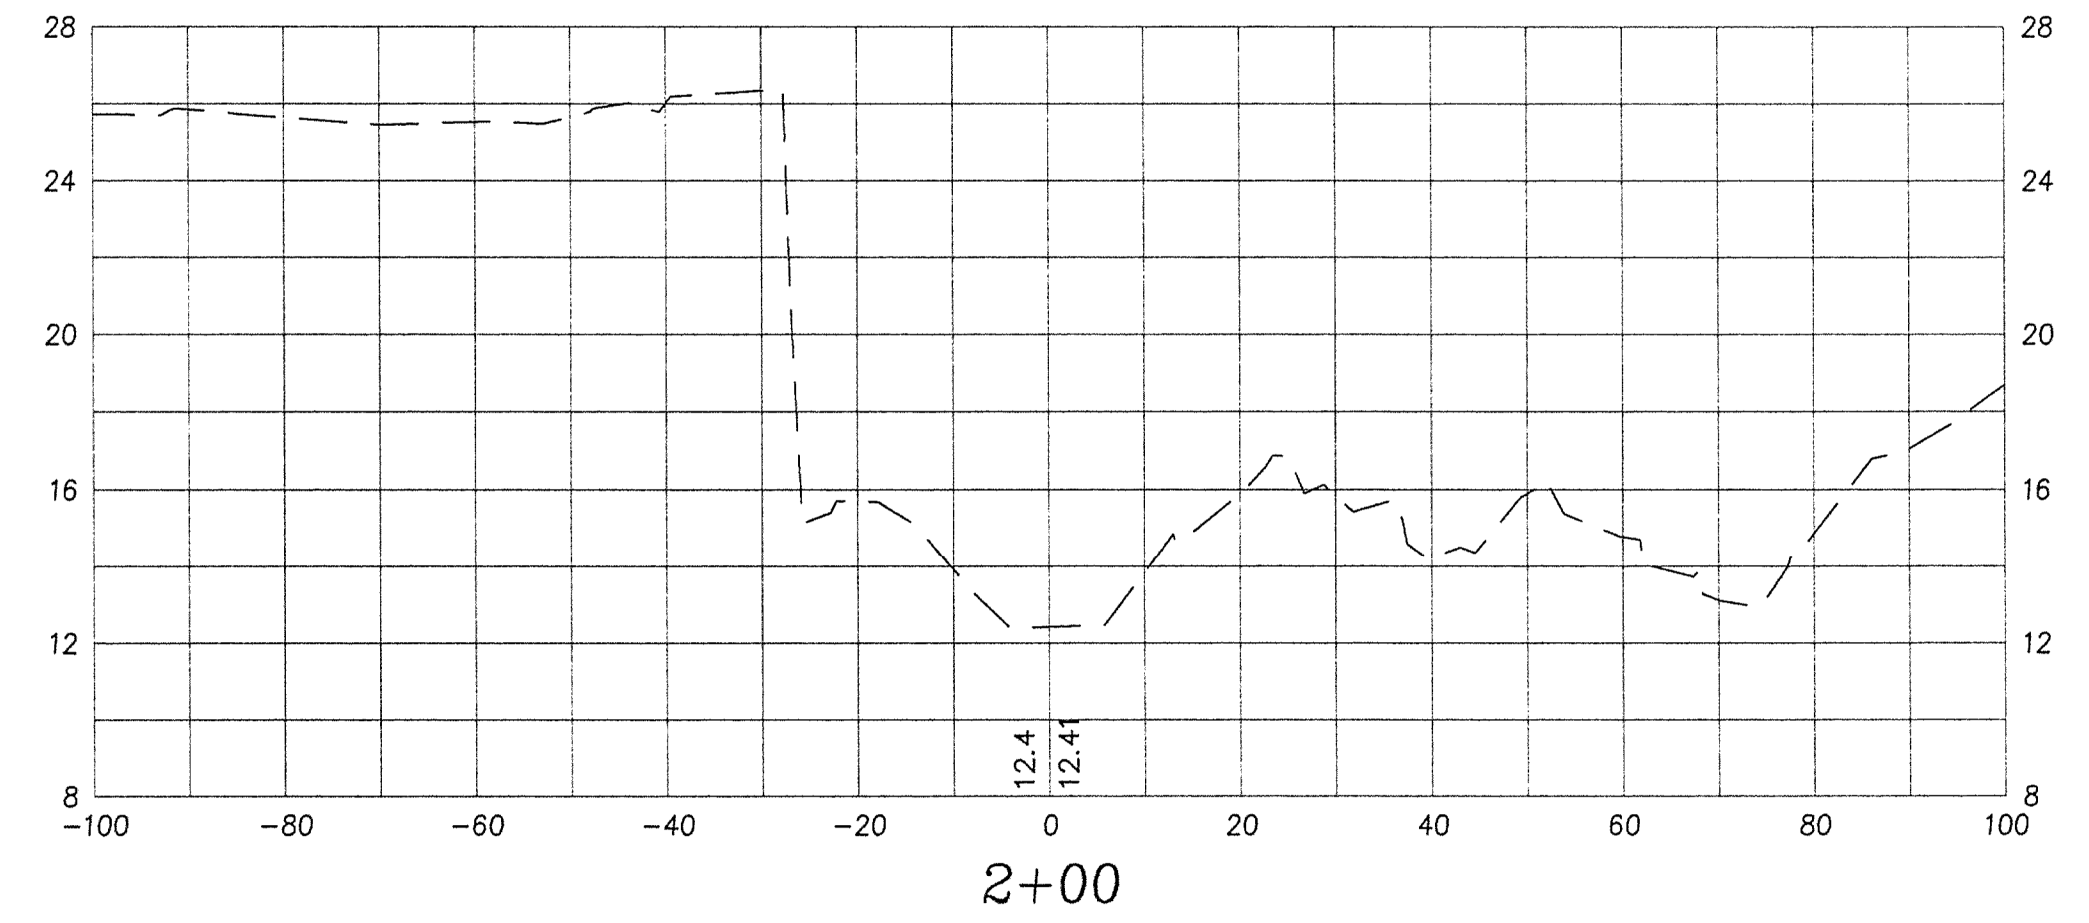


2+00

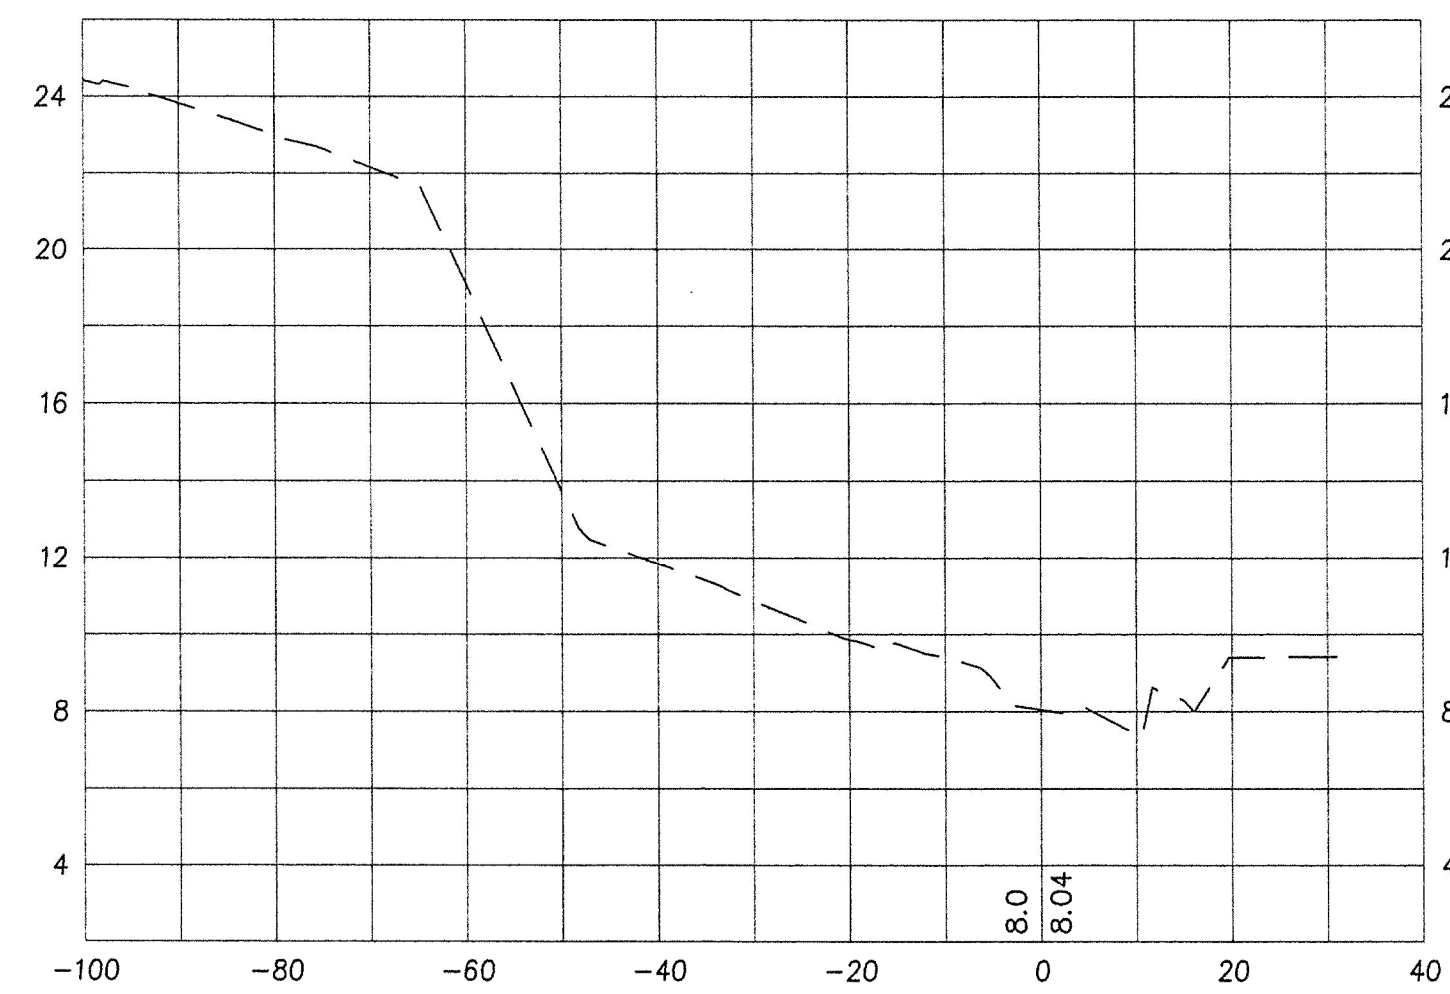



0+50

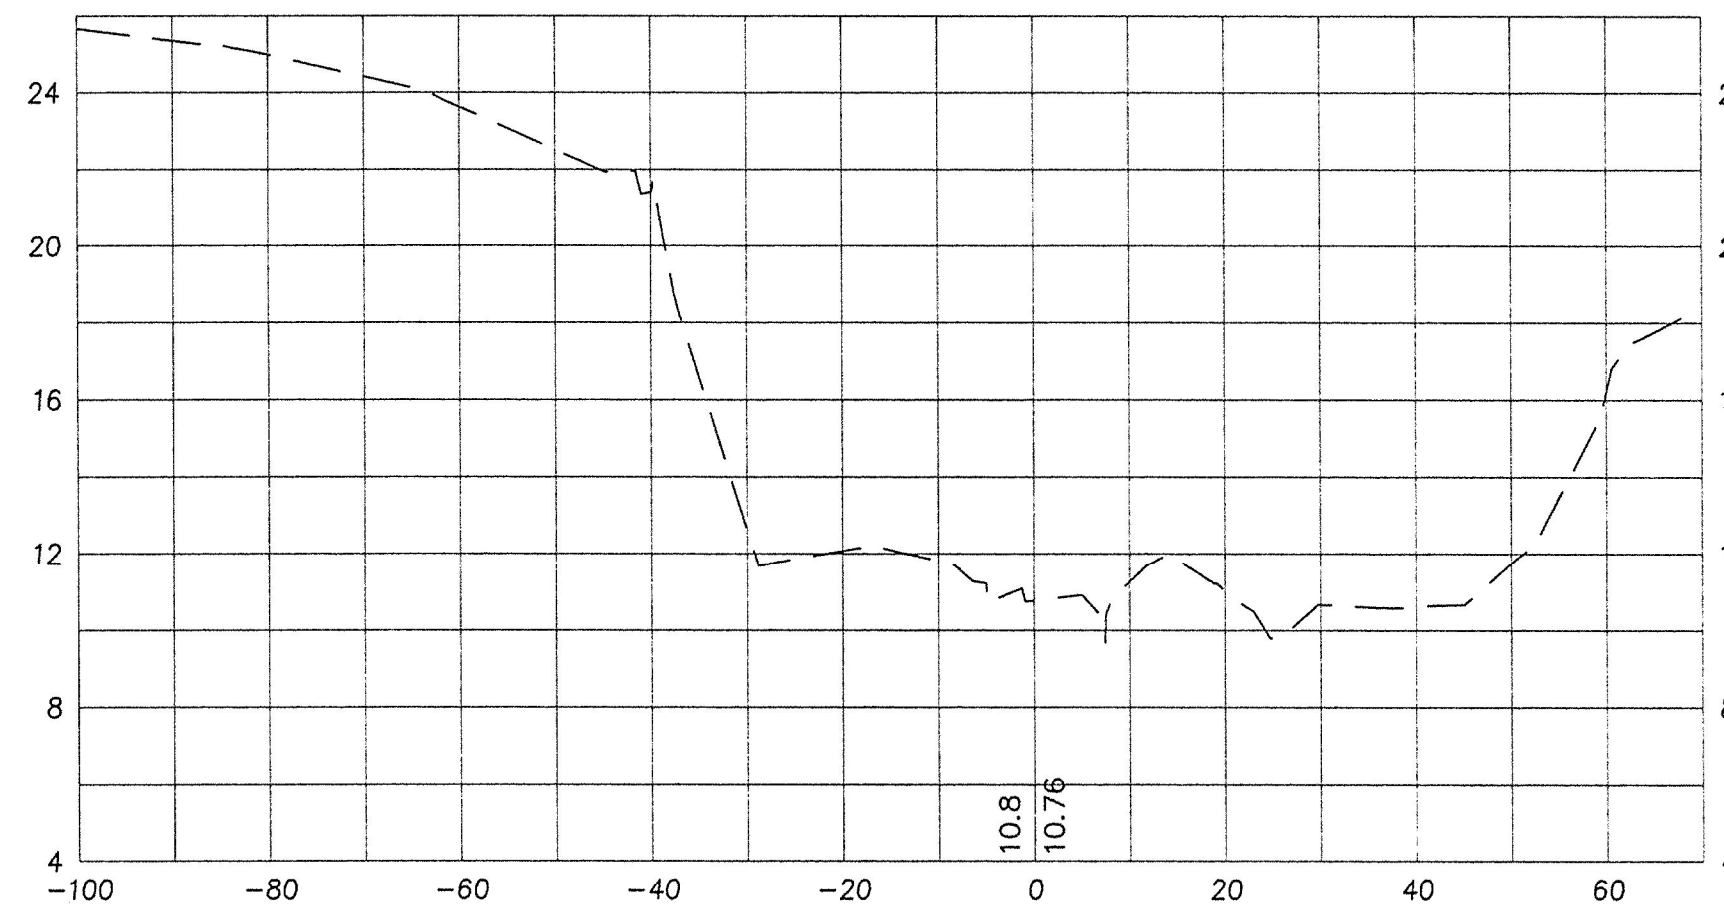


1+25

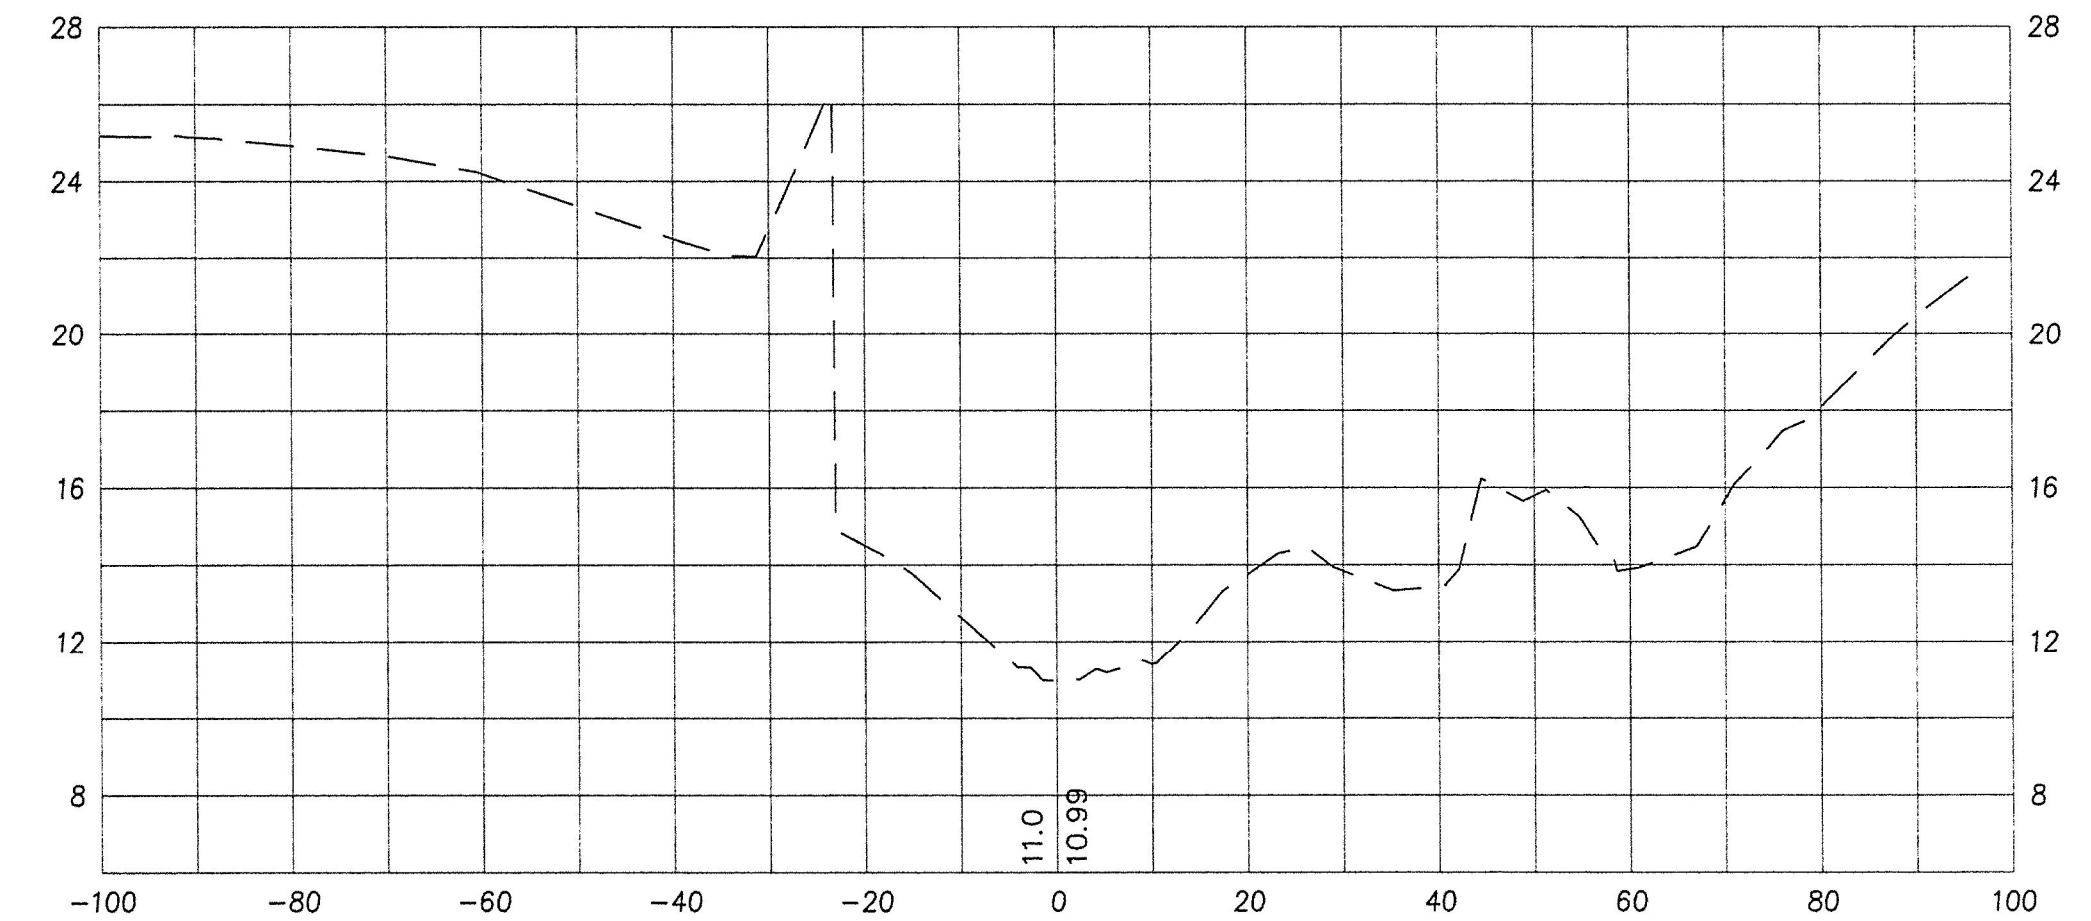

1+75

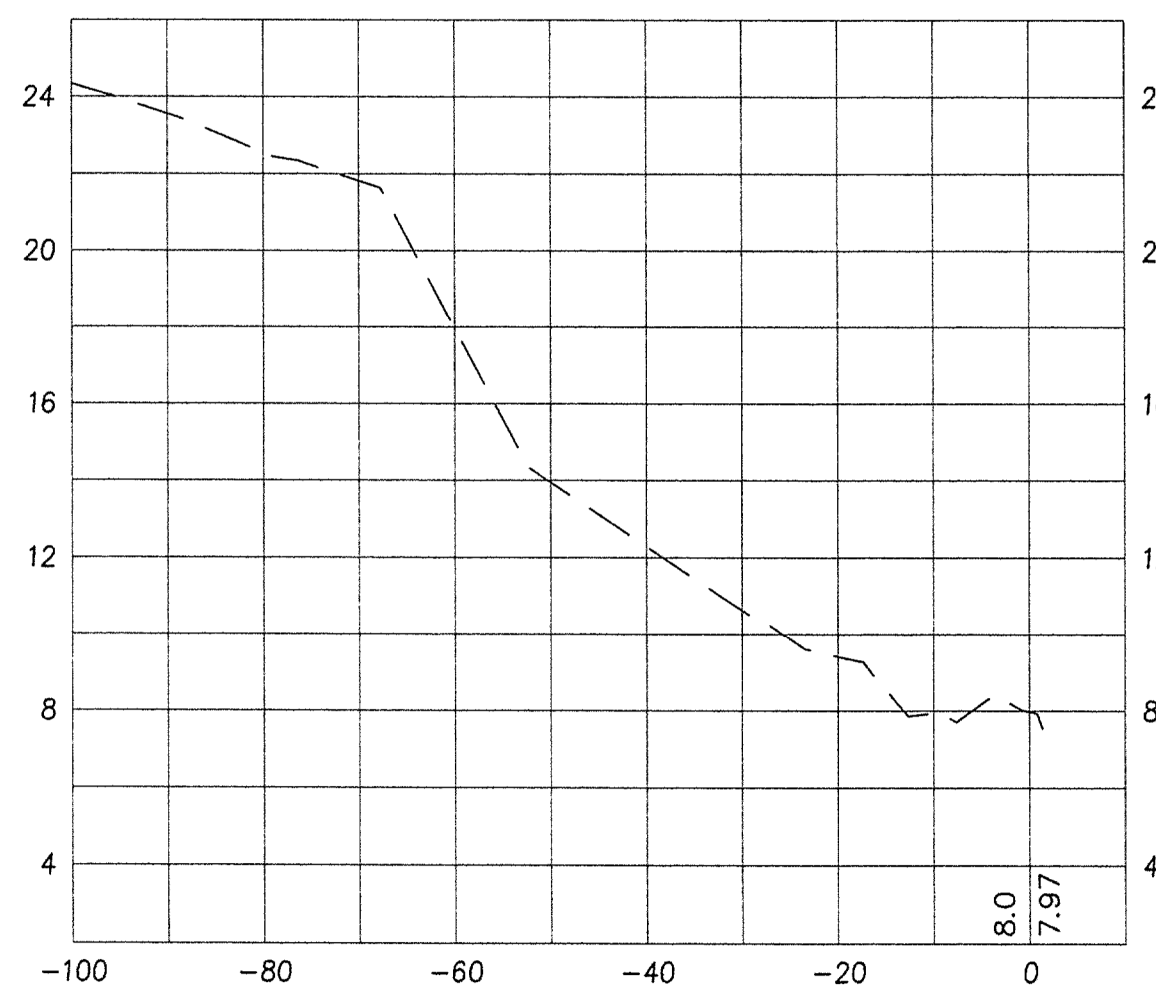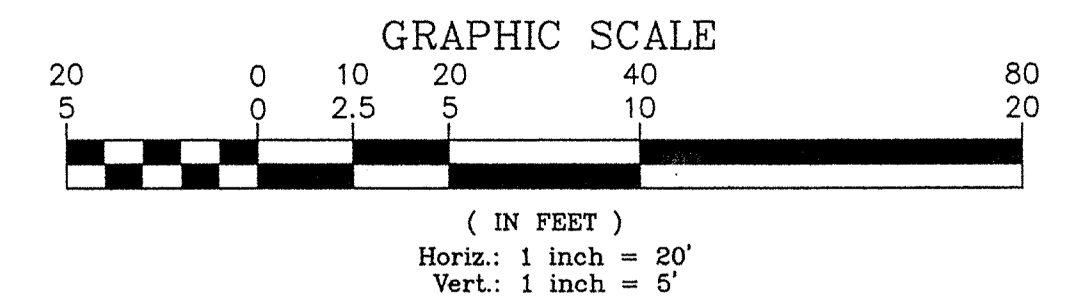


0+25

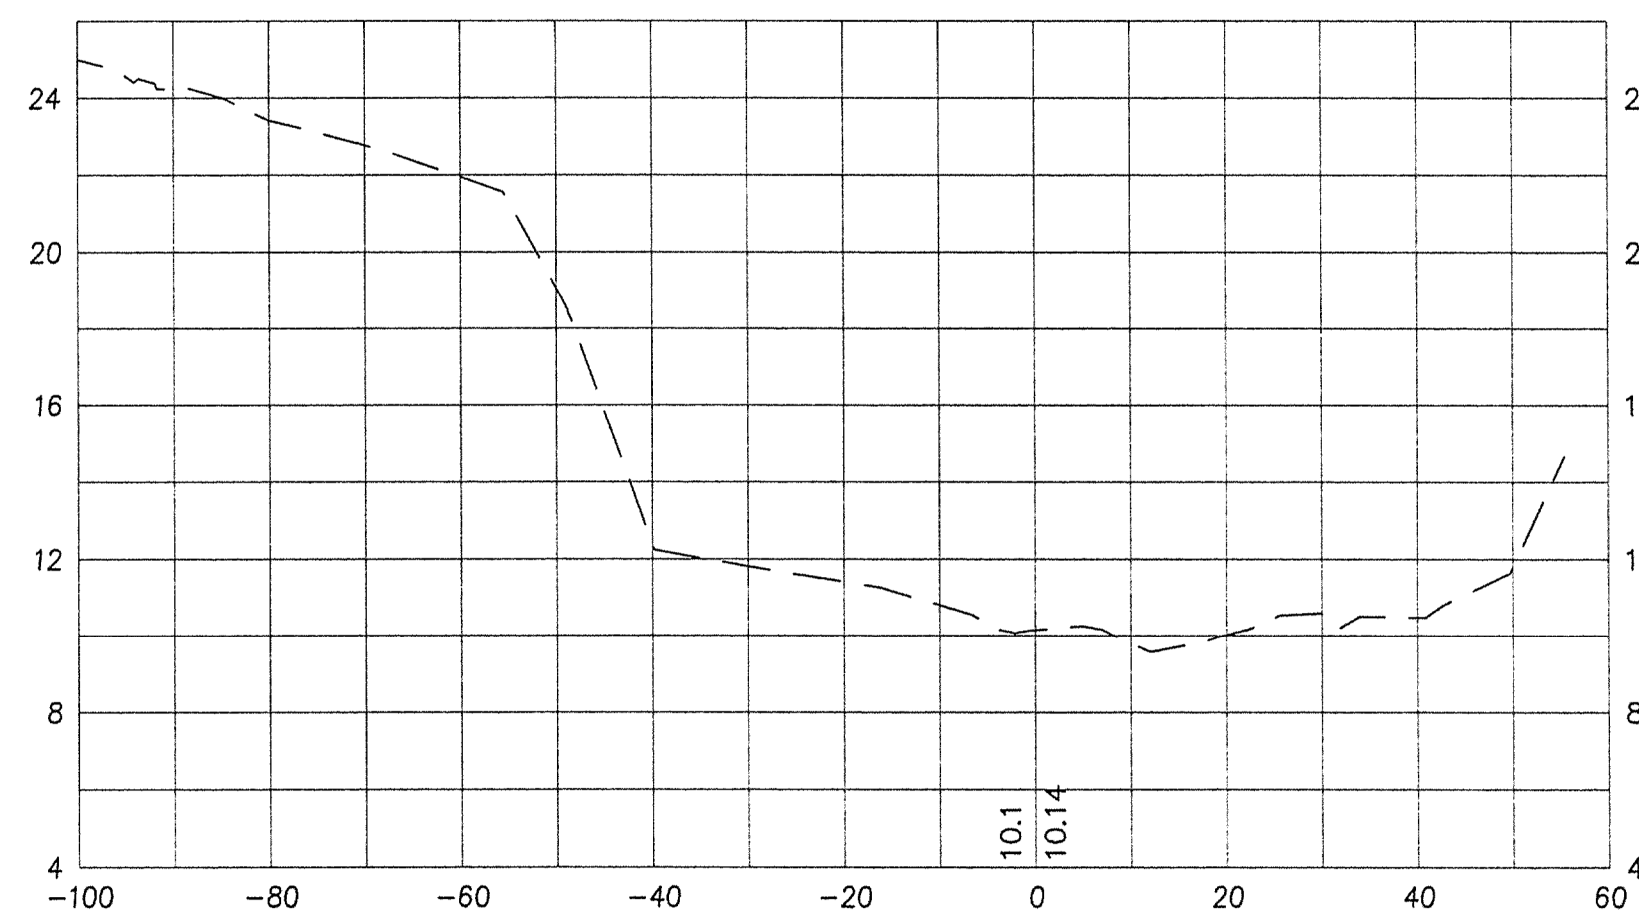

1+00

I CERTIFY:
THAT THIS ACTUAL SURVEY WAS MADE
ON THE GROUND ON SEPTEMBER 28, 2016.

THAT THIS SURVEY CONFORMS TO THE
REQUIREMENTS FOR ACCURACY FOR
N.H. URBAN SURVEY.

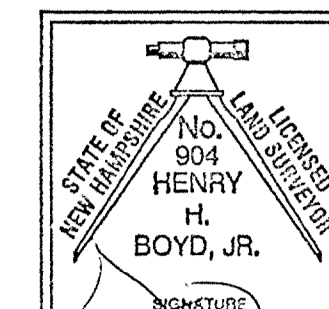

LICENSED LAND SURVEYOR DATE 10-14-2016









AS BUILT PLAN
IN
EXETER, N.H.

SHOWING
EXISTING CONDITIONS
OFF OF PLEASANT STREET & HIGH STREET

PREPARED FOR
SUMCO ECO CONTRACTING
16 FRONT STREET, SUITE 209, SALEM, MA 01970


MILLENNIUM ENGINEERING INC.
ENGINEERS AND LAND SURVEYORS
P.O. BOX 745 13 HAMPTON ROAD EXETER, NH 03833
PHONE:(603)778-0528 FAX:(603)772-0689 WWW.MEI-NH.COM

SCALE: AS NOTED	DRWN. BY: P.D.B.	PROJECT: E161877
DATE: OCT. 05, 2016	CHKD. BY: H.H.B.	SHEET: 2 OF 3

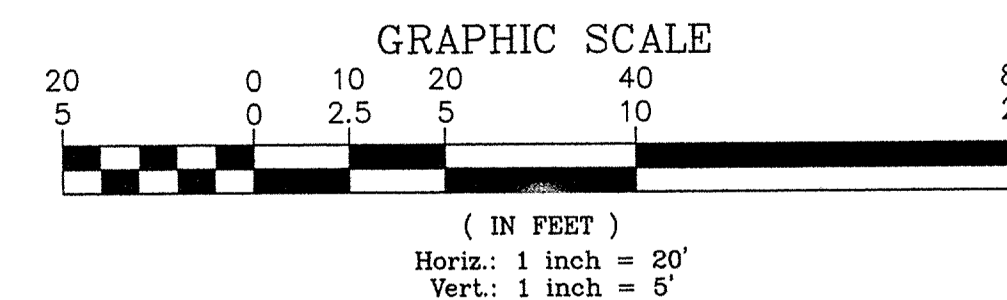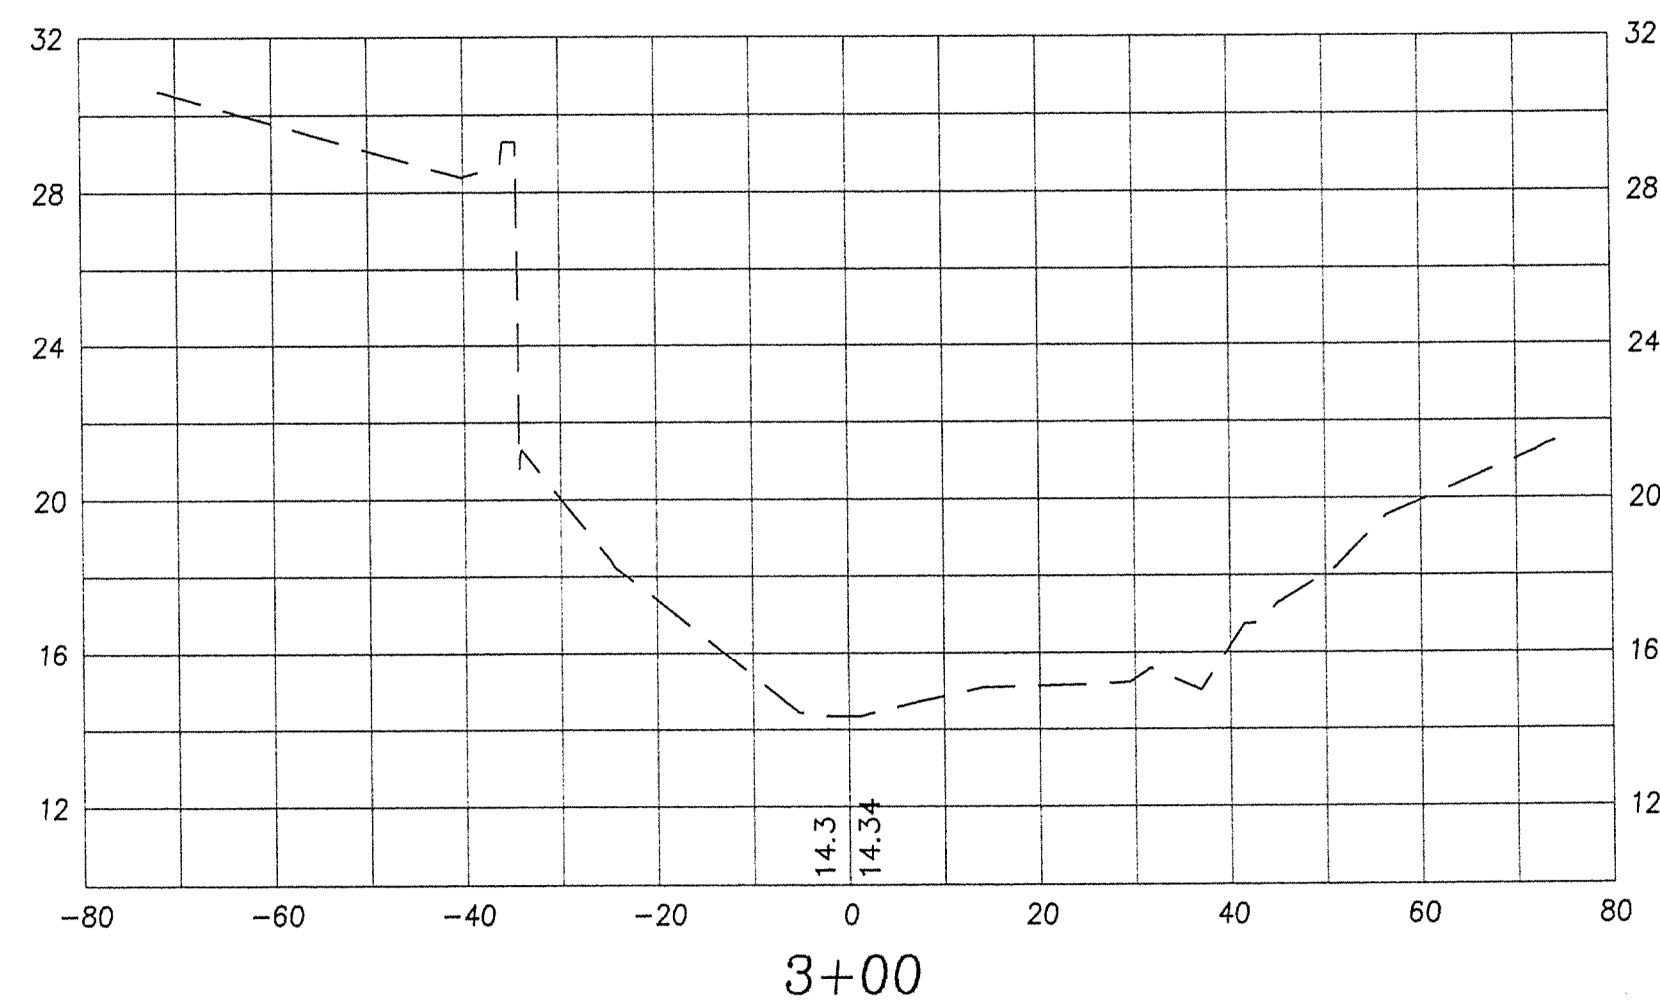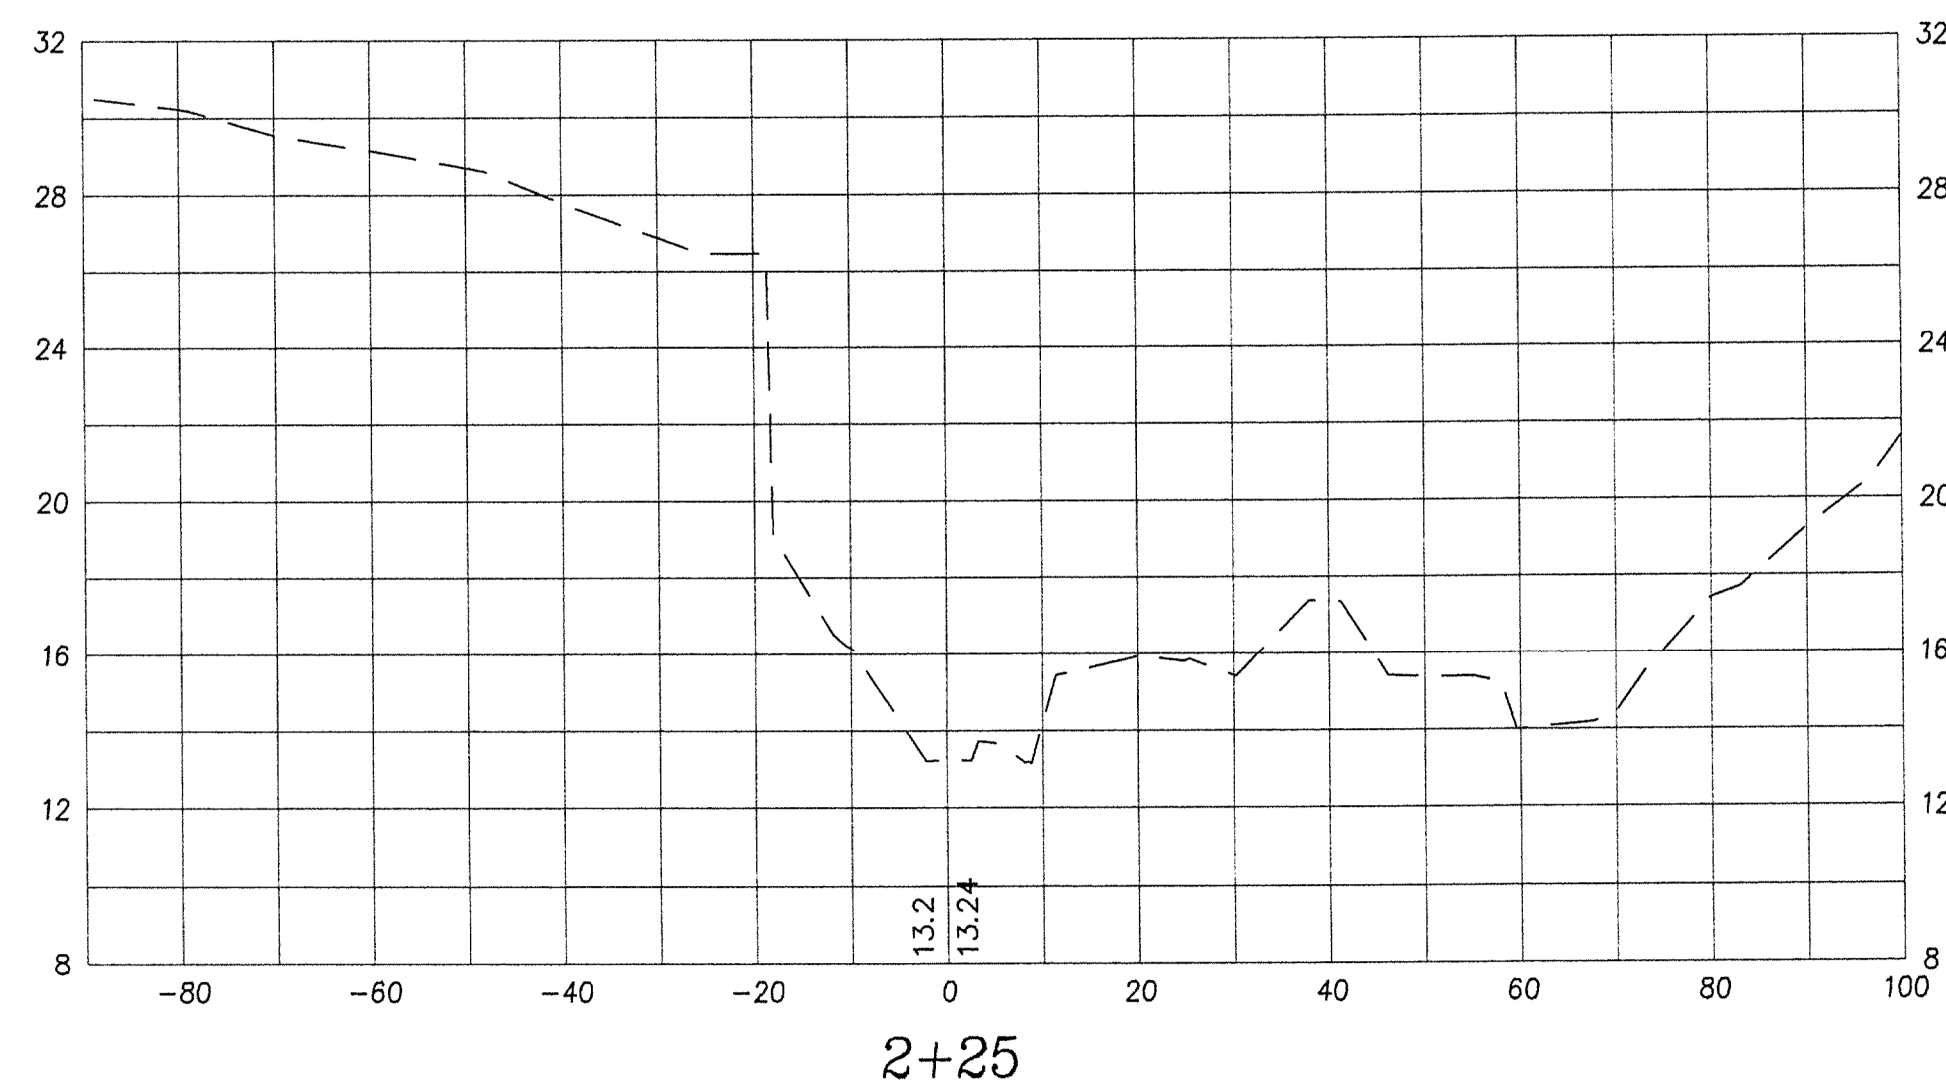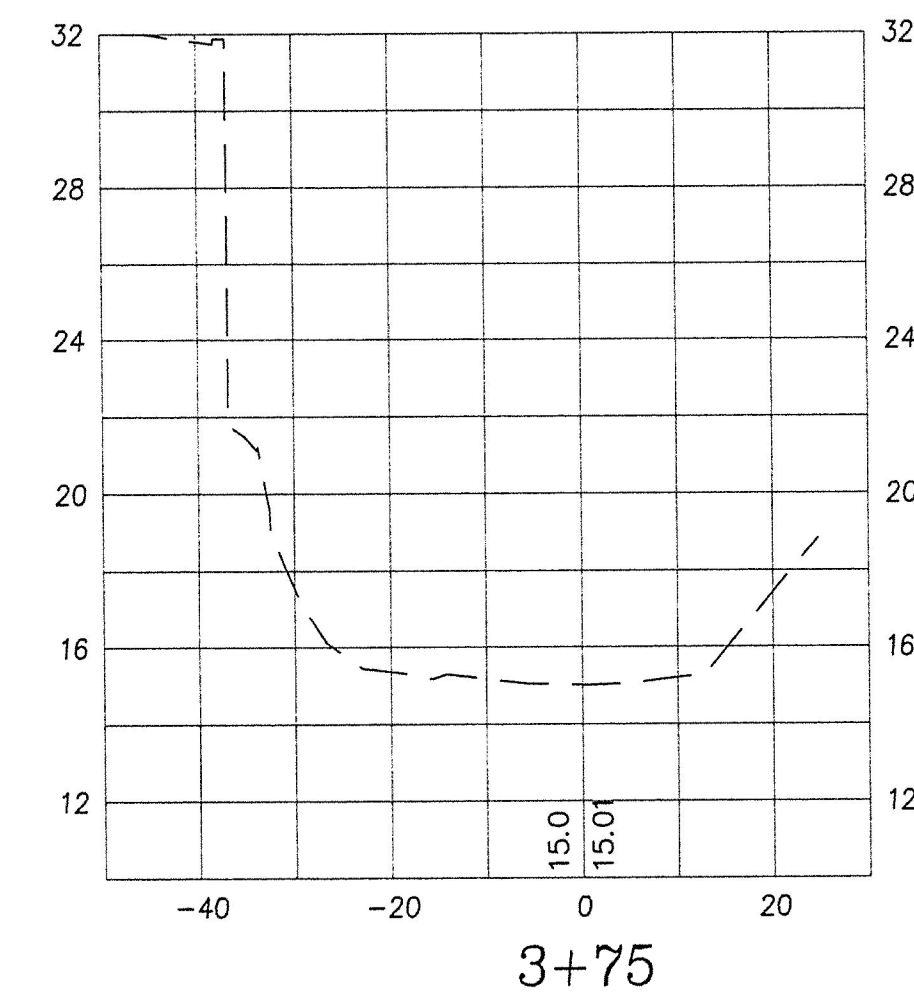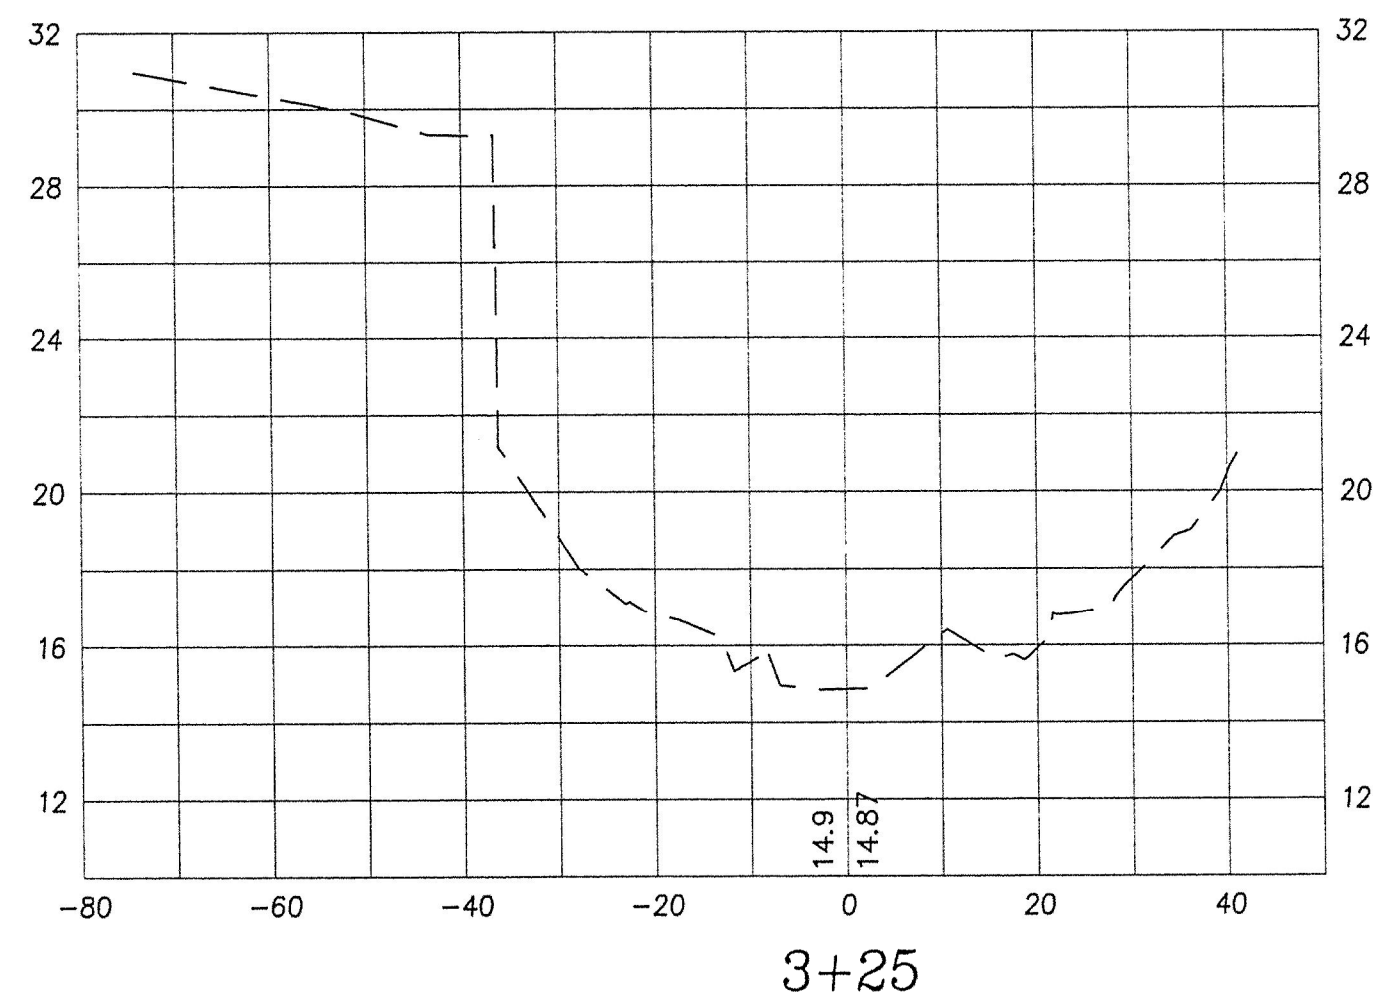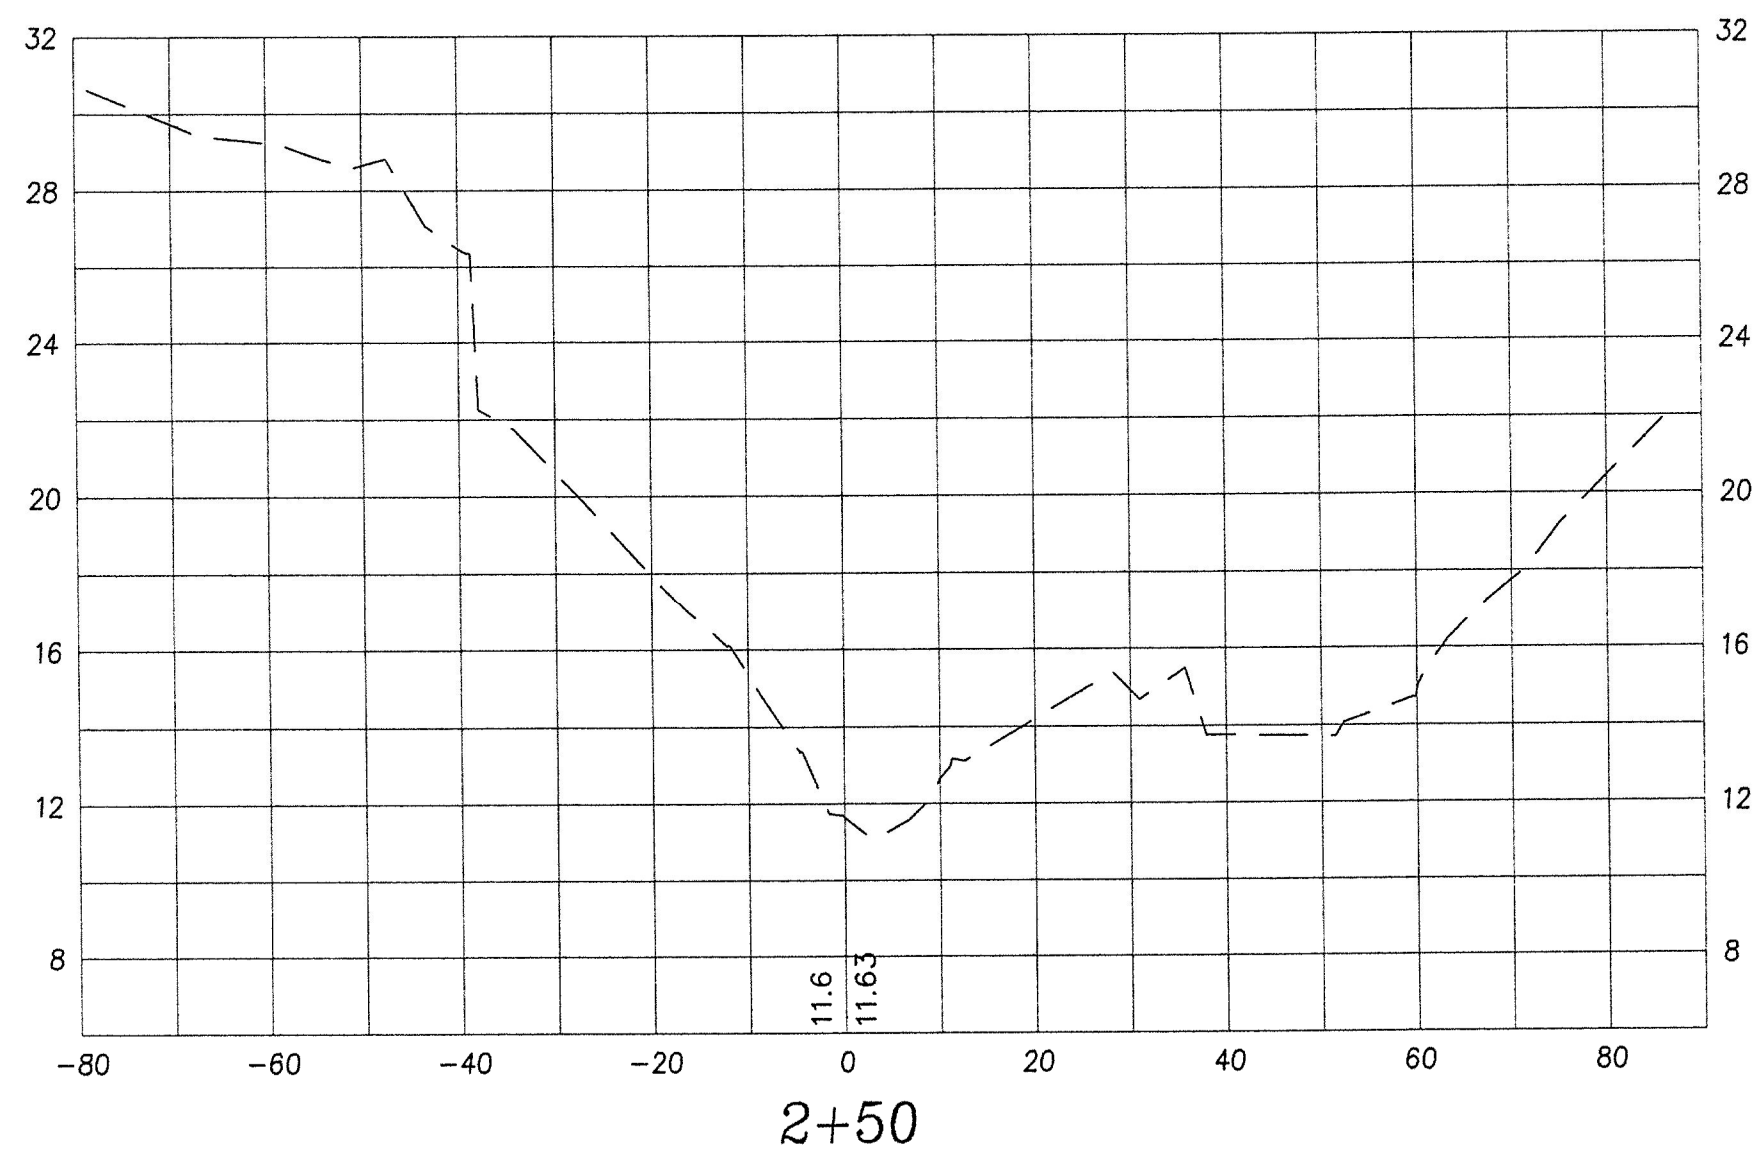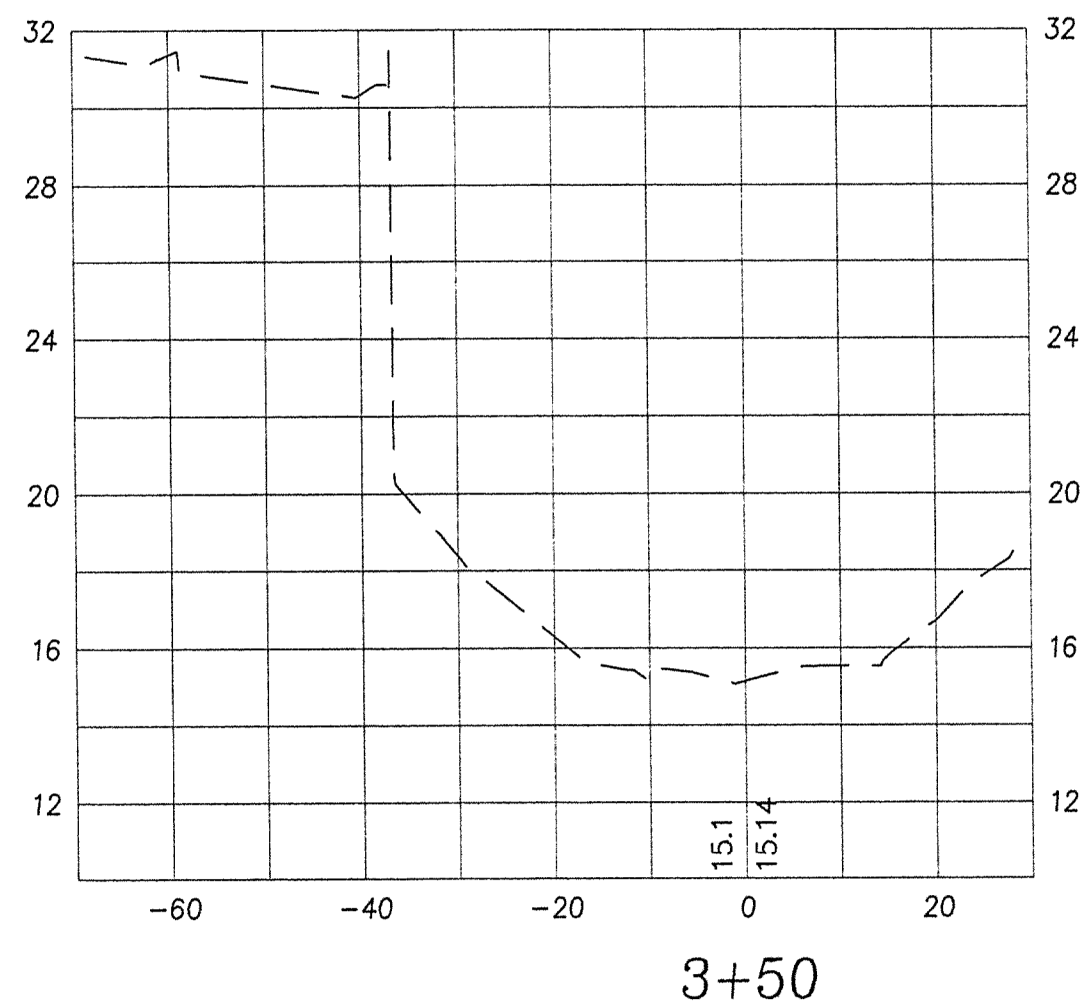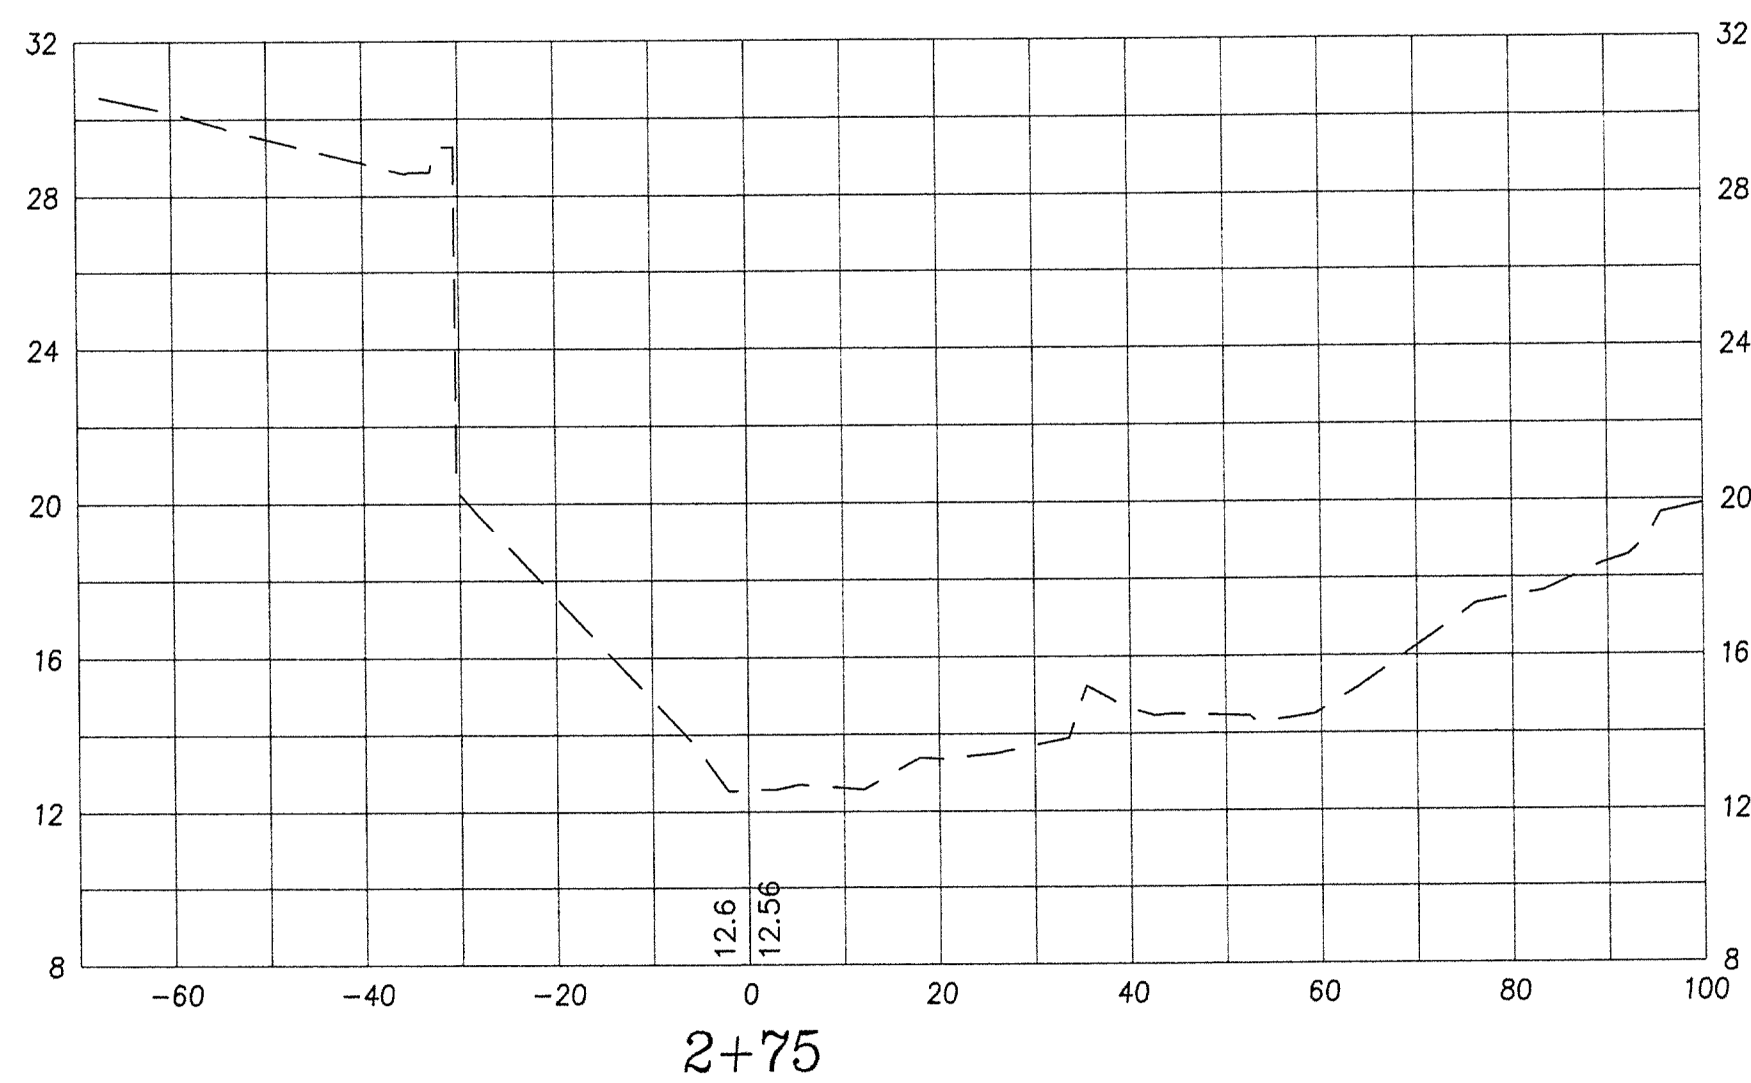

I CERTIFY:
THAT THIS ACTUAL SURVEY WAS MADE
ON THE GROUND ON SEPTEMBER 28, 2016.

THAT THIS SURVEY CONFORMS TO THE
REQUIREMENTS FOR ACCURACY FOR
N.H. URBAN SURVEY.

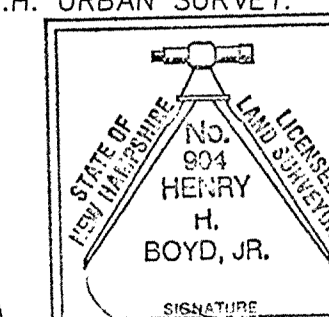

LICENSED LAND SURVEYOR DATE 10-14-2016

AS BUILT PLAN		
IN EXETER, N.H.		
SHOWING EXISTING CONDITIONS OFF OF PLEASANT STREET & HIGH STREET		
PREPARED FOR SUMCO ECO CONTRACTING 16 FRONT STREET, SUITE 209, SALEM, MA 01970		
MILLENNIUM ENGINEERING INC. ENGINEERS AND LAND SURVEYORS P.O. BOX 745 13 HAMPTON ROAD EXETER, NH 03833 PHONE:(603)778-0528 FAX:(603)772-0689 WWW.MEI-NH.COM		
SCALE: AS NOTED	DRWN. BY: P.D.B.	PROJECT: E161877
DATE: OCT. 05, 2016	CHKD. BY: H.H.B.	SHEET: 3 OF 3

Town of Exeter, New Hampshire

Linden Street

Little River Bridge Replacement

Record Drawings

Issued January 2016

Exeter Board of Selectmen

Julie Gilman, Chair
Dan Chartrand
Donald Clement, Vice Chair
Nancy Belanger, Clerk
Anne Surman

Exeter Town Manager

Russell Dean


Exeter Department of Public Works

Jennifer Perry, PE, Director
Jay Perkins, Hwy. Supt.

Exeter Engineering

Paul Vlasich, PE, Town Engineer
Jennifer Mates, PE, Asst. Town Engineer

Index of Sheets	
Sheet Number	Sheet Title
1	Cover
2	General Plan and Elevation
3	Site Plan and Profile
4	Bridge Notes
5	Survey Layout
6	Boring Logs (1 of 2)
7	Boring Logs (2 of 2)
8	Abutment A Plan and Elevation
9	Abutment B Plan and Elevation
10	Abutment and Wingwall Elevations and Details
11	Prestressed Box Beam Layout
12	Box Beam Details (1 of 3)
13	Box Beam Details (2 of 3)
14	Box Beam Details (3 of 3)
15	Typical Section
16	Superstructure Details
17	Approach Slab Details (1 of 2)
18	Approach Slab Details (2 of 2)
19	Bearing and Joint Details
20	T101 Bridge Rail & Approach Rail (Steel Posts)
21	Alternative Platform for Offset EAGRT
22	Snow Screen with T101 Bridge Rail
23	General Notes and Summary of Quantities
24	Roadway Plan and Profile
25	Cross Sections (1 of 2)
26	Cross Sections (2 of 2)
27	Road and Utility Details
28	Thrust Block Details
29	Linden Street Traffic Control Plan

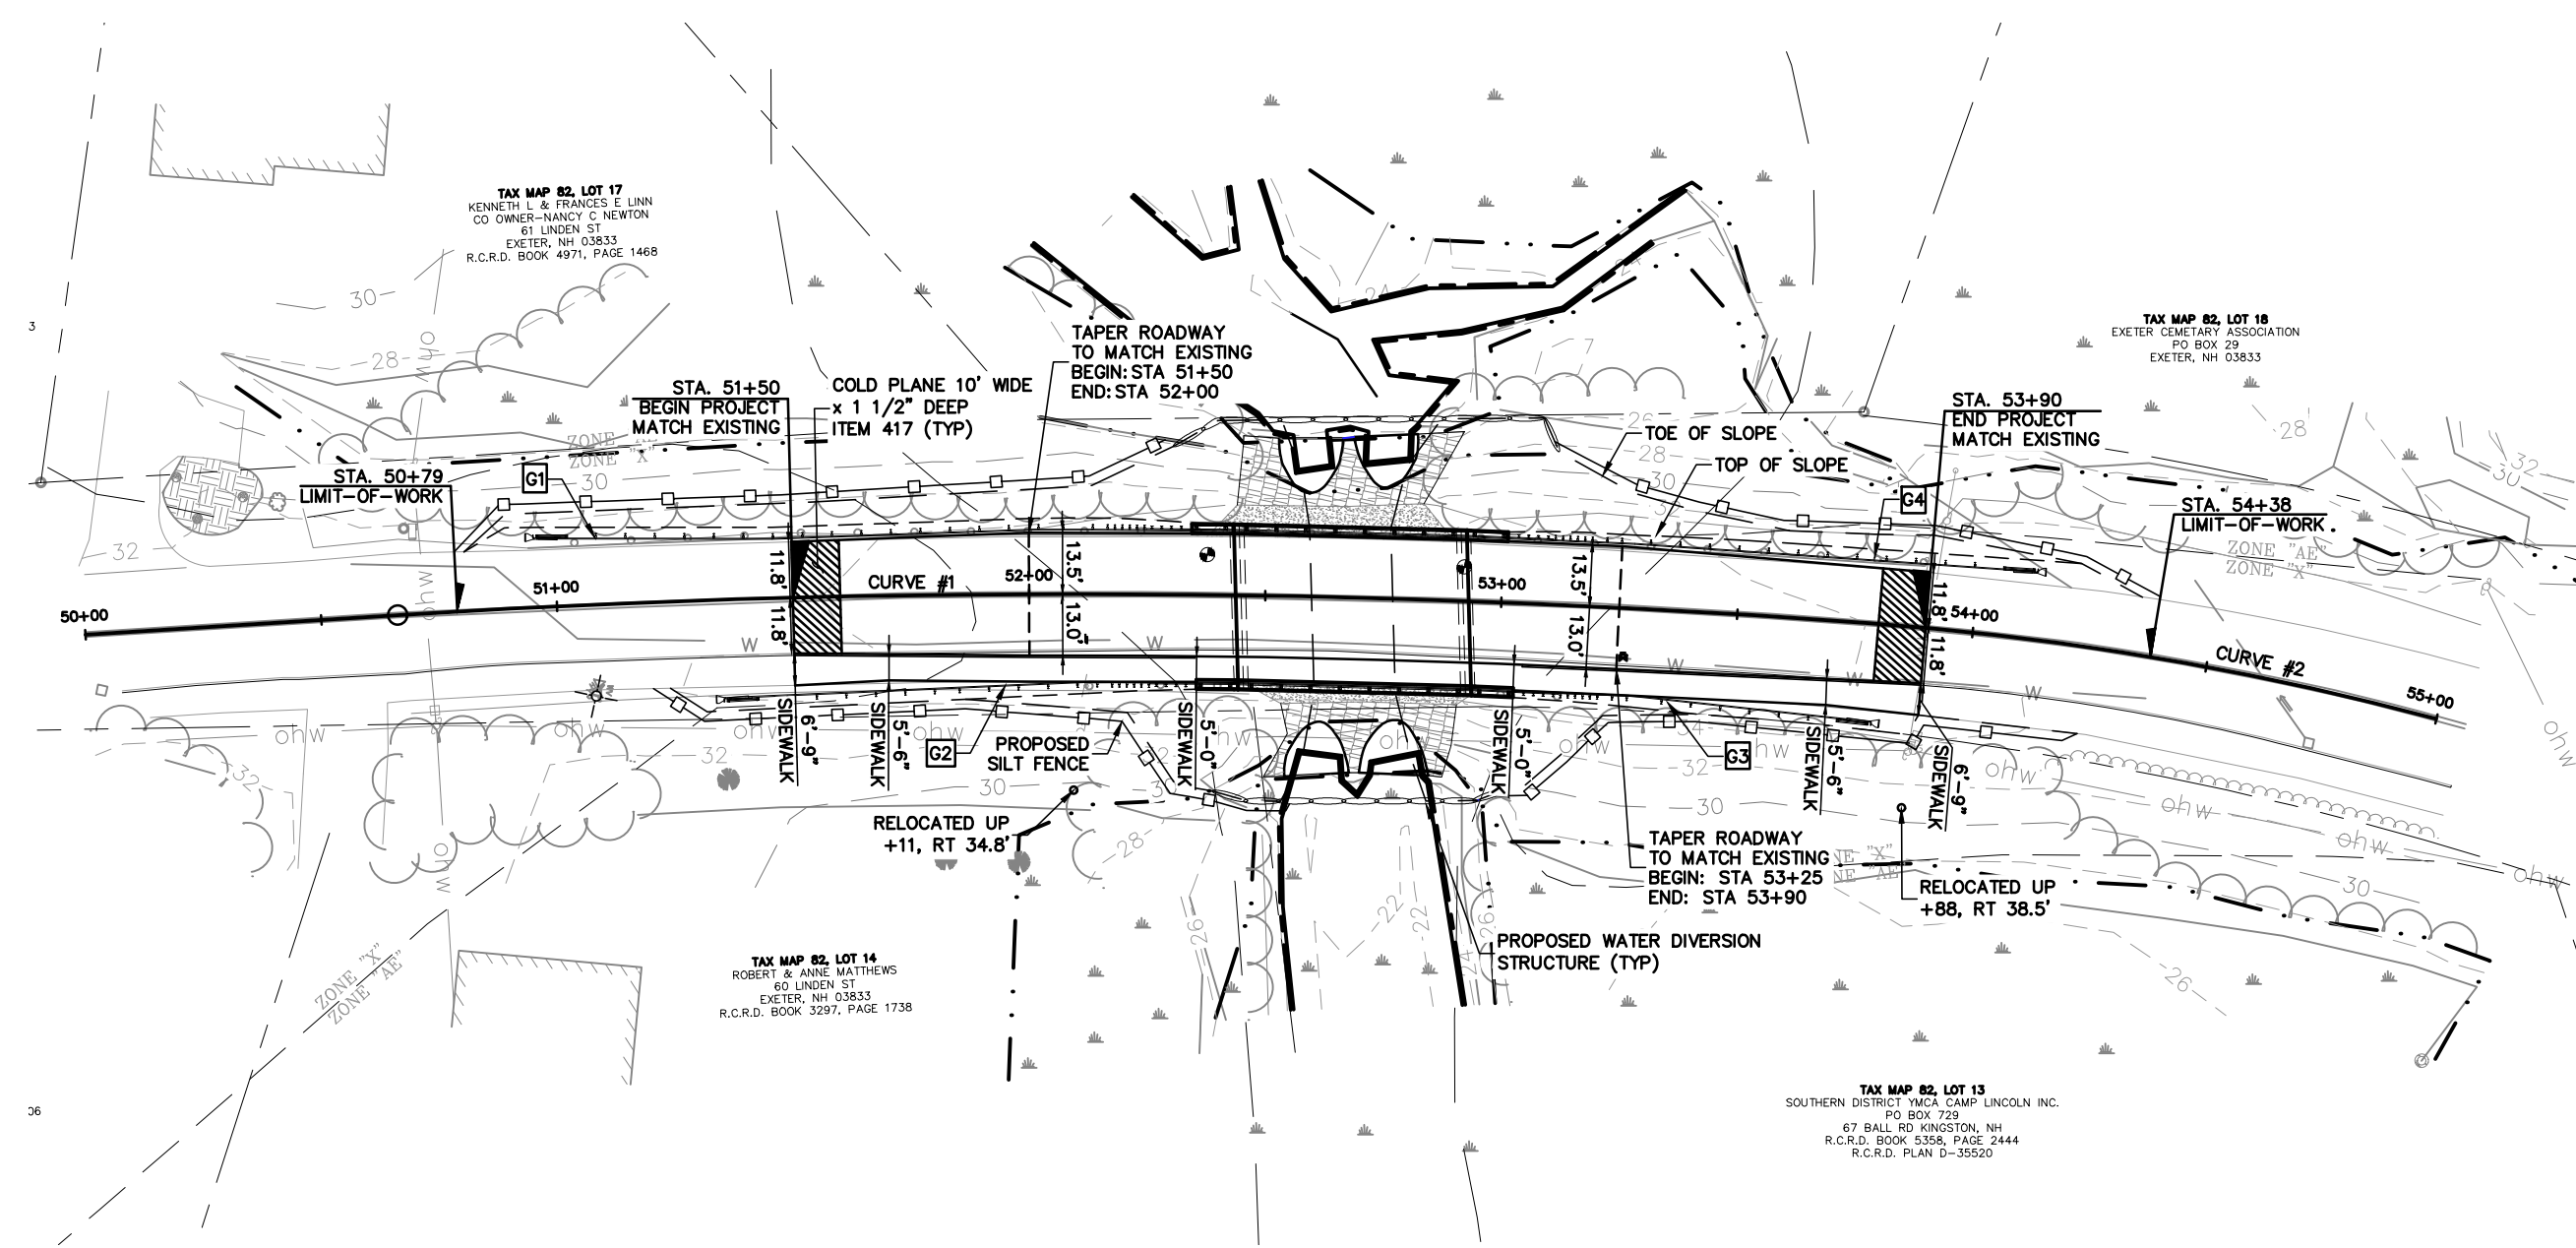

SITE OVERVIEW
SCALE: 1" = 40'

Prepared For:
Town of Exeter
Department of Public Works
13 Newfields Road
Exeter, New Hampshire 03833


Prepared By:

CMA
 ENGINEERS
 CIVIL/ENVIRONMENTAL ENGINEERS


35 Bow Street
 Portsmouth, New Hampshire 03801
 Phone: 603/431-6196
 Fax: 603/431-5376

Langer Place
 55 South Commercial Street
 Manchester, New Hampshire 03101
 Phone: 603/627-0708
 Fax: 603/627-0746


10 Free Street
 Portland, Maine 04101
 Phone: 207/541-4223
 Fax: 207/541-4225

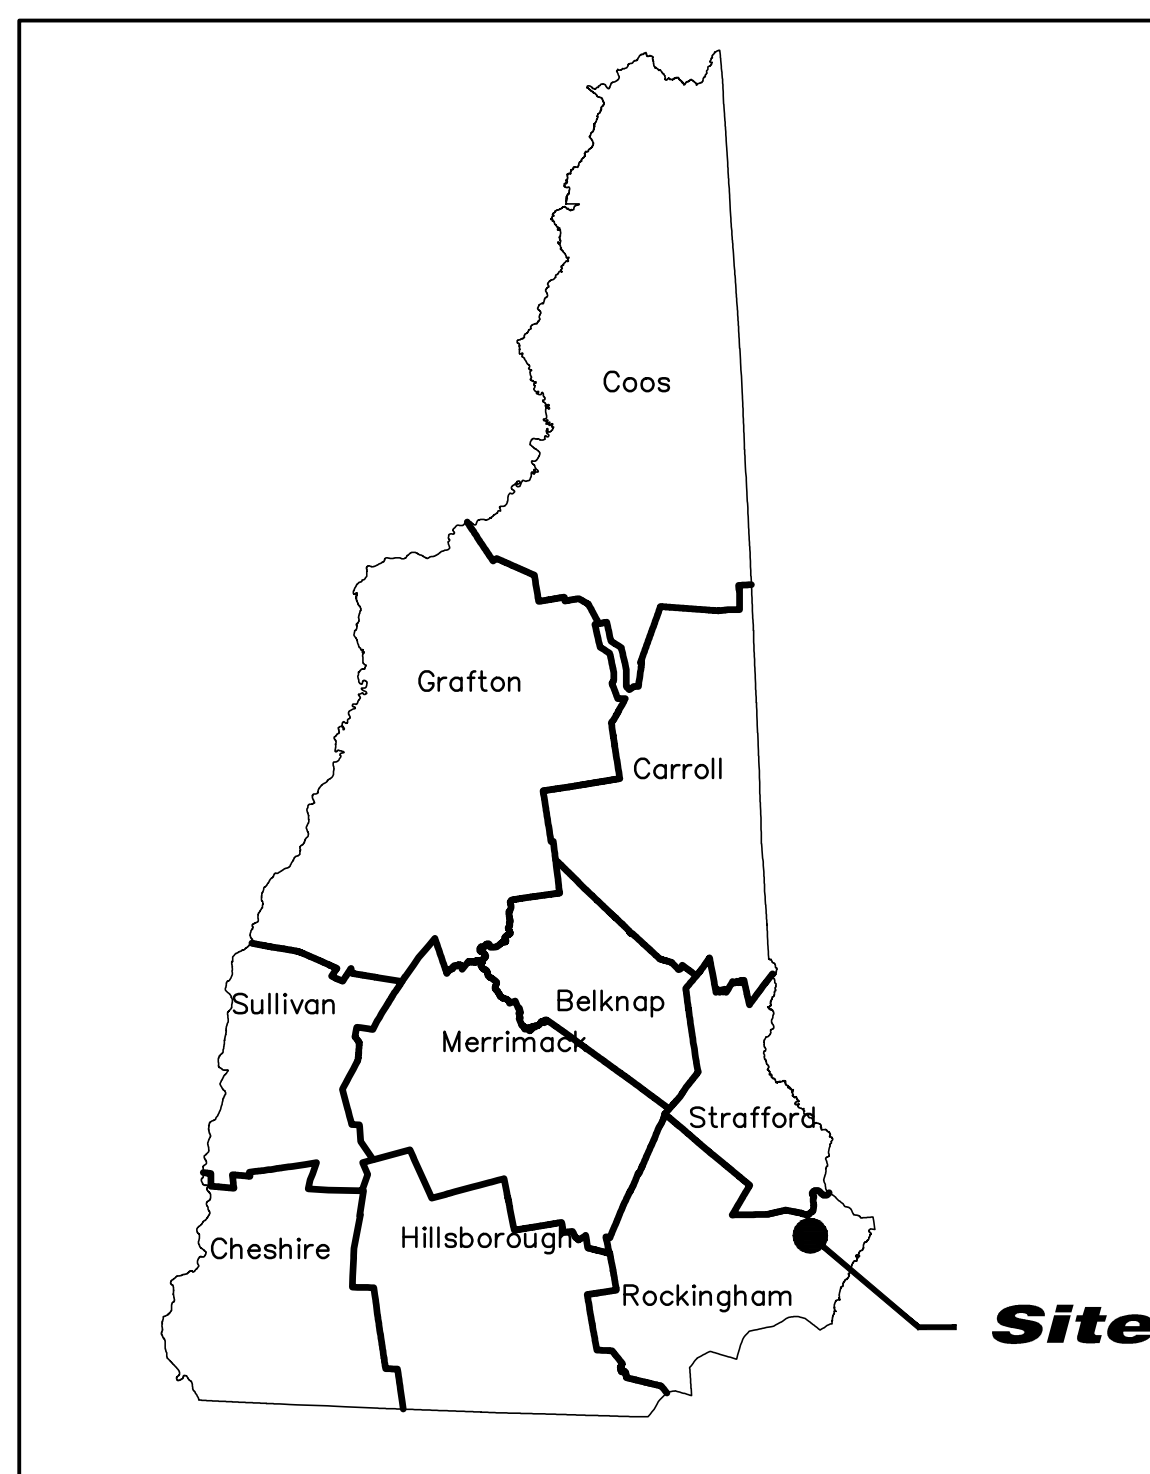

Locus Plan

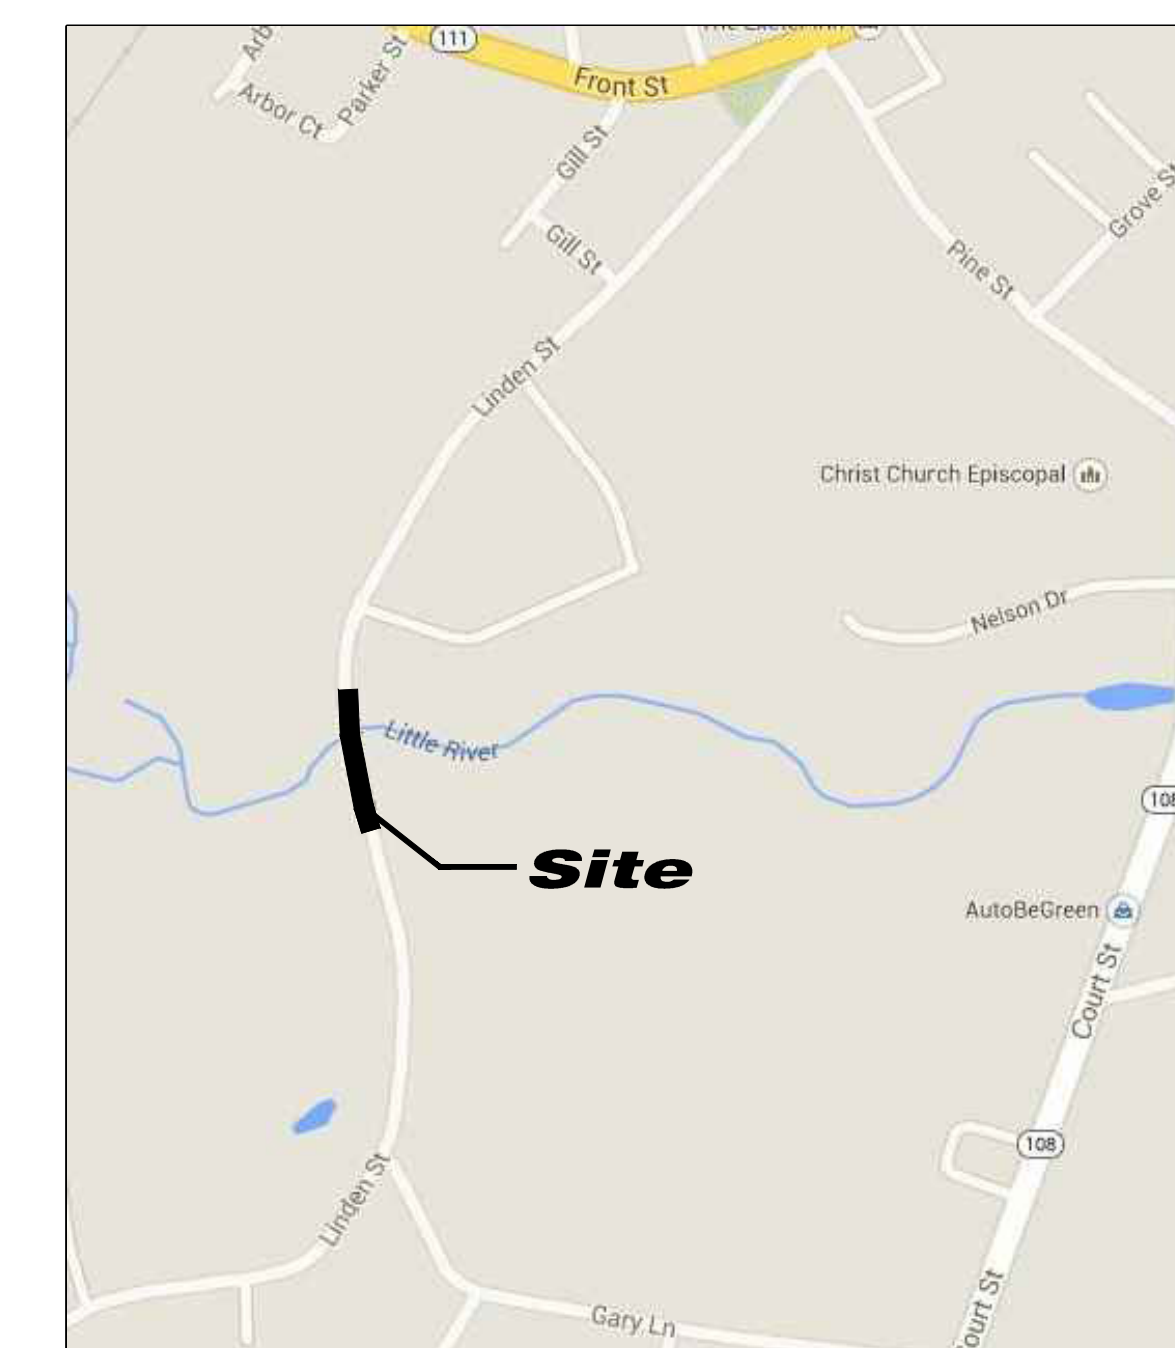

Project Location

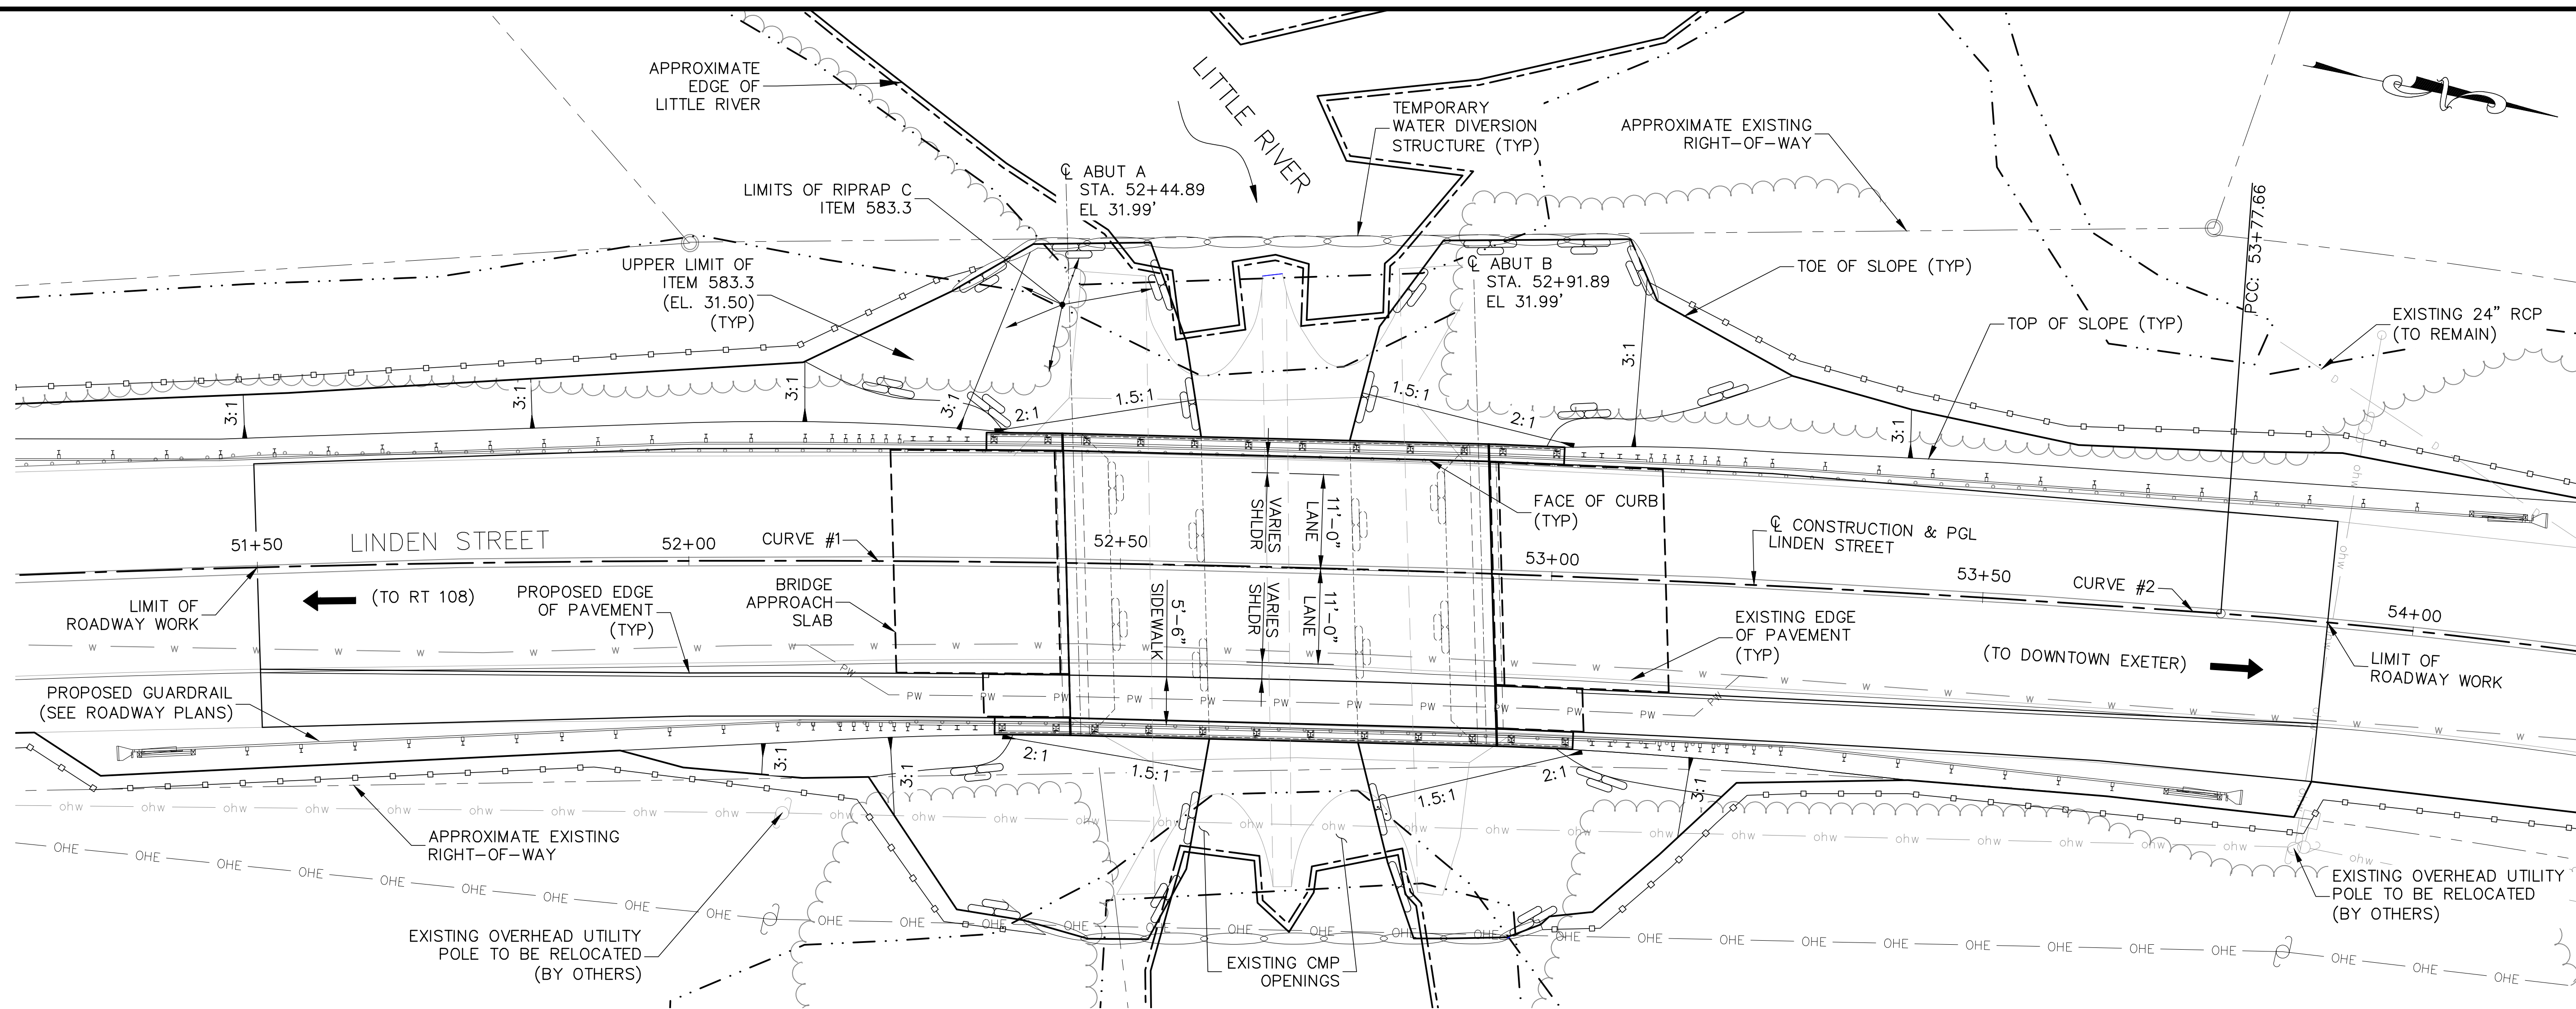

General Plan
Scale: 1"=10'-0"

HYDRAULIC DATA

DRAINAGE AREA: 957 CFS (50 YEAR)
 DESIGN FLOOD: 3.9 FT/SEC
 DESIGN VELOCITY: 30.12 FT (50 YEAR)
 DESIGN FLOOD ELEVATION: 31.40 FT
 100 YEAR FLOOD ELEVATION: 31.40 FT

LEGEND


- EDGE OF RIVER
- TREE LINE
- SILT FENCE
- PROPERTY LINE/ROW
- WATER DIVERSION STRUCTURE
- STONE FILL
- EXISTING OVERHEAD ELECTRIC
- PROPOSED OVERHEAD ELECTRIC
- EXISTING WATER MAIN
- PROPOSED WATER MAIN

**CURVE #1
LINDEN STREET**

PI STA = 52+22.18
 N = 172812.7558
 E = 1173490.2571
 Δ = 07°45'30"
 T = 155.96'
 R = 2300.00'
 L = 311.44'
 E = 5.28'

**CURVE #2
LINDEN STREET**

PI STA = 54+38.80
 N = 173028.0313
 E = 1173460.7123
 Δ = 10°46'52"
 T = 61.34'
 R = 650.00'
 L = 122.31'
 E = 2.89'

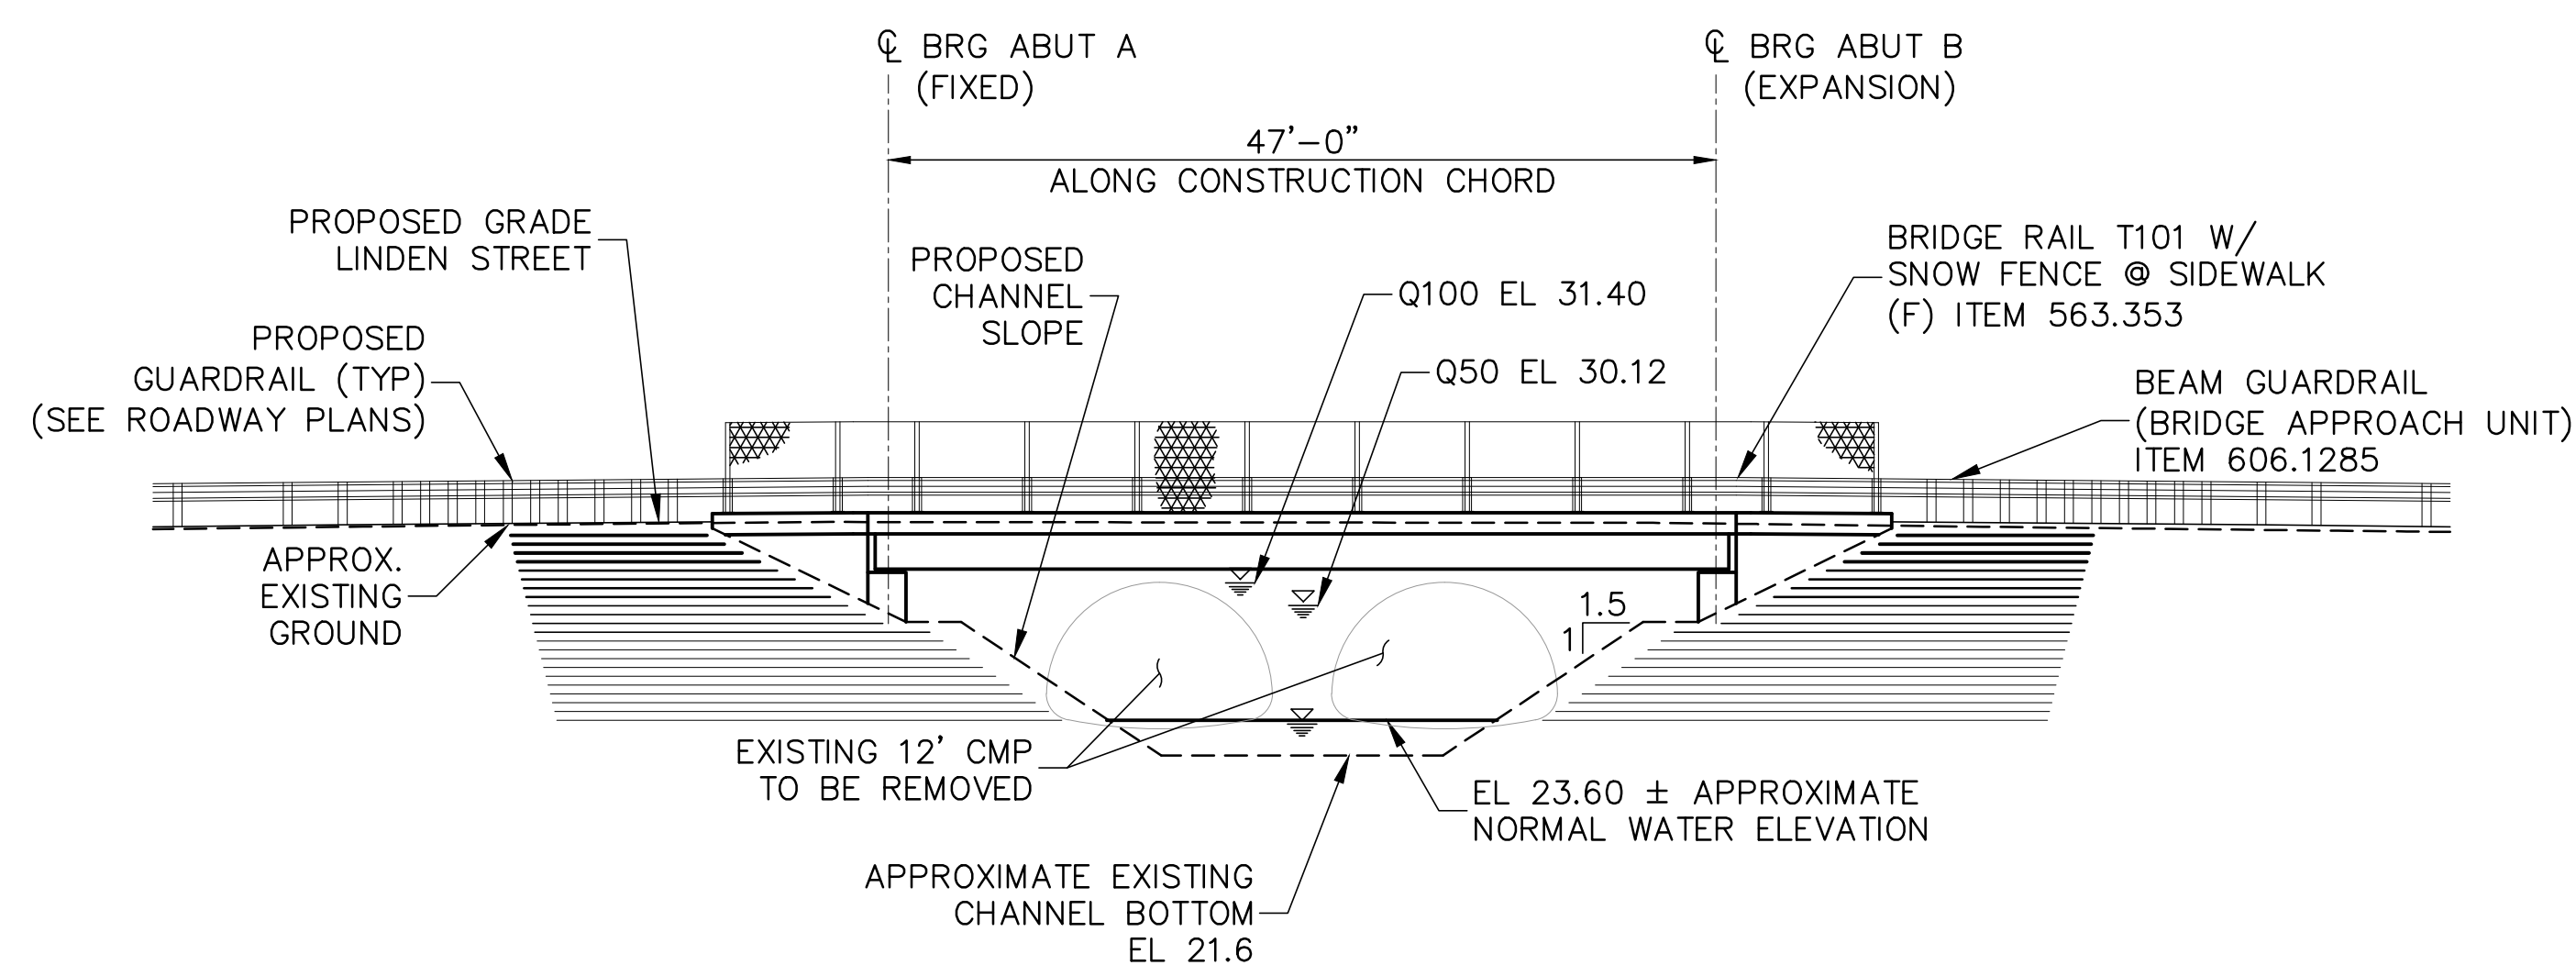

Elevation
Scale: 1"=10'-0"

INDEX OF BRIDGE SHEETS

BRIDGE SHEET NO.	SHEET TITLE
B-1	GENERAL PLAN AND ELEVATION
B-2	SITE PLAN AND PROFILE
B-3	BRIDGE NOTES
B-4	SURVEY LAYOUT AND CHANNEL SECTIONS
B-5	BORING LOGS (SHEET 1 OF 2)
B-6	BORING LOGS (SHEET 2 OF 2)
B-7	ABUTMENT A PLAN AND ELEVATION
B-8	ABUTMENT B PLAN AND ELEVATION
B-9	ABUTMENT AND WINGWALL ELEVATIONS AND DETAILS
B-10	PRESTRESSED BOX BEAM LAYOUT
B-11	BOX BEAM DETAILS (SHEET 1 OF 3)
B-12	BOX BEAM DETAILS (SHEET 2 OF 3)
B-13	BOX BEAM DETAILS (SHEET 3 OF 3)
B-14	TYPICAL SECTION AND RAIL LAYOUT
B-15	SUPERSTRUCTURE DETAILS
B-16	APPROACH SLAB DETAILS (SHEET 1 OF 2)
B-17	APPROACH SLAB DETAILS (SHEET 2 OF 2)
B-18	BEARING AND JOINT DETAILS
B-19	T101 BRIDGE AND APPROACH RAIL
B-20	ALTERNATIVE PLATFORM FOR OFFSET EAGRT
B-21	SNOW SCREEN WITH T101 BRIDGE RAIL

designed by: LBK/OGK
 drawn by: LBK/OGK
 approved by: JLG
 date: July 2015
 project no: 923
 file name: 923 - Structural Plans.dwg

scale: AS SHOWN

by: JLG
 date: 1/6/16
 revision: 0
 no. AS-BUILT

Town of Exeter
 Department of Public Works

Linden Street
 Little River Bridge Replacement

General Plan and Elevation

drawing no. B-1

sheet: 2 of 29

CMA ENGINEERS
 CIVIL/ENVIRONMENTAL ENGINEERS
 35 Bow Street Portsmouth, NH 03801 603-931-6196
 10 Free Street Portland, Maine 04101 207-541-4225
 info@cmaengineers.com www.cmaengineers.com

Structure Notes:		
1)	DESIGN LOADING:	HL-93
2)	DESIGN METHOD:	LOAD AND RESISTANCE FACTOR DESIGN METHOD (LRFD).
3)	SPECIFICATIONS:	AASHTO LRFD 2015. NHDOT 2006 STANDARD SPECIFICATIONS AS AMENDED.
4)	FOUNDATION DATA:	STUB ABUTMENTS SUPPORTED ON END BEARING PILES HP12x53 WITH APPROVED PILE POINTS (AASHTO M270, ASTM A709 GRADE 50). NOMINAL AXIAL RESISTANCE OF 388 TONS IN COMBINATION WITH A RESISTANCE FACTOR OF 0.5.
5)	REINFORCING STEEL:	AASHTO M31 (ASTM A615) GRADE 60. REINFORCING STEEL IN THE DECK OVERLAY, BOX BEAMS, APPROACH SLABS, AND BRUSH CURBS SHALL BE EPOXY COATED.
6)	CONCRETE:	BRIDGE DECK OVERLAY, CURBS, WINGWALL COPINGS AND APPROACH SLABS = 4 KSI STUB ABUTMENT AND WINGWALL = 4 KSI PRESTRESSED BUTTED BOX BEAMS = 6 KSI, RELEASE = 4.8 KSI
7)	POST-TENSIONING STEEL:	0.6" ϕ SEVEN-WIRE STRAND CONFORMING TO AASHTO M203 (ASTM A416) GRADE 270, LOW RELAXATION.
8)	PRESTRESSING STEEL:	0.5" ϕ SEVEN-WIRE STRAND CONFORMING TO AASHTO M203 (ASTM A416) GRADE 270, LOW RELAXATION.
9)	SEISMIC PERFORMANCE ZONE 2:	A = 0.17
10)	ALL EXISTING BRONZE DISCS REPRESENTING STATE BENCHMARKS OR SURVEY TRIANGULATION POINTS MUST NOT BE DISTURBED. WHEN THE WORK CALLED FOR INVOLVES DISTURBING A BRONZE DISK, THE CONTRACTOR SHALL NOTIFY THE ENGINEER SUFFICIENTLY IN ADVANCE OF THE WORK TO PERMIT THE TOWN, STATE OR AGENCY HAVING JURISDICTION TO TEMPORARILY RELOCATE THE AFFECTED MARKER.	
11)	MAINTENANCE OF TRAFFIC:.	ROAD CLOSURE AND DETOUR; SEE TRAFFIC CONTROL PLAN.
12)	FOR STRUCTURE LAYOUT SEE BRIDGE SHEET 4.	

Bridge Removal Notes:

- PLANS OF THE EXISTING BRIDGE ARE NOT AVAILABLE.
- ITEM 502, REMOVAL OF EXISTING BRIDGE STRUCTURE, SHALL INCLUDE REMOVAL OF THE ENTIRE CORRUGATED METAL PIPE, FOOTINGS, AND EXISTING STONE MASONRY HEADWALLS AS DESCRIBED WITHIN THESE PLANS. SEE SPECIAL CONDITIONS FOR MATERIALS TO BE SALVAGED TO THE TOWN. ALL OTHER EXISTING BRIDGE MATERIALS SHALL BECOME PROPERTY OF THE CONTRACTOR.
- EXCAVATION AND BACKFILL NOT INCLUDED IN OTHER PAY ITEMS, BUT REQUIRED FOR REMOVAL OF THE EXISTING STRUCTURE SHALL BE SUBSIDIARY TO ITEM 502.

Water Diversion Structure Notes:

- ITEM 503.101, WATER DIVERSION STRUCTURES, MAY BE REQUIRED FOR REMOVAL OF THE EXISTING STRUCTURE AND THE CONSTRUCTION OF THE ABUTMENTS DURING HIGH FLOW CONDITIONS. THE CONTRACTOR SHALL SUBMIT THE DIVERSION STRUCTURE TYPE, DESIGN, AND PROPOSED METHOD OF CONSTRUCTION TO THE ENGINEER IN ACCORDANCE WITH SECTION 105.02 OF THE NHDOT STANDARD SPECIFICATIONS. WATER DIVERSION STRUCTURE SUBMITTALS SHALL BE DESIGNED AND SEALED BY A PROFESSIONAL ENGINEER LICENSED IN THE STATE OF NEW HAMPSHIRE.
- WATER DIVERSION STRUCTURE LIMITS SHOWN ON THE PLANS ARE APPROXIMATE. THE CONTRACTOR SHALL DETERMINE THE REQUIRED LIMITS, IN ACCORDANCE WITH THE ENVIRONMENTAL PERMIT, TO MAINTAIN A DEWATERED AND ADEQUATELY SUPPORTED EXCAVATION DURING THE CONSTRUCTION.
- ALL COSTS FOR DESIGN, INSTALLATION AND REMOVAL OF WATER DIVERSION STRUCTURES SHALL BE INCLUDED IN ITEM 503.101.

Utility Notes:

- ITEMS 611.05212 AND 611.052121 SHALL INCLUDE ALL NECESSARY MATERIALS, INCLUDING PIPE, INSULATION, STRAPS, PROTECTIVE JACKETING, EXPANSION JOINTS, SADDLES, ROLLER SUPPORTS, ASSOCIATED HARDWARE AND LABOR TO INSTALL THE UTILITY. FOR LIMITS, SEE BRIDGE SHEET B-1.
- ALL THREADED RODS, NUTS, WASHERS, STRAPS, AND PIPE ROLL SUPPORTS SHALL BE GALVANIZED.

Boring Notes:		
1)	BORINGS INDICATED THUS \bullet WERE MADE BY GREAT WORKS PUMP & TEST BORING, INC. IN JULY 2014. BLOW COUNTS SHOWN ARE THE NUMBER OF BLOWS REQUIRED TO DRIVE A 2" O.D. STANDARD SPLIT SPOON SAMPLER 6", USING A 140LB WEIGHT FALLING 30".	
2)	BORINGS ARE FOR DESIGN PURPOSES ONLY, SHOWING CONDITIONS AT THE BORING POINTS ONLY, AND DO NOT NECESSARILY INDICATE MATERIAL TO BE ENCOUNTERED DURING CONSTRUCTION.	
3)	GROUNDWATER LEVELS NOTED, IF ANY, WERE MEASURED AT THE TIME OF EXPLORATION. THE WATER LEVELS ENCOUNTERED DURING CONSTRUCTION MAY VARY CONSIDERABLY DUE TO PREVAILING CLIMATE, RAINFALL, OR OTHER FACTORS.	

Pile Notes:

1)	MAXIMUM FACTORED PILE LOAD:	143.0 KIPS PER PILE
2)	STEEL H-PILES SHALL CONFORM TO AASHTO M270 (ASTM A709), GRADE 50. ALL PILES SHALL BE HP12x53. PILE POINTS ARE REQUIRED, REFER TO THE QUALIFIED PRODUCTS LIST FOR STANDARD MANUFACTURED PILE POINTS.	
3)	THE PILES SHALL BE DRIVEN IN ACCORDANCE WITH SECTION 510 TO A NOMINAL GEOTECHNICAL RESISTANCE EQUAL TO THE MAXIMUM FACTORED LOAD DIVIDED BY A RESISTANCE FACTOR OF 0.65. ITEM 510.2, PILE LOADING TESTS, SHALL BE USED TO CONDUCT PILE DYNAMIC ANALYZER (PDA) TESTS IN ACCORDANCE WITH SECTION 510 TO VERIFY THE NOMINAL GEOTECHNICAL RESISTANCE AND THE ACCEPTABILITY OF THE CONTRACTOR'S DRIVING SYSTEM. SEE SPECIAL PROVISION FOR ADDITIONAL INFORMATION.	
4)	ONE SPLICE PER PILE WHEN THE ESTIMATED LENGTH IS OVER 60 FEET AND SPLICES REQUIRED FOR PILES THAT EXCEED THE ESTIMATED LENGTH WILL BE PAID. NO PAYMENT FOR ADDITIONAL PILE SPLICES WITHIN THE ESTIMATED LENGTH WILL BE PAID UNLESS ORDERED. APPROVED ADDITIONAL PILE SPLICES WILL BE PAID UNDER ITEM 510.9.	
	ESTIMATED PILE LENGTHS:	ABUTMENT A: 26.0 FEET ABUTMENT B: 26.0 FEET
5)	PILE LOCATION AND ALIGNMENT TOLERANCES AT ABUTMENTS SHALL CONFORM TO SECTION 510.3.6.4 REQUIREMENTS FOR BENT CAPS SUPPORTED BY PILES.	
6)	PILE LAYOUT DIMENSIONS ARE GIVE AT THE BOTTOM OF THE STUB ABUTMENT.	
7)	PLACE REINFORCING STEEL TO CLEAR PILES.	
8)	PILES SHALL BE DRIVEN TO REFUSAL (BEDROCK).	

Precast Box Beam Notes:		
1)	THE CONCRETE COMPRESSIVE STRENGTH OF THE PRECAST BOX BEAM UNITS SHALL BE 4800 PSI AT RELEASE AND 6000 PSI AT 28 DAYS.	
2)	PRESTRESSING STEEL SHALL BE 0.5" ϕ UNCOATED SEVEN-WIRE STRAND CONFORMING TO AASHTO M203 (ASTM A416) GRADE 270 LOW RELAXATION. ALL STRANDS SHALL BE PRE-TENSIONED TO 43.9 KIPS PER STRAND (75% INITIAL PULL).	
3)	POST-TENSIONING STRANDS SHALL BE COMPLETELY COATED WITH A CORROSION PREVENTATIVE COATING SUCH AS FLO-GUARD, AS MANUFACTURED BY INSTEEL INDUSTRIES, INC., SANDERSON, FL., OR POLYSTRAND, AS MANUFACTURED BY LANG TENDONS, INC., TOUGHKENAMON, PA., OR AN APPROVED EQUAL. IF THE FLO-GUARD COATING SYSTEM IS SUPPLIED, GROUT SHALL BE EXCLUDED FROM THE LATERAL POST-TENSIONING DUCTS DURING GROUTING OF THE SHEAR KEYS BETWEEN THE BEAMS. THE CONTRACTOR'S PROPOSED METHOD FOR EXCLUDING THE GROUT FROM THE POST-TENSIONING DUCTS SHALL BE SUBMITTED WITH THE SHOW DRAWINGS. POST-TENSIONING ANCHORAGE SYSTEM SHALL BE MONO-STRAND CORROSION PROTECTION SYSTEM AS MANUFACTURED BY HAYES INDUSTRIES, INC., HOUSTON TEXAS OR APPROVED EQUAL.	
4)	TRANSVERSE POST-TENSIONING OF THE PRECAST BOX BEAMS SHALL BE PERFORMED IN ACCORDANCE WITH SPECIAL PROVISION 528.3224.	
5)	ALL REINFORCING STEEL FOR THE SUPERSTRUCTURE SHALL CONFORM TO AASHTO M31 (ASTM A615) GRADE 60 AND SHALL BE EPOXY COATED.	
6)	THE PRECAST BOX BEAM REINFORCING STEEL SHALL HAVE A MINIMUM CLEAR COVER OF 1 $\frac{1}{4}$ " UNLESS OTHERWISE NOTED.	
7)	THE COST OF PRESTRESSING STRANDS, POST-TENSIONING STRANDS AND ANCHORAGES, AND REINFORCING STEEL CAST INTO THE PRECAST BOX BEAM UNITS SHALL BE SUBSIDIARY TO ITEM 528.3224. ALL OTHER STEEL IN THE SUPERSTRUCTURE SHALL BE PAID UNDER ITEM 544.31.	
8)	LIFTING DEVICES SHALL BE WITHIN 24" OF EACH END OF THE PRECAST BOX BEAM UNITS. COST SHALL BE SUBSIDIARY TO ITEM 528.3224.	
9)	1" ϕ DRAINS SHALL BE PROVIDE AT THE THE LOW END OF ALL BOX BEAM VOIDS.	
10)	THE BOX BEAM SHEAR KEYS SHALL BE BLAST CLEANED PRIOR TO SHIPPING.	
11)	THE TOP SURFACE OF THE BOX BEAMS SHALL BE RAKED TRANSVERSELY TO A $\frac{1}{4}$ " AMPLITUDE.	
12)	DRILLING INTO THE BOX BEAMS SHALL NOT BE ALLOWED.	
13)	DIFFERENTIAL CAMBER (AT ERECTION) BETWEEN ADJACENT MEMBERS SHALL BE LIMITED TO 1". VALUES FOR MIDSPAN CAMBER AT TRANSFER SHALL BE DETAILED ON THE SHOP DRAWINGS.	
14)	PROVIDE INSERTS TO SUPPORT THE CONTRACTOR'S OVERHANG BRACKETS IN THE TOP SLAB ON EXTERIOR UNITS AT THE SPACING REQUESTED BY THE GENERAL CONTRACTOR. INSERTS SHALL BE SHOWN ON THE SHOP DRAWINGS. ALL COSTS SHALL BE SUBSIDIARY TO ITEM 528.3224.	

Bridge Deck Notes:		
1)	ALL CONCRETE IN THE CAST-IN-PLACE OVERLAY AND BRUSH CURBS SHALL BE ITEM 520.01, CONCRETE CLASS AA.	
2)	CONCRETE OVERLAY FINISHING SHALL MEET THE REQUIREMENTS OF 520.3.9.2 UNLESS OTHERWISE APPROVED IN WRITING BY THE ENGINEER.	
3)	THE CONTRACTOR SHALL NOT DRILL INTO THE PRECAST BOX BEAMS UNLESS APPROVED IN WRITING BY THE ENGINEER.	
4)	ALL REINFORCEMENT IN THE BRIDGE DECK OVERLAY AND BRUSH CURBS SHALL BE EPOXY COATED AND SHALL BE PAID AS ITEM 544.31, REINFORCING STEEL, EPOXY COATED (CONTRACTOR DETAILED).	
5)	ALL REINFORCING SHALL BE 2 $\frac{1}{2}$ " FROM CONCRETE SURFACES, UNLESS OTHERWISE NOTED.	

Approach Slab Notes:

- ALL CONCRETE FOR THE APPROACH SLABS SHALL BE ITEM 520.0302, CONCRETE CLASS AA, APPROACH SLABS (F).
- ALL REINFORCEMENT IN THE APPROACH SLABS SHALL BE EPOXY COATED AND SHALL BE PAID AS ITEM 544.31, REINFORCING STEEL, EPOXY COATED (CONTRACTOR DETAILED).
- ALL REINFORCING SHALL BE 2 $\frac{1}{2}$ " FROM CONCRETE SURFACES, UNLESS OTHERWISE NOTED.
- FILL SPACE BETWEEN APPROACH SLAB AND WINGWALL OR ROADWAY CURB WITH ITEM 520.01. CONCRETE FILL SHALL BE A MINIMUM DEPTH OF 6 INCHES.
- APPROACH SLABS SHALL BE PLACED AFTER THE CONCRETE DECK OVERPOUR HAS BEEN CONSTRUCTED.
- APPROACH SLABS FOR BOTH ABUTMENTS SHALL BE CAST 2 $\frac{5}{8}$ " BELOW FINISHED GRADE AT THE APPROACH SLAB SEATS.

Elastomeric Bearing Notes:

- ELASTOMERIC BEARING PADS SHALL BE VIRGIN NATURAL RUBBER, HARDNESS (SHORE "A" DUROMETER) OF 60, GRADE 4.
- STEEL PLATE REINFORCEMENT SHALL CONFORM TO AASHTO M270 (ASTM A709, GRADE 35).
- ELASTOMERIC BEARINGS, INCLUDING STEEL PLATES, SHALL BE PAID AS ITEM 548.11, ELASTOMERIC BEARING PADS (F).
- DESIGN SERVICE LOADS PER BEARING: (DESIGN METHOD A)
MAX DEAD LOAD: 14.9 KIP
MAX LIVE LOAD: 26.7 KIP
- FOLLOWING THE MANUFACTURE OF THE ELASTOMERIC BEARINGS AND VERIFICATION OF THE INTERNAL STEEL LAMINATES, THE PIN GROOVE OPENING SHALL BE COATED WITH AN APPROVED ASPHALTIC SEALER AND THE SPACE FILLED WITH SILICONE CAULKING.

Abutment and Wingwall Notes

- THE CONTRACTOR SHALL BE REQUIRED TO PLACE ALL CONCRETE IN THE DRY. DEWATERING, AS REQUIRED, SHALL BE CONTINUOUS UNTIL THE ABUTMENT AND WINGWALLS ARE BACKFILLED TO THE ELEVATION OF THE SURROUNDING WATER TABLE, UNLESS DIRECTED OTHERWISE.
- ALL EXPOSED EDGES OF CONCRETE SHALL BE CHAMFERED $\frac{3}{4}$ " EXCEPT AS NOTED.
- ALL CONCRETE IN THE STUB ABUTMENTS, WINGWALLS, AND WINGWALL COPING SHALL BE ITEM 520.01, CONCRETE CLASS AA.
- ITEM 538.2, BARRIER MEMBRANE, VERTICAL SURFACES (F), SHALL BE PLACED OVER THE ABUTMENT-WINGWALL VERTICAL CONSTRUCTION JOINT, 1'-0" ON EACH SIDE OF THE JOINT.
- ITEM 534.3, WATER REPELLENT (SILANE-SILOXANE), SHALL BE APPLIED TO THE ENTIRE BRIDGE SEAT, INCLUDING THE BEARING PEDESTAL SURFACES AND ALL EXPOSED SURFACES ON BOTH ABUTMENTS AND ALL WINGWALLS TO 1'-0" BELOW THE FILL LINE.
- ALL REINFORCING IN THE ABUTMENTS AND WINGWALLS SHALL BE PAID AS ITEM 544.3, REINFORCING STEEL, (CONTRACTOR DETAILED) EXCEPT REINFORCING IN WINGWALL COPINGS WHICH SHALL BE EPOXY COATED AND PAID AS ITEM 544.31, REINFORCING STEEL, EPOXY COATED (CONTRACTOR DETAILED).
- ALL REINFORCING SHALL BE A MINIMUM OF 2 $\frac{1}{2}$ " FROM CONCRETE SURFACES, UNLESS NOTED OTHERWISE.

revision	date
0	AS-BUILT
1/6/16	JLG


CMA ENGINEERS
CIVIL/ENVIRONMENTAL ENGINEERS

35 Bow Street
Portsmouth, NH 03801
603-931-6196

10 Free Street
Portland, Maine 04101
207-541-4223

55 So. Commercial Street
Manchester, NH 03101
603-687-0708


info@cmaengineers.com
www.cmaengineers.com

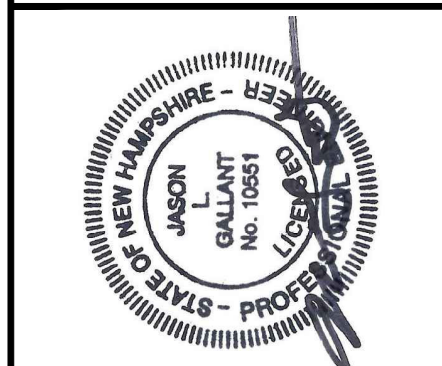

date:	July 2015
project no:	923
file name:	923 - Structural Plans.dwg
designed by:	LBK/OGK
drawn by:	LBK/OGK
approved by:	JLG
scale:	AS SHOWN

Town of Exeter Department of Public Works	Linden Street Little River Bridge Replacement	Bridge Notes
--	--	--------------

drawing no.	B-3
sheet:	4 of 29

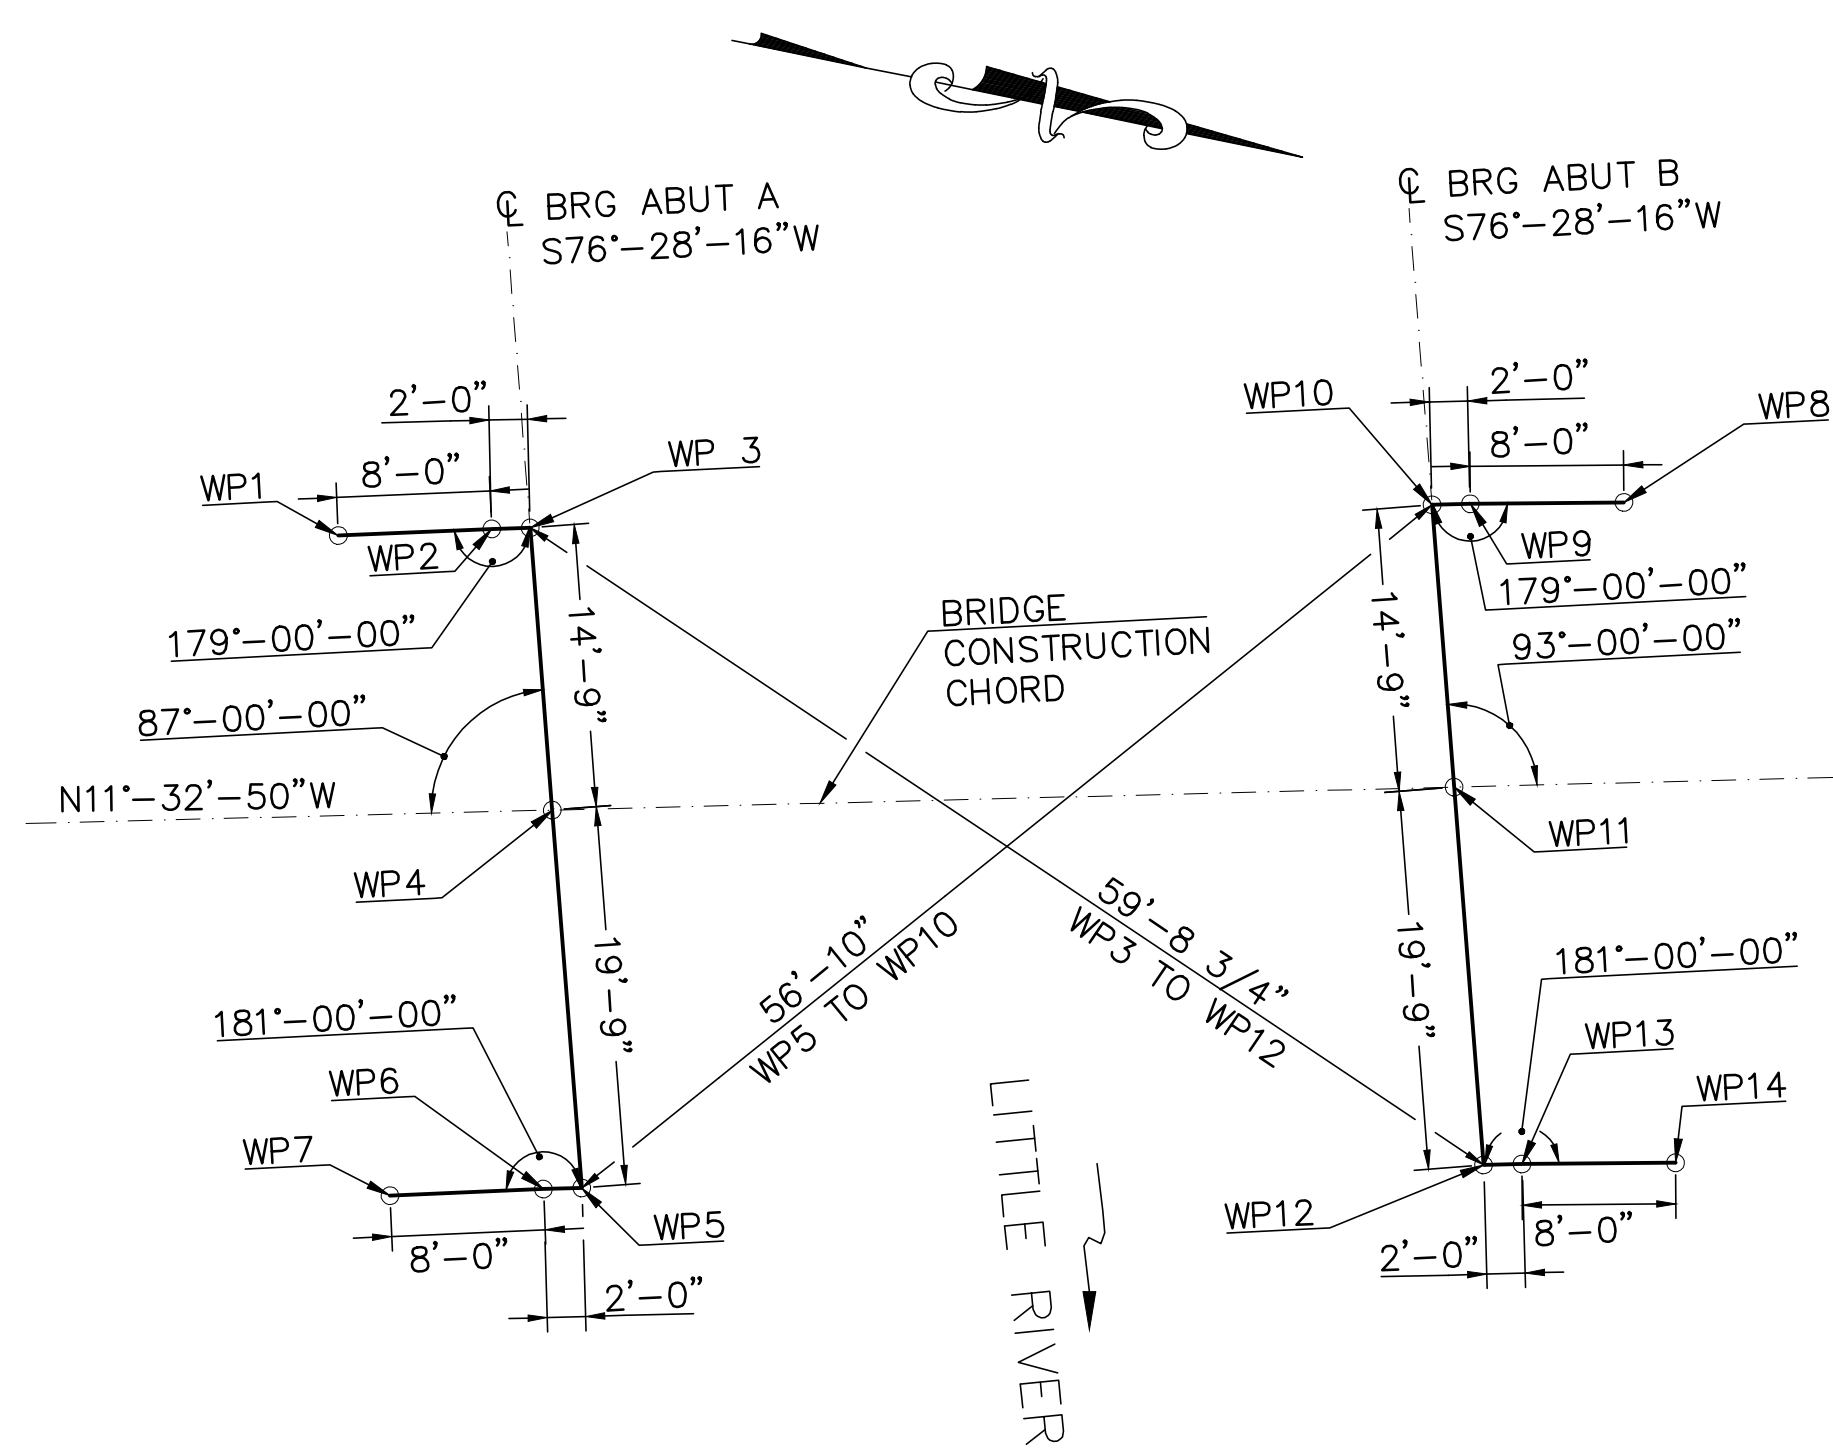

Survey Layout

Scale: 1"=10'


WORKING POINT COORDINATES		
WORKING POINT NO.	NORTHING	EASTING
WP1	172823.06	1173478.52
WP2	172830.90	1173476.92
WP3	172832.87	1173476.55
WP4	172836.32	1173490.89
WP5	172840.94	1173510.09
WP6	172838.98	1173510.46
WP7	172831.14	1173512.06
WP8	172888.93	1173466.26
WP9	172881.04	1173467.59
WP10	172879.08	1173467.96
WP11	172882.53	1173482.30
WP12	172887.15	1173501.50
WP13	172889.12	1173501.13
WP14	172897.01	1173499.81

LOCATION AND DESCRIPTION OF BENCHMARKS				
BENCH MARK	LOCATION	NORTHING	EASTING	ELEVATION
TBM "A"	MAG NAIL SET, UP 6" IN POLE #18/51	173147.9749	1173435.3853	31.64'
TBM "B"	"X" MARK CHISED IN BOLT OVER MAIN OUTLET OF HYDRANT AT 60 LINDEN STREET	172707.7694	1173540.6009	35.53'

HORIZONTAL DATUM: NAD1983, NEW HAMPSHIRE STATE PLANE COORDINATE SYSTEM
 VERTICAL DATUM: NGVD 1929


Vertical datum of bridge plans is NGVD29. Subtract 0.76 ft from all elevations on plans to convert to NAVD88 for HEC-RAS model.

SUMMARY OF BRIDGE QUANTITIES			
ITEM NO.	ITEM DESCRIPTION	QUANTITY	UNIT
207.1	COMMON CHANNEL EXCAVATION	770	CY
209.201	GRANULAR BACKFILL BRIDGE (F)	100	CY
403.911	HOT BITUMINOUS BRIDGE PAVEMENT, 1.5" BASE COURSE (F)	13	TON
502	REMOVAL OF EXISTING BRIDGE STRUCTURE	1	U
503.101	WATER DIVERSION STRUCTURE	1	U
504.1	COMMON BRIDGE EXCAVATION (F)	310	CY
504.2	ROCK BRIDGE EXCAVATION	20	CY
508	STRUCTURAL FILL	20	CY
510.1	PILE DRIVING EQUIPMENT	1	U
510.61	FURNISHING AND DRIVING STEEL BEARING PILES	13800	LB
510.65	DRIVING-POINTS FOR STEEL BEARING PILES	10	EA
520.01	CONCRETE CLASS AA	105	CY
520.0302	CONCRETE CLASS AA APPROACH SLABS	60	CY
528.3224	PRESTRESSED CONCRETE BRIDGE DECK, 24" BUTTED BOX BEAMS (F)	1600	SF
534.3	WATER REPELLENT (SILANE-SILOXANE)	10	GAL
538.2	BARRIER MEMBRANE, PEEL AND STICK - VERTICAL SURFACES (F)	5	SY
538.5	BARRIER MEMBRANE, HEAT WELDED (F)	25	SY
538.6	BARRIER MEMBRANE, HEAT WELDED - MACHINE METHOD (F)	170	SY
544.3	REINFORCING STEEL, (CONTRACTOR DETAILED)	4900	LB
544.31	REINFORCING STEEL, EPOXY COATED (CONTRACTOR DETAILED)	14300	LB
544.7	SYNTHETIC FIBER REINFORCEMENT (F)	380	LB
548.11	ELASTOMERIC BEARING PADS (F)	36	EA
559.4	ASPHALTIC PLUG EXPANSION JOINT (F)	35	LF
559.41	MODIFIED ELASTOMERIC PLUG TYPE FLEXIBLE JOINT, 6" WIDE (F)	35	LF
562.1	SILICONE JOINT SEALANT (F)	40	LF
563.3	BRIDGE RAIL T101	68	LF
563.353	BRIDGE RAIL T101 WITH SNOW SCREENING	68	LF
583.3	RIPRAP C	240	CY
593.411	GEOTEXTILE, PERMANENT EROSION CONTROL, CLASS 1, NON-WOVEN	475	SY
1008.9	ALTERATIONS AND ADDITIONS AS NEEDED - TESTING OF MATERIAL	6000	\$

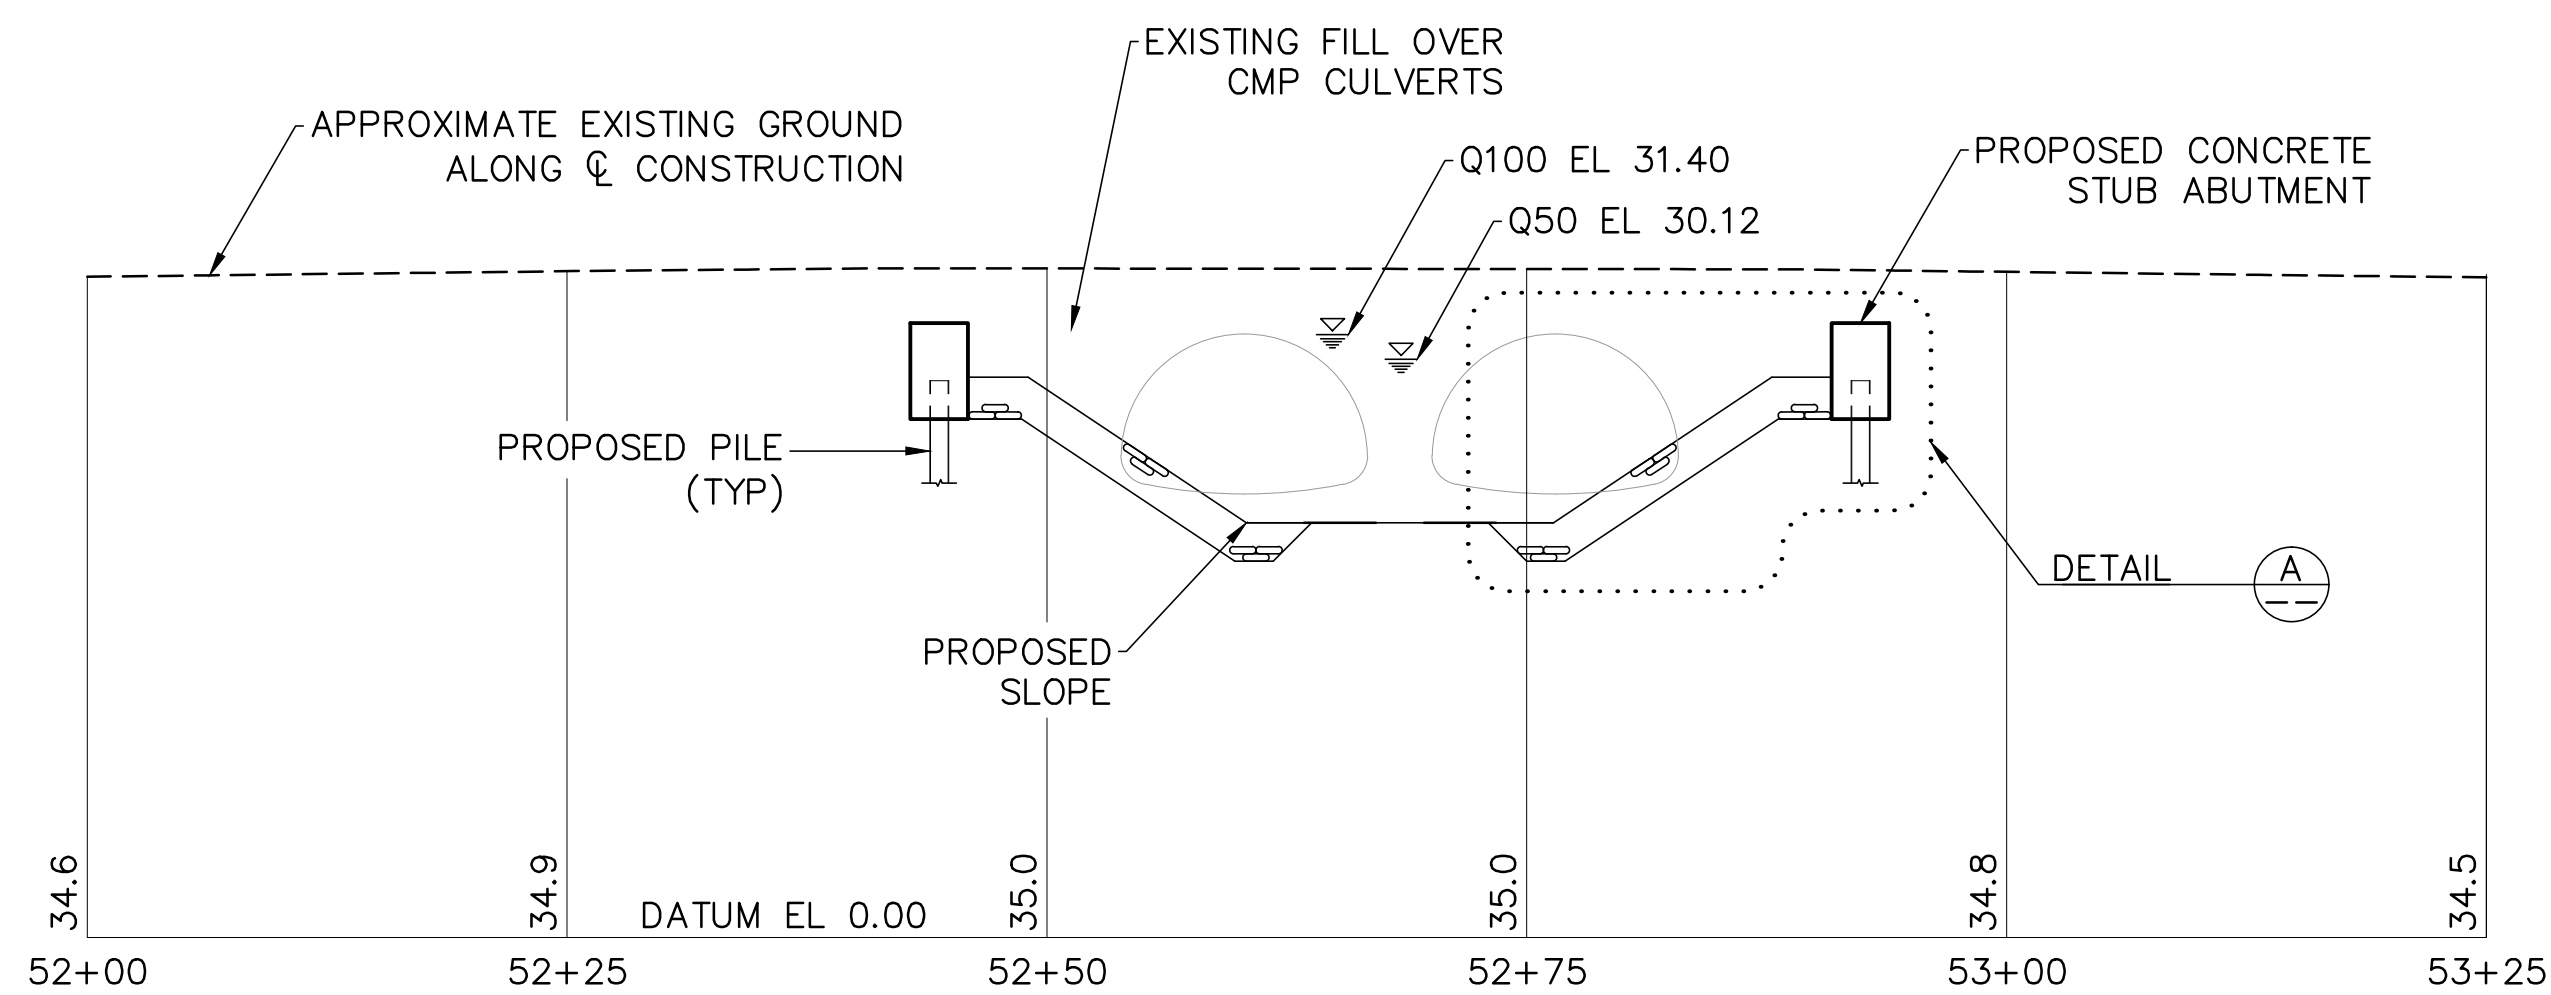

Proposed Channel Section

Scale: 1"=10'-0"

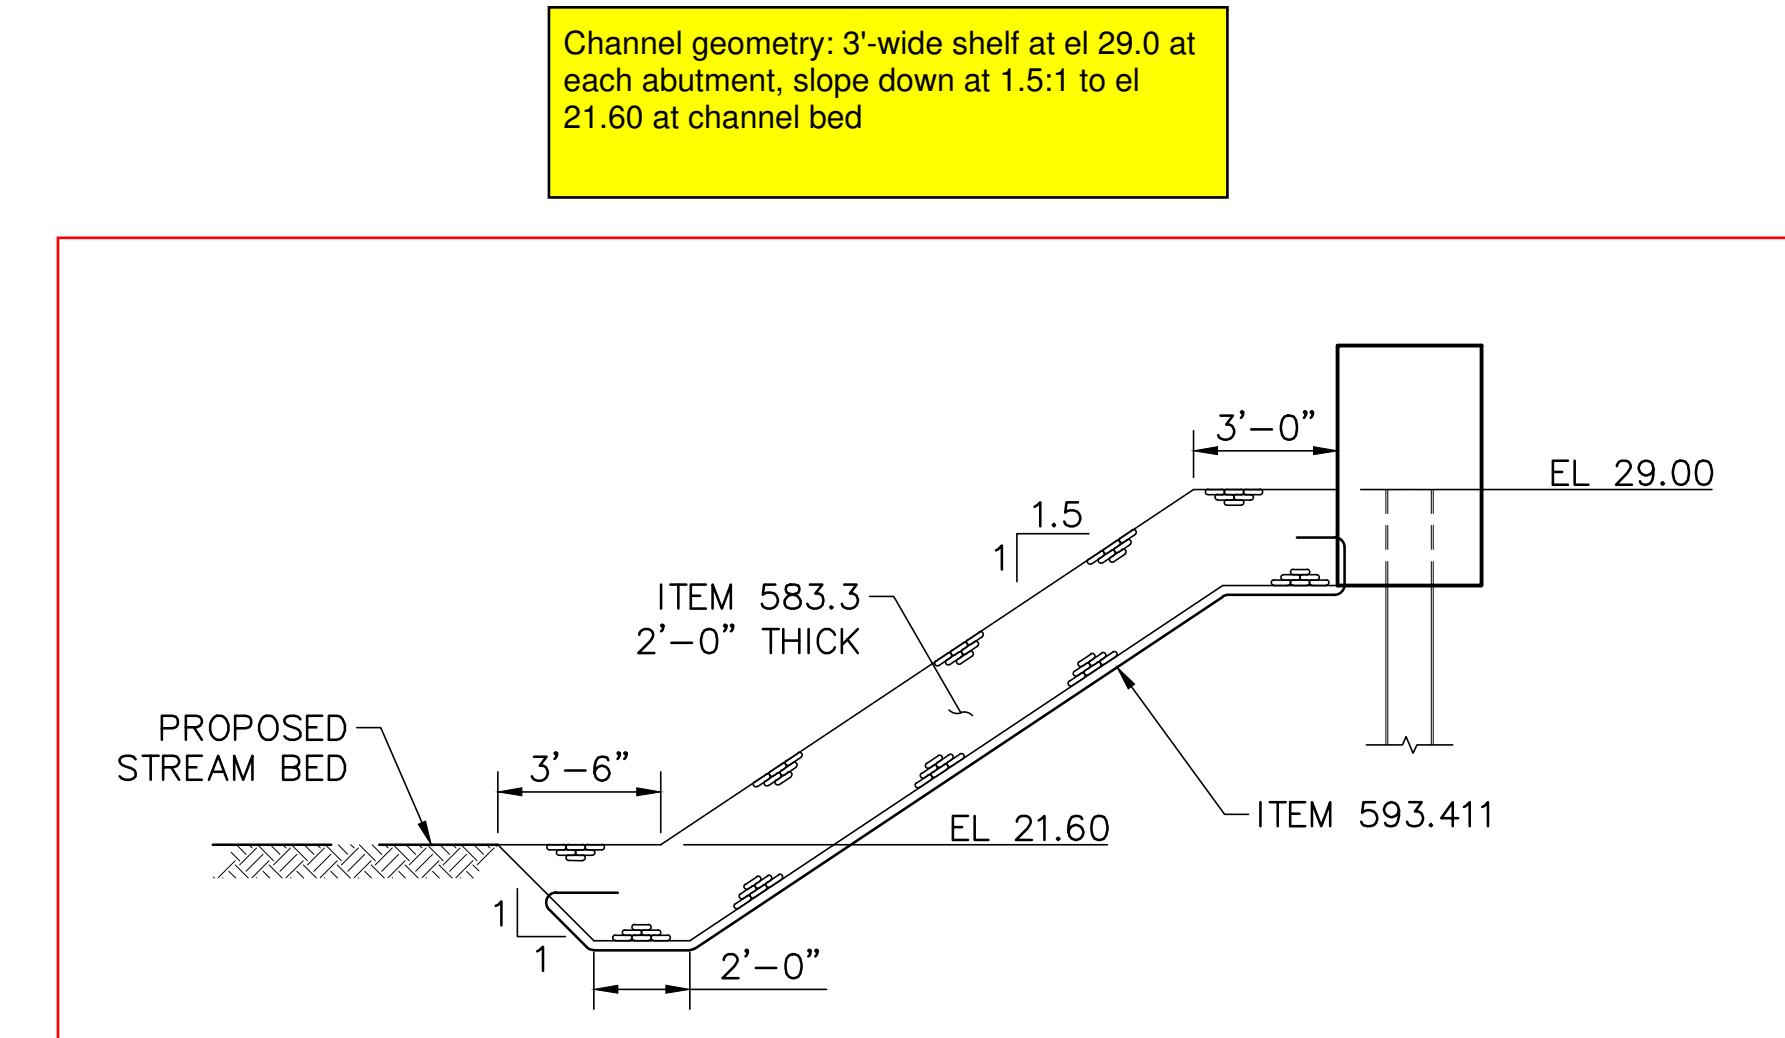

Detail

Scale: 1/4"=1'-0"



 CIVIL/ENVIRONMENTAL ENGINEERS 35 Bow Street Portsmouth, NH 03801 603.931.6196 info@cmaengineers.com	 JASON L. BURT No. 10851 State of New Hampshire	designed by: LBK/OGK	drawn by: LBK/OGK	approved by: JLG	scale: AS SHOWN
		date: July 2015	project no: 923	file name: 923 - Structural Plans.dwg	date: 1/6/16
Town of Exeter Department of Public Works Linden Street Little River Bridge Replacement Survey Layout and Channel Sections					
drawing no. B-4					
sheet: 5 of 29					

Boring No. B-1
Station 52+37.6, 8.5 Left

TEST BORING LOG


CMA Engineers, Inc. Civil/Environmental Engineers 35 Bow Street Portsmouth, NH 03801 Phone: 603.431.6196 Fax: 603.431.5376		PROJECT Description: Linden Street Bridge Location: Exeter, NH Notes: Contractor: Great Works Pump & Test Boring, Inc.		Test Boring Number B-1
CMA Engineer: Bob Grillo		Equipment: Acker Track Rig		Ground Elevation: 35' +/-
File Number: #923		Operator: Peter Michaud		Weather: Sun 80F
Depth	Sample No. Depth (ft)	Blow Count	Sample Descriptions and Classifications	Remarks
1	S-1 0.5' - 2.5'	16	Brown Sand and Gravel, trace Silt. Dry. Fill.	4" Asphalt Solid stem augers to advance boring.
2		17		
3		14		
4		14		
5	S-2 5' - 7'	5	Same. Moist.	Obstruction at 9'. Bridge Abutment? Move 2' south.
6		3		
7		5		
8		4		
9	S-3 10' - 12'	2	Brown-Gray Silty Clay with brick fragments. Fill.	
10		2		
11		5		
12		8		
13	S-4 12' - 14'	7	Brown-Gray Silty Clay with organics. Fill.	
14		7		
15		9		
16		9		
17	S-5 15' - 17'	6	Brown-Gray Silty Clay. Fill.	
18		6		
19		9		
20		10		
21	S-6 17' - 19'	8	No Recovery	Rock in Spoon tip.
22		5		
23		5		
24		5		
25	T-1 20' - 22'		Gray Silty Clay	Drove 4" Casing to 20', wash boring.
26	Vane Shear 22' - 22.75'		730 psf	
27	Vane Shear 22.75' - 23.5'		650 psf	
28	Vane Shear 25' - 25.75'		530 psf	

BOTTOM OF STUB ABUTMENT ABUTMENT A (EL. 27.0)

Boring No. B-1
(Continued)


TEST BORING LOG

CMA Engineers, Inc. Civil/Environmental Engineers 35 Bow Street Portsmouth, NH 03801 Phone: 603.431.6196 Fax: 603.431.5376		PROJECT Description: Linden Street Bridge Location: Exeter, NH Notes: Contractor: Great Works Pump & Test Boring, Inc.		Test Boring Number B-1
CMA Engineer: Bob Grillo		Equipment: Acker Track Rig		Ground Elevation: 35' +/-
File Number: #923		Operator: Peter Michaud		Weather: Sun 80F
Depth	Sample No. Depth (ft)	Blow Count	Sample Descriptions and Classifications	Remarks
26	Vane Shear 25.75' - 26.5'		530 psf	
27				
28				
29				
30	S-7 30' - 30.1'	50/.5"		— Changed to Granular Soil at 28.8' Refused at 30.1'
31				
32				
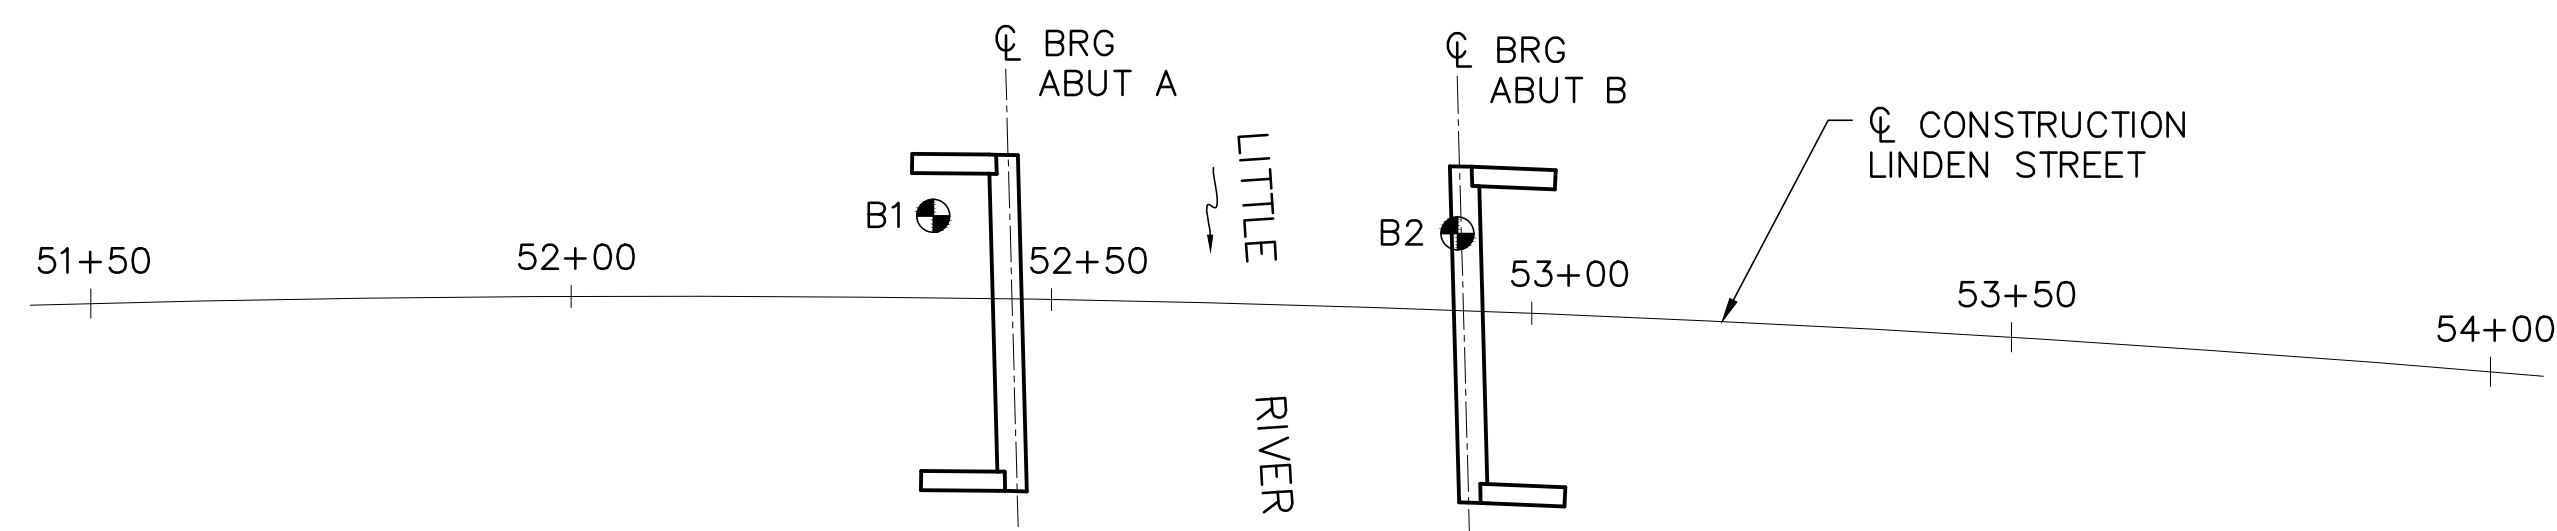


Proposed Channel Section
Scale: 1" = 20'-0"

10/16	JLG	by
0	AS-BUILT	no.
0		revision
<p>10 Free Street Portland, Maine 04101 207.541-4225</p> <p>35 Bow Street Portsmouth, NH 03801 603.431-6196</p> <p>info@cmaengineers.com www.cmaengineers.com</p>		
date: July 2015	designed by: LBK/OGK	drawn by: LBK/OGK
project no: 923	approved by: JLG	scale: AS SHOWN
file name: 923 - Structural Plans.dwg		
<p>Town of Exeter Department of Public Works Linden Street Little River Bridge Replacement Boring Logs (Sheet 1 of 2)</p>		
drawing no. B-5		
sheet: 6 of 29		

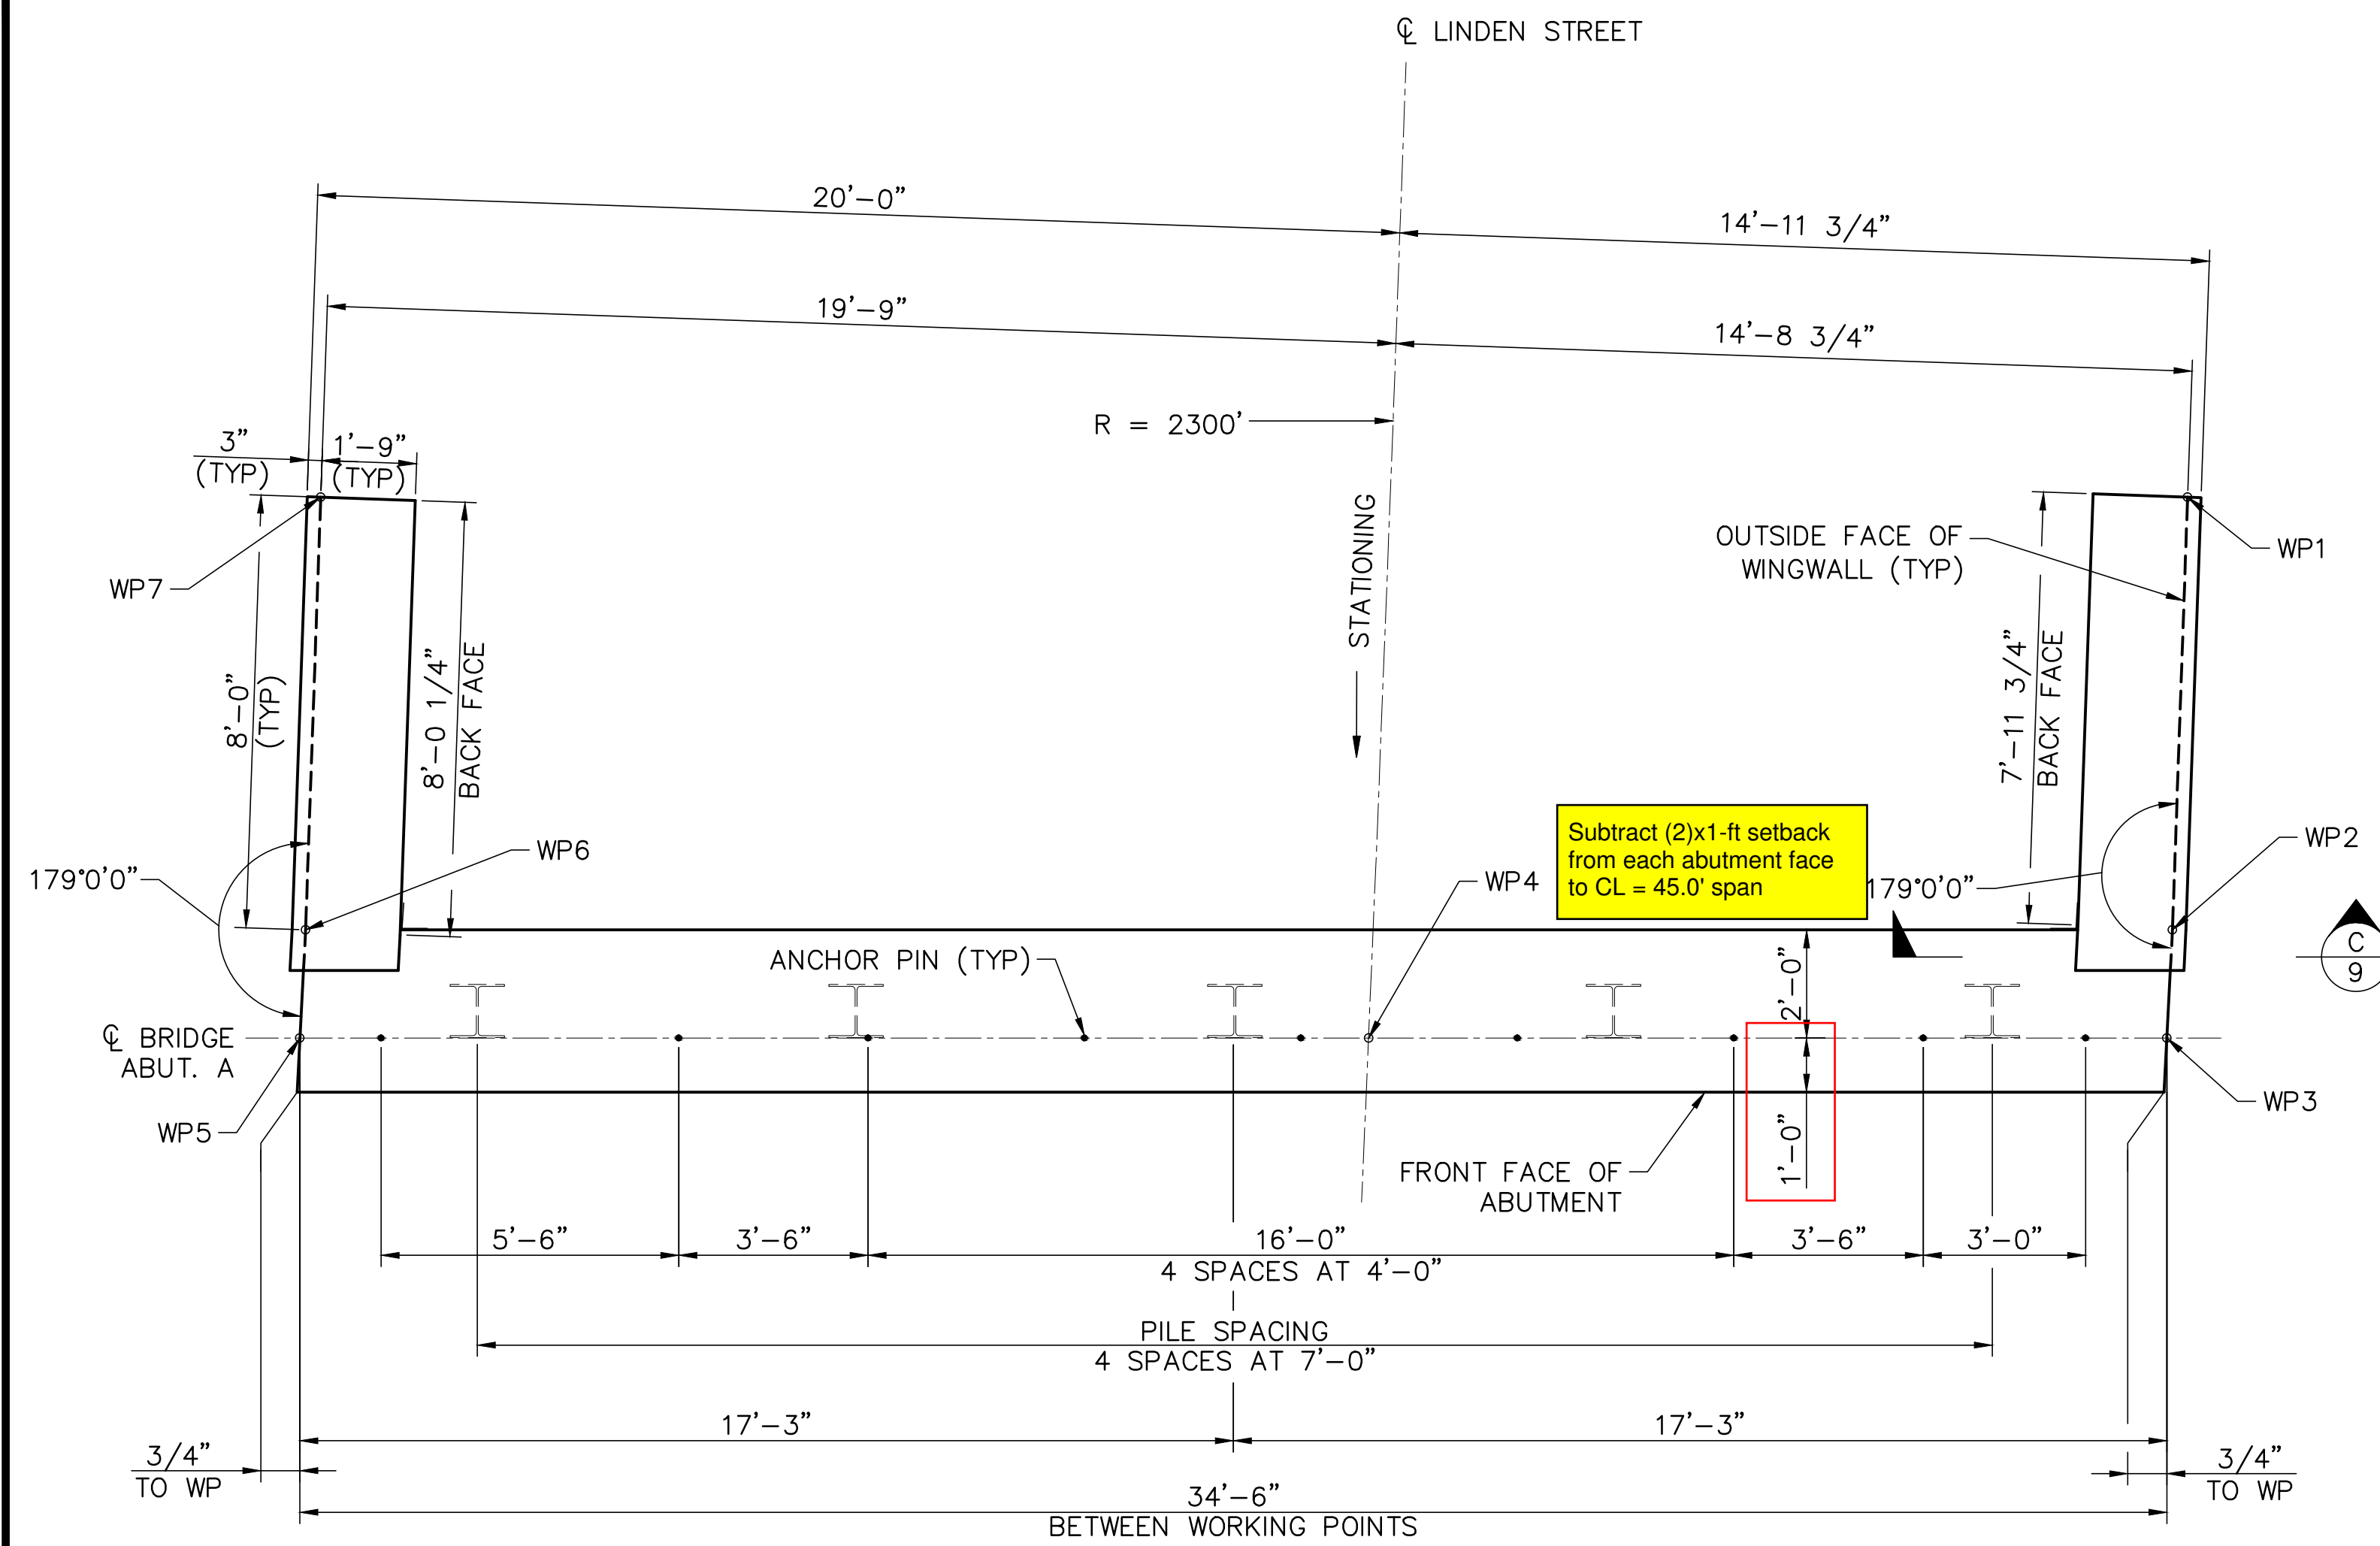


Abutment A Plan

Scale: 3/8"=1'-0"

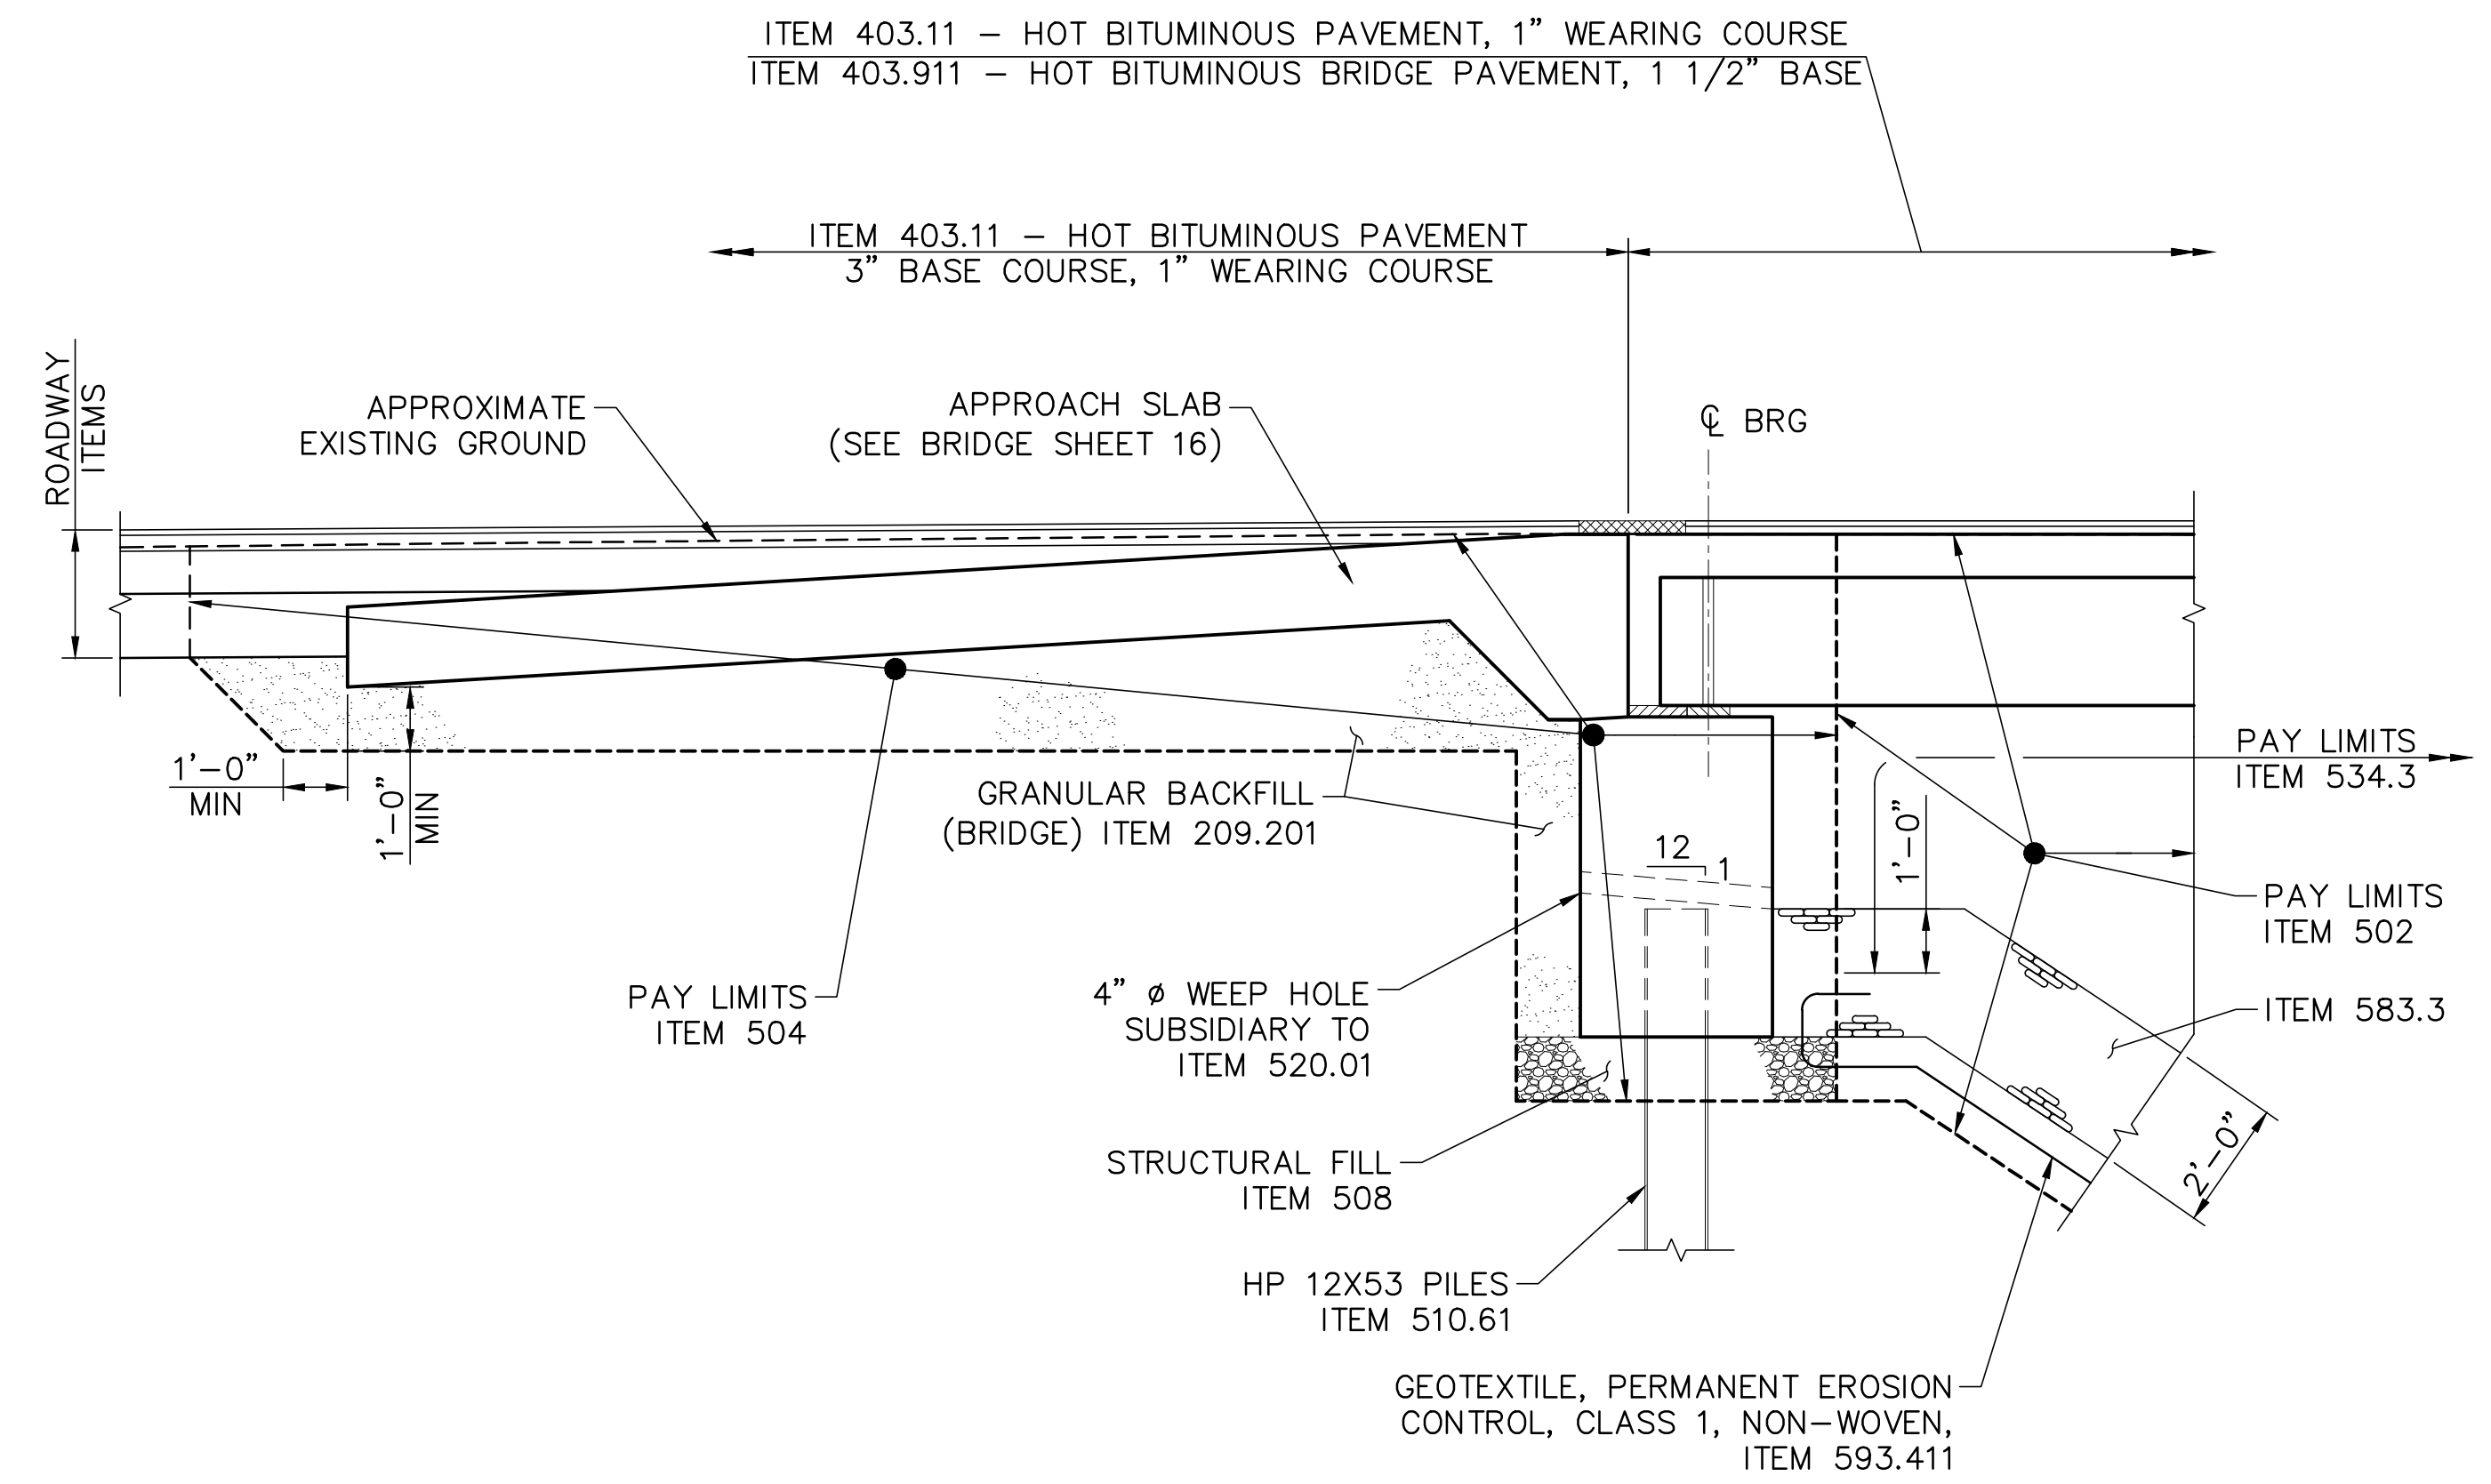

Typical Abutment Section


Scale: 3/8"=1'-0"

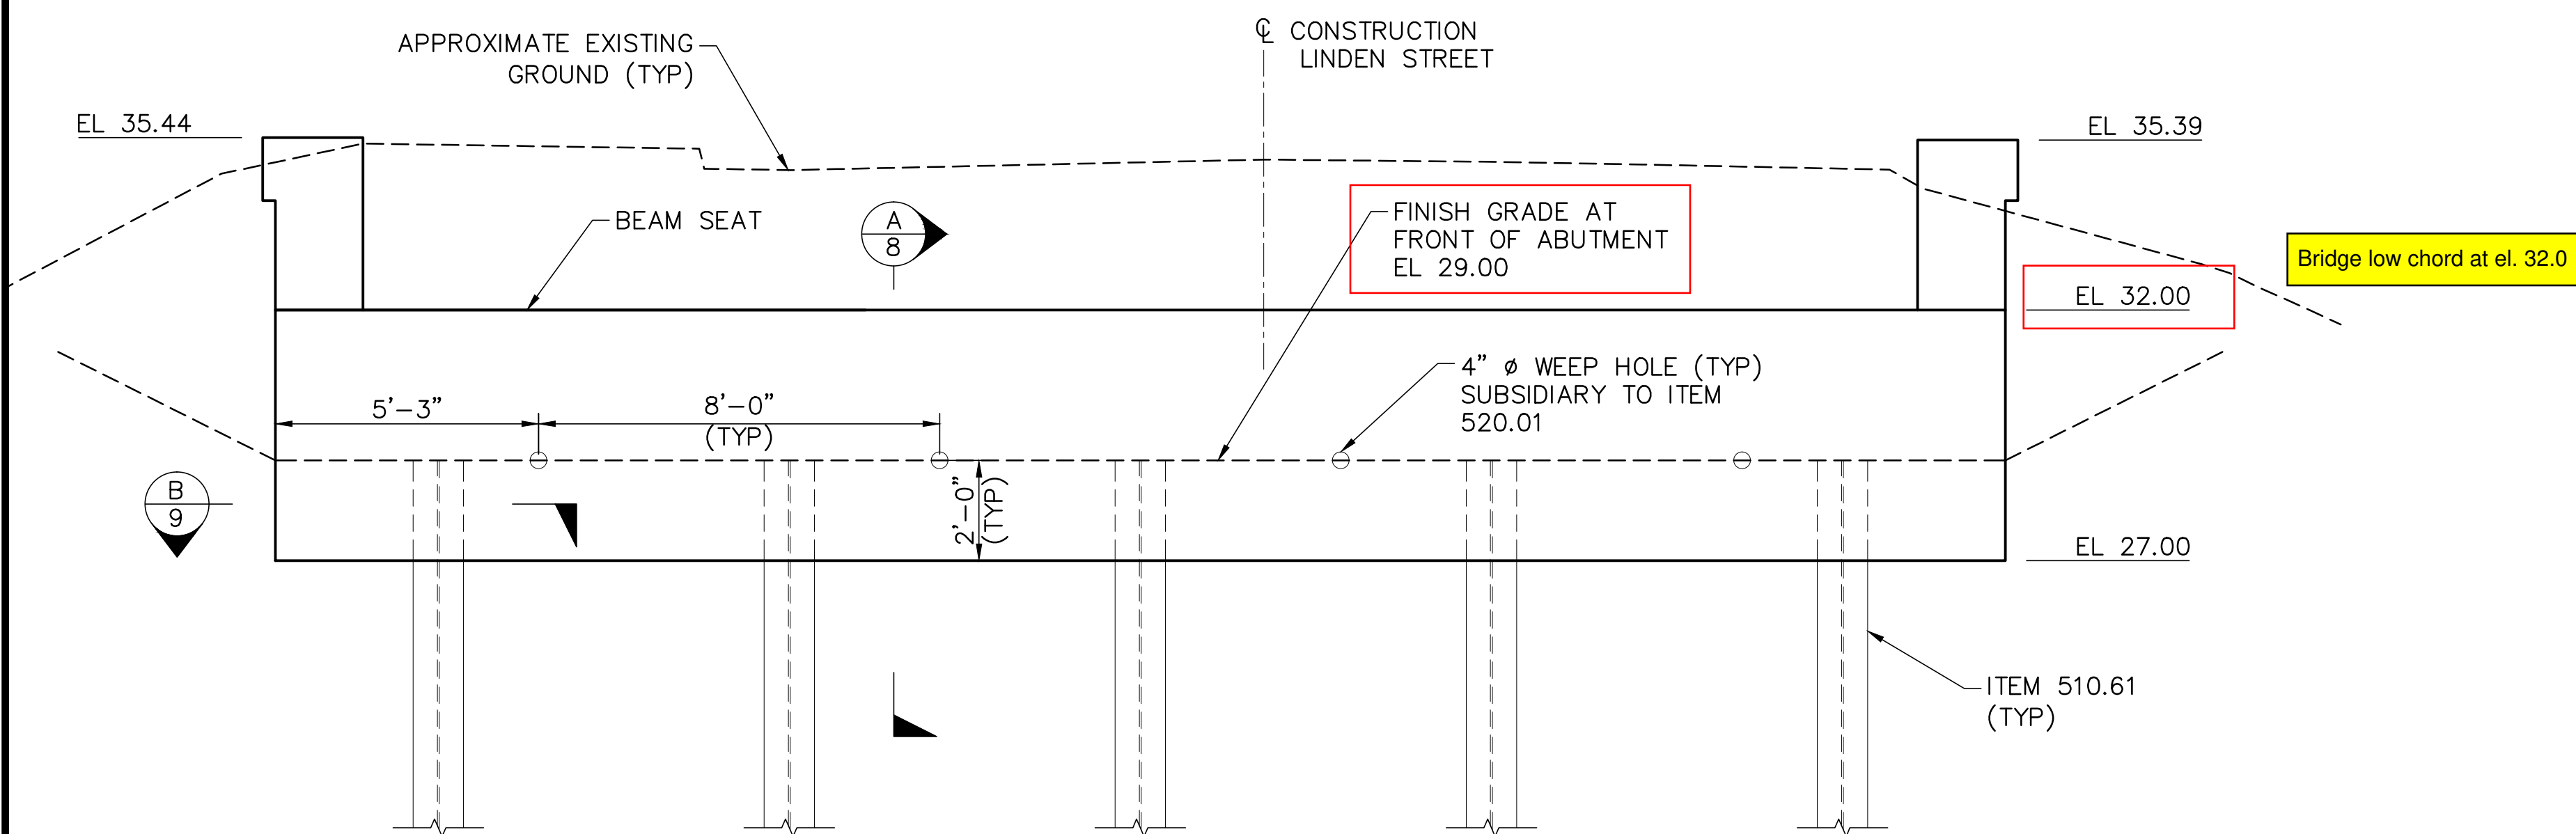

Abutment A Elevation


Scale: 3/8"=1'-0"

designed by: LBK/OGK		date: July 2015	
drawn by: LBK/OGK		project no: 923	
approved by: JLG		file name: 923 - Structural Plans.dwg	
scale: AS SHOWN		revision 0 AS-BUILT	
<p>CMA ENGINEERS CIVIL/ENVIRONMENTAL ENGINEERS</p> <p>35 Bow Street Portsmouth, NH 03801 603-931-6196</p> <p>10 Free Street Portland, Maine 04101 207-561-4225</p> <p>www.cmaengineers.com</p>		<p>1/6/16 JLG</p> <p>by</p>	
<p>Town of Exeter Department of Public Works Linden Street Little River Bridge Replacement Abutment A Plan and Elevation</p>			
drawing no. B-7			
sheet: 8 of 29			

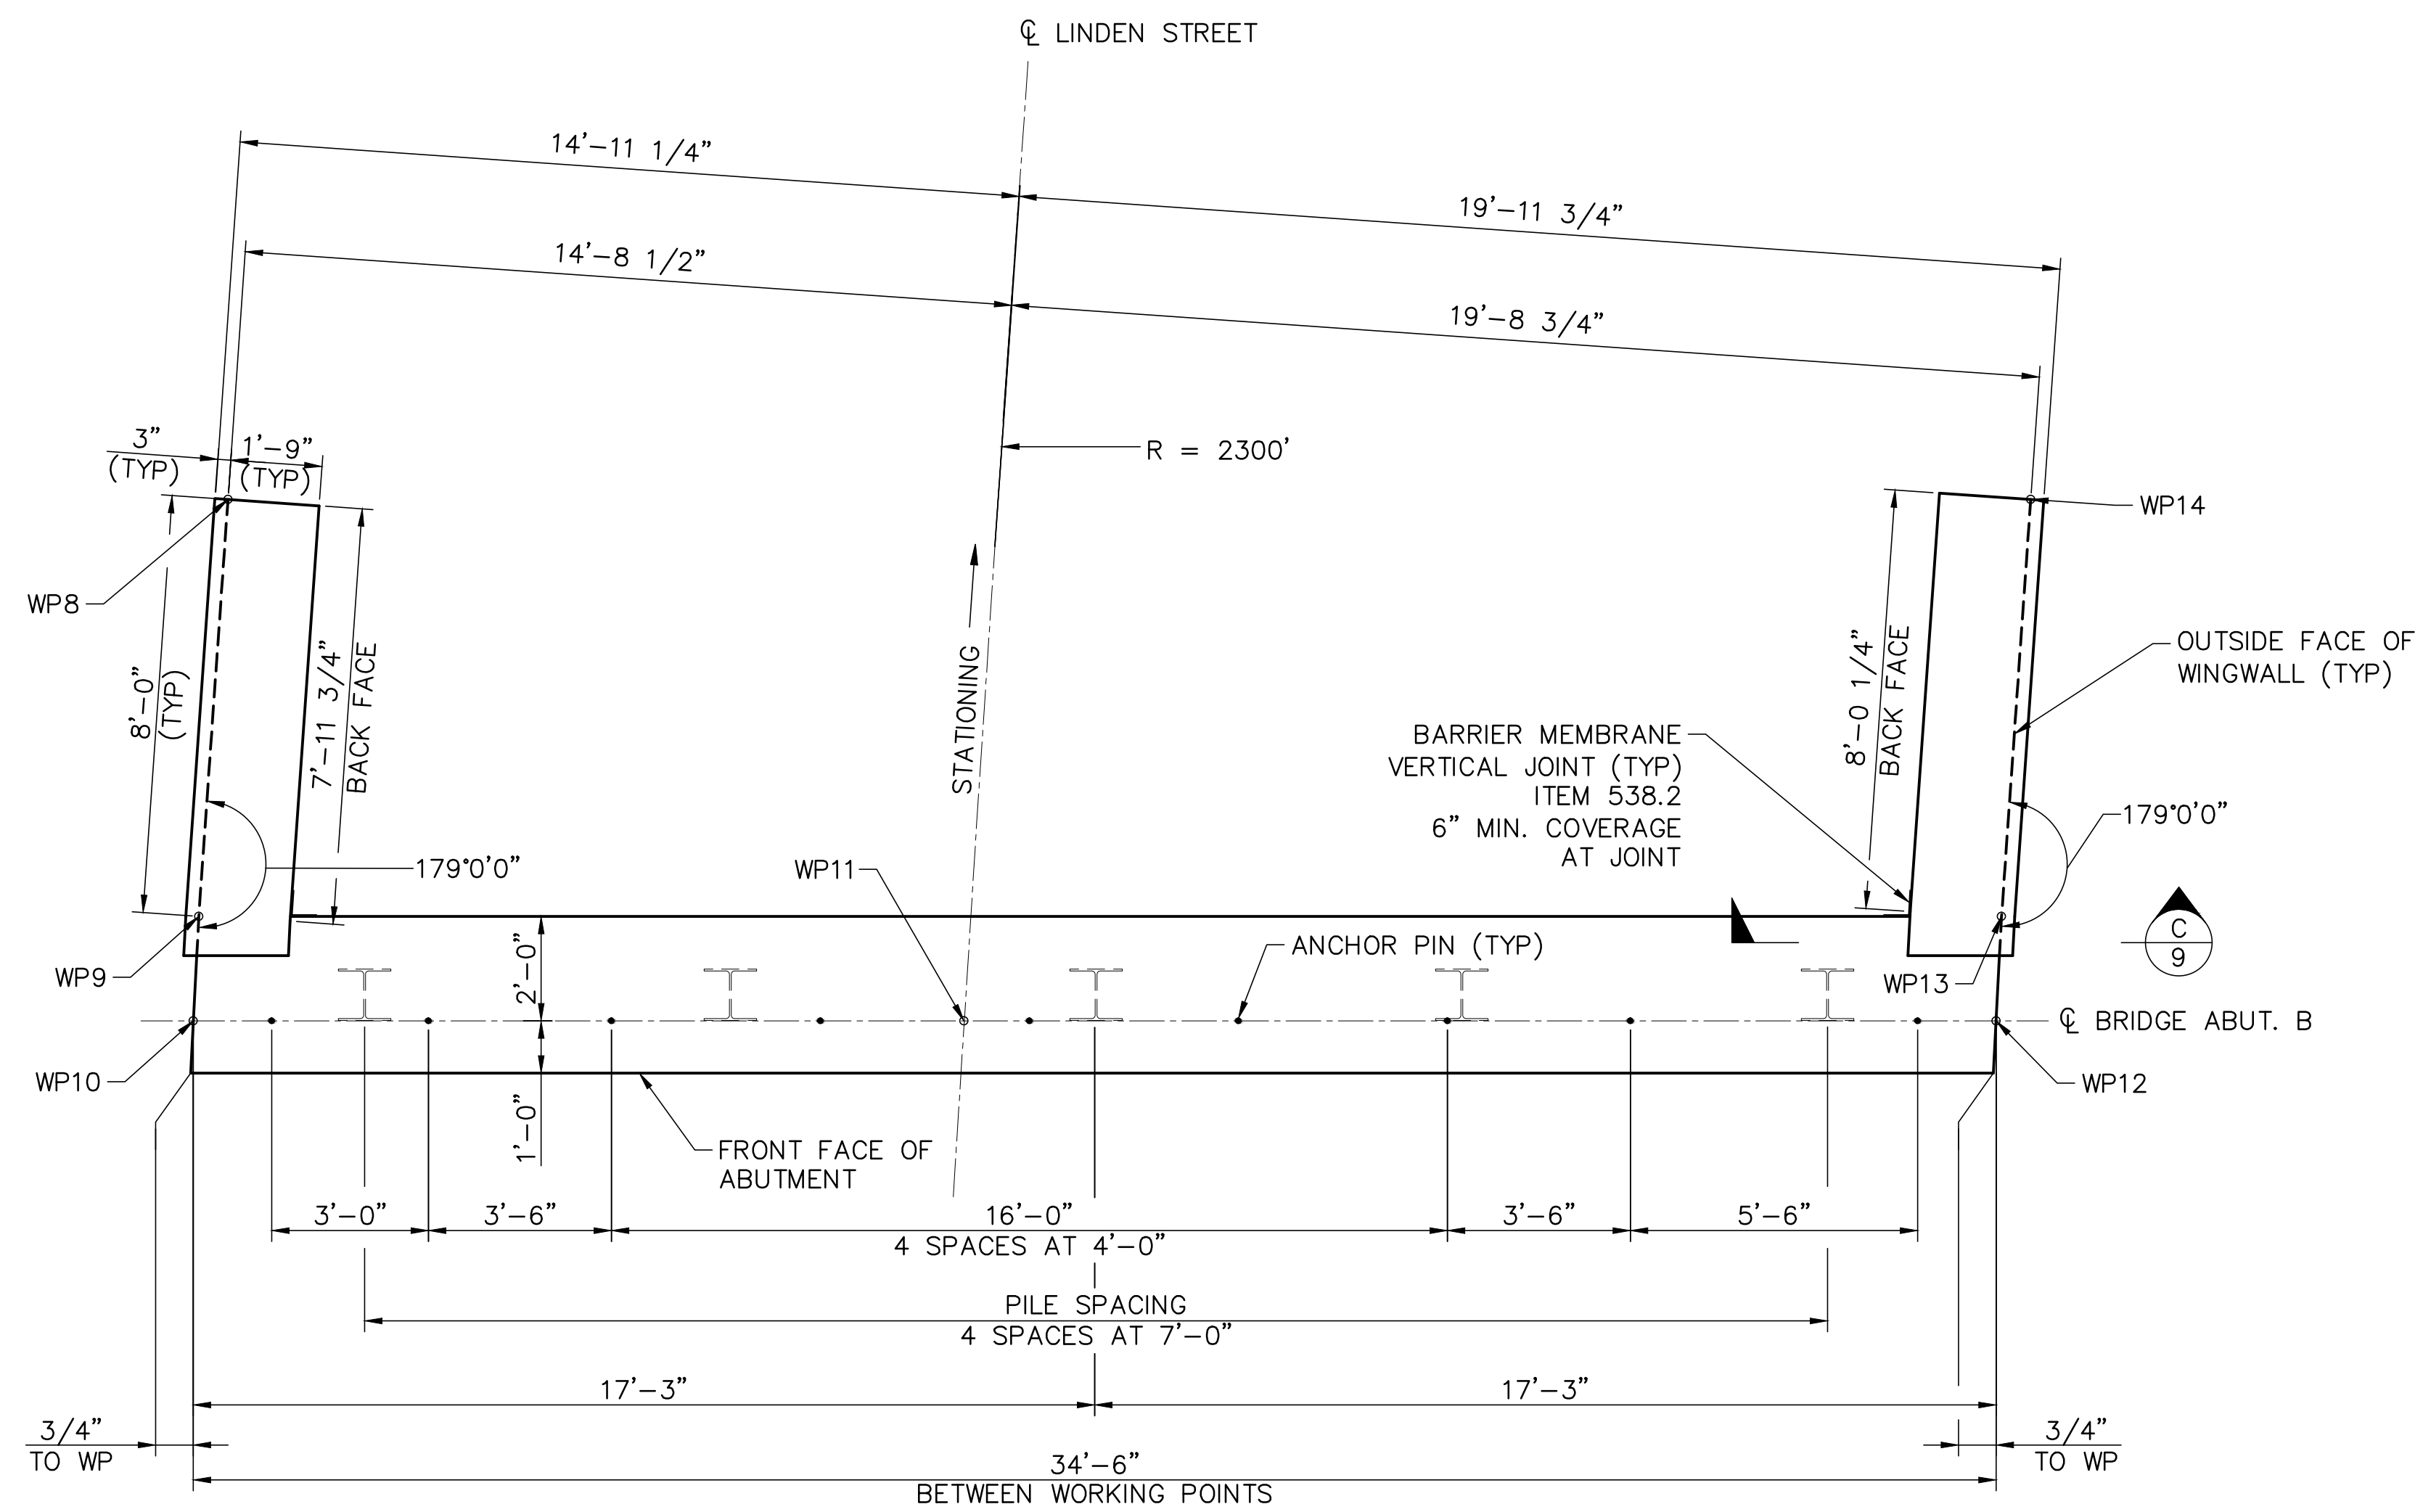



Abutment B Plan

Scale: 3/8"=1'-0"

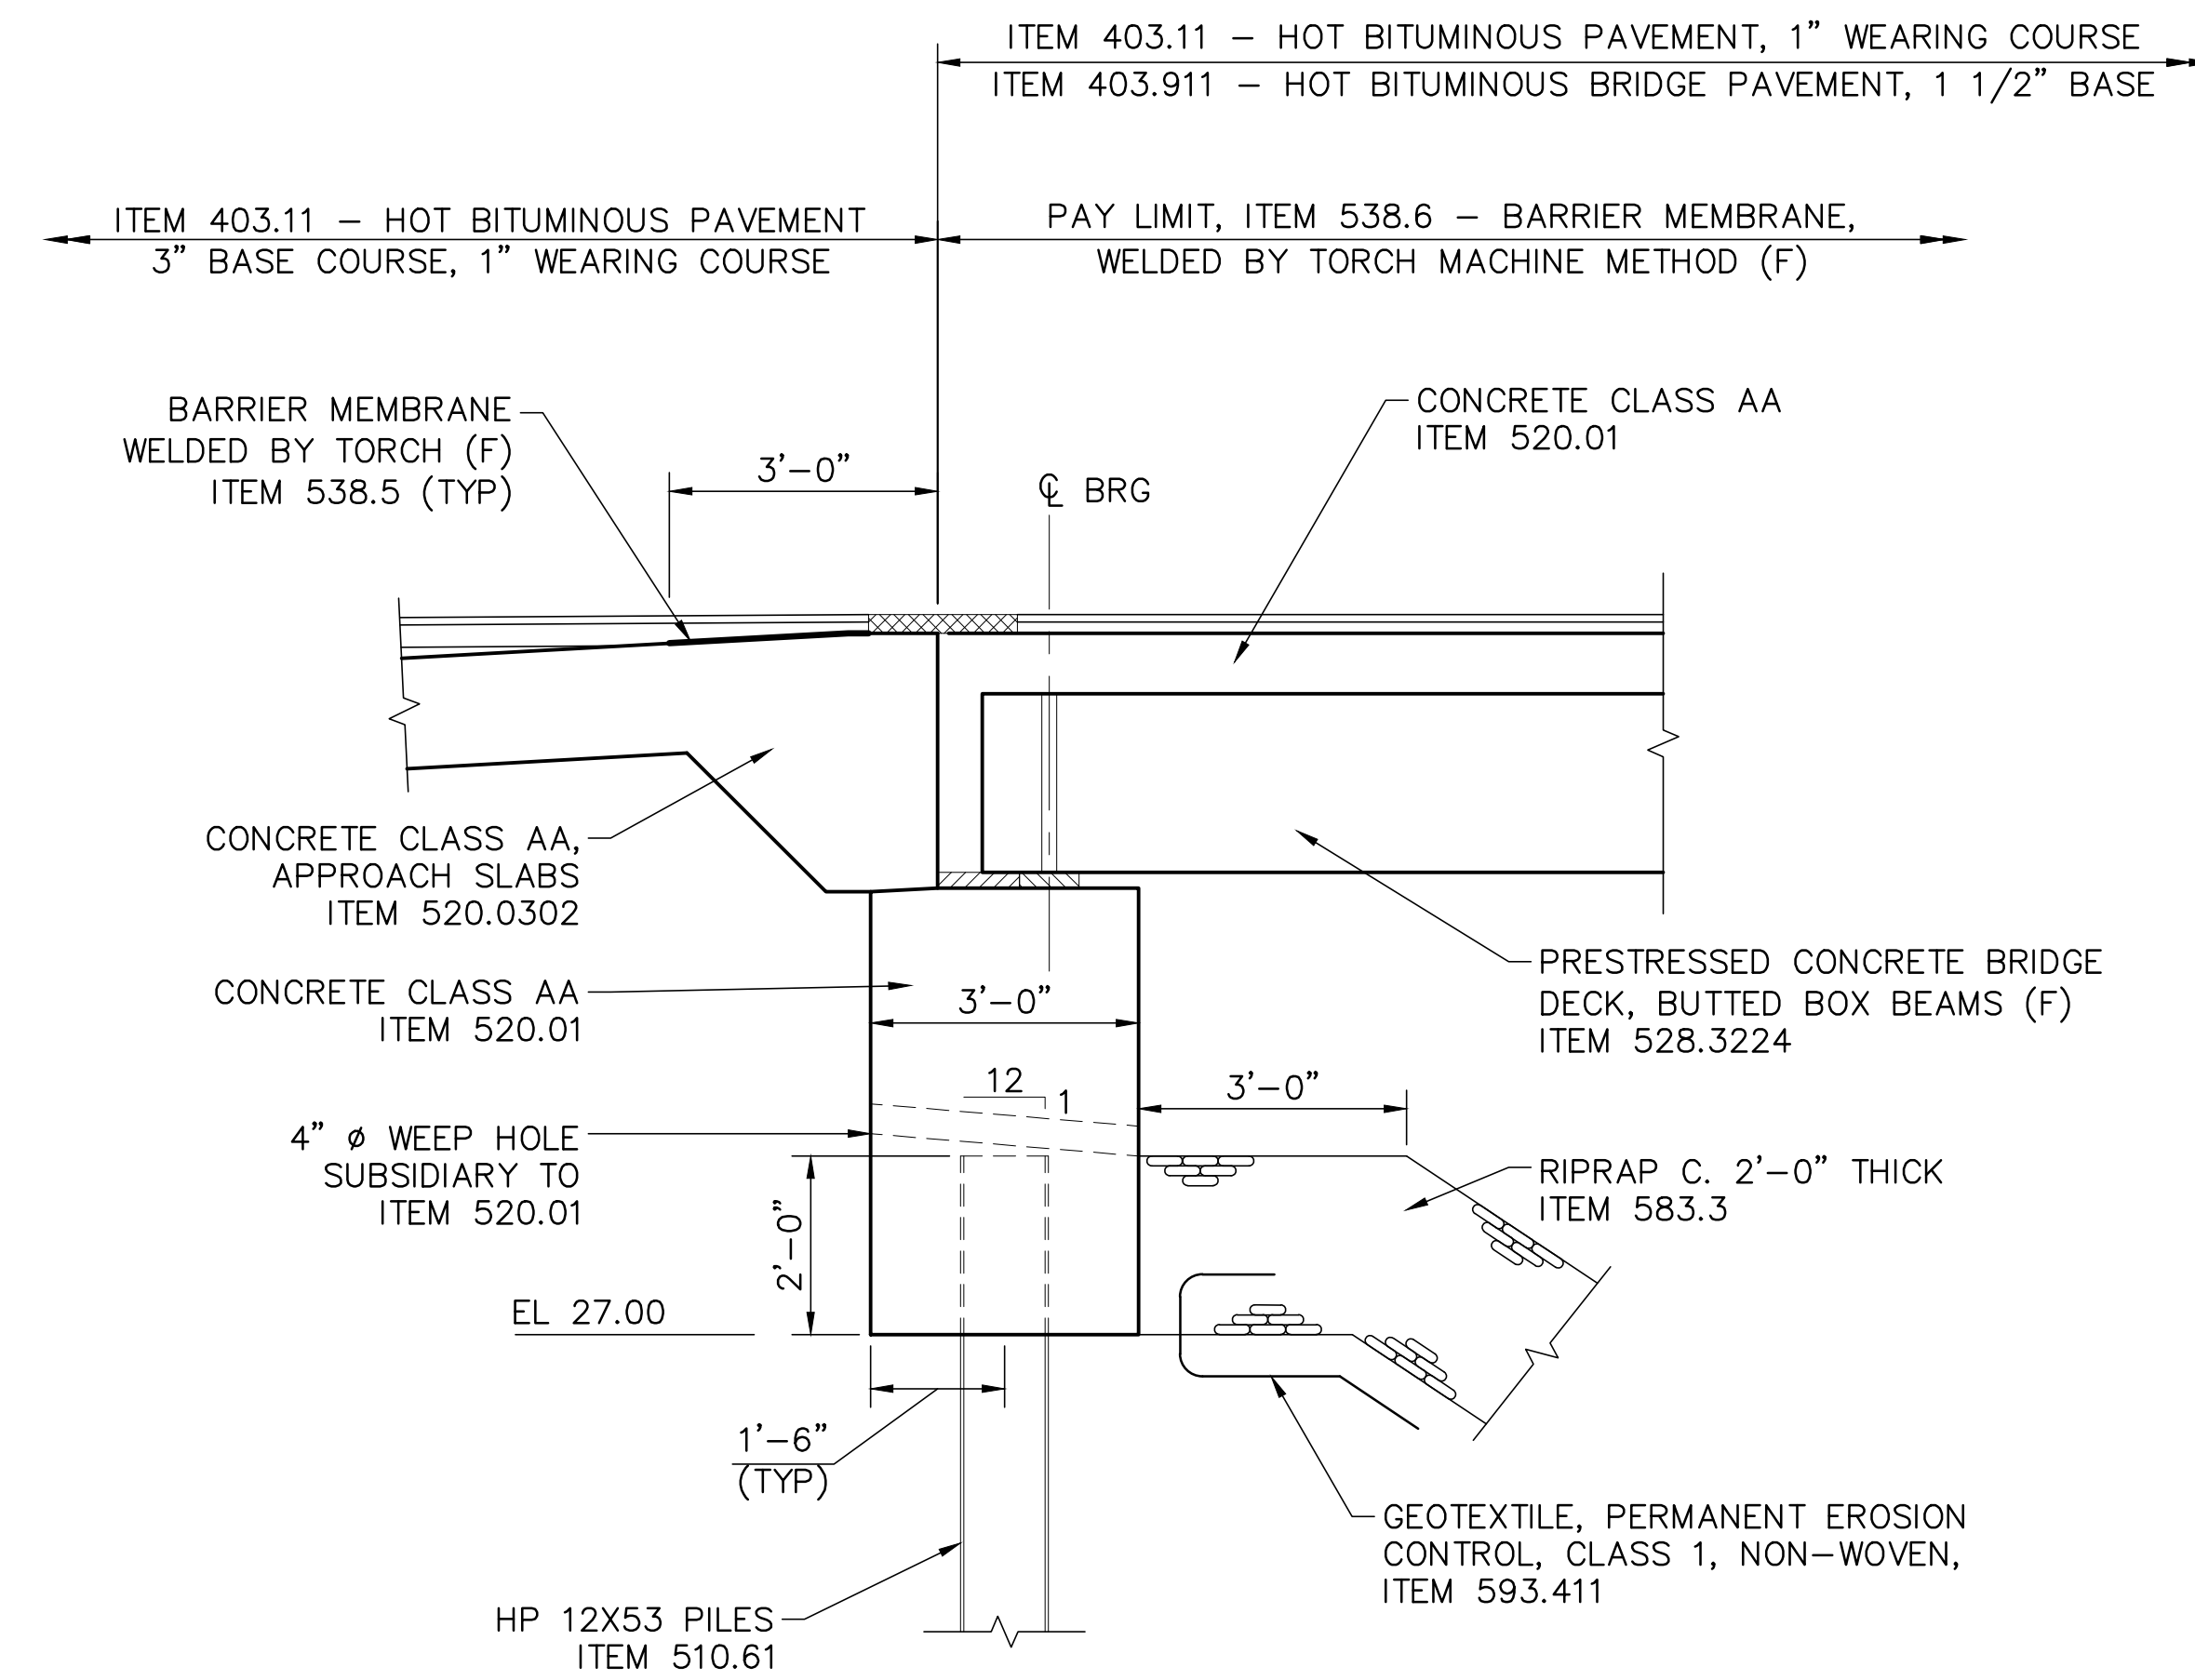

Section

Scale: 1/2"=1'-0"

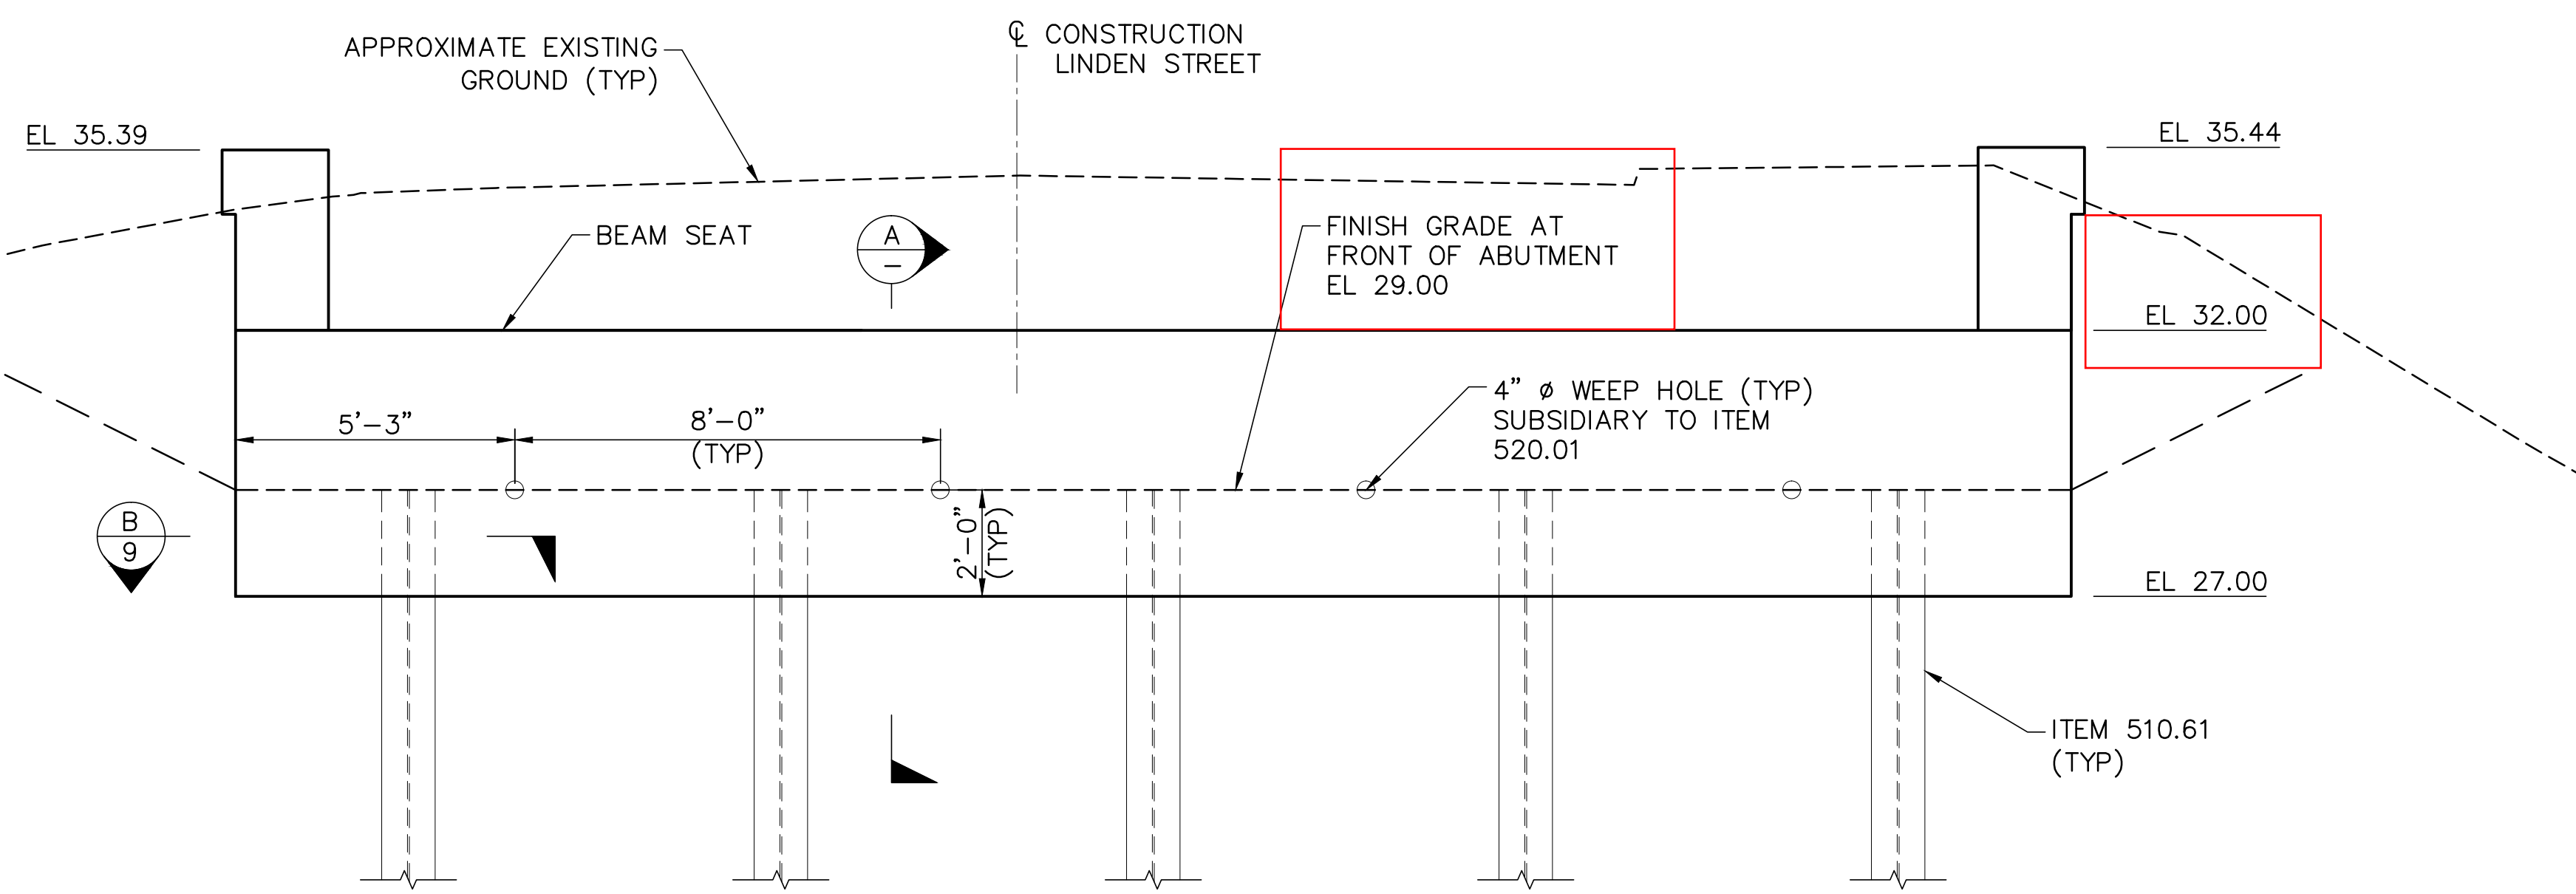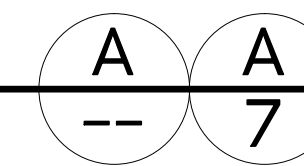


Abutment B Elevation

Scale: 3/8"=1'-0"

revision	no.	date	by
0	AS-BUILT	1/6/16	JLG


CMA ENGINEERS
 CIVIL/ENVIRONMENTAL ENGINEERS
 35 Bow Street Portsmouth, NH 03801 603-431-6196
 10 Free Street Portland, Maine 04101 207-561-4225
 55 So. Commercial Street Manchester, NH 03101 603-627-0708
 www.cmaengineers.com info@cmaengineers.com

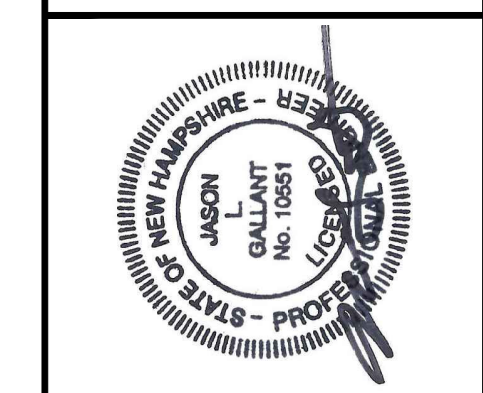

designed by:	LBK/OGK
drawn by:	LBK/OGK
approved by:	JLG
date:	July 2015
project no:	923
file name:	923 - Structural Plans.dwg
scale:	AS SHOWN


Town of Exeter
 Department of Public Works
 Linden Street
 Little River Bridge Replacement
 Abutment B Plan
 and Elevation

F:\CADD\PROJECTS\923-Exeter Bridges\Production\Linden St\As-Built\923 - Structural Plans.dwg Date Plotted: Jan 06, 2016 - 2:04pm Plotted By: LKALLOCH

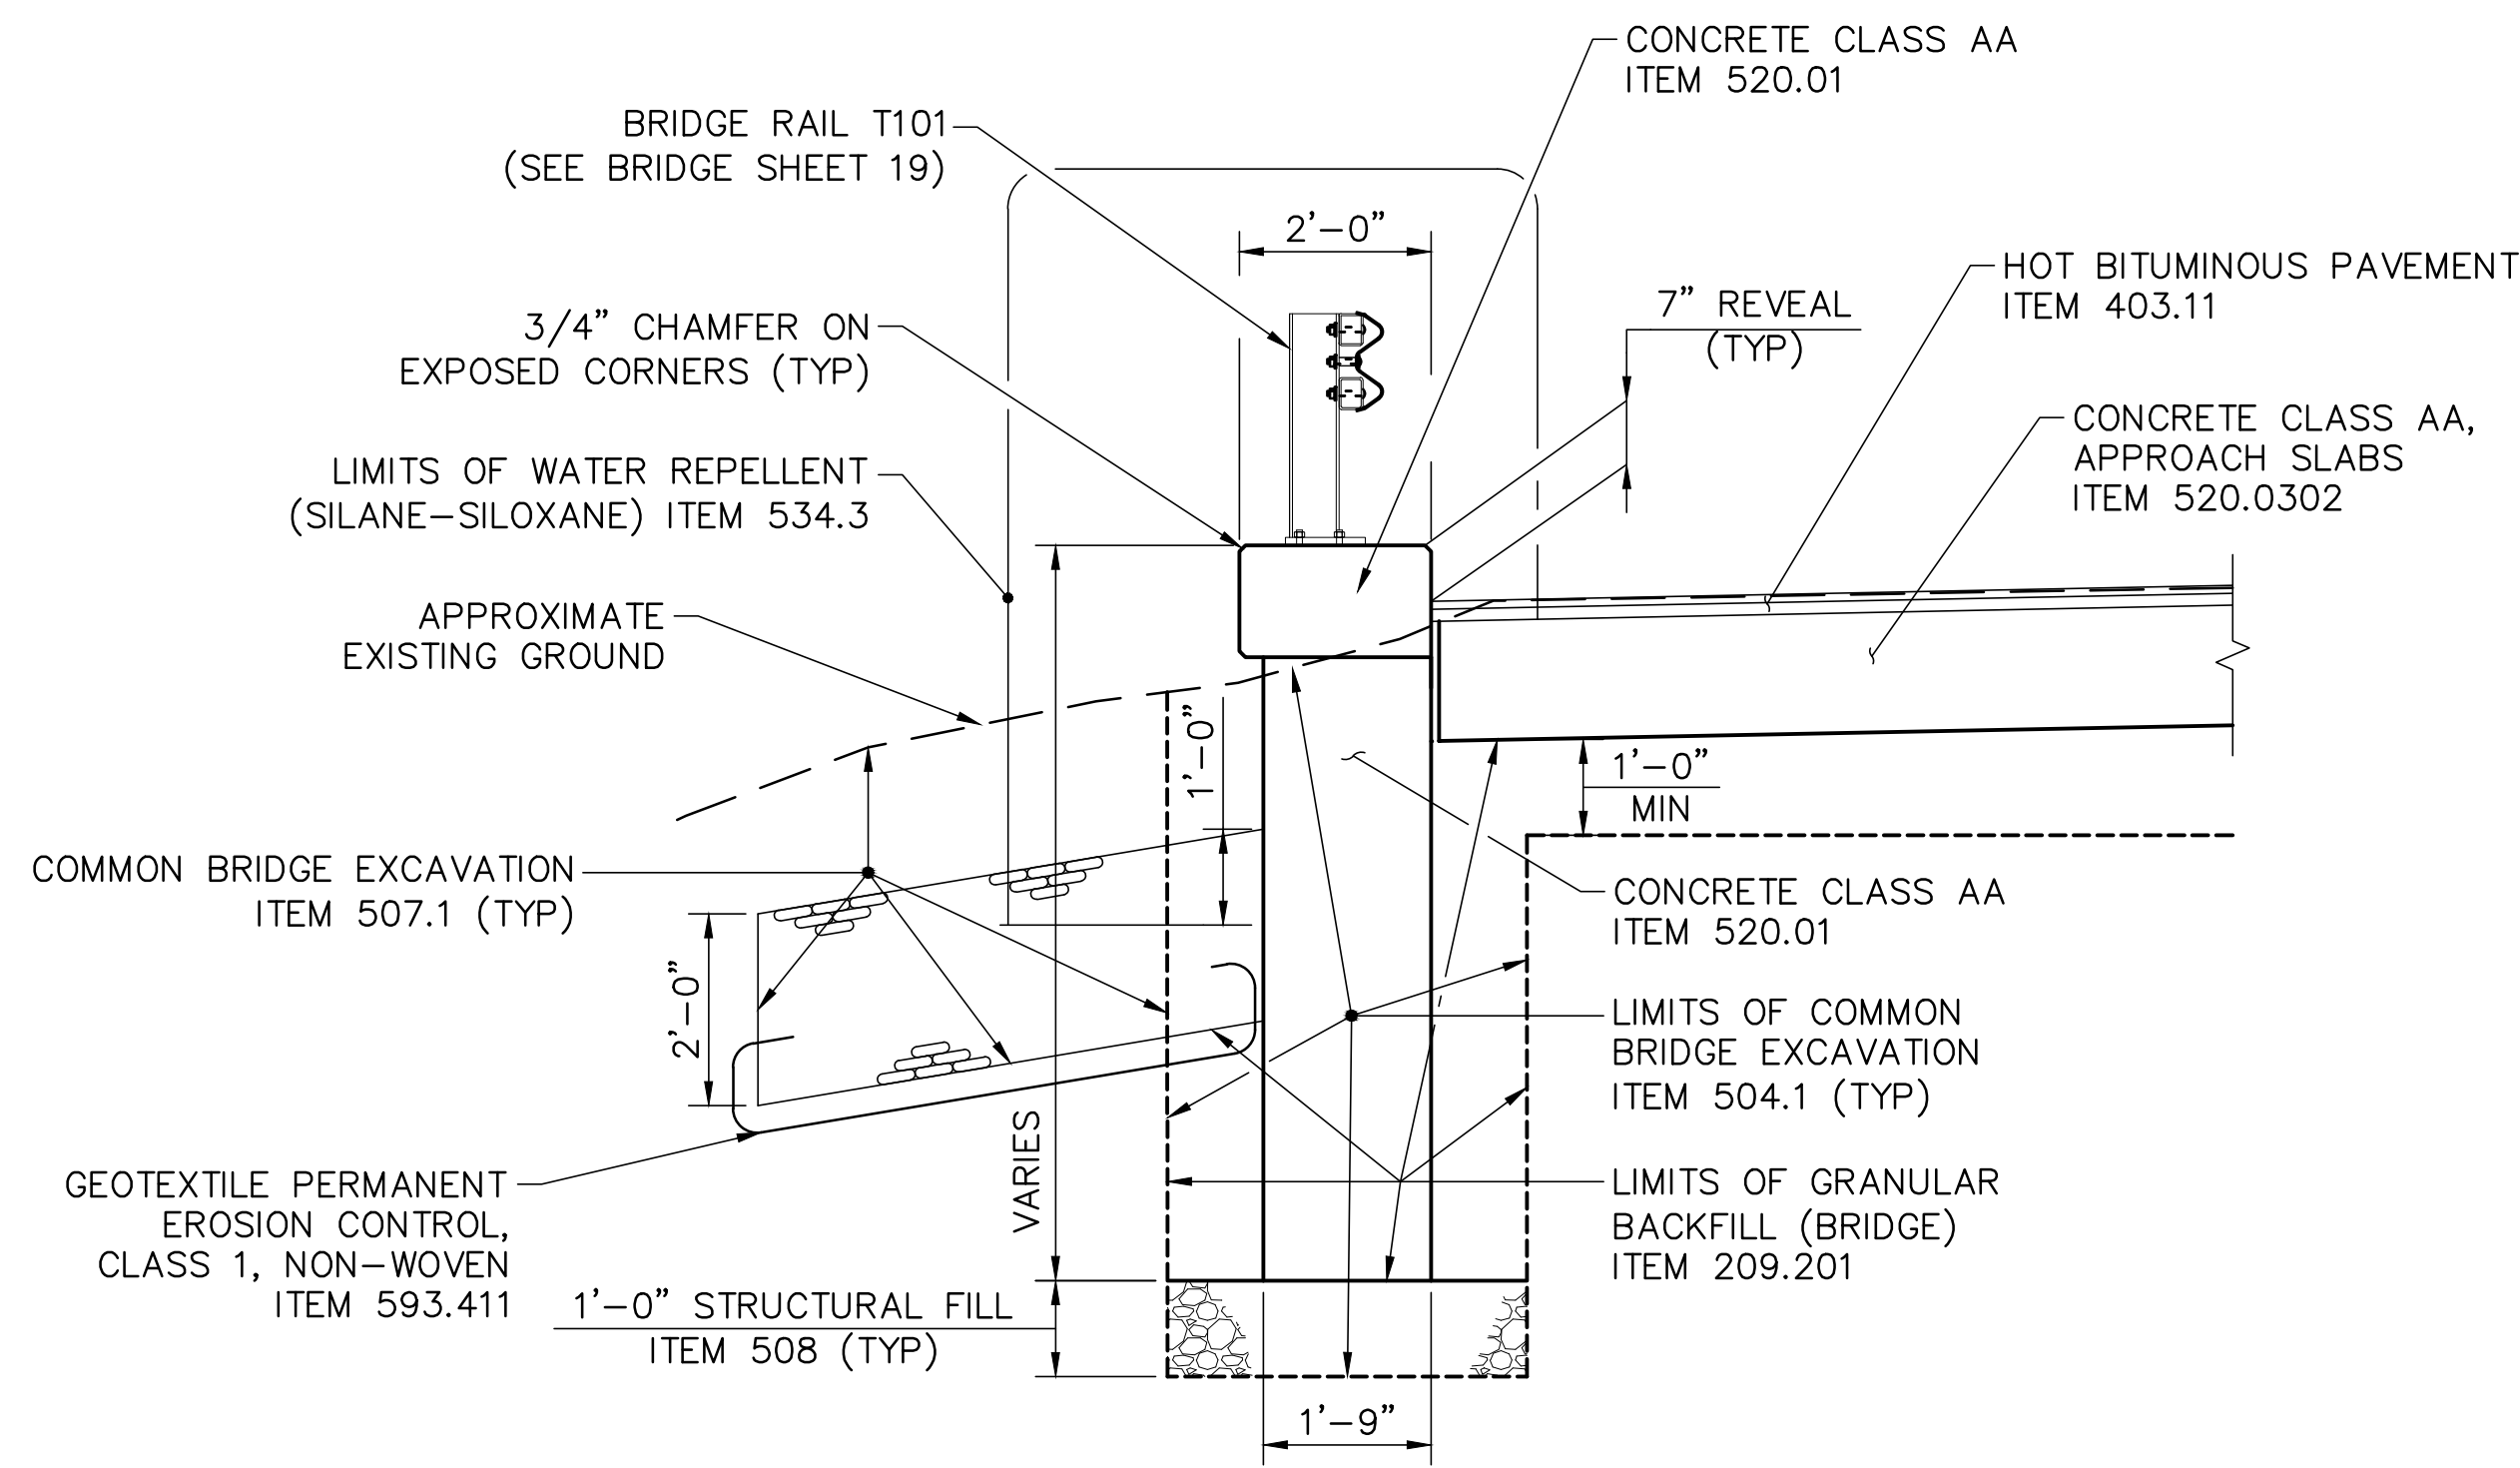


Typical Wingwall Section

Scale: 1/2"=1'-0"

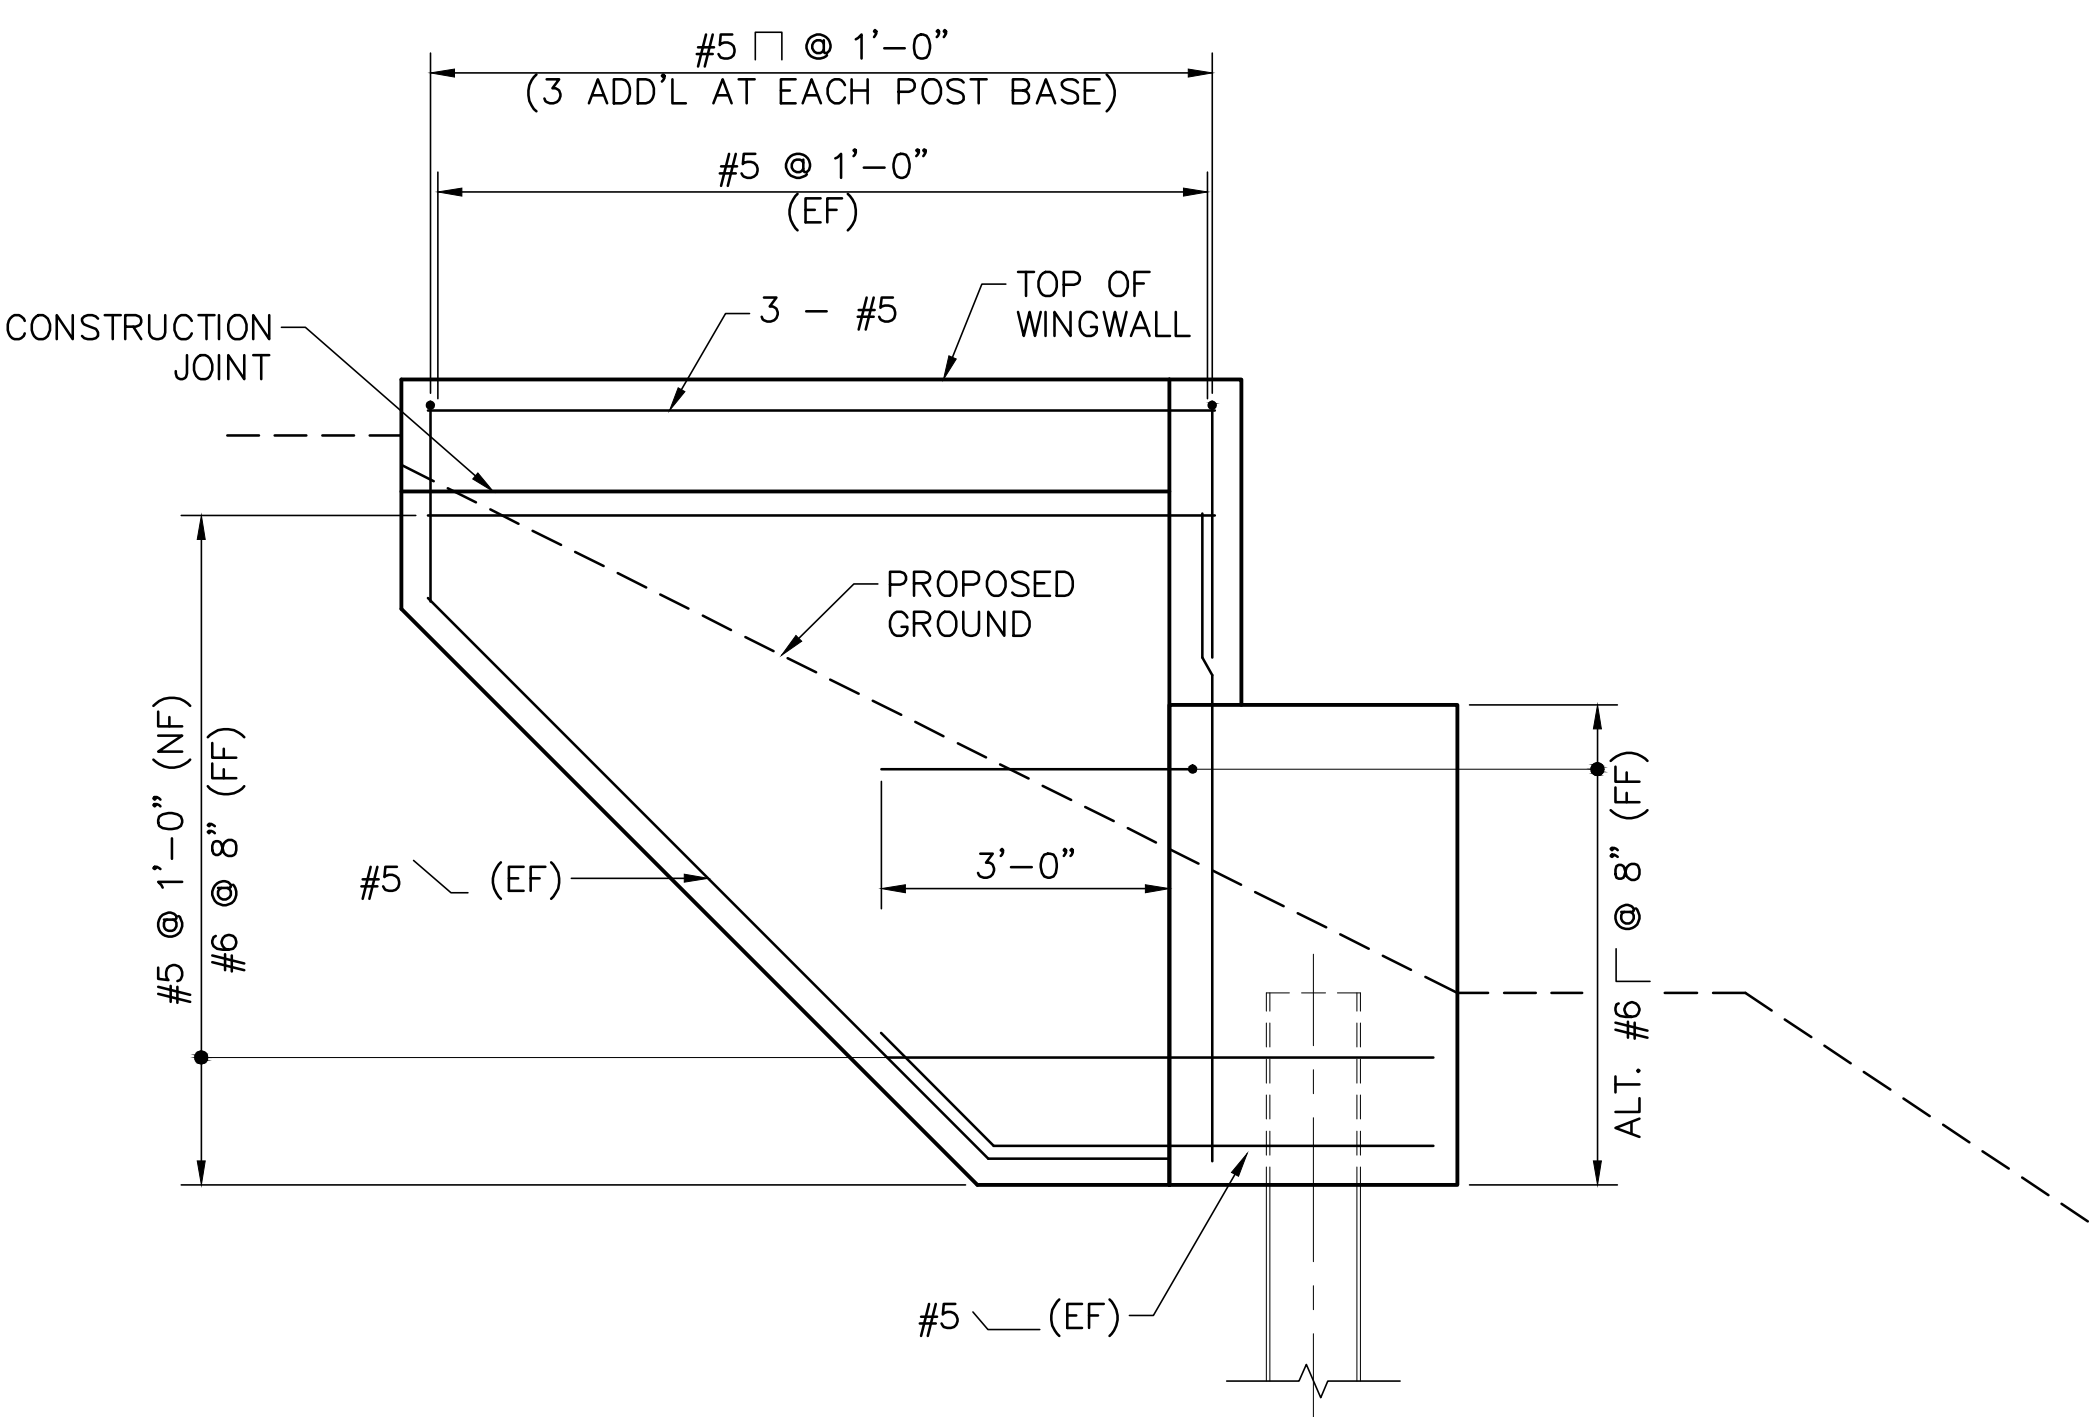



Wingwall Reinforcement

Scale: 1/2"=1'-0"

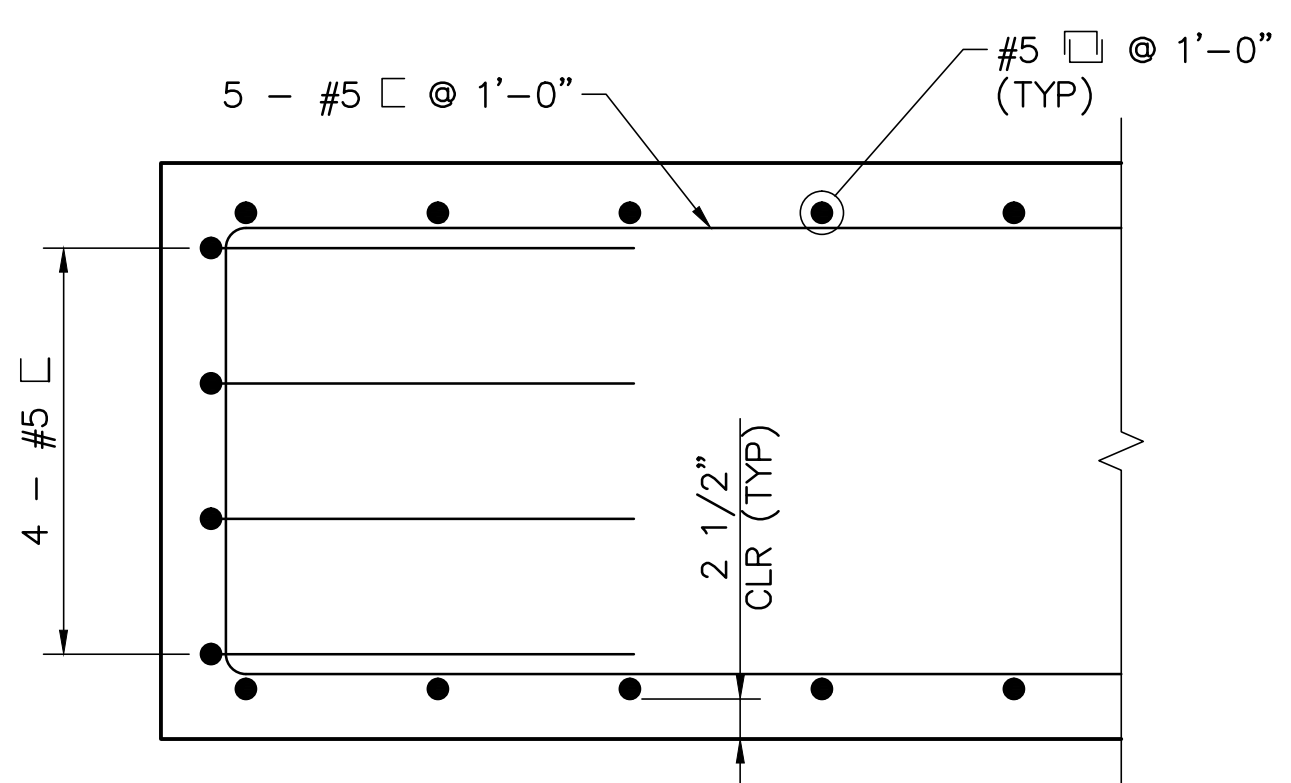



Reinforcing Detail

Scale: 1"=1'-0"

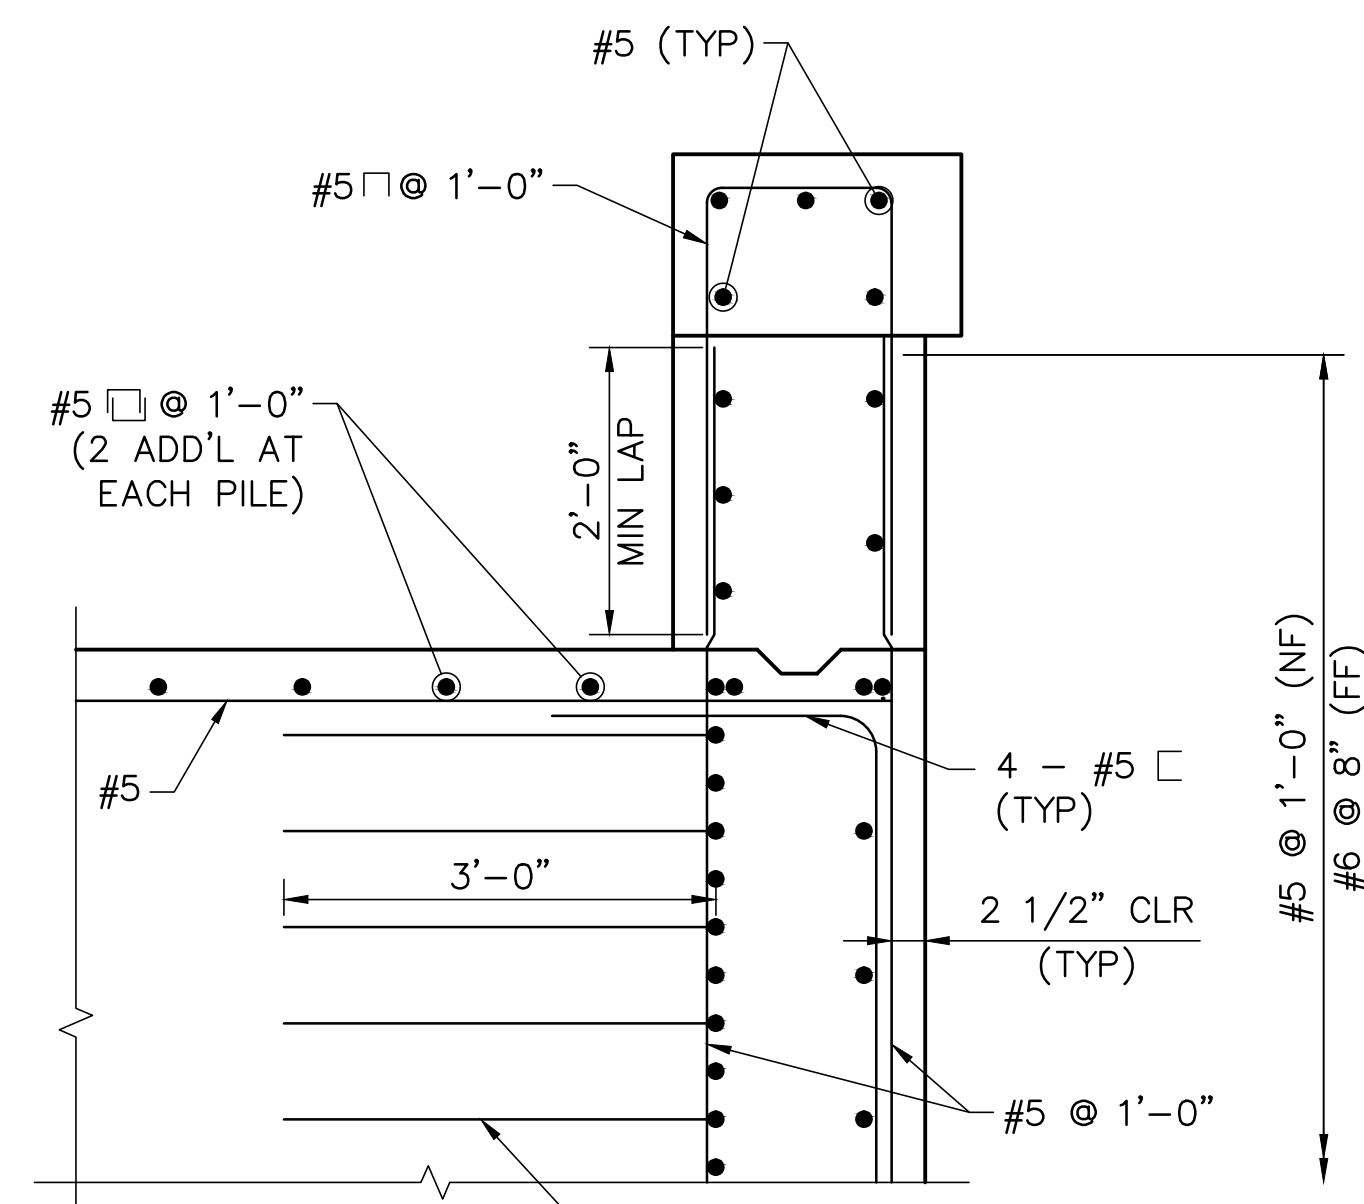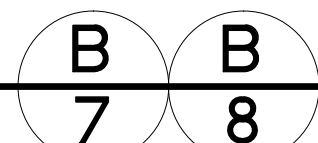


Reinforcing Detail

Scale: 1"=1'-0"

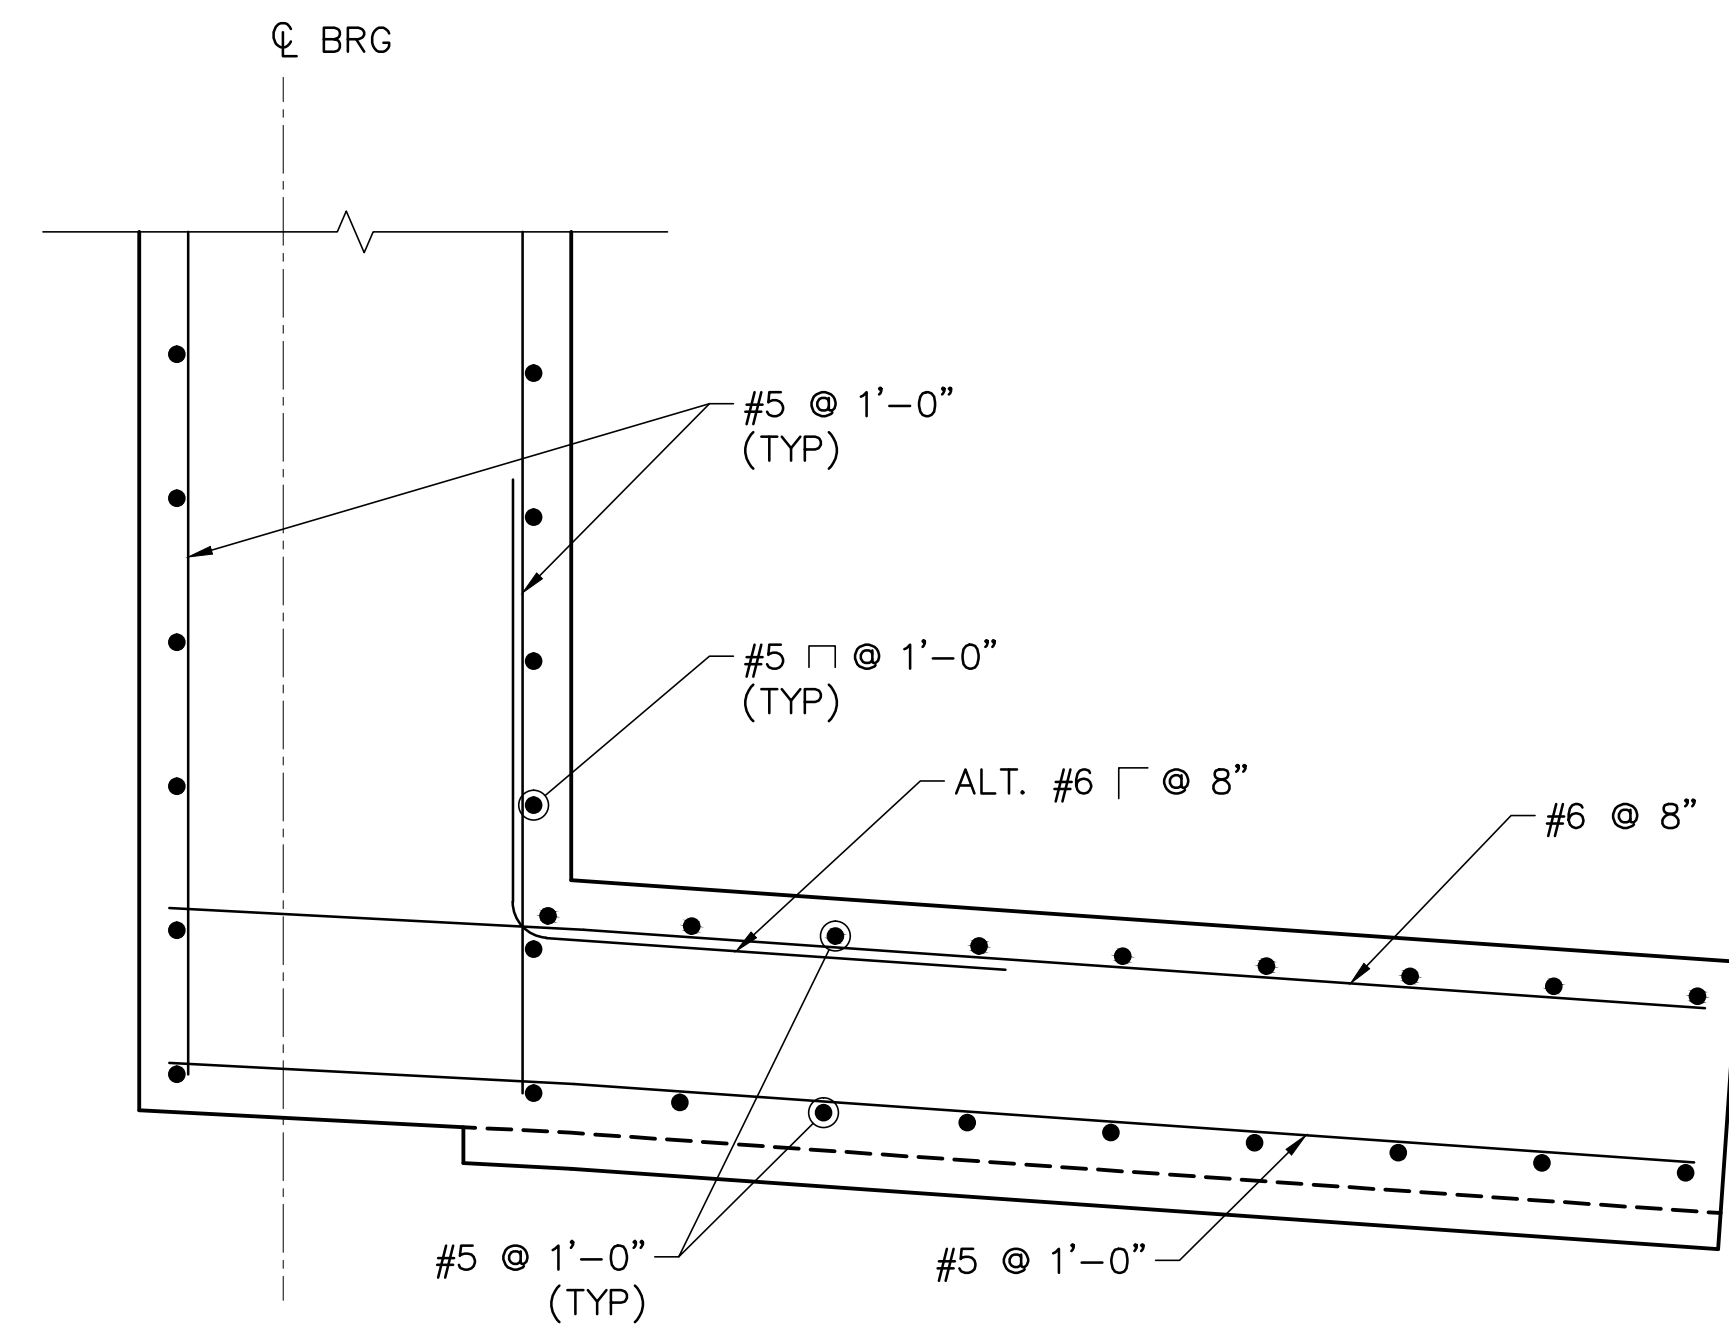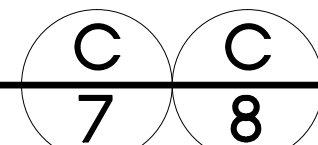


Wingwall Reinforcement Plan

Scale: 3/4"=1'-0"

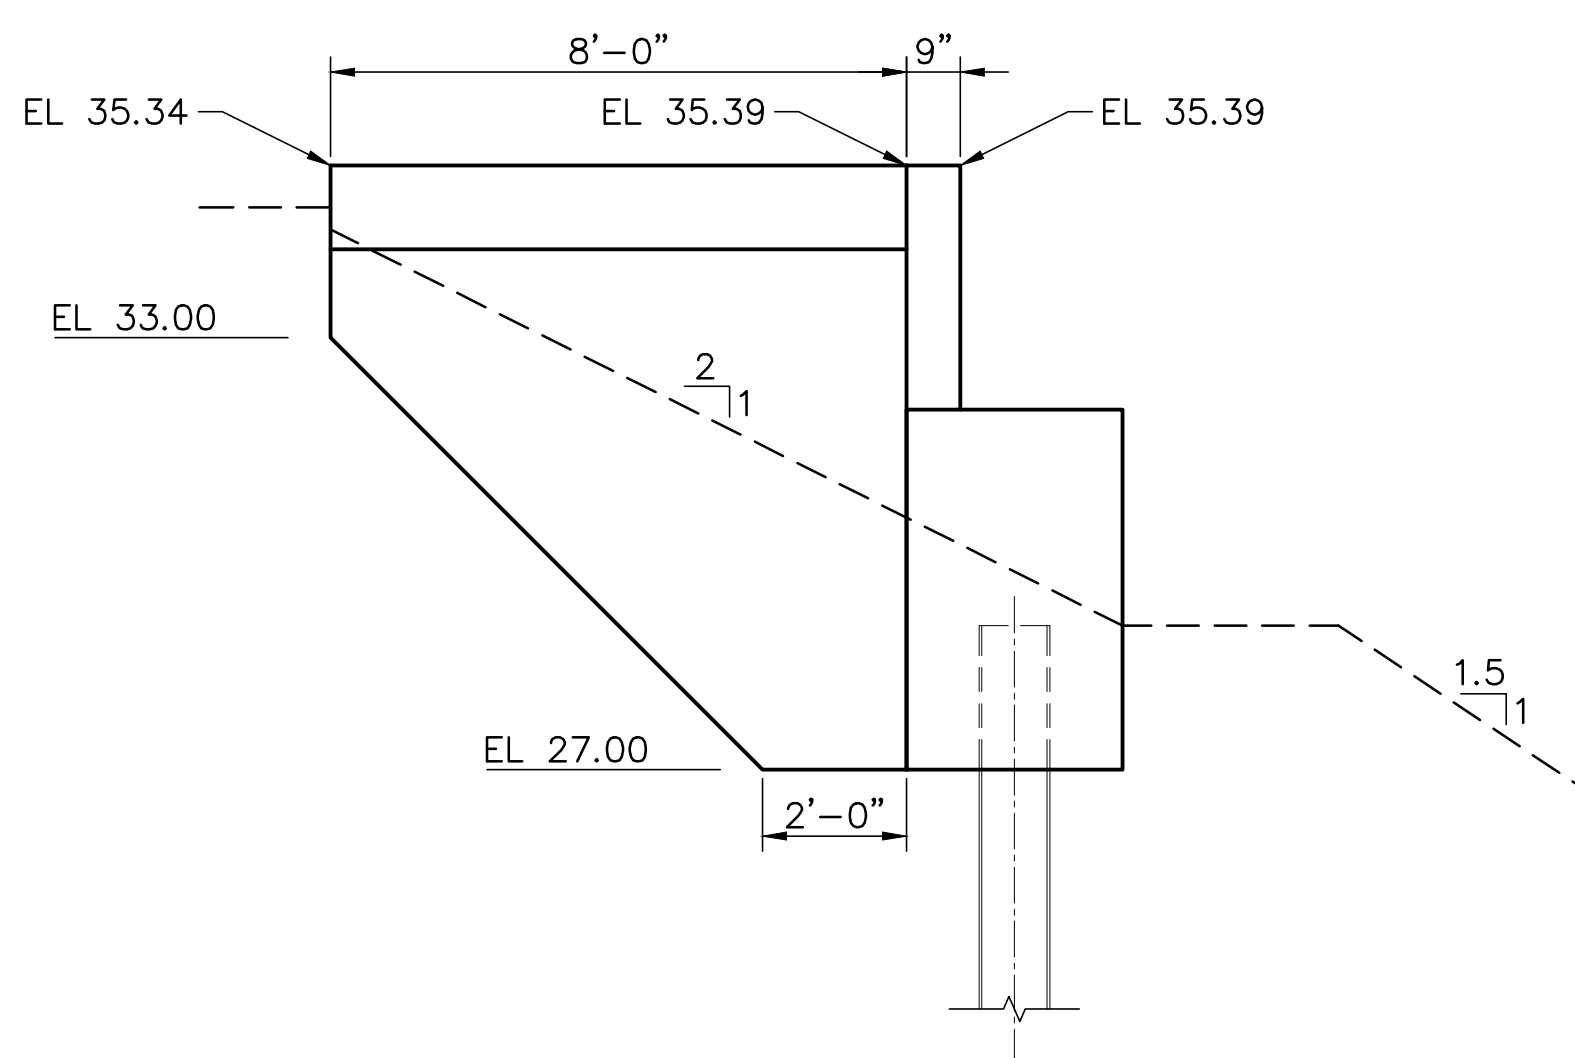


NW and SW Wingwalls

Scale: 3/8"=1'-0"

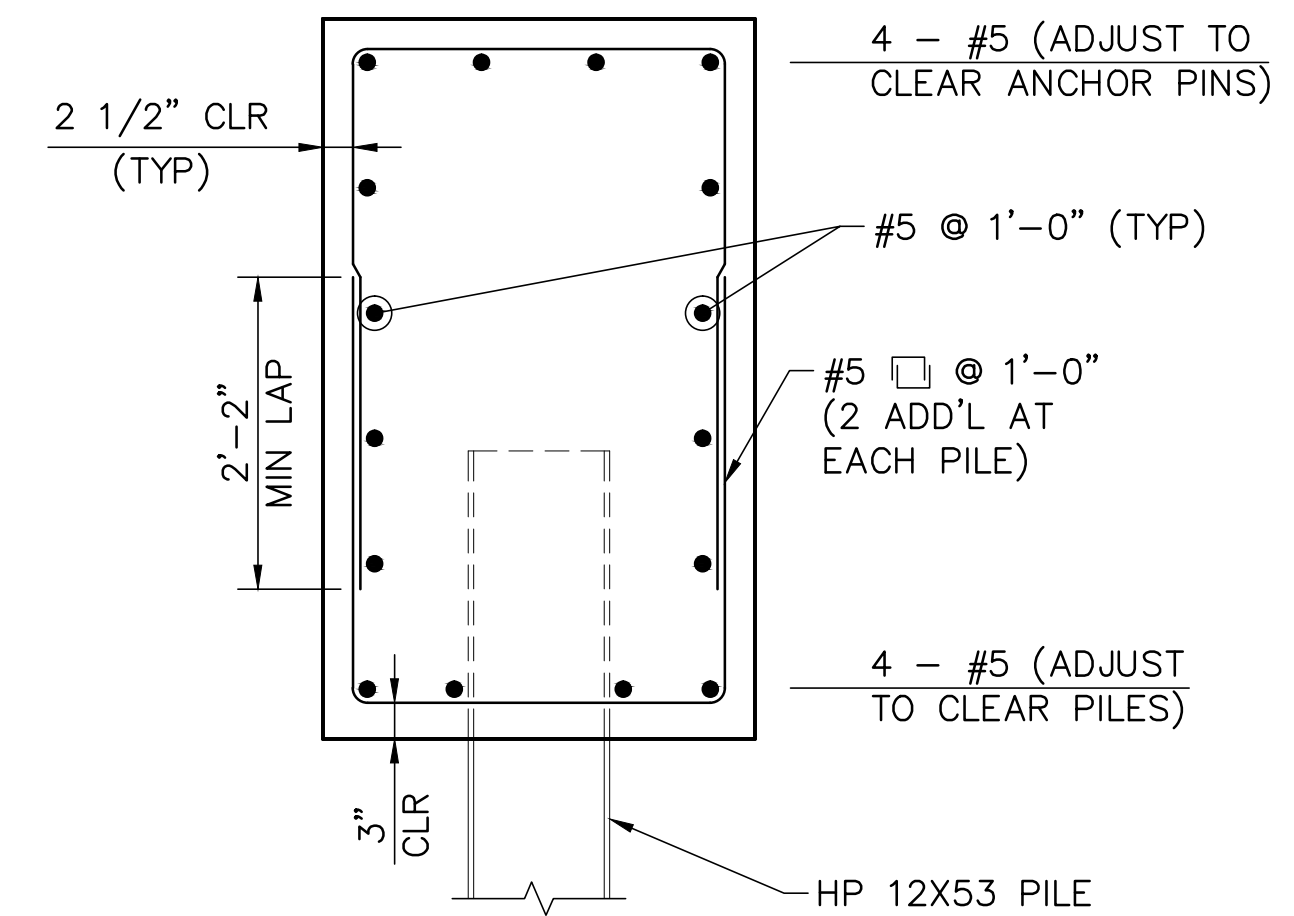


Typical Abutment Reinforcing

Scale: 3/4"=1'-0"

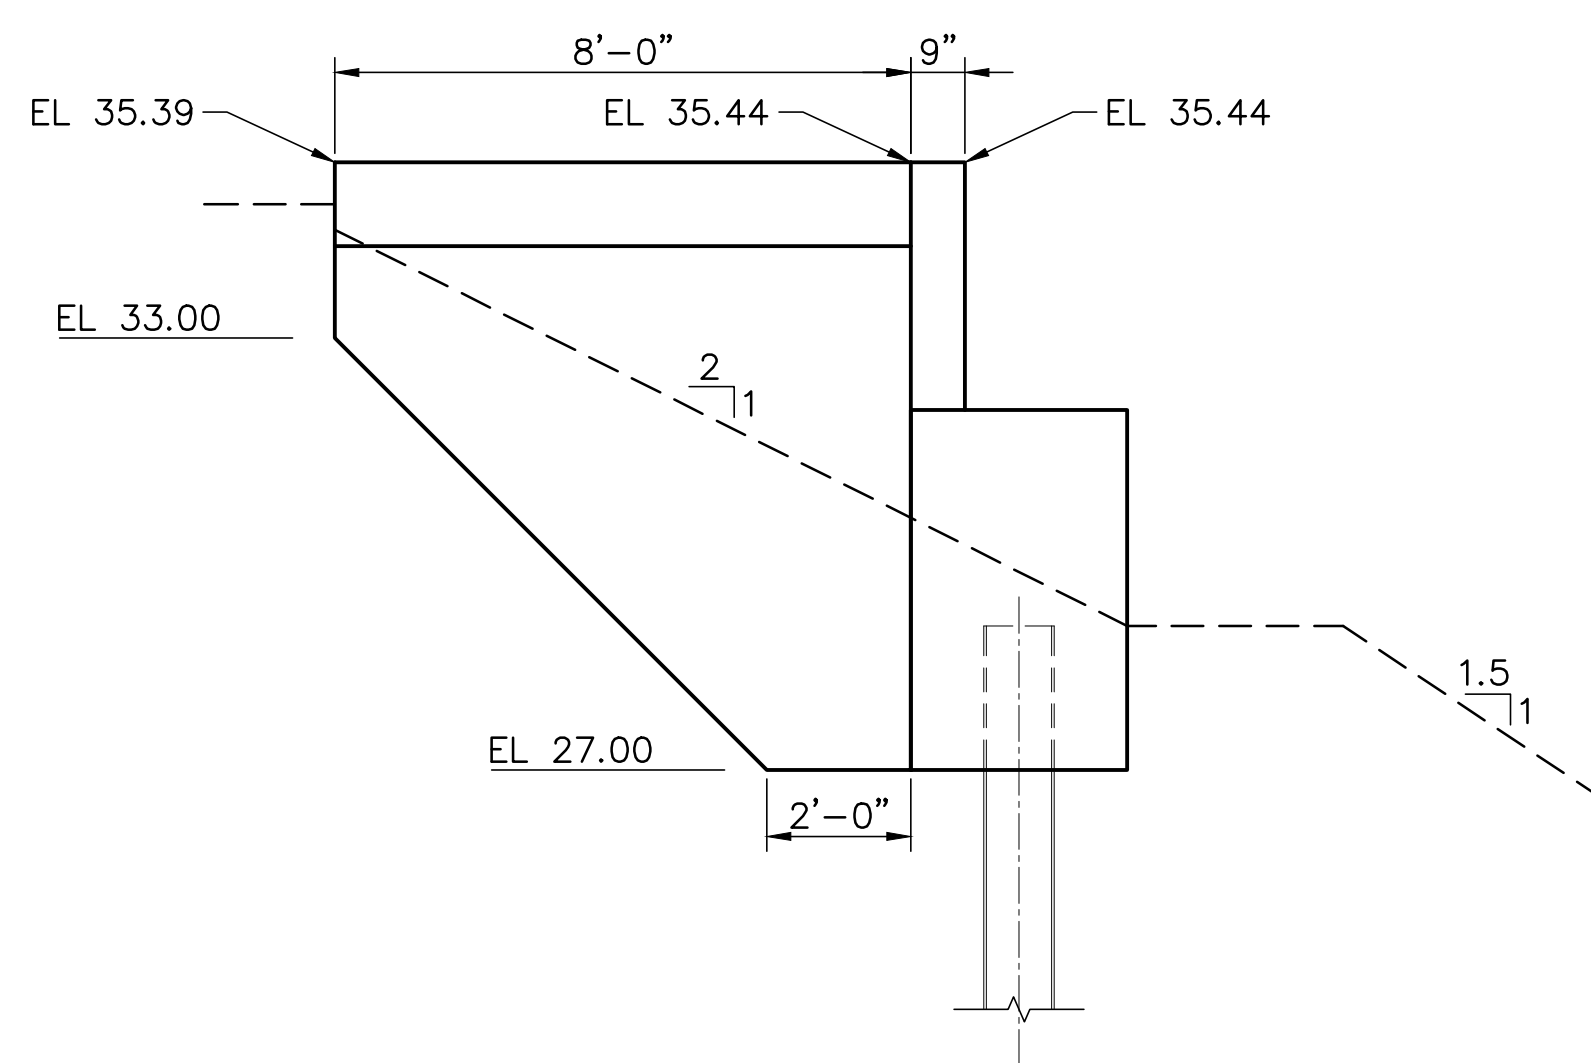

NE and SE Wingwalls

Scale: 3/8"=1'-0"

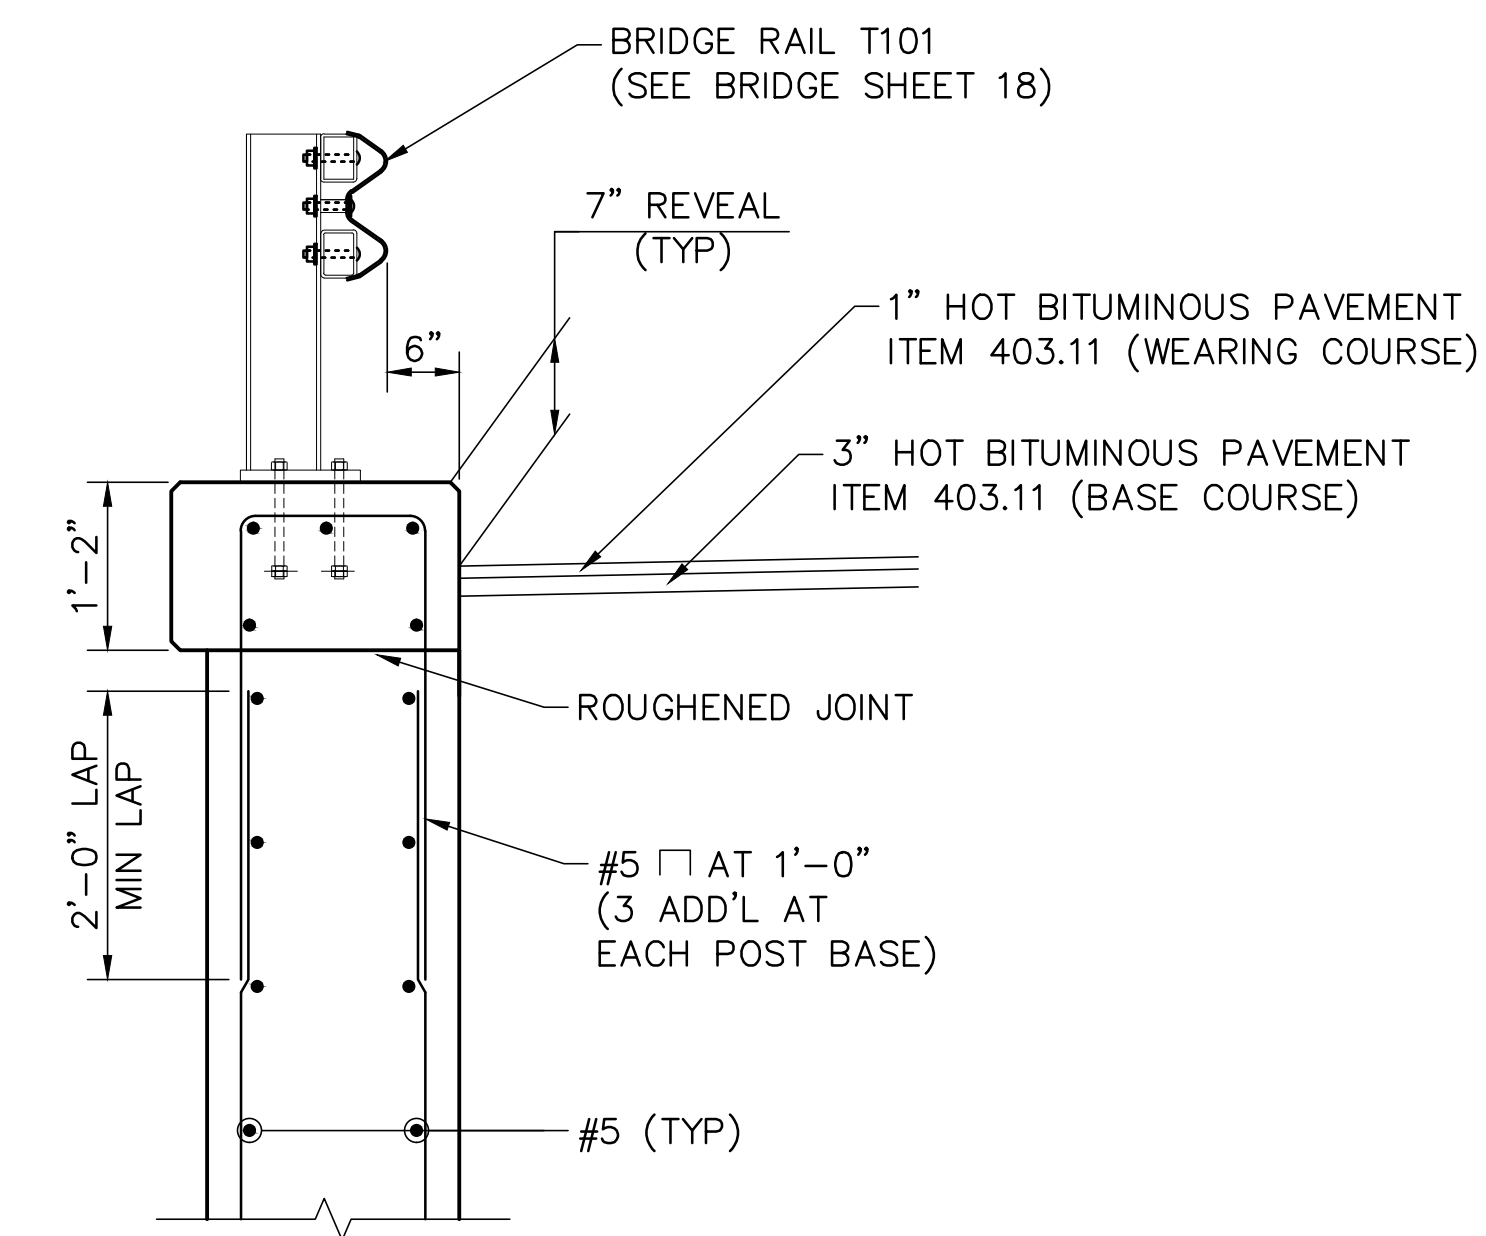

Typical Section At Wingwall Coping

Scale: 3/4"=1'-0"

no.	0	AS-BUILT	revision	date	1/6/16	JLG	by
-----	---	----------	----------	------	--------	-----	----

CMA ENGINEERS
CIVIL/ENVIRONMENTAL ENGINEERS


35 Bow Street
Portsmouth, NH 03801
603-931-6196

10 Free Street
Portland, Maine 04101
207-561-4223

603-627-0708


www.cmaengineers.com

info@cmaengineers.com

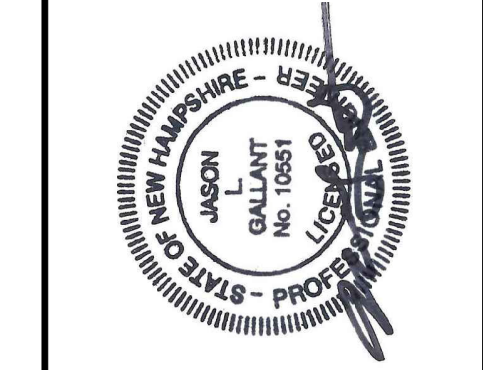

designed by:	LBK/OGK	approved by:	JLG
drawn by:	LBK/OGK	scale:	AS SHOWN
date:	July 2015	file name:	923 - Structural Plans.dwg
project no:	923		


Town of Exeter
Department of Public Works
Linden Street
Little River Bridge Replacement
Abutment and Wingwall
Elevations and Details

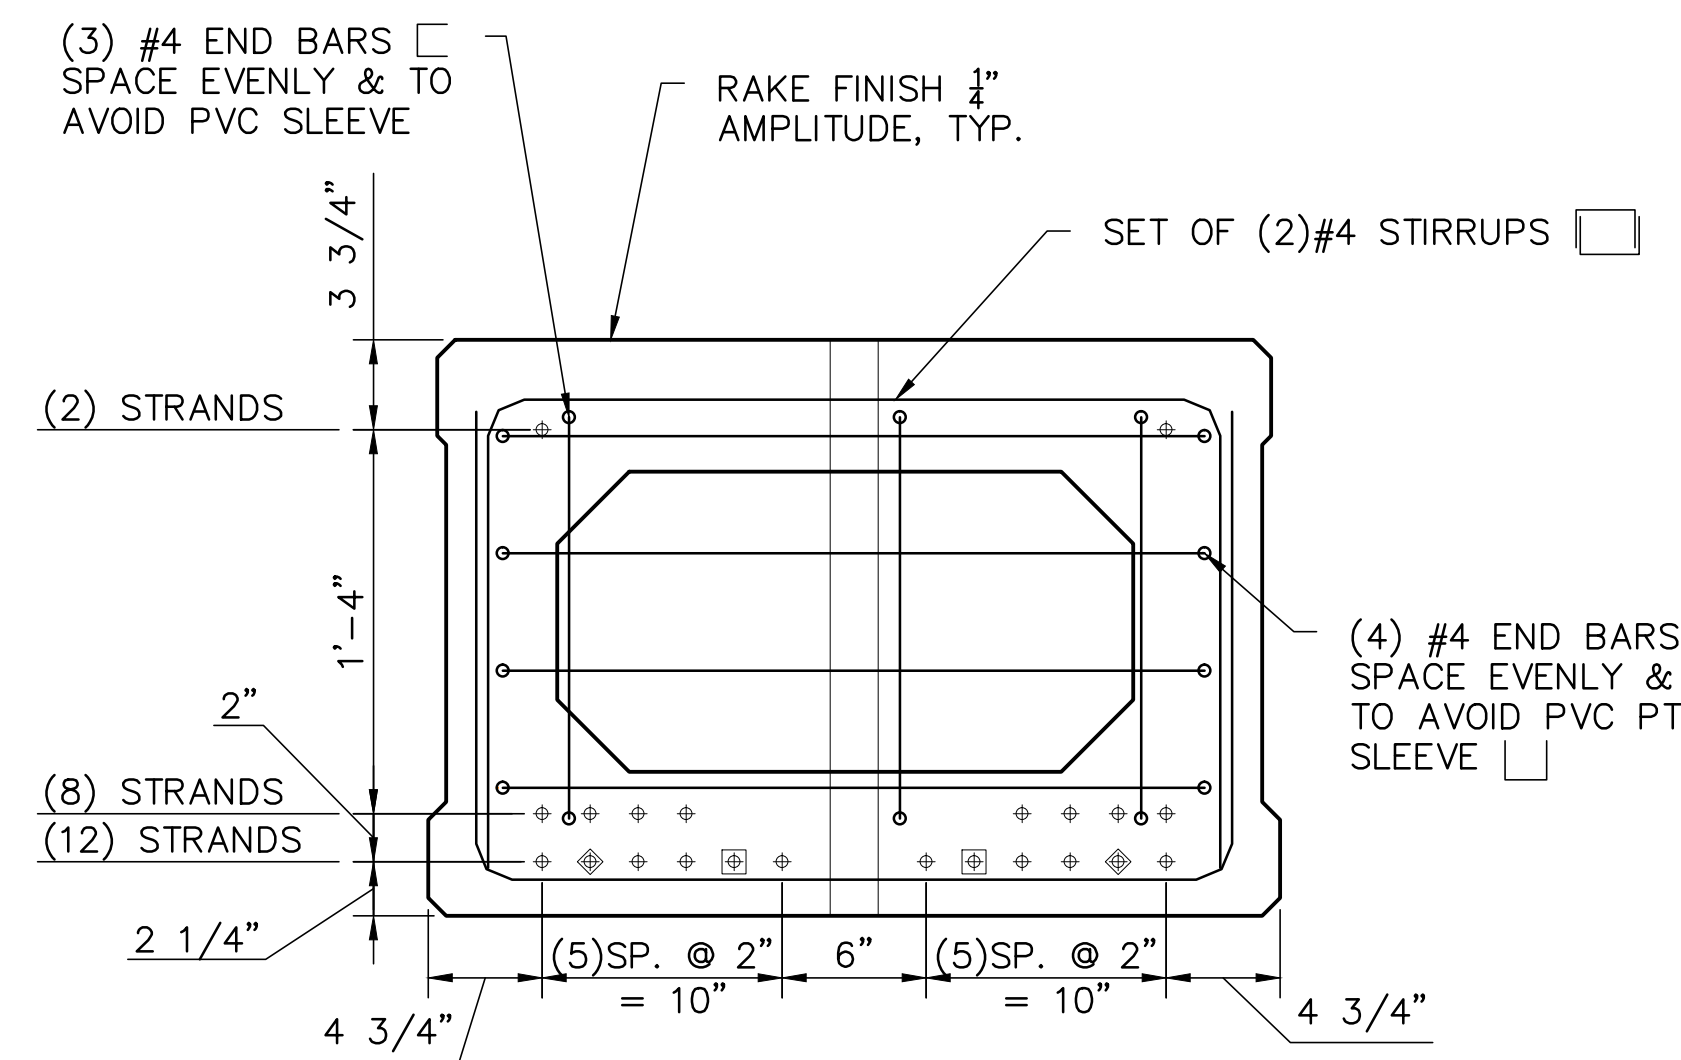

♦ DENOTES 1/2" Ø 270 KSI LOW-LAX STRAND
 ⊕ DENOTES 1/2" Ø 270 KSI LOW-LAX STRAND DEBONDED FOR 5'-0" FROM END
 ⊞ DENOTES 1/2" Ø 270 KSI LOW-LAX STRAND DEBONDED FOR 6'-0" FROM END
 NOTE: ALL STRANDS PULLED TO 31 KIPS EACH.

36" Box Beam Typical End Section


Scale: 1 1/2" = 1'-0"

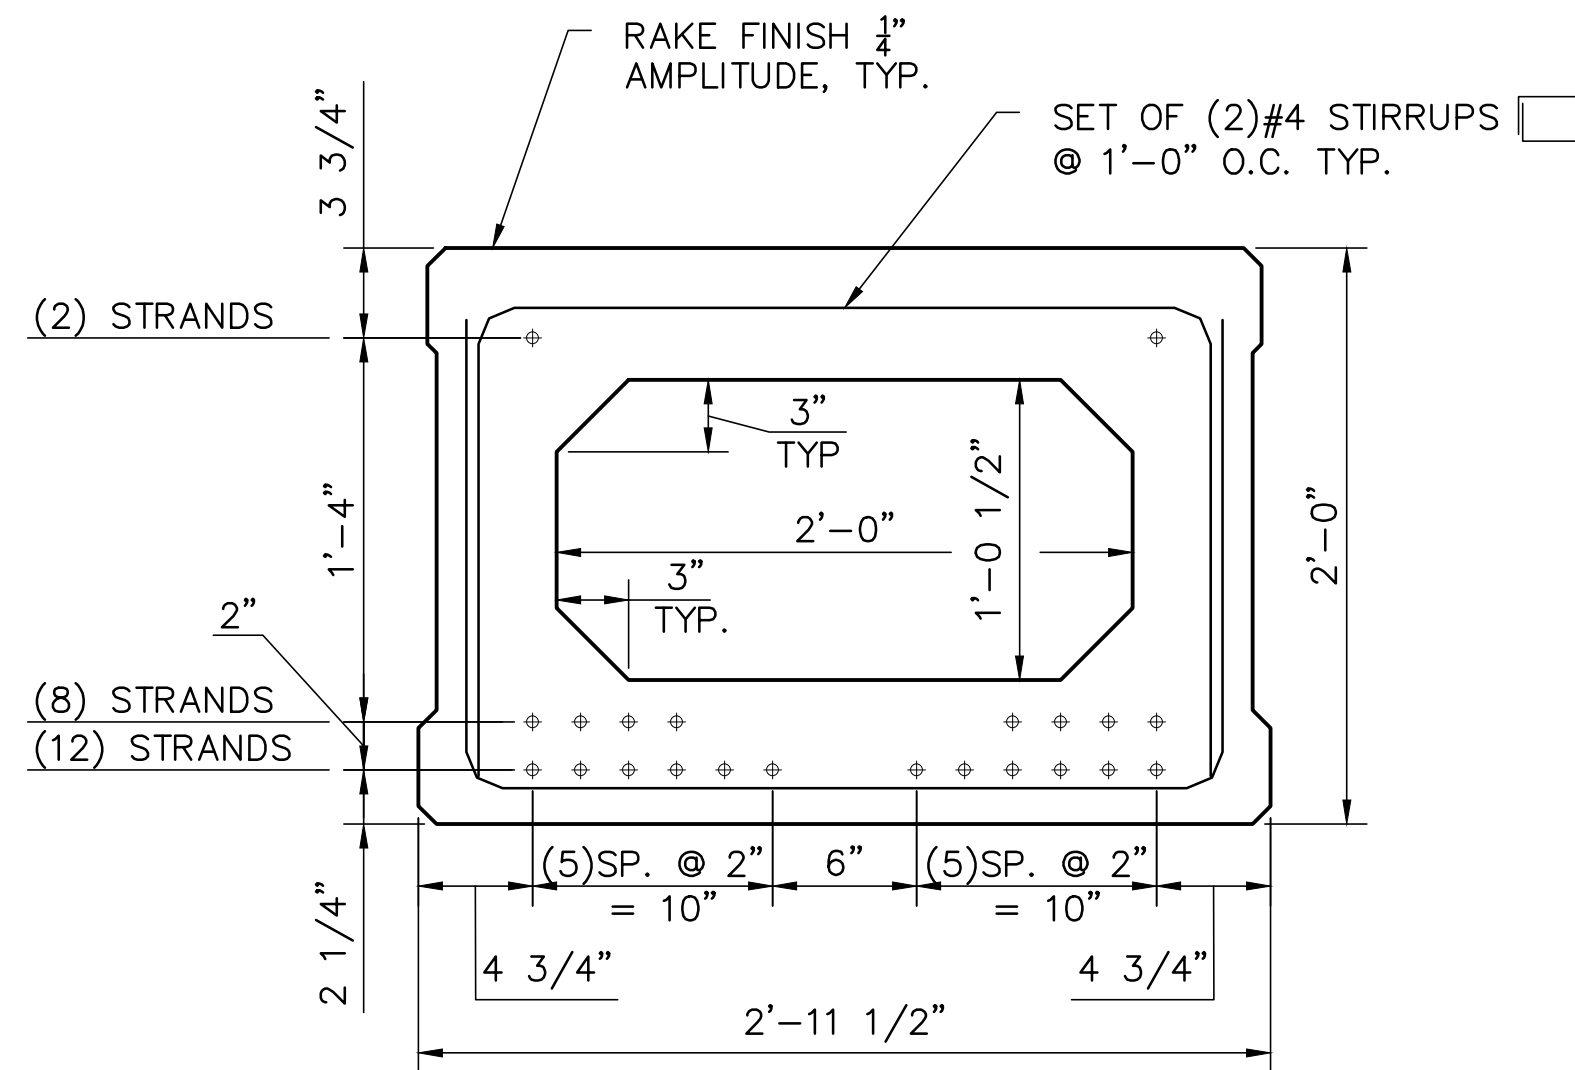

♦ DENOTES 1/2" Ø 270 KSI LOW-LAX STRAND
 NOTE: ALL STRANDS PULLED TO 31 KIPS EACH.


36" Box Beam Typical Mid Section

Scale: 1 1/2" = 1'-0"

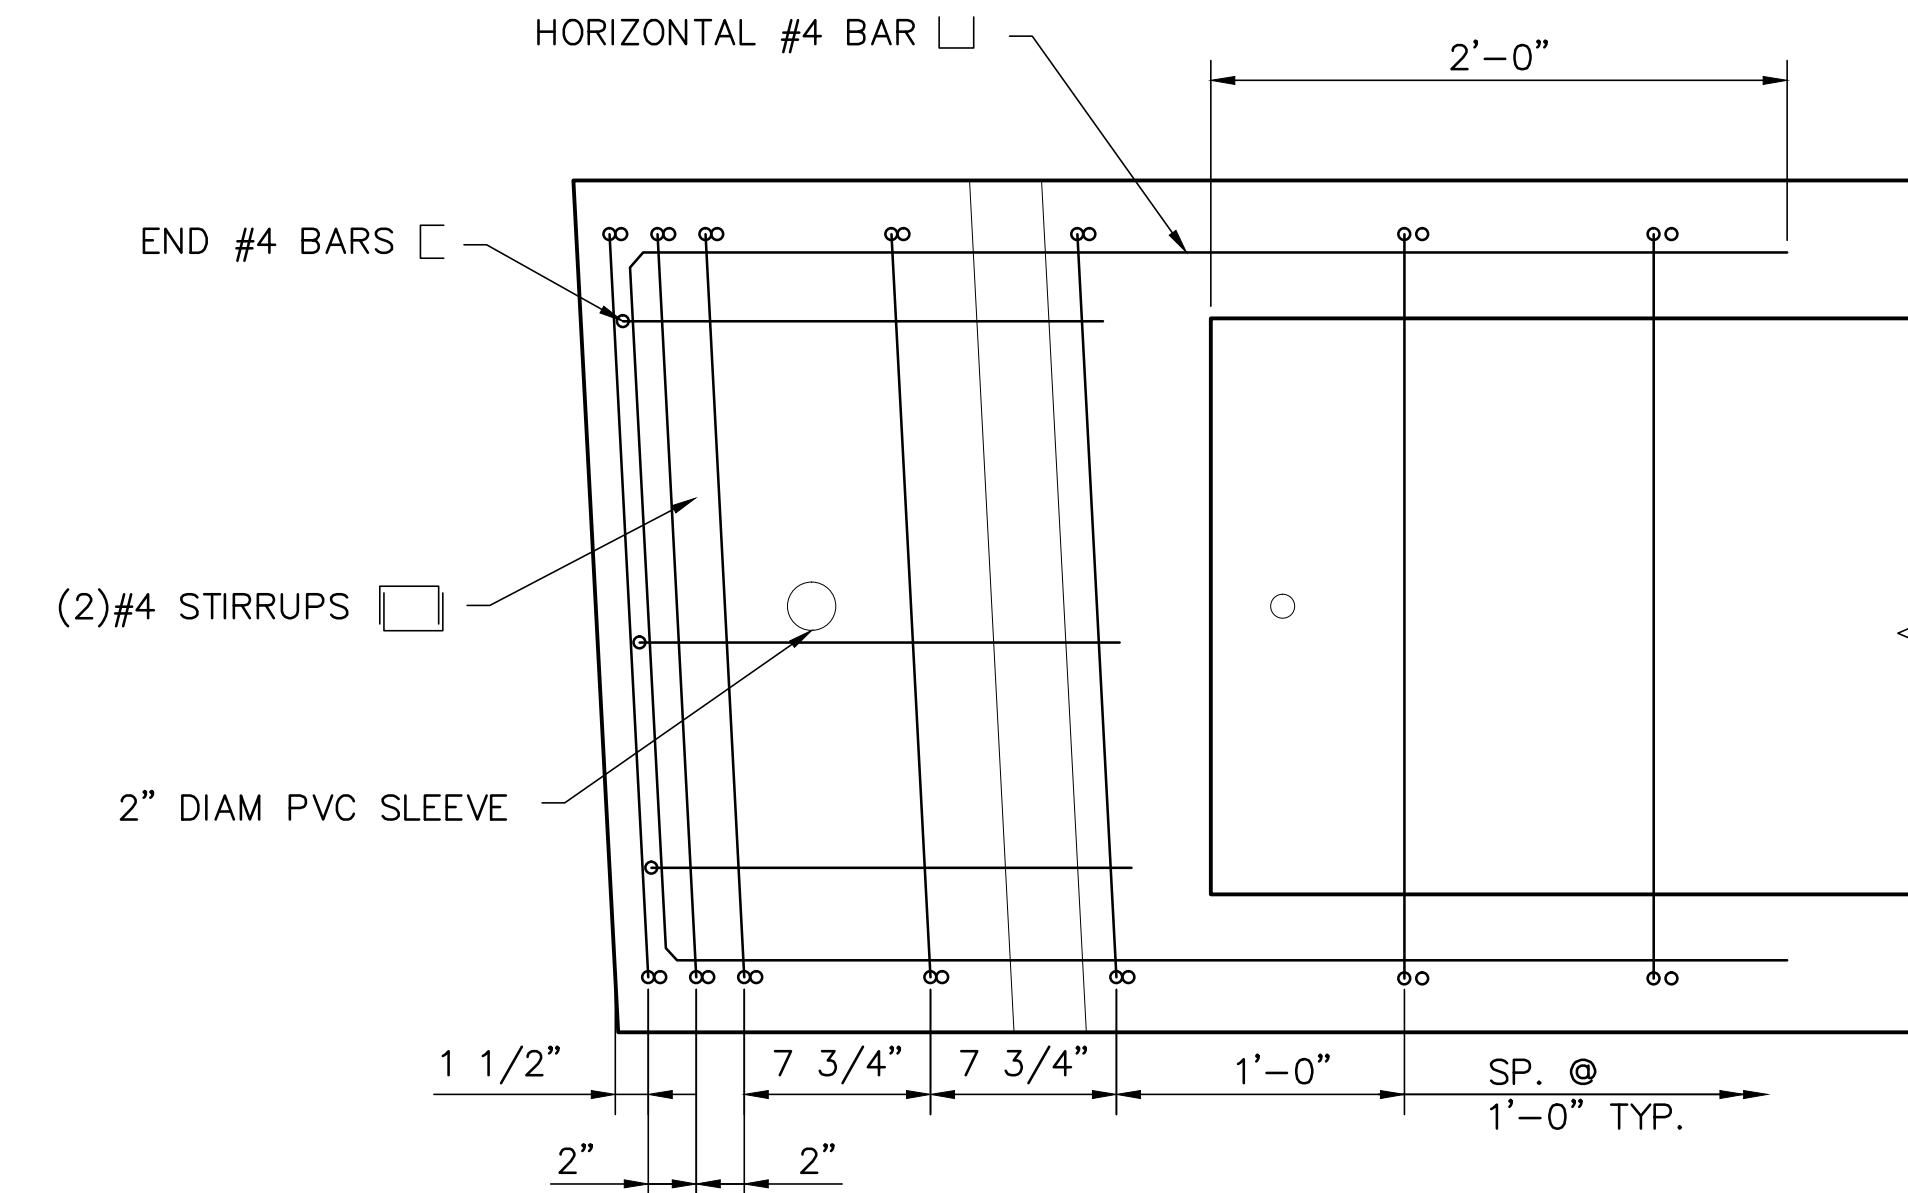

36" Box Beam Typical End Plan


Scale: 1 1/2" = 1'-0"

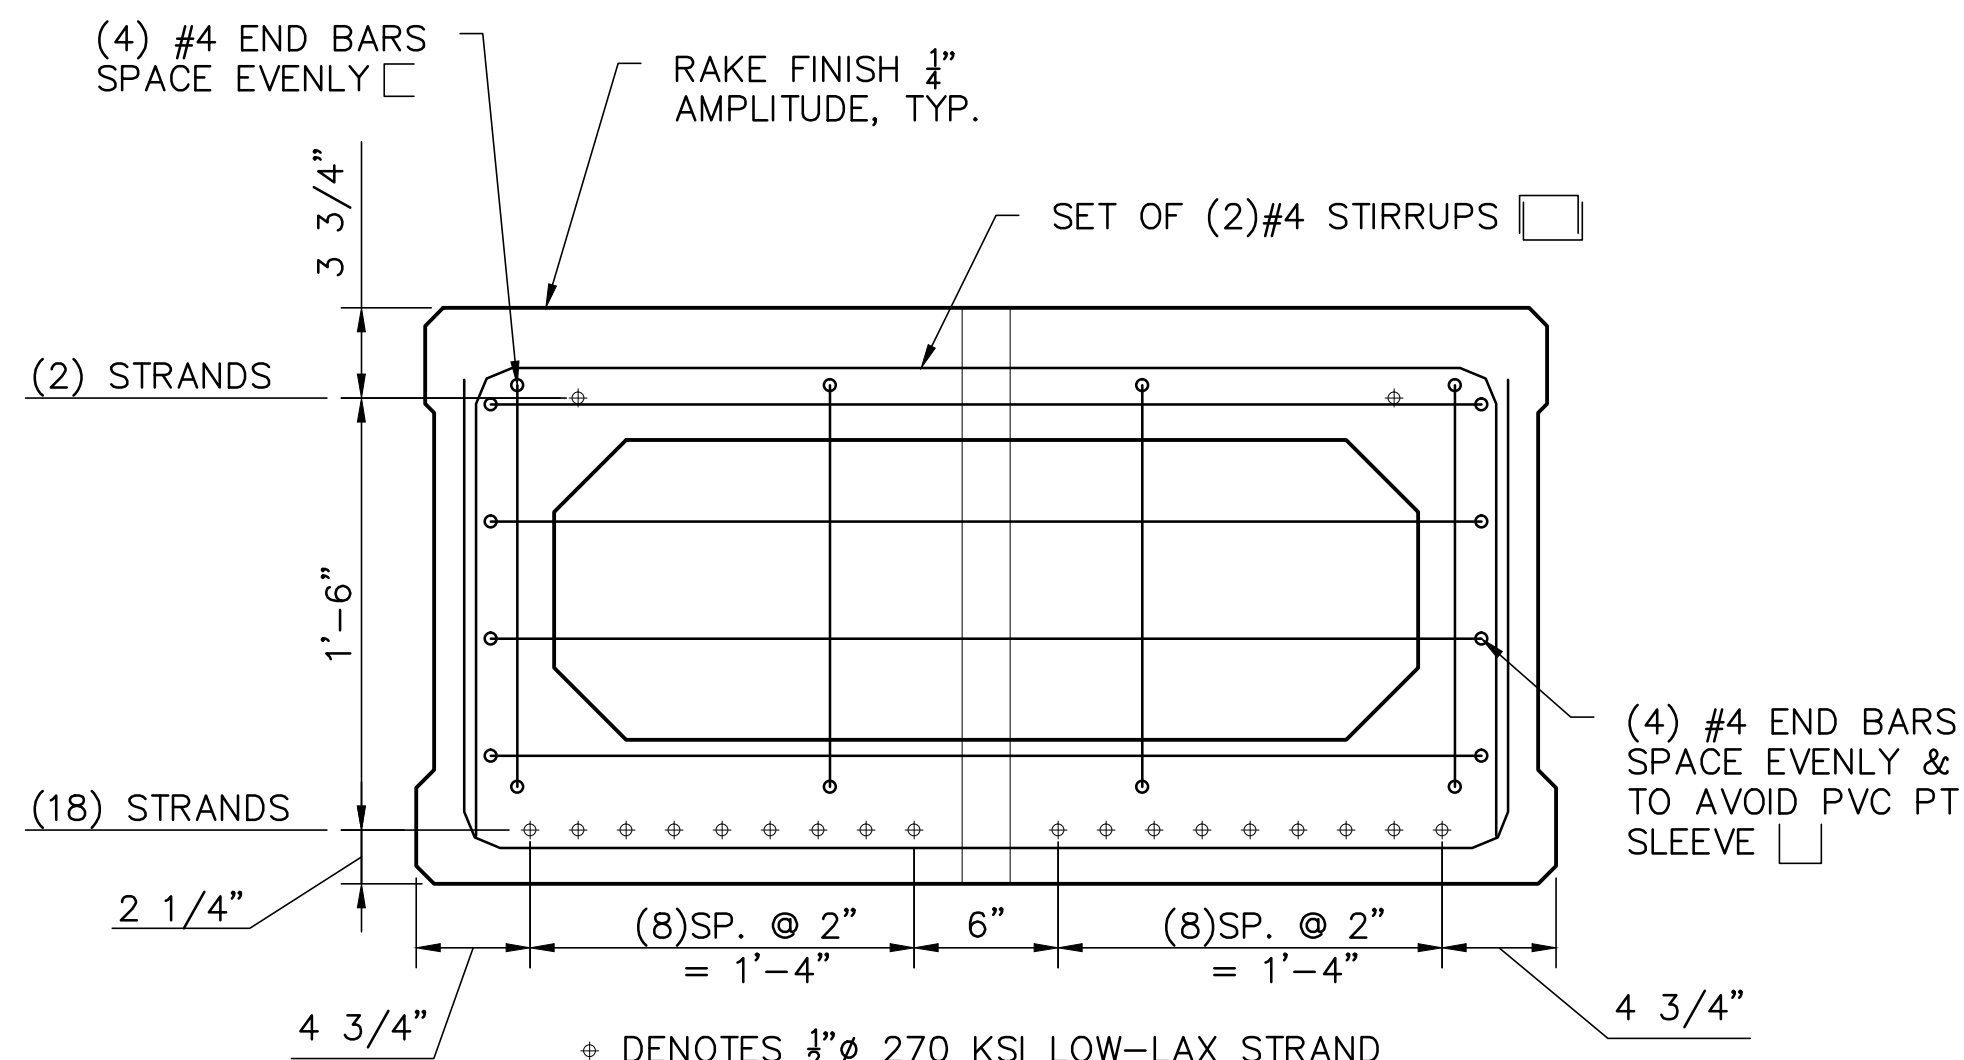

♦ DENOTES 1/2" Ø 270 KSI LOW-LAX STRAND
 NOTE: ALL STRANDS PULLED TO 31 KIPS EACH.

48" Box Beam Typical End Section


Scale: 1 1/2" = 1'-0"

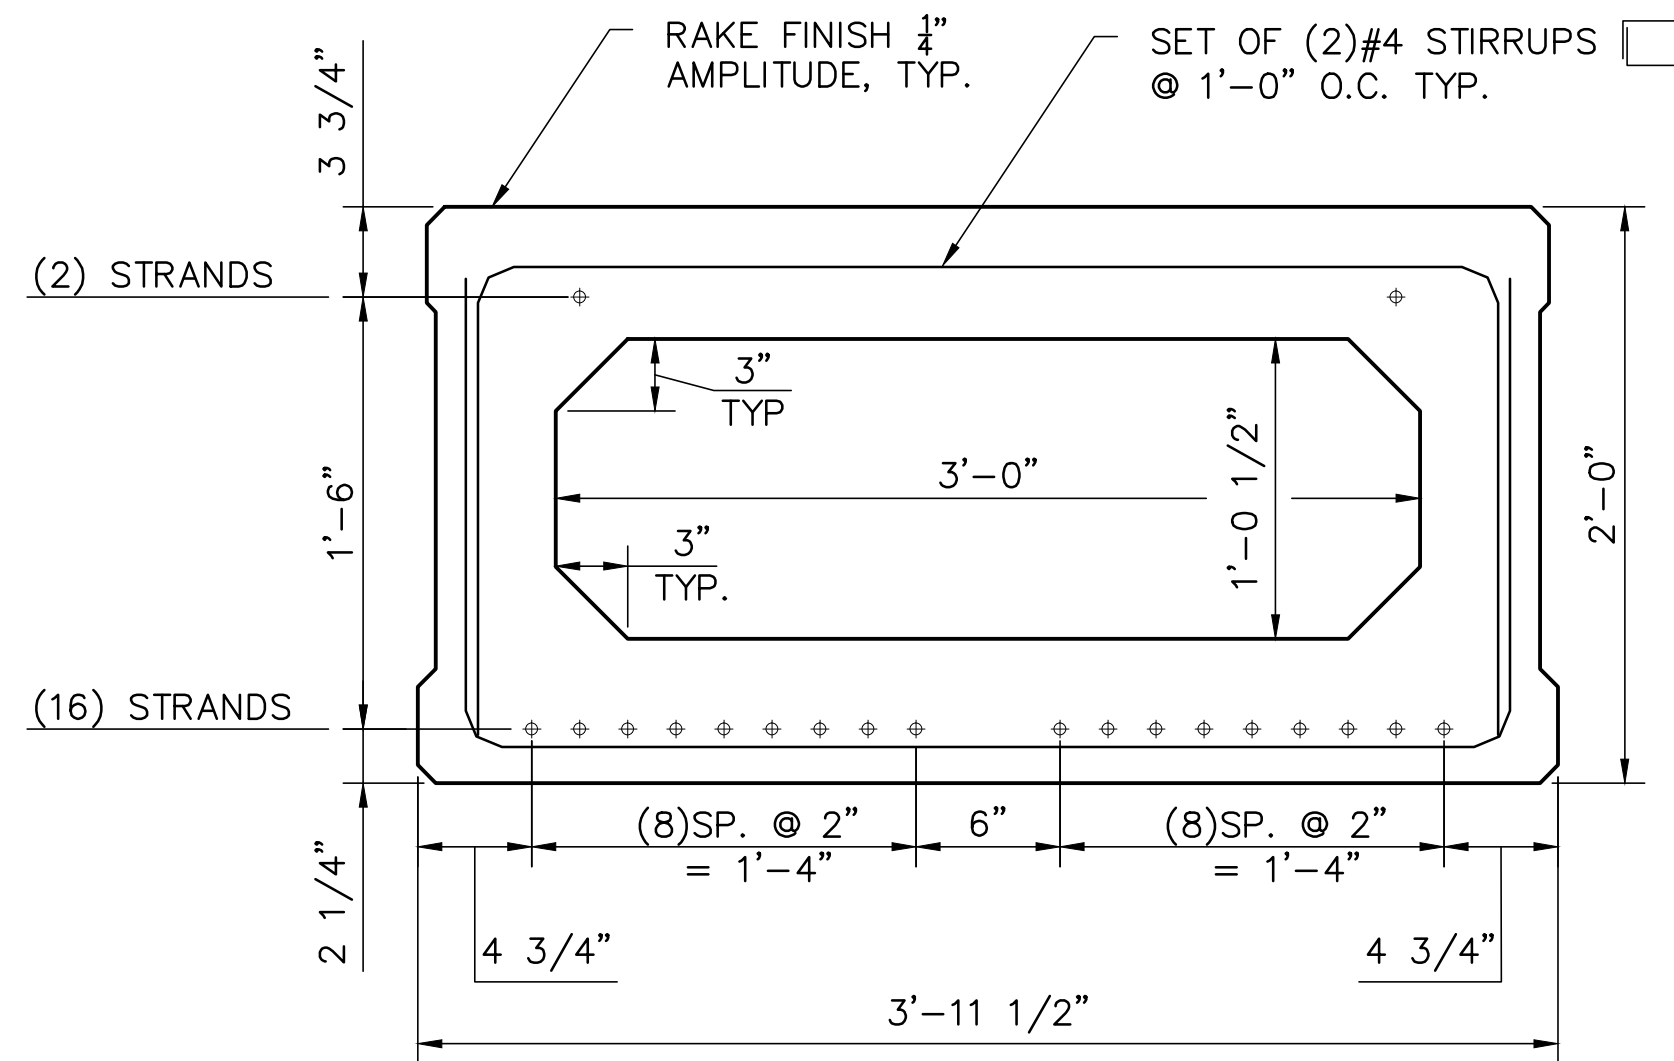

♦ DENOTES 1/2" Ø 270 KSI LOW-LAX STRAND
 NOTE: ALL STRANDS PULLED TO 31 KIPS EACH.

48" Box Beam Typical Mid Section

Scale: 1 1/2" = 1'-0"

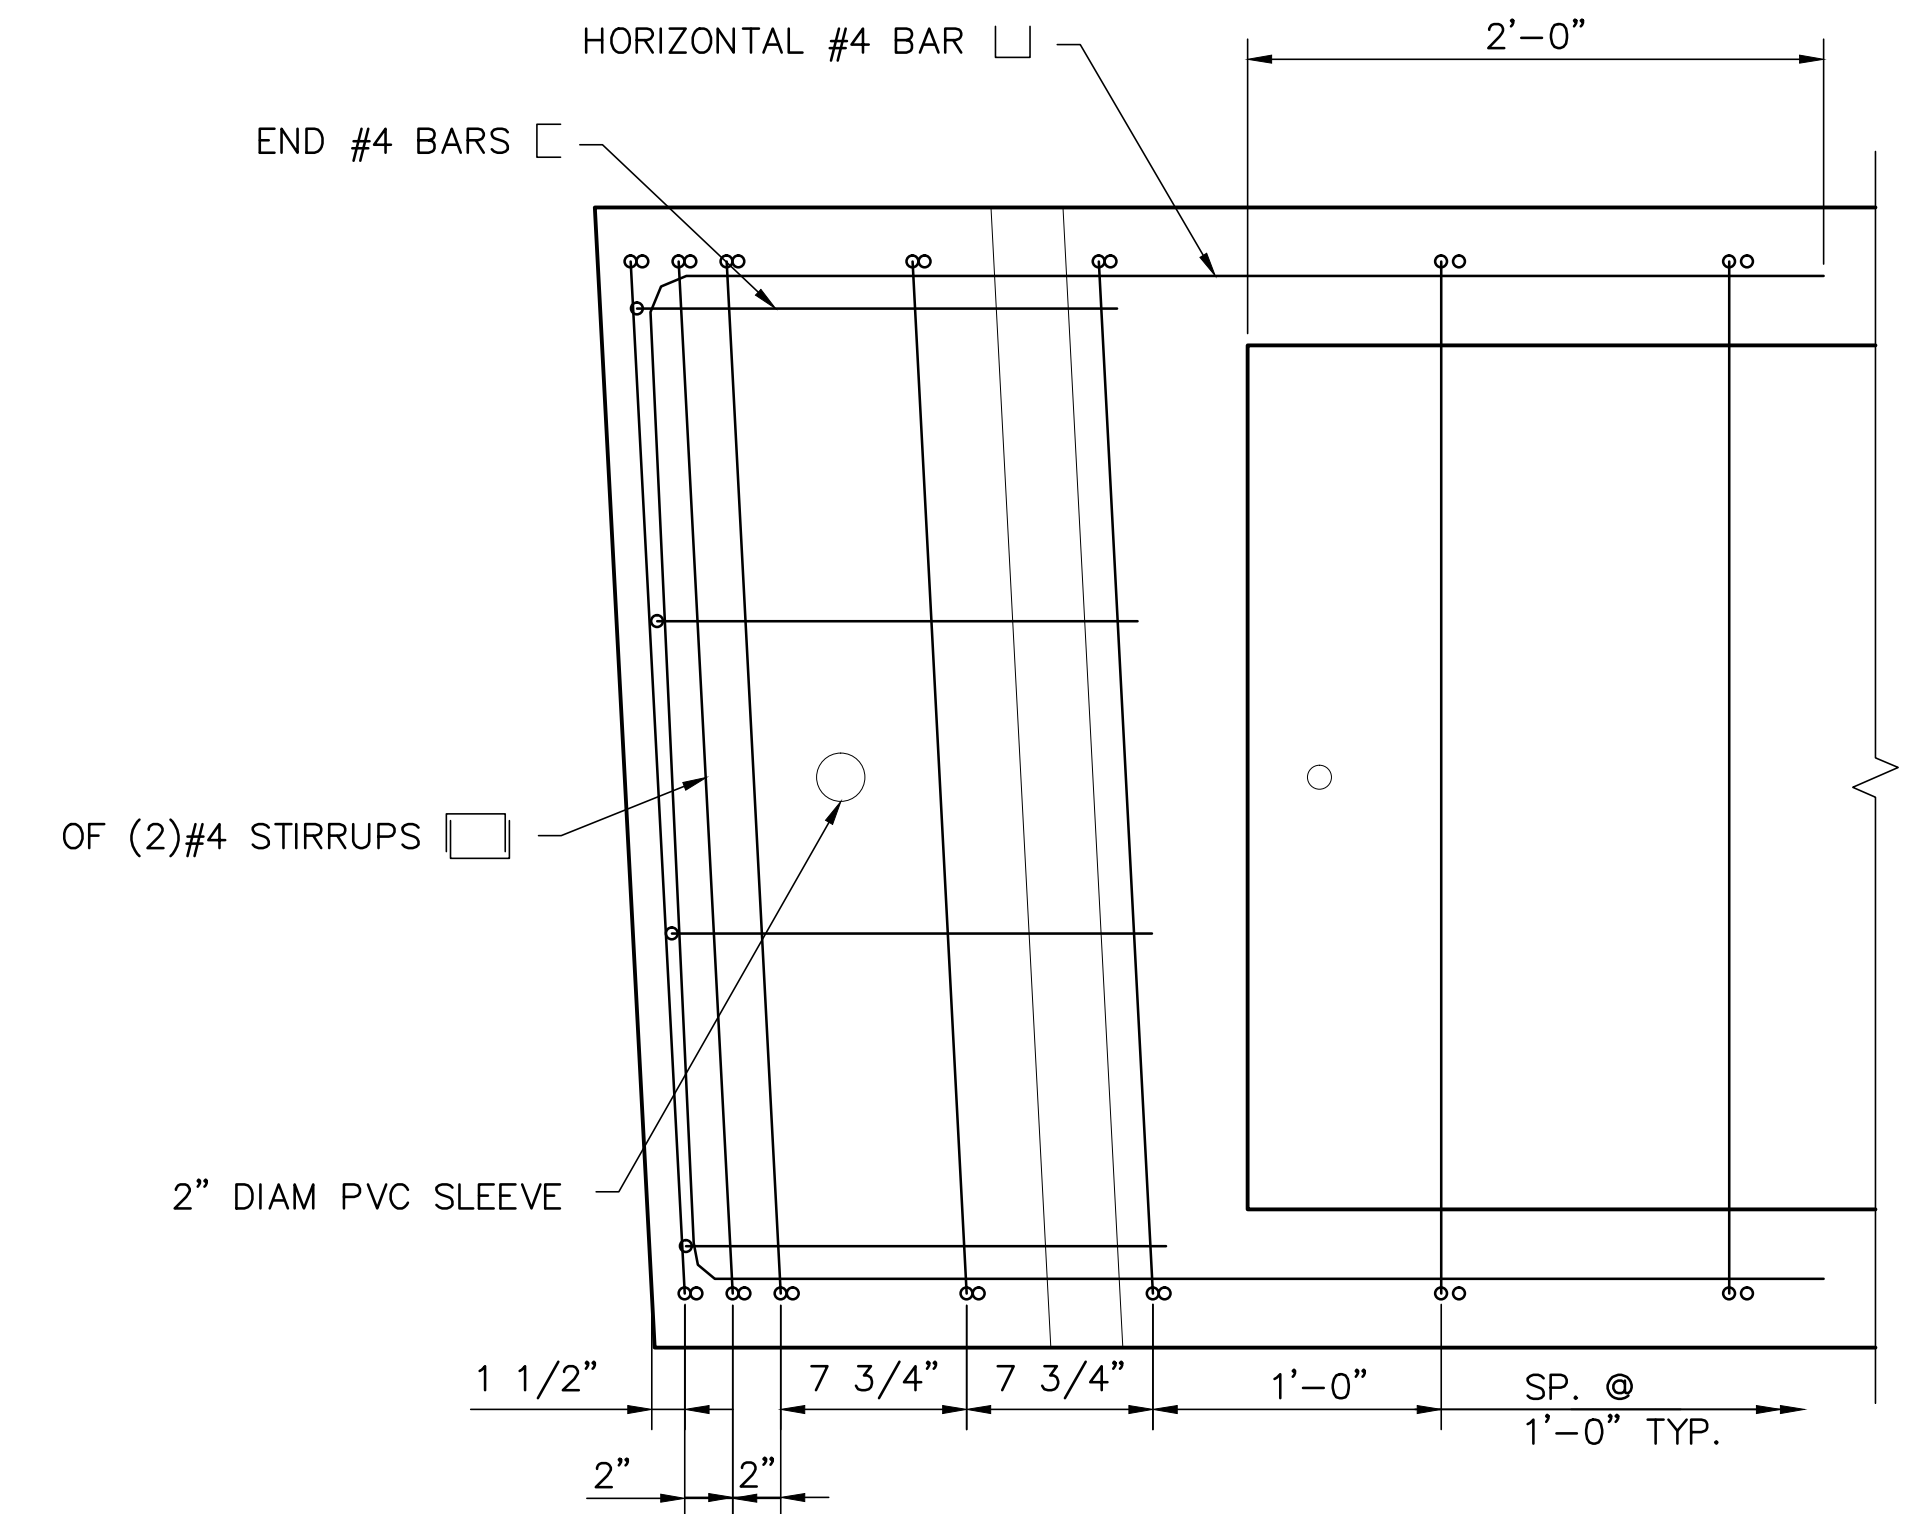

48" Box Beam Typical End Plan

Scale: 1 1/2" = 1'-0"

	CAMBER AT MID-SPAN (IN)				
	PRESTRESS	SELF WEIGHT	SUPERIMPOSED DL	TOTAL AT ERECTION	TOTAL AT FINAL
BEAM B1	1.28	0.46	0.222	1.45	1.04
BEAM B2	1.28	0.46	0.224	1.45	1.03
BEAM B3-B7	0.96	0.43	0.268	0.92	0.26
BEAM B8	1.28	0.46	0.445	1.45	0.37
BEAM B9	1.28	0.46	0.558	1.45	0.03

designed by: LBK/OGK
 date: July 2015
 project no: 923
 file name: 923 - Structural Plans.dwg
 scale: AS SHOWN

drawn by: LBK/OGK
 approved by: JLG

Town of Exeter
 Department of Public Works
 Linden Street
 Little River Bridge Replacement
 Prestressed Box Beam
 Details (Sheet 1 of 2)


drawing no:
B-11

sheet: 12 of 29

CMA ENGINEERS
 CIVIL/ENVIRONMENTAL ENGINEERS
 10 Free Street
 Portland, Maine 04101
 207.564.4223
 35 Bow Street
 Portsmouth, NH 03801
 603.931.6196
 info@cmaengineers.com
 www.cmaengineers.com


1/6/16
 AS-BUILT
 0
 no.

JLG
 by
 date

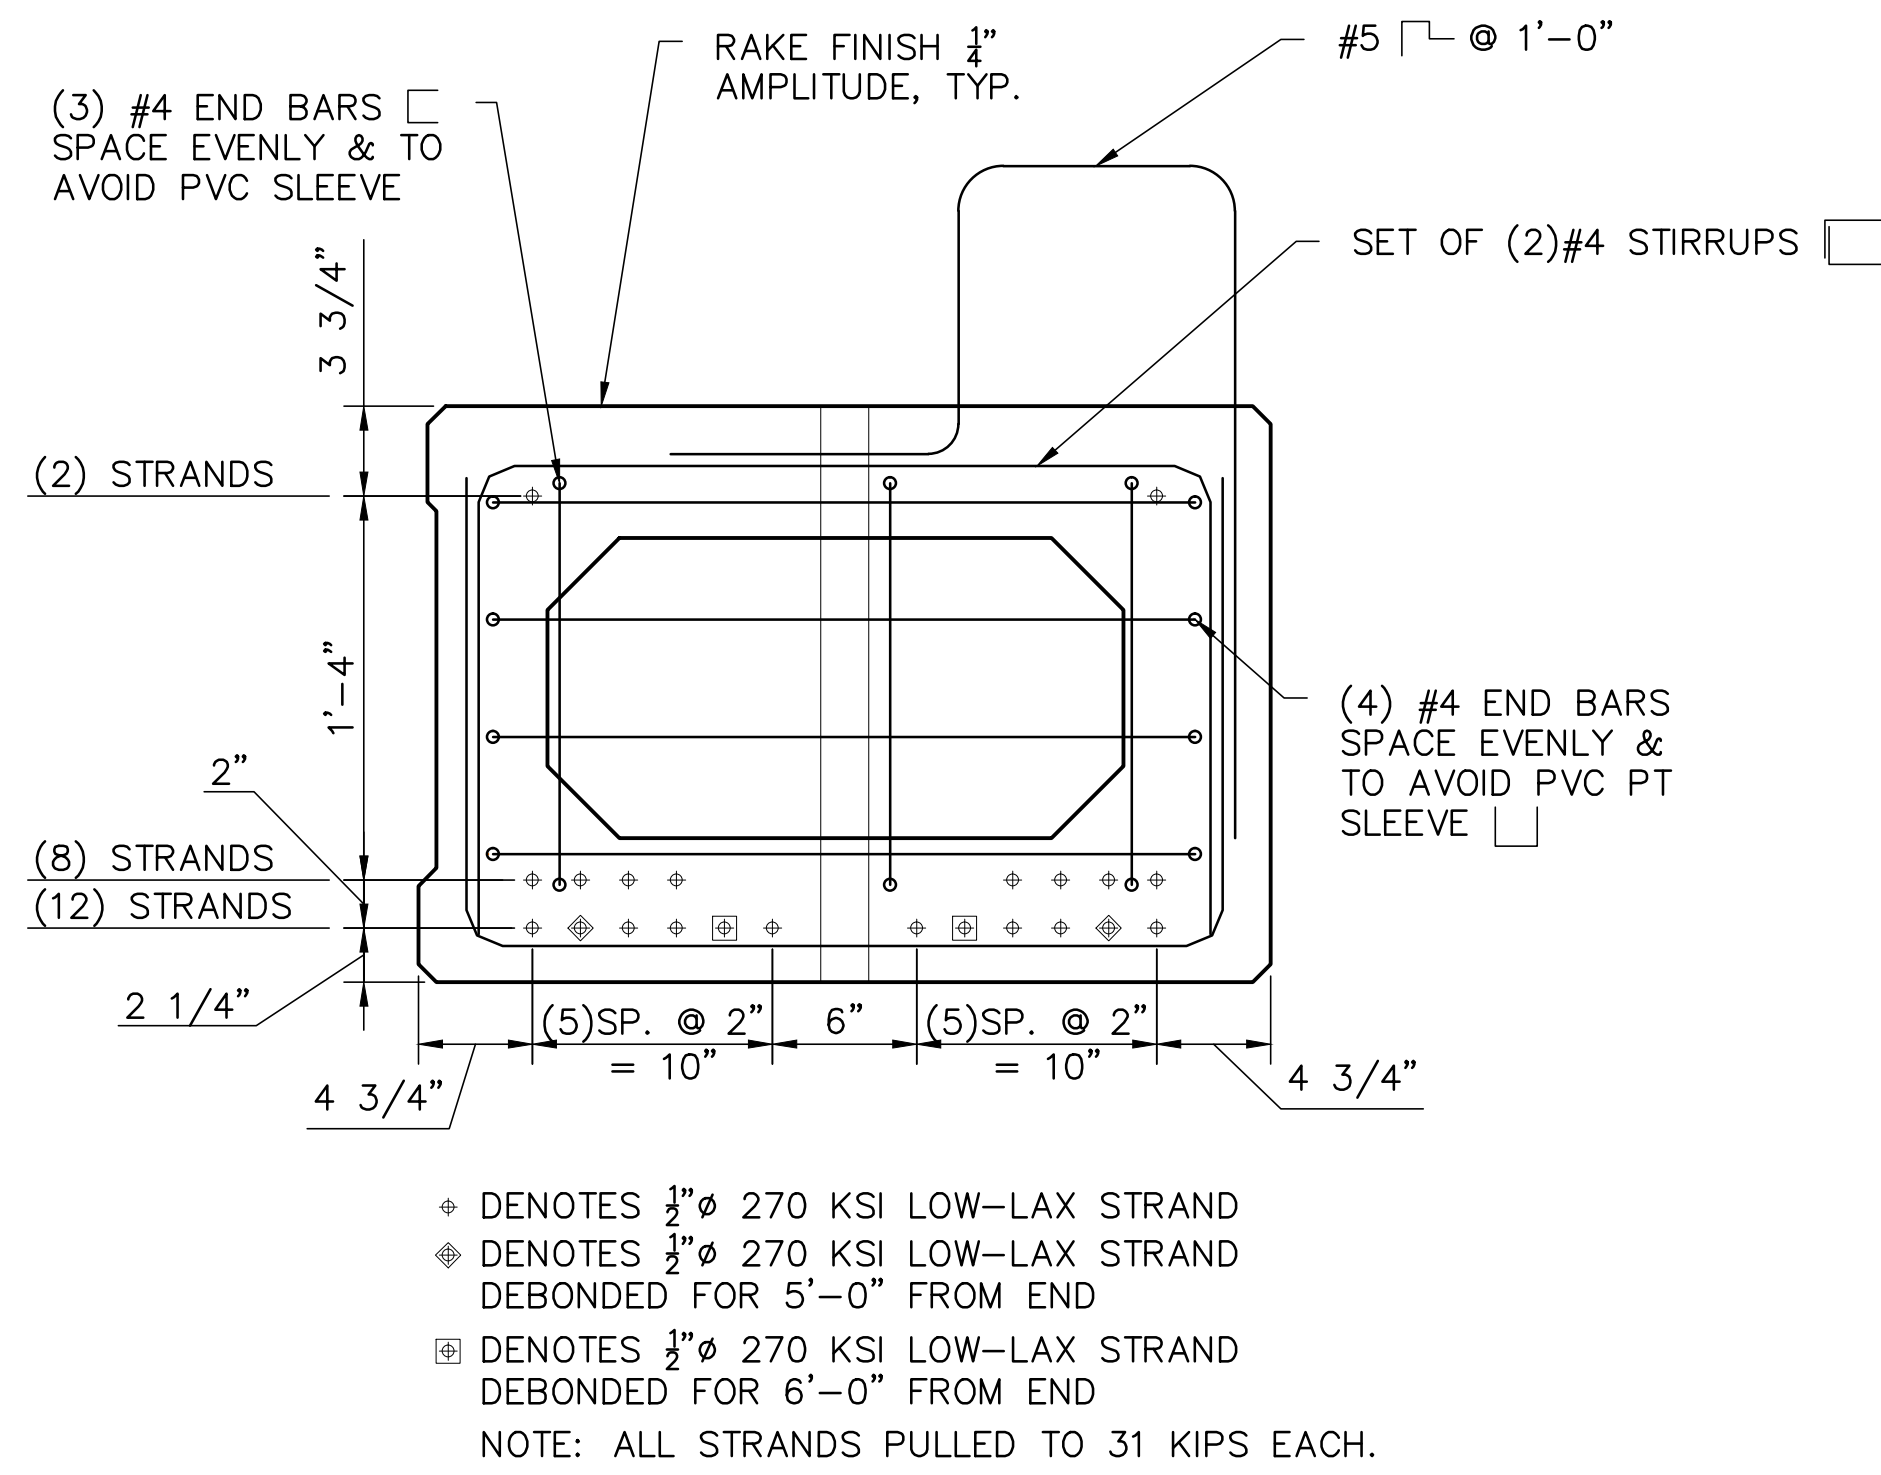


36" Box Beam (Beam B8) End Section

Scale: $1\frac{1}{2}$ " = 1'-0"

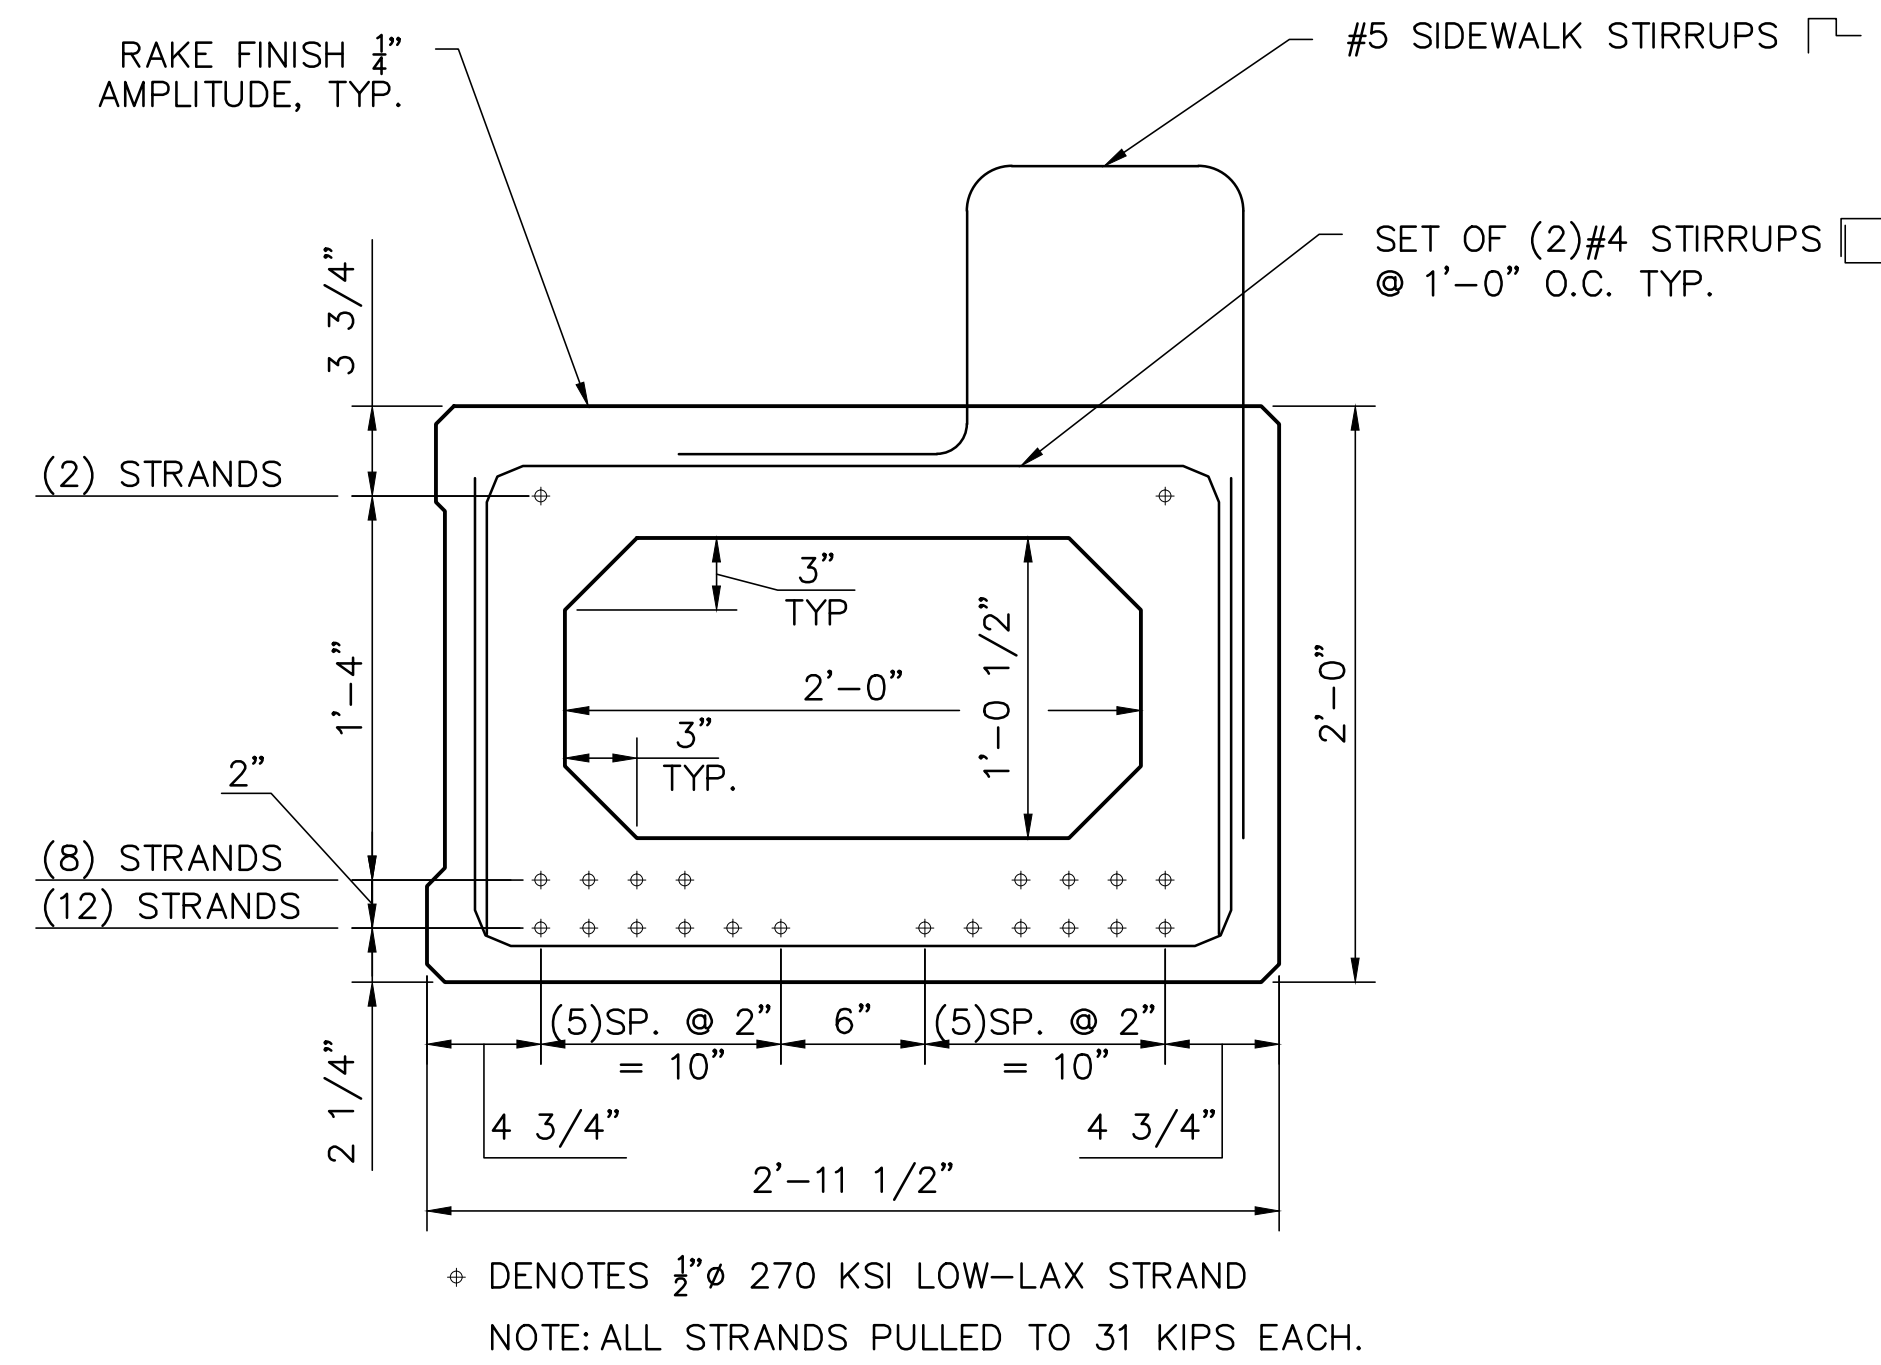

36" Box Beam (Beam B8) Typical Mid Section


Scale: $1\frac{1}{2}$ " = 1'-0"

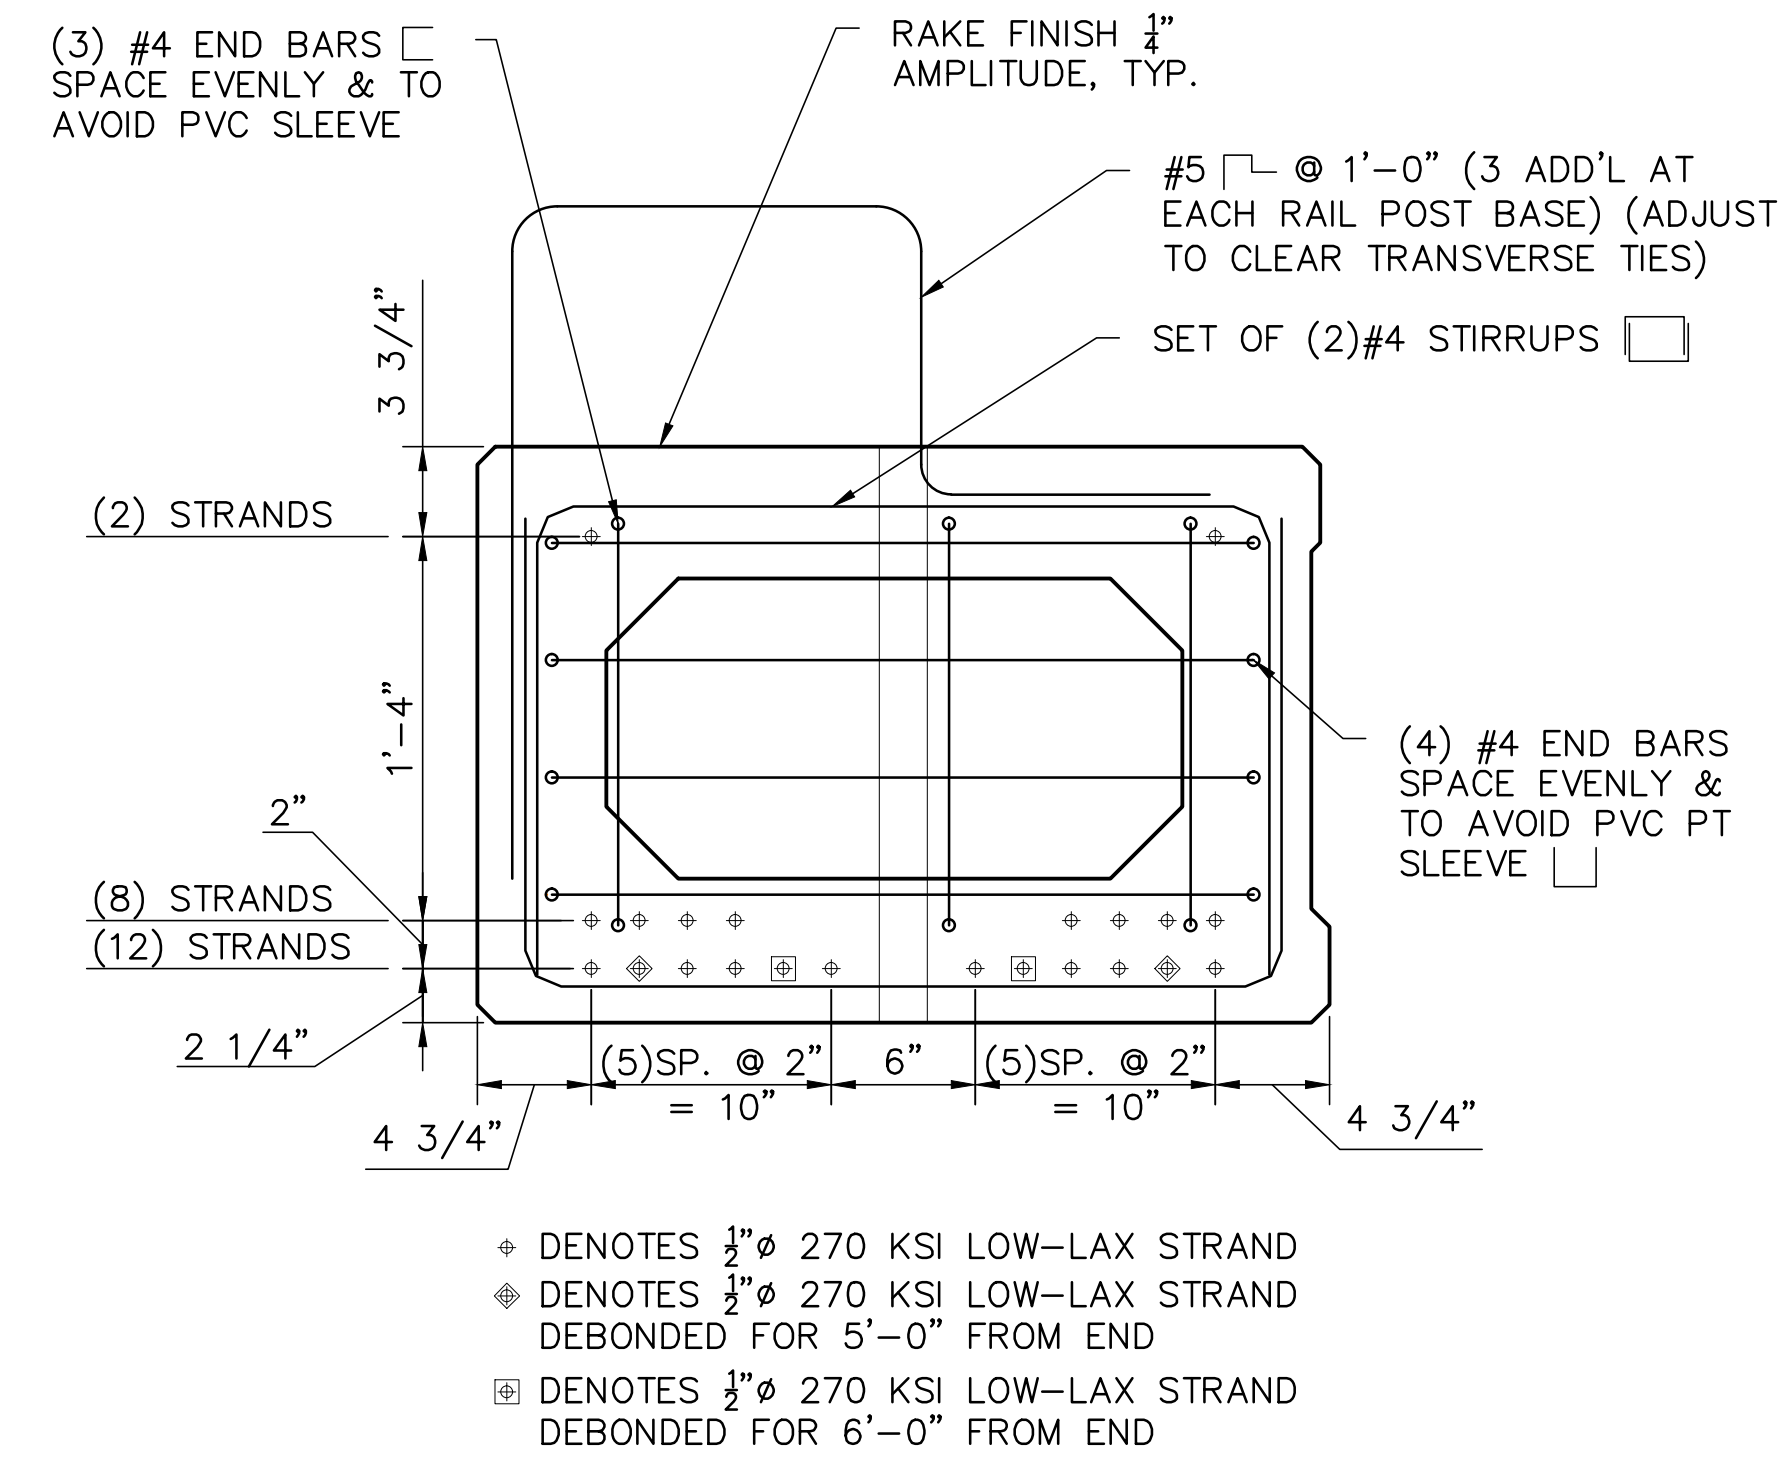

36" Box Beam (Beam B1/B9) End Section

Scale: $1\frac{1}{2}$ " = 1'-0"

- NOTES:
- 1). ALL STRANDS PULLED TO 31 KIPS EACH.
 - 2). BEAM B1 SHOWN WITH SINGLE SHEAR KEY. BEAM B9 OPPOSITE HAND WITH BOTH SHEAR KEYS OMITTED.

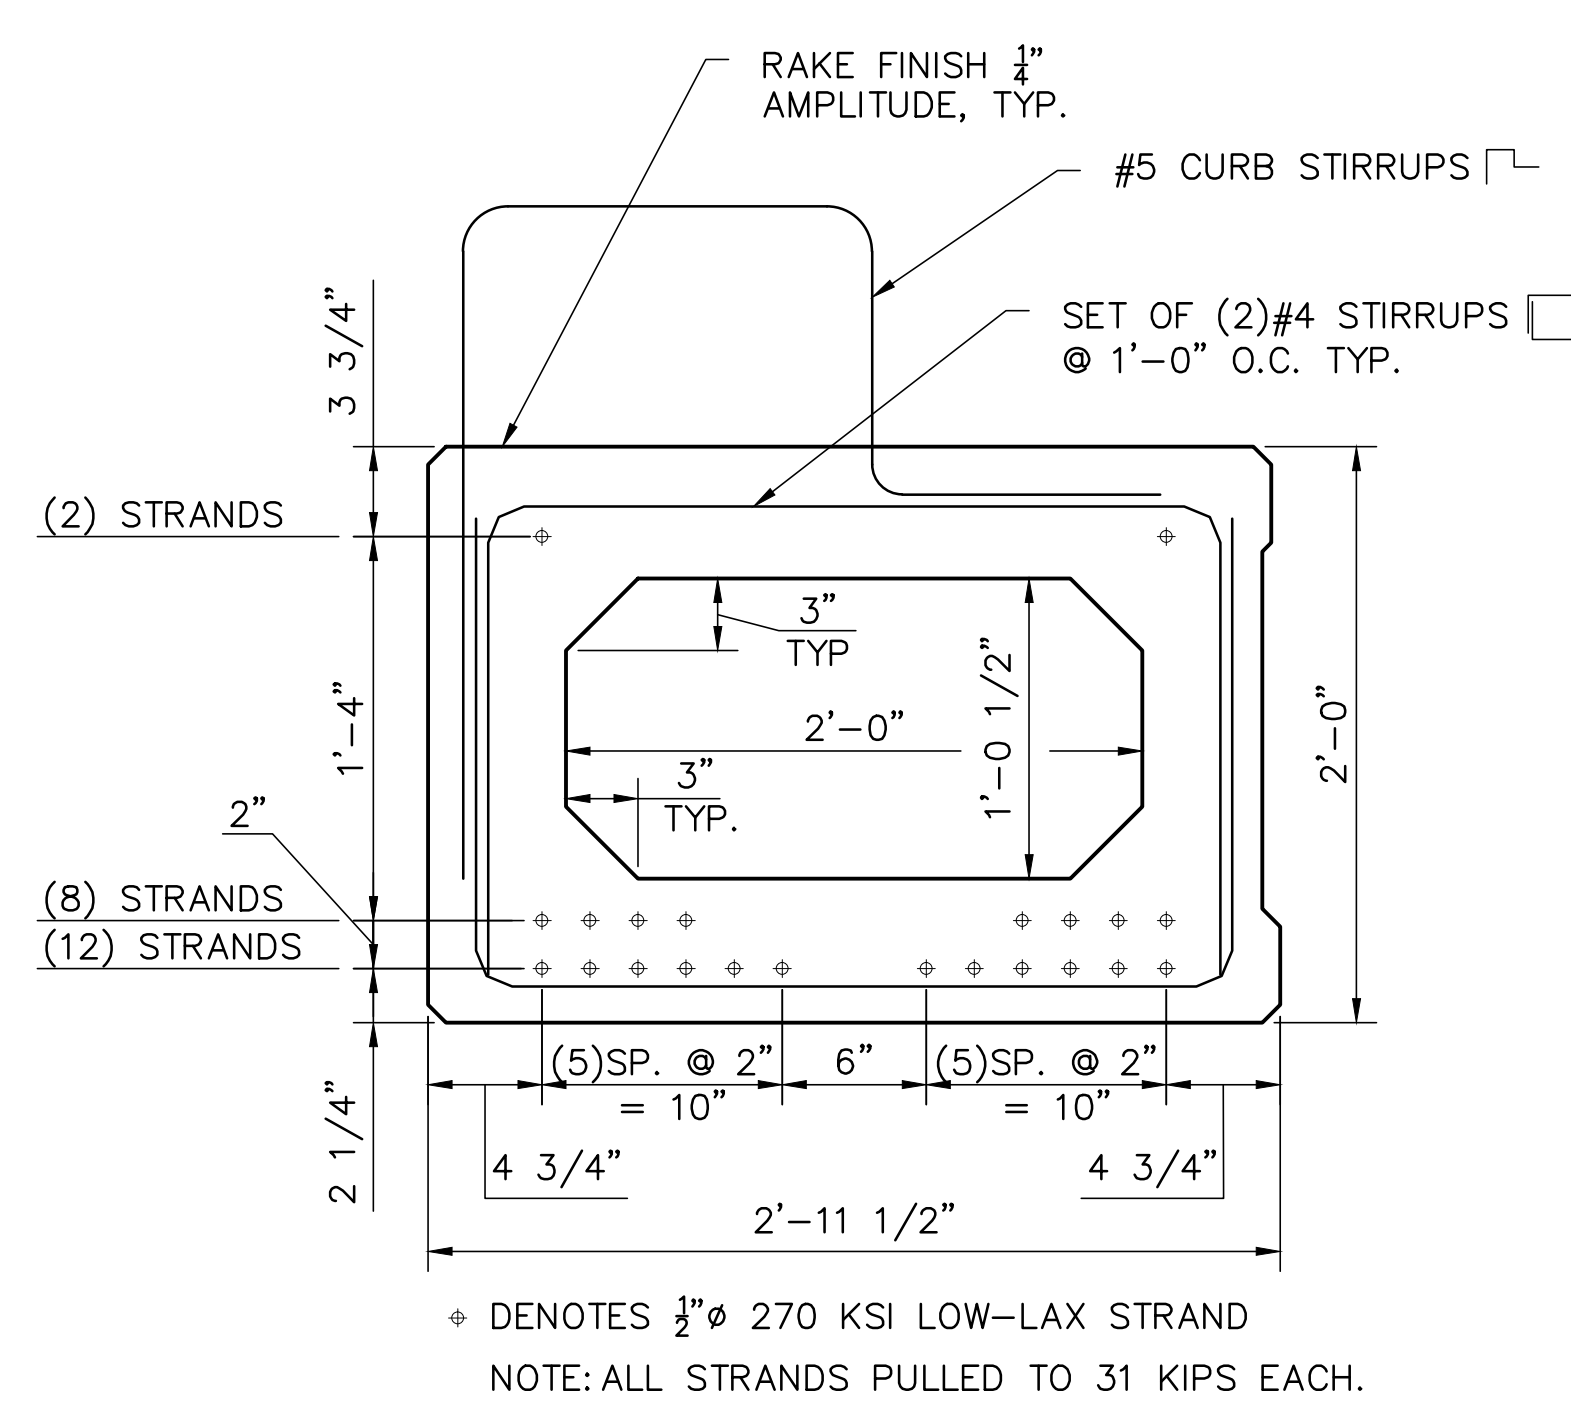

36" Box Beam (Beam B1/B9) Typical Mid Section

Scale: $1\frac{1}{2}$ " = 1'-0"

no.	0	AS-BUILT	1/6/16	JLG	by
revision					date


CMA ENGINEERS
CIVIL/ENVIRONMENTAL ENGINEERS

10 Free Street
Portland, Maine 04101
207.541-4223

35 Bow Street
Portsmouth, NH 03801
603.931-6196


55 So. Commercial Street
Manchester, NH 03101
603.627-0708

www.cmaengineers.com
info@cmaengineers.com

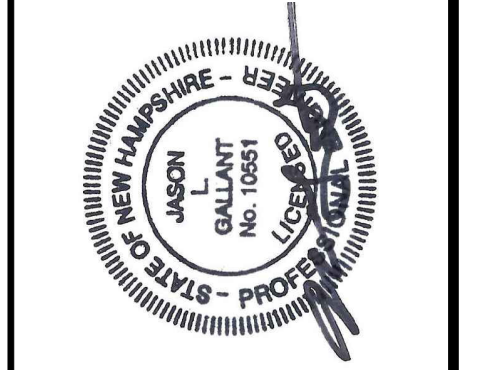


date:	July 2015	designed by:	LBK/OGK
project no:	923	drawn by:	LBK/OGK
file name:	923 - Structural Plans.dwg	approved by:	JLG
scale:	AS SHOWN		

Town of Exeter
Department of Public Works
Linden Street
Little River Bridge Replacement
Prestressed Box Beam
Details (Sheet 2 of 3)

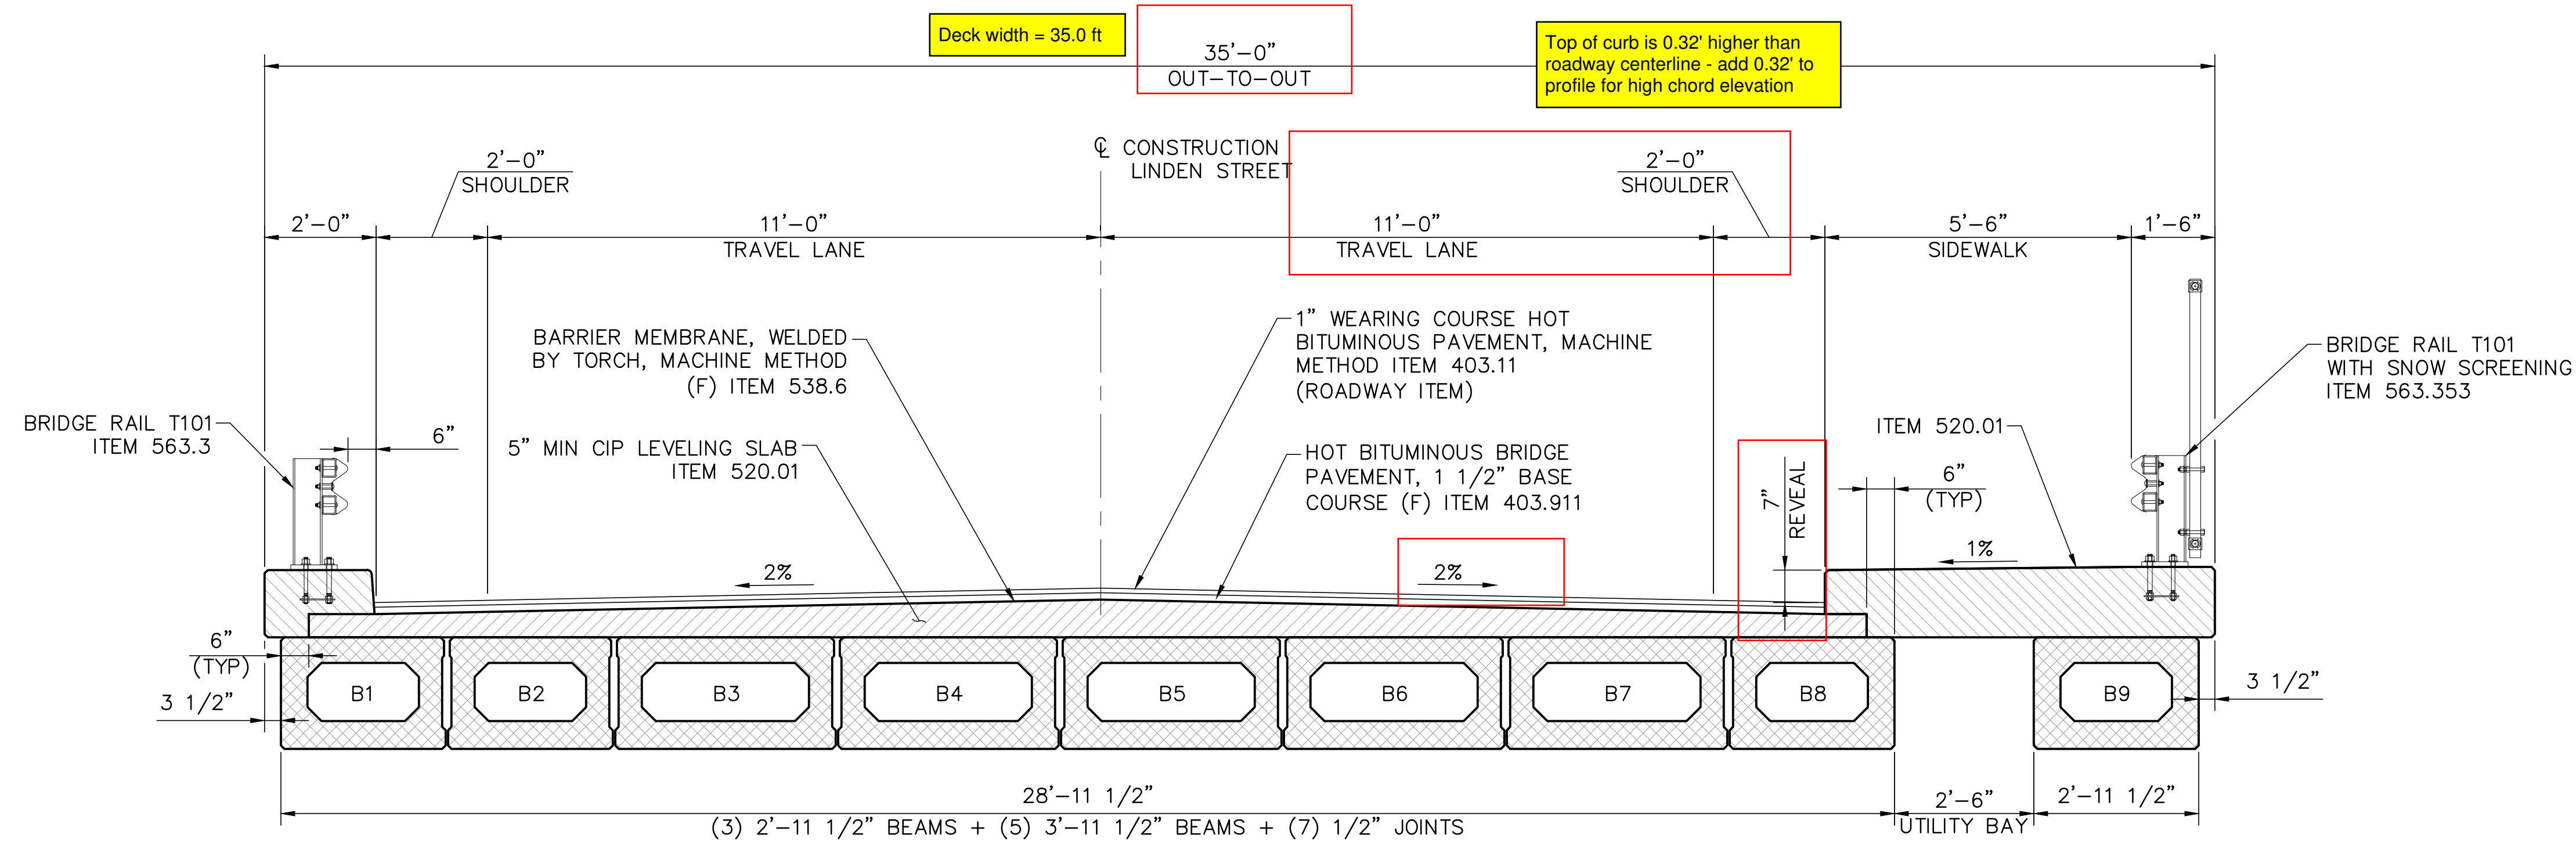

Typical Deck Section
Scale: 1/2" = 1'-0"

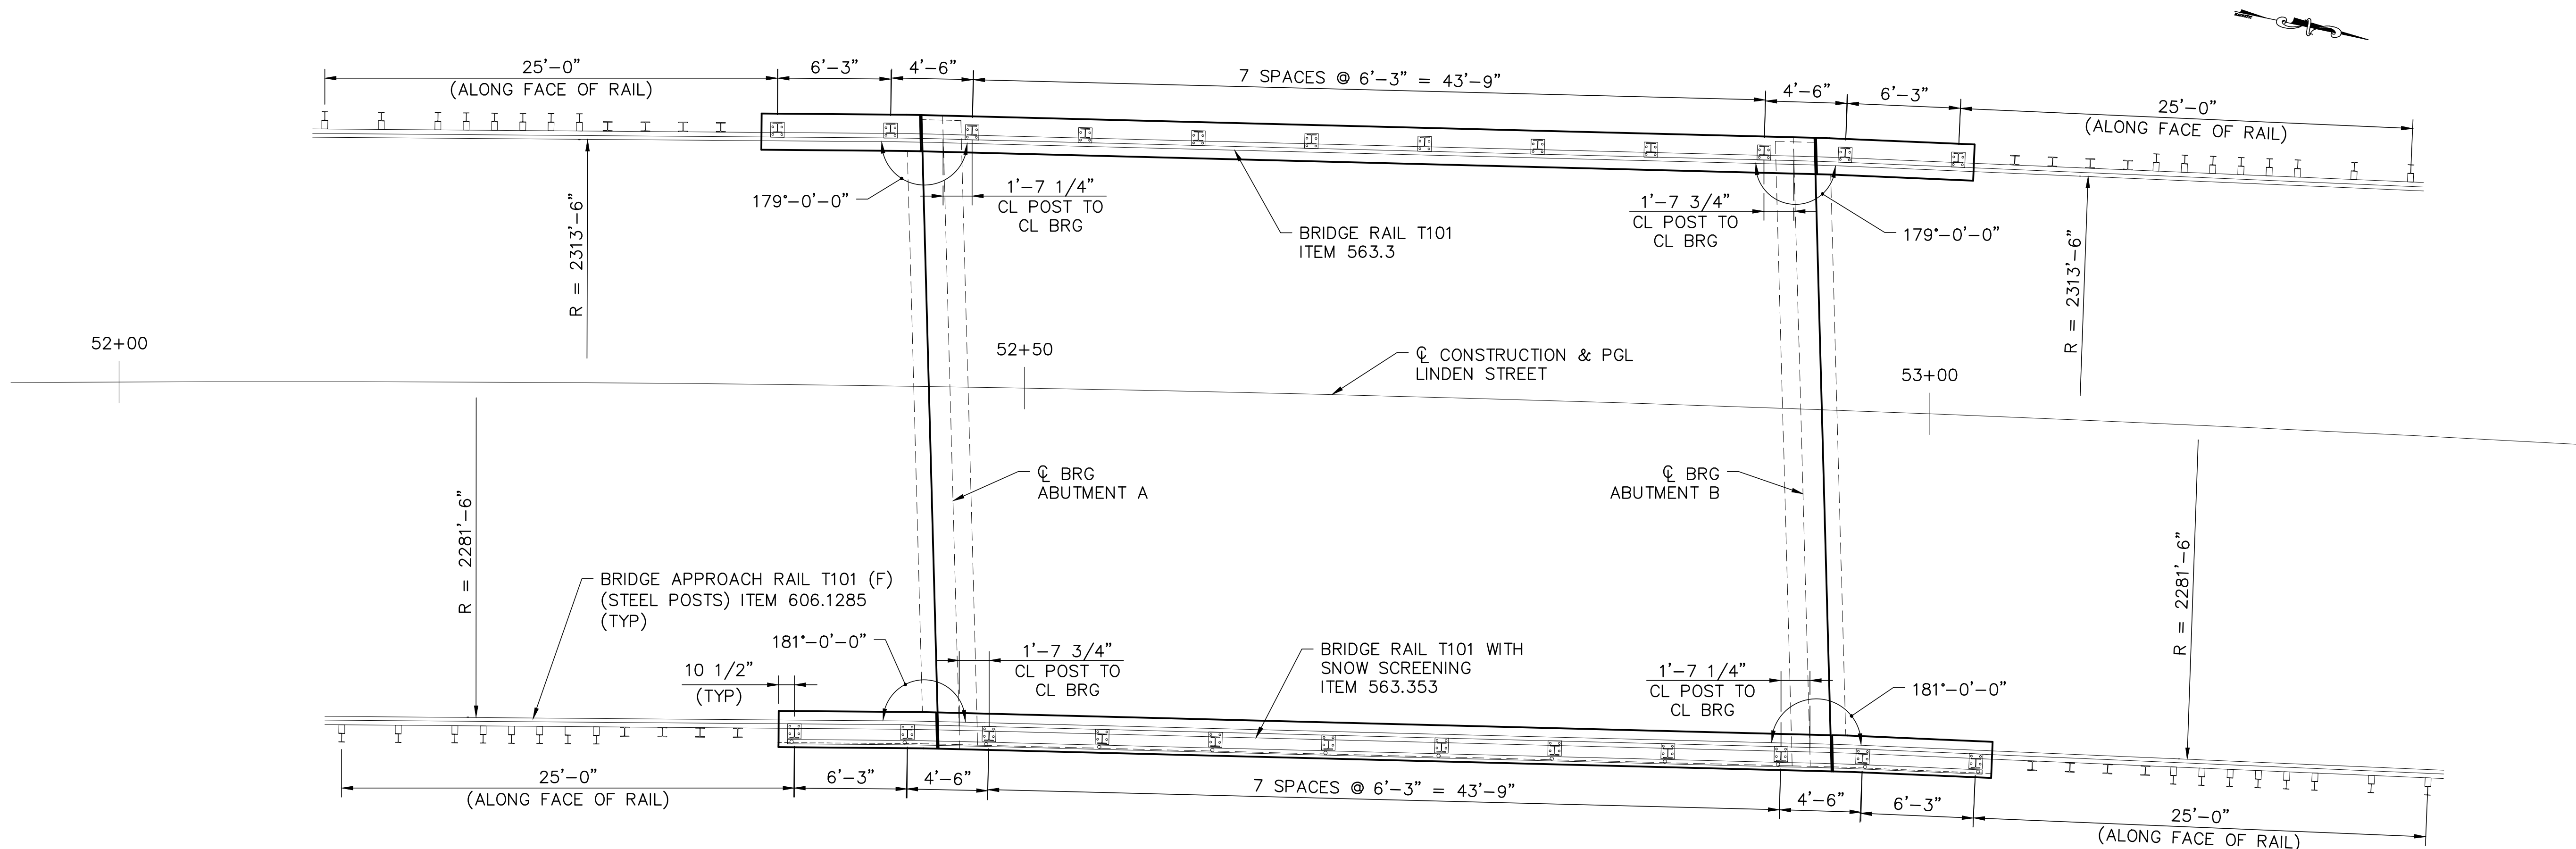

Rail Layout Plan
Scale: 1" = 5'-0"

no.	0	AS-BUILT	revision	1/6/16	JLG	by
-----	---	----------	----------	--------	-----	----


CMA ENGINEERS
CIVIL/ENVIRONMENTAL ENGINEERS

35 Bow Street
Portsmouth, NH 03801
603-431-6196

10 Free Street
Portland, Maine 04101
207-541-4225


55 So. Commercial Street
Manchester, NH 03101
603-667-0708

www.cmaengineers.com
info@cmaengineers.com

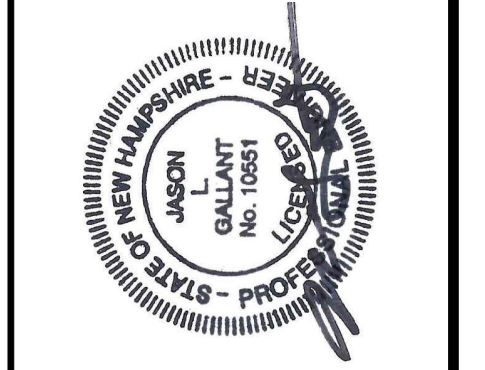


designed by:	LBK/OGK
drawn by:	LBK/OGK
approved by:	JLG
date:	July 2015
project no:	923
file name:	923 - Structural Plans.dwg
scale:	AS SHOWN

Town of Exeter
Department of Public Works
Linden Street
Little River Bridge Replacement
Typical Section
and Rail Layout

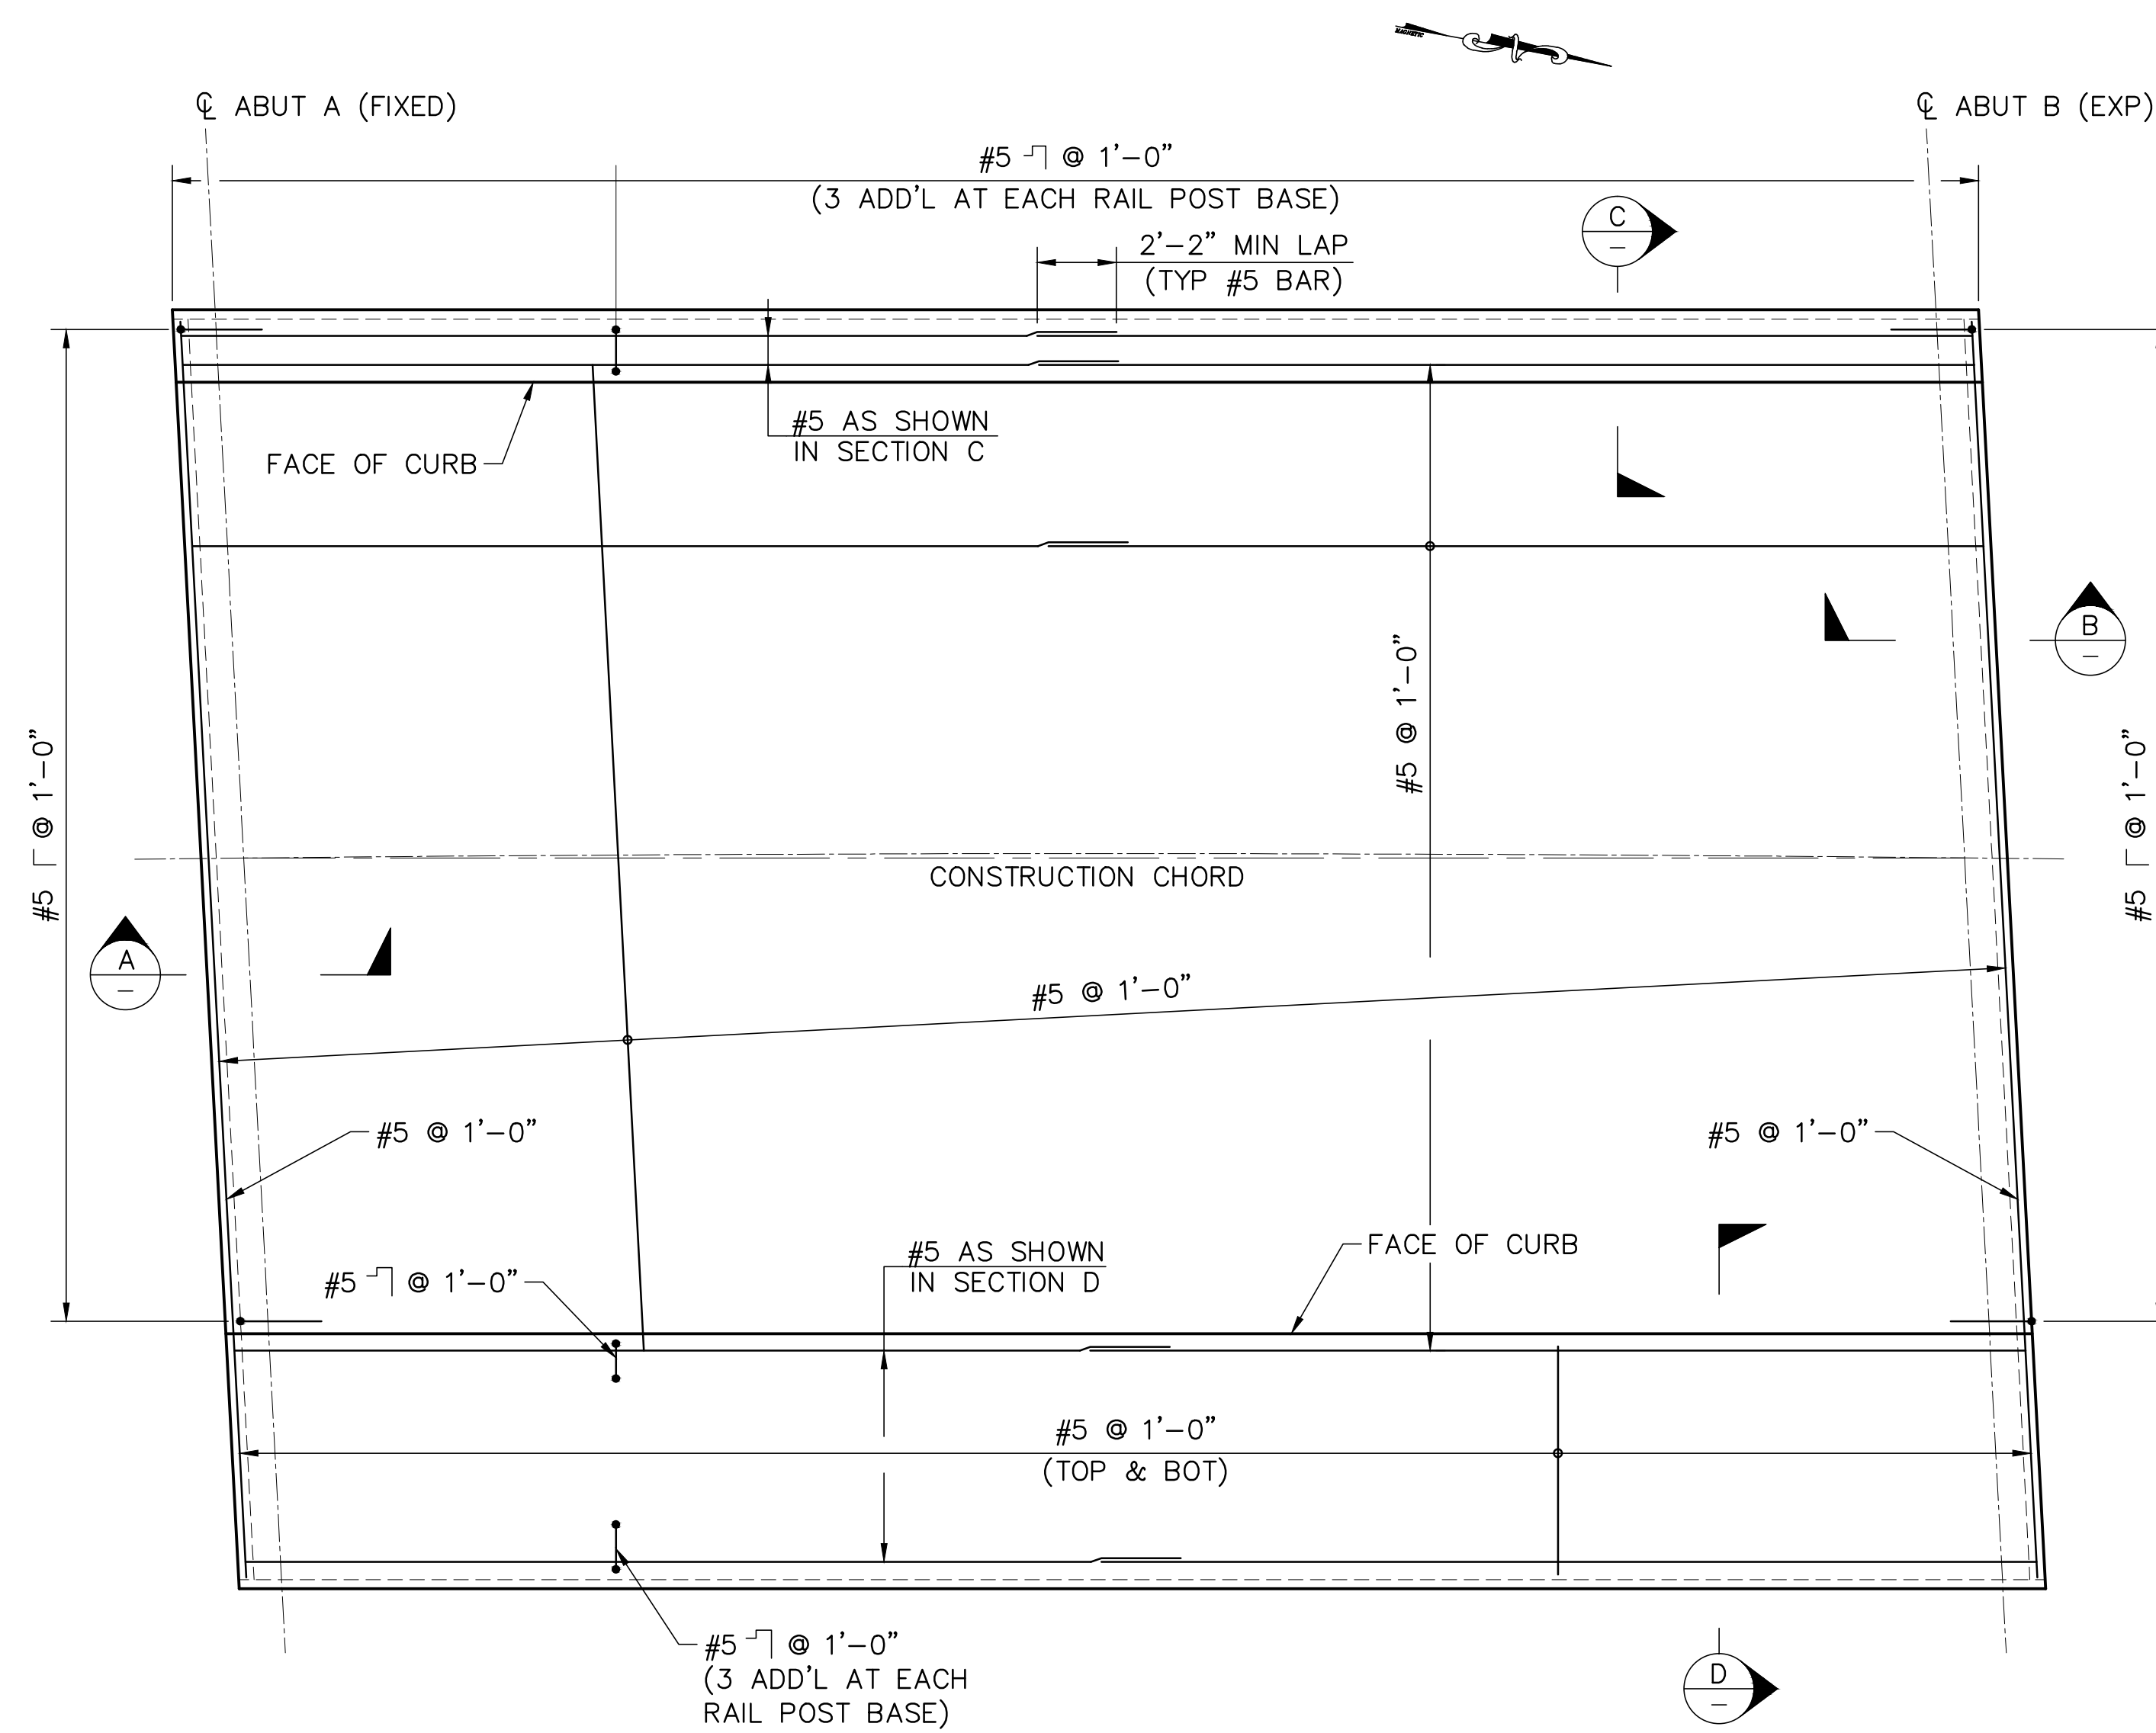

Overlay and Curb Reinforcing Plan

Scale: 1/4"=1'-0"

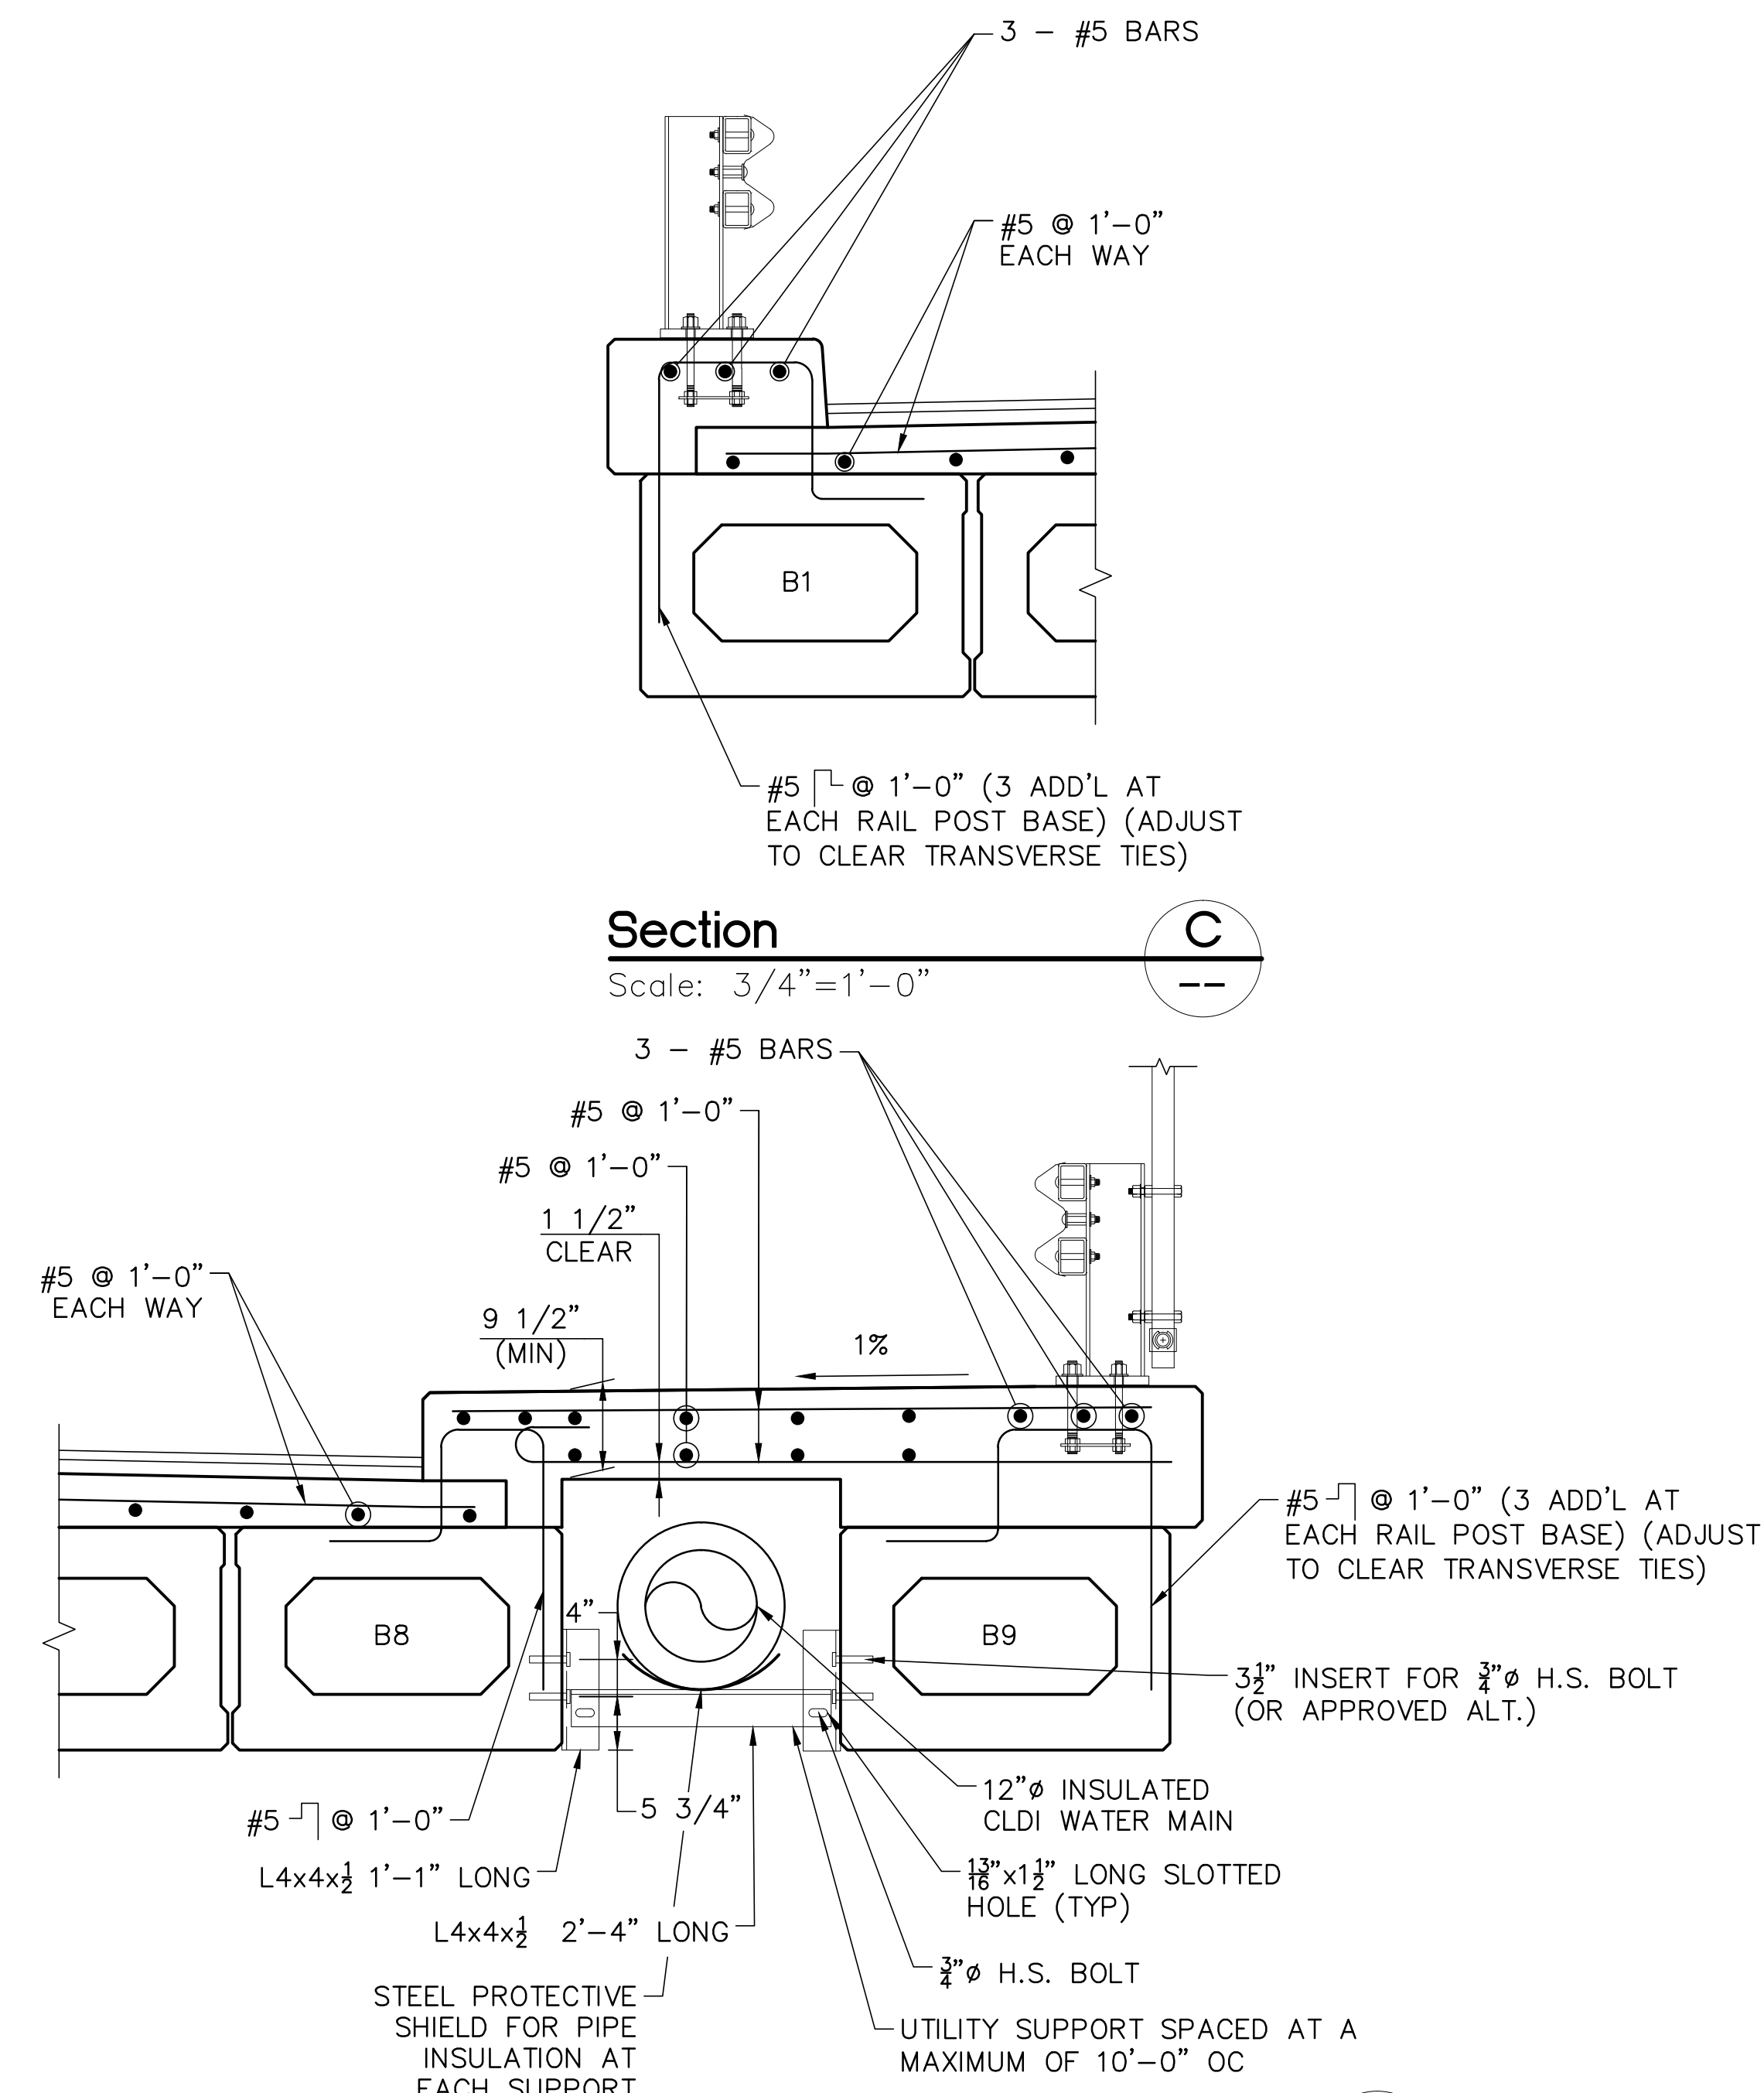


Section C

Scale: 3/4"=1'-0"

Section D

Scale: 3/4"=1'-0"

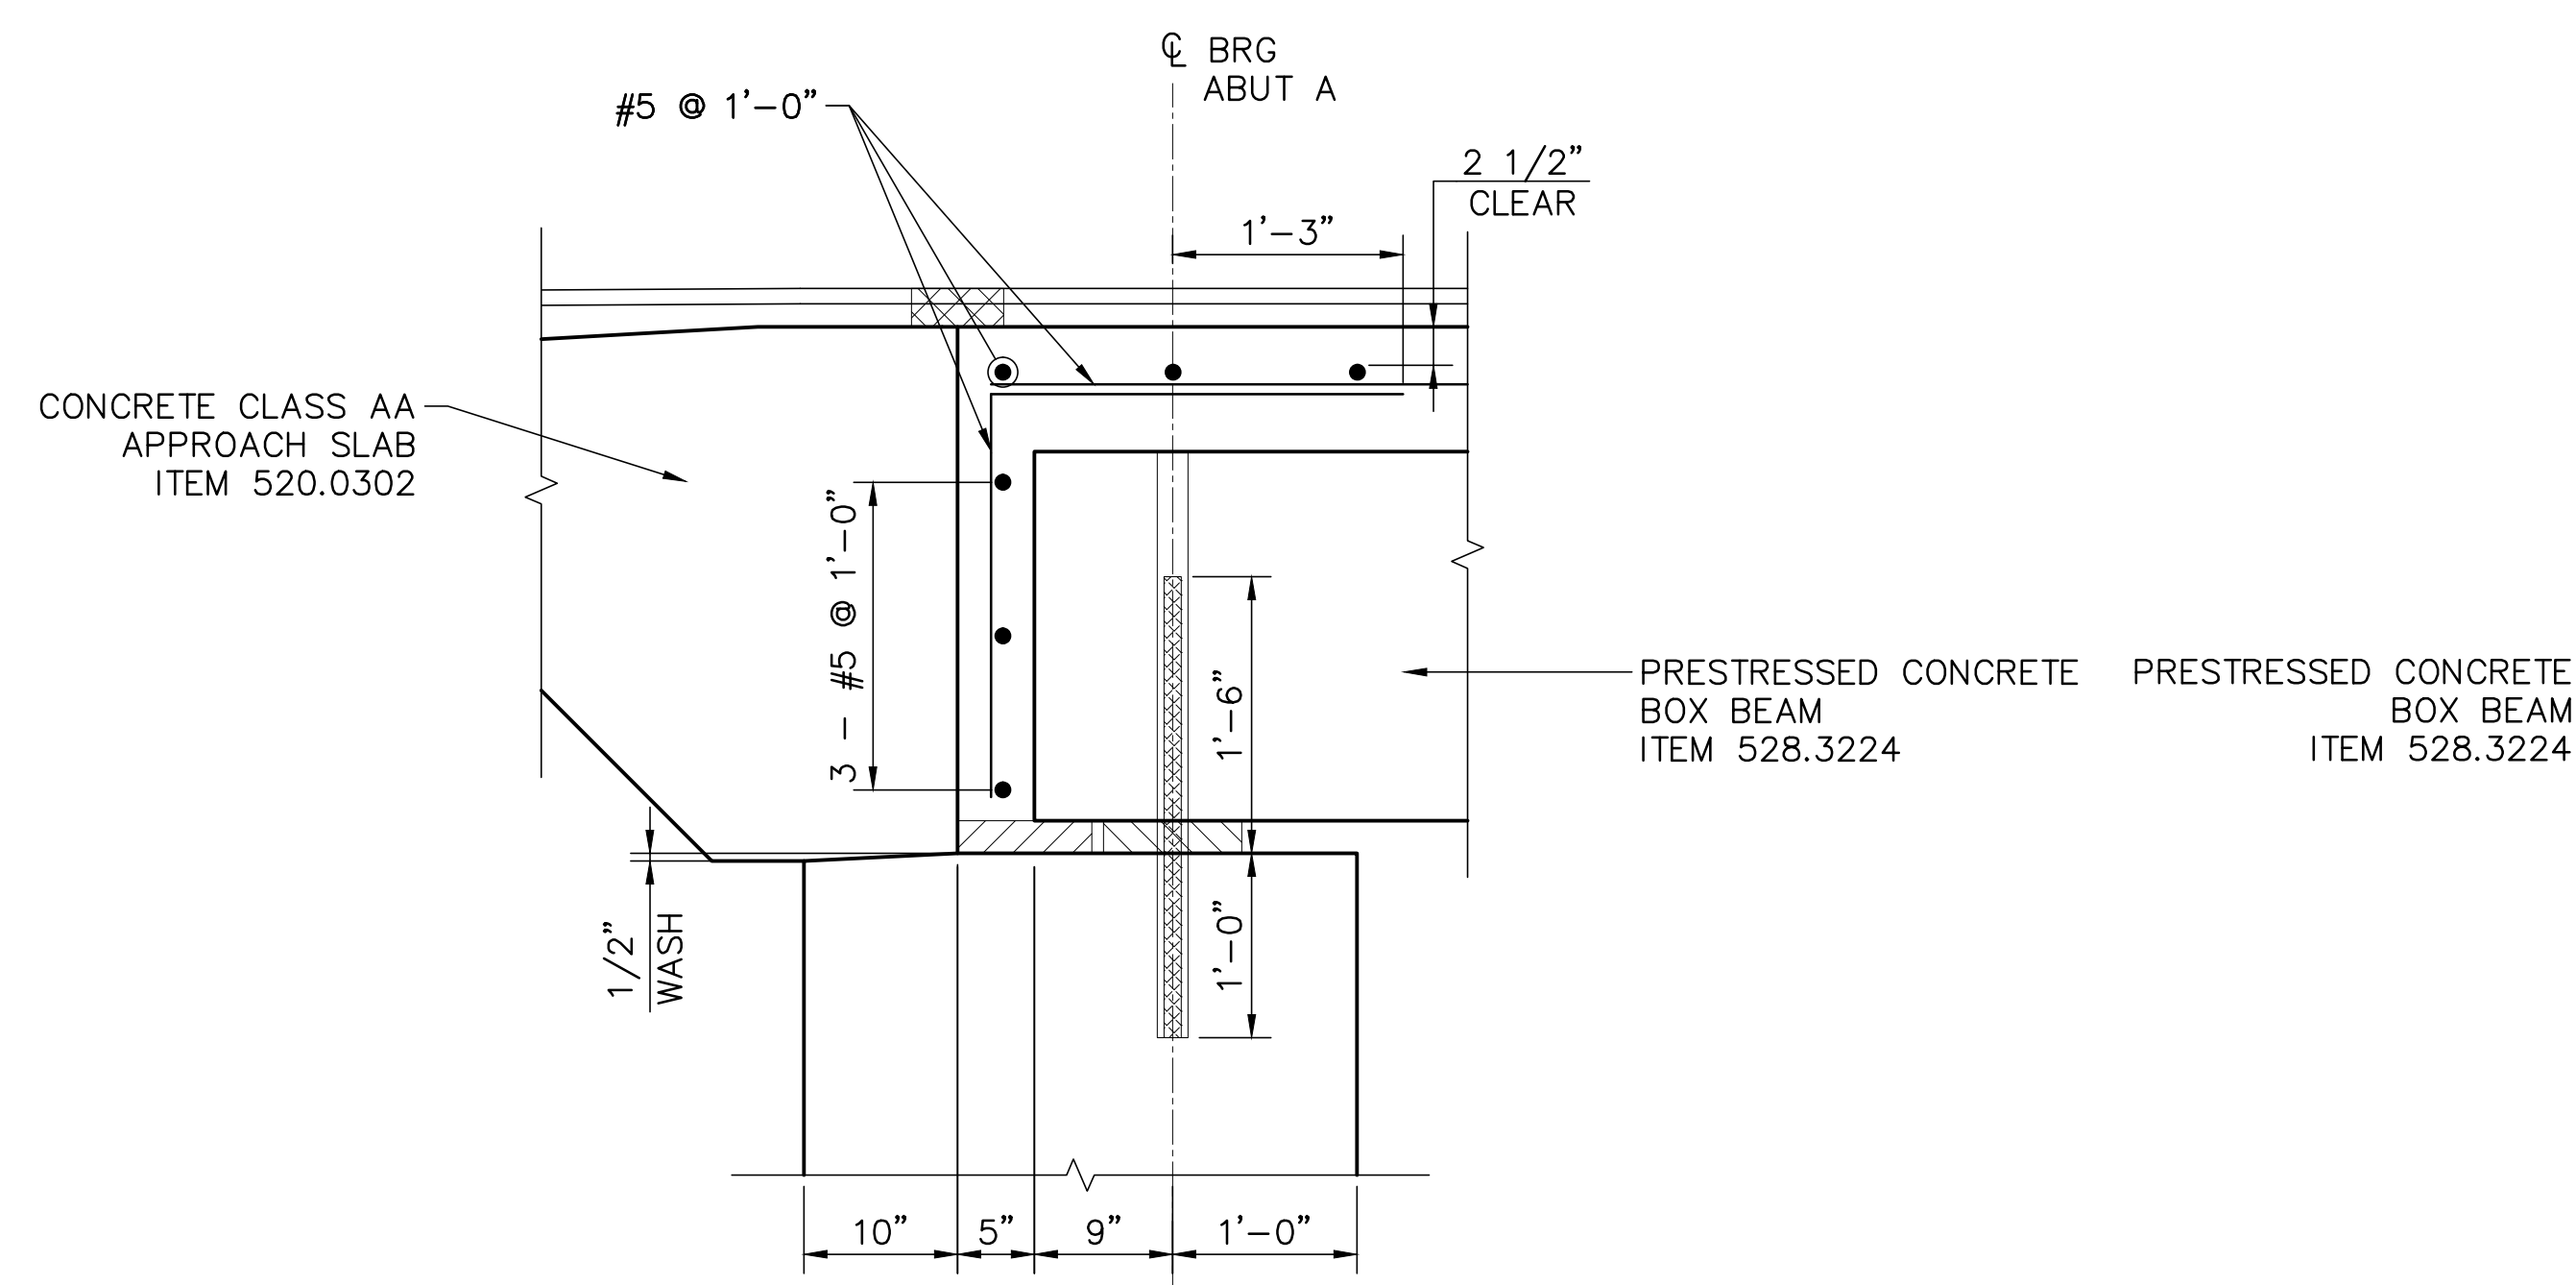


Section A

Scale: 1"=1'-0"


Section B

Scale: 1"=1'-0"

<p>CMA ENGINEERS CIVIL/ENVIRONMENTAL ENGINEERS</p> <p>35 Bow Street Portsmouth, NH 03801 603-431-6196 10 Free Street Portland, Maine 04101 207-541-4225</p> <p>info@cmaengineers.com www.cmaengineers.com</p>		<p>date: July 2015 project no: 923 file name: 923 - Structural Plans.dwg</p>	<p>designed by: LBK/OGK drawn by: LBK/OGK approved by: JLG</p>	<p>scale: AS SHOWN</p>
<p>Town of Exeter Department of Public Works Linden Street Little River Bridge Replacement Superstructure Details</p>		<p>drawing no: B-15</p>	<p>revision: 0 AS-BUILT</p>	<p>date: 1/6/16 by: JLG</p>
<p>sheet: 16 of 29</p>		<p>F:\CADD\PROJECTS\923-Exeter Bridges\Production\Linden St\As-Built\923 - Structural Plans.dwg Date Plotted: Jan 06, 2016 - 2:14pm Plotted By: LKALLOCH</p>		

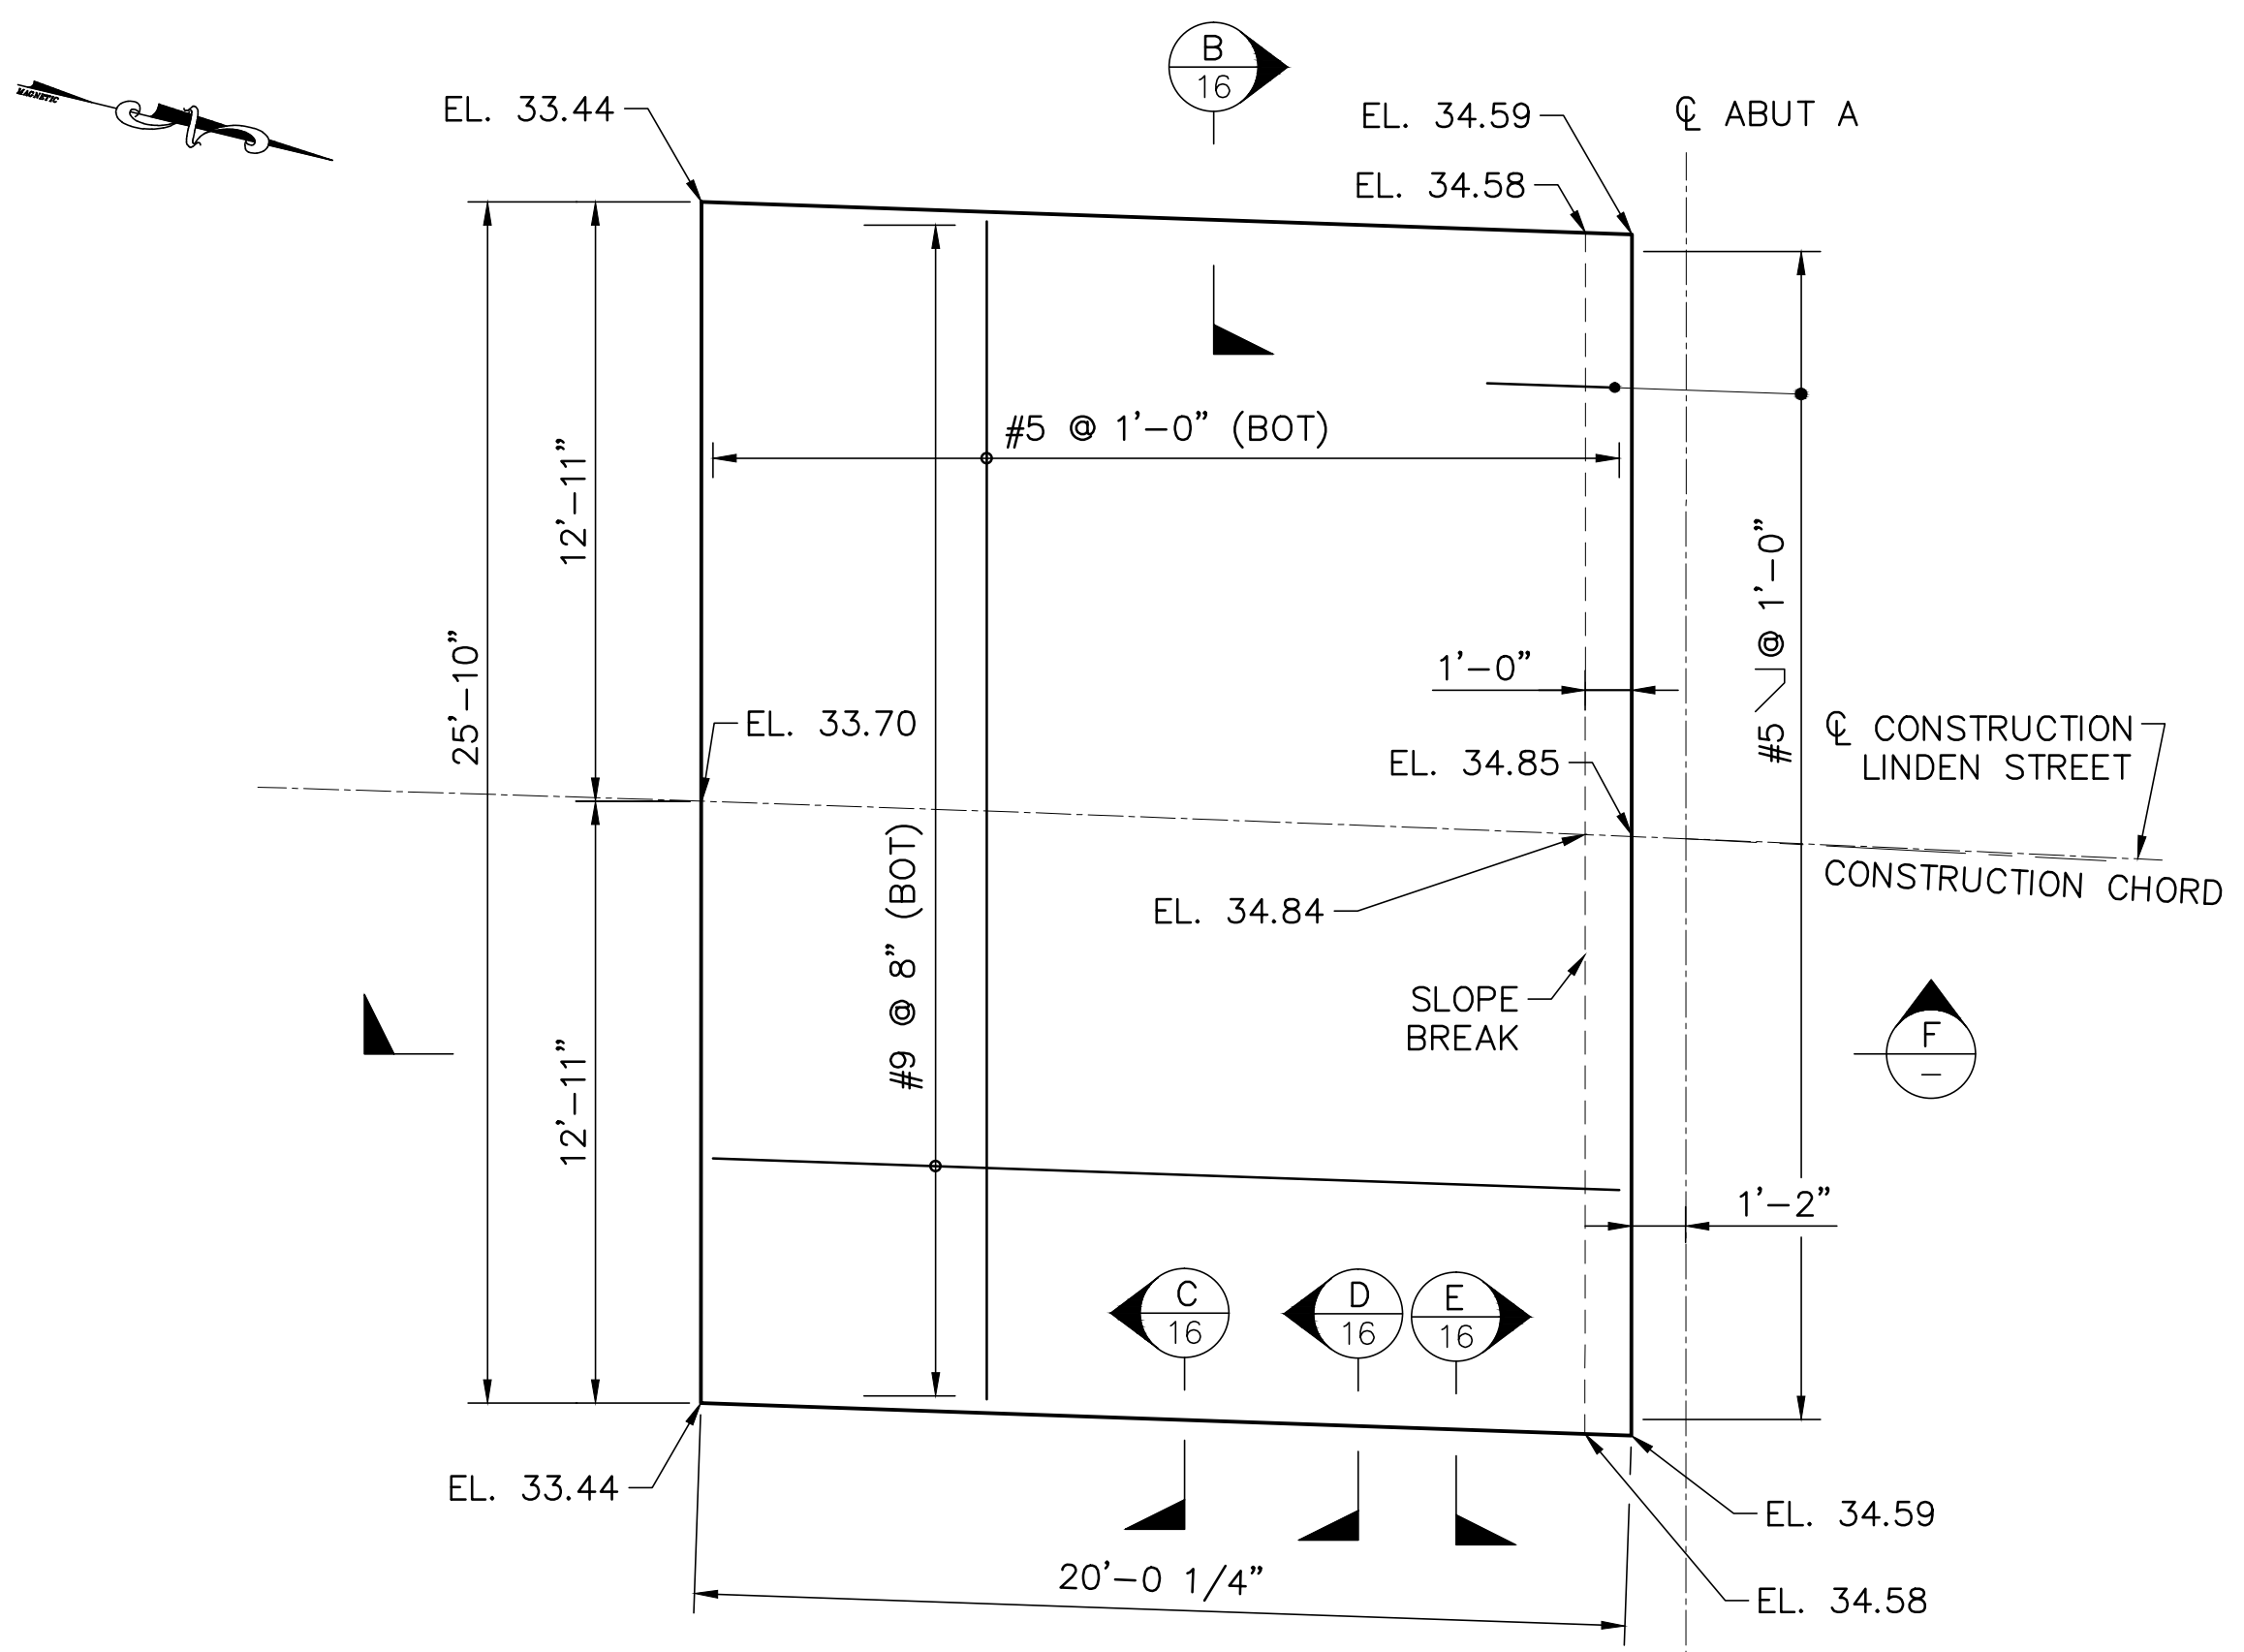


Abutment A

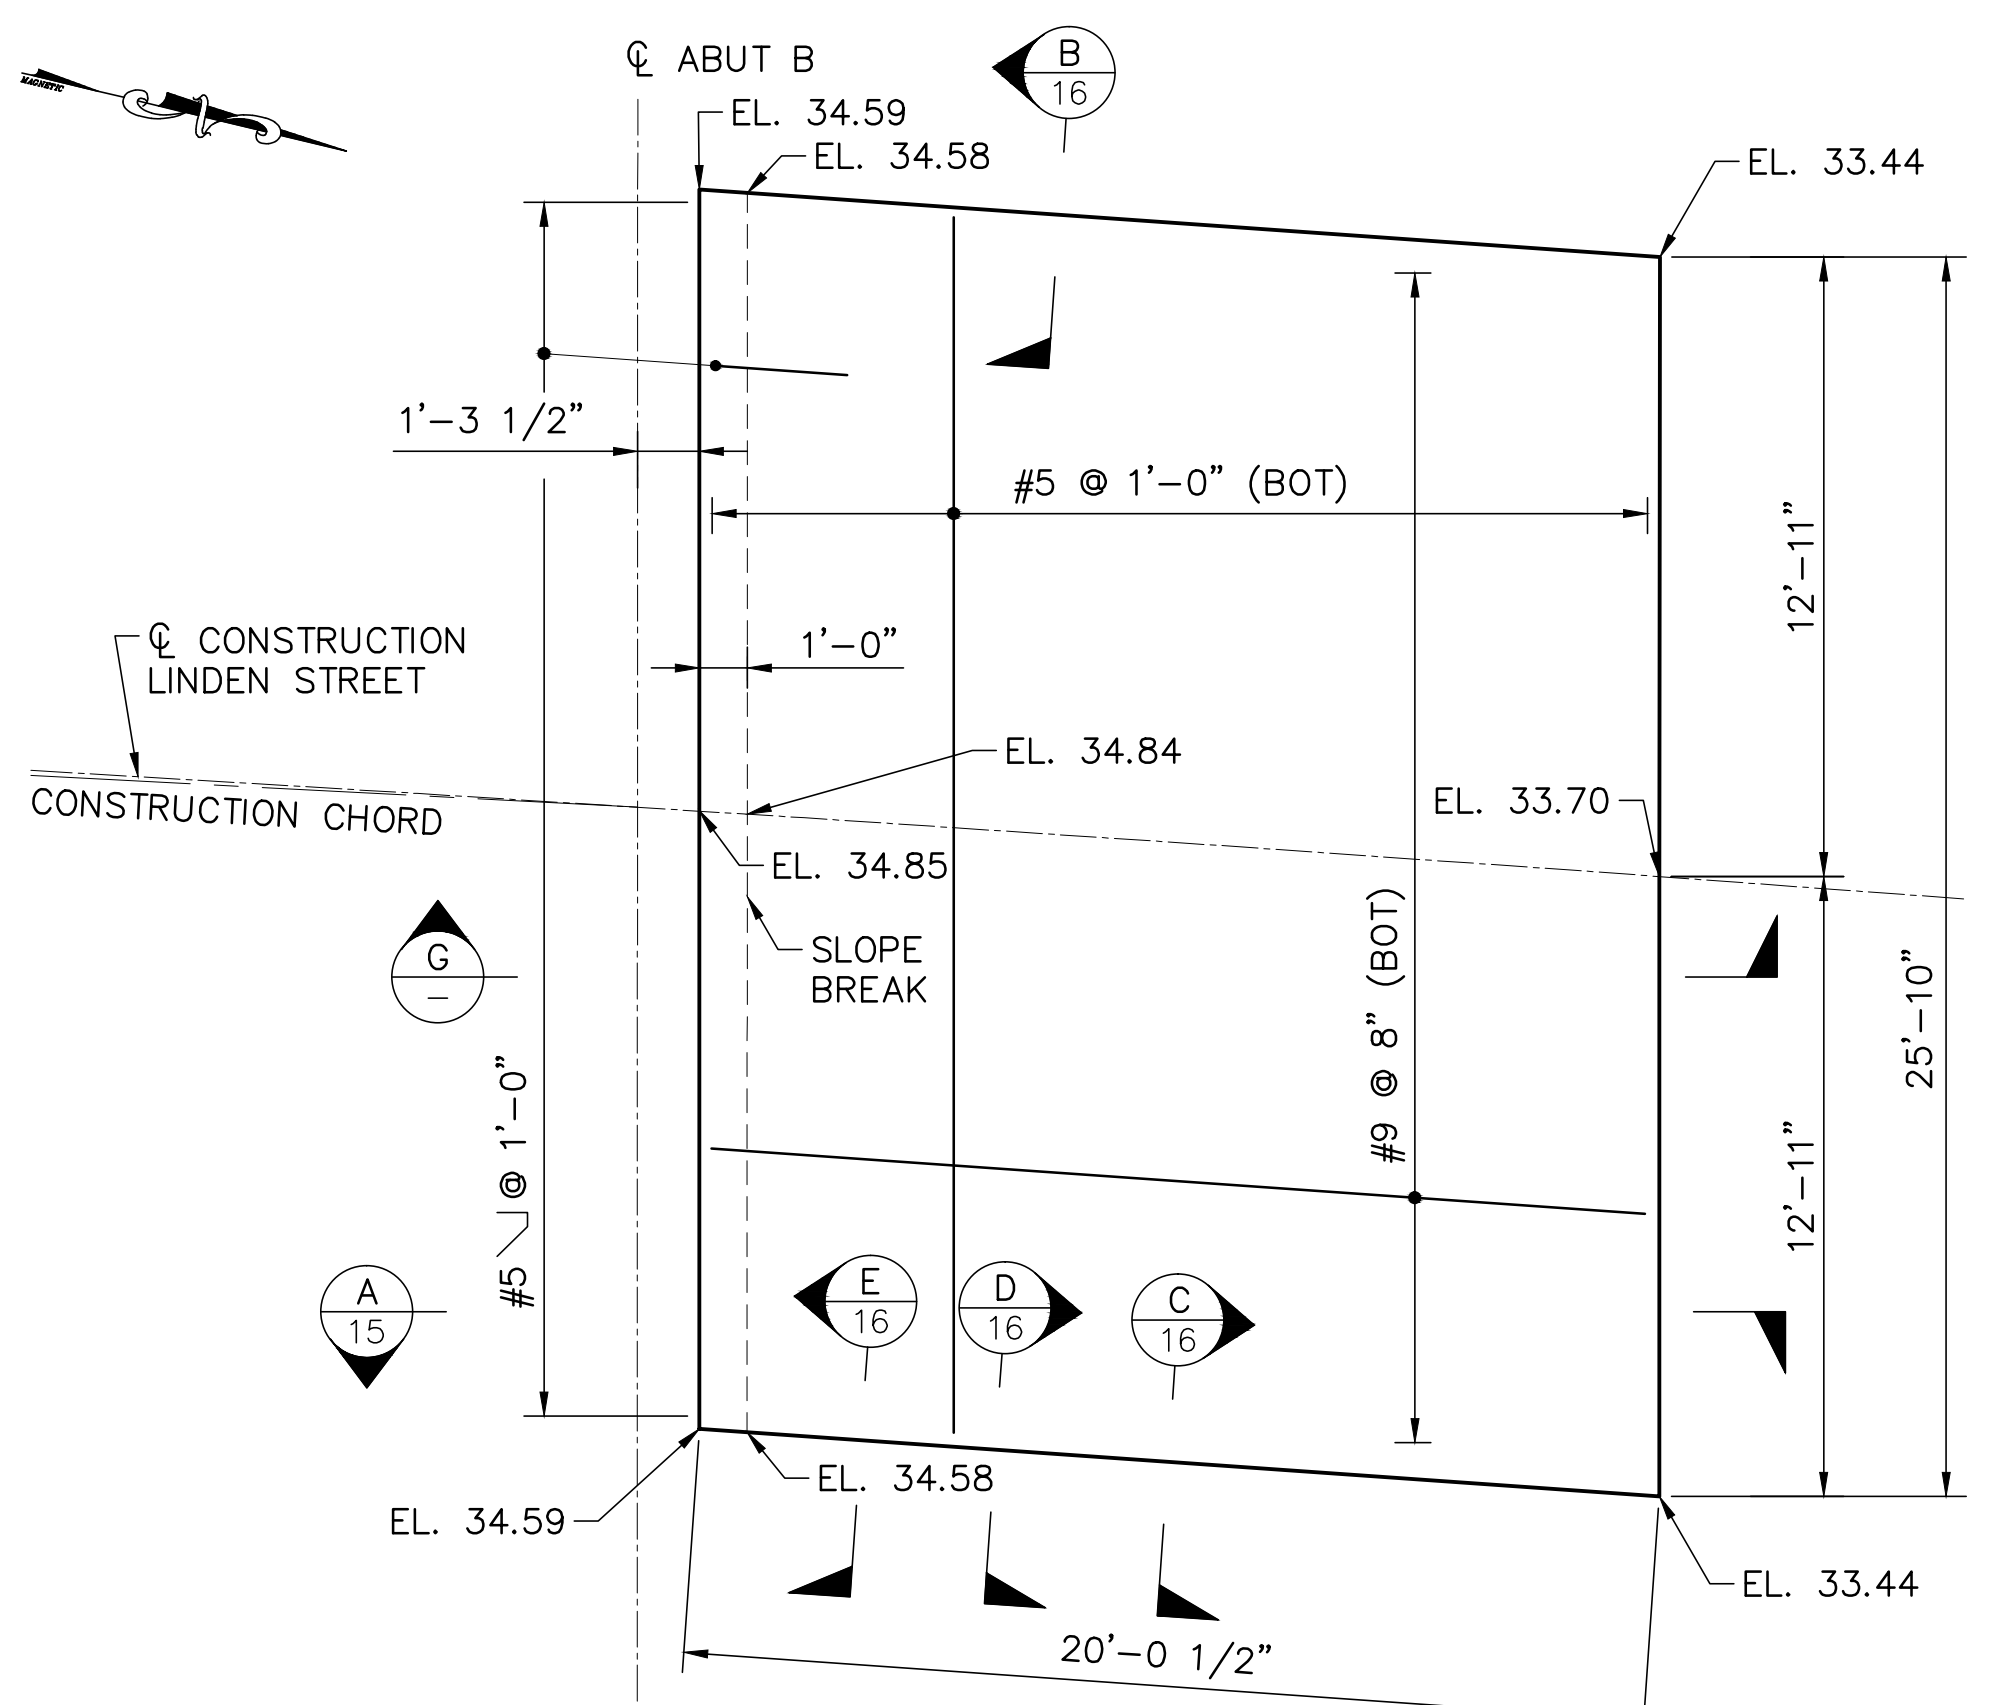


Abutment B

Approach Slab Plan
Scale: 1/4" = 1'-0"

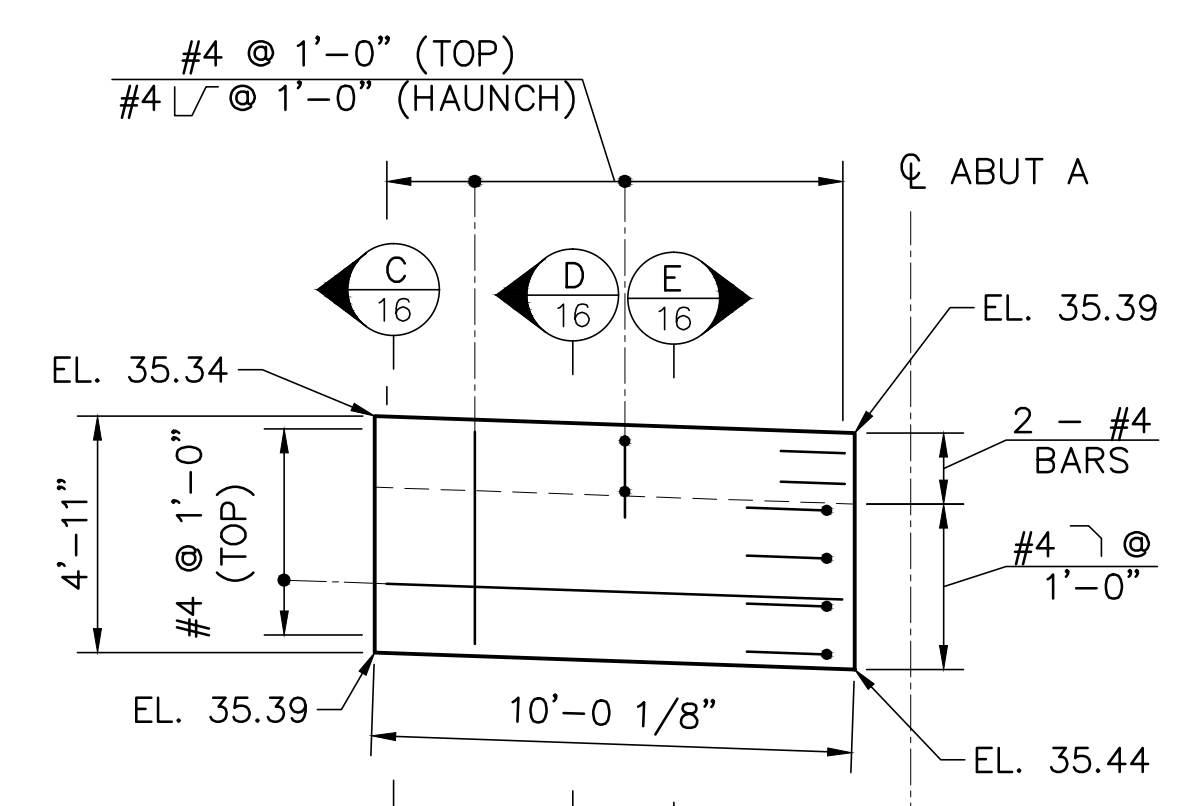


Abutment A

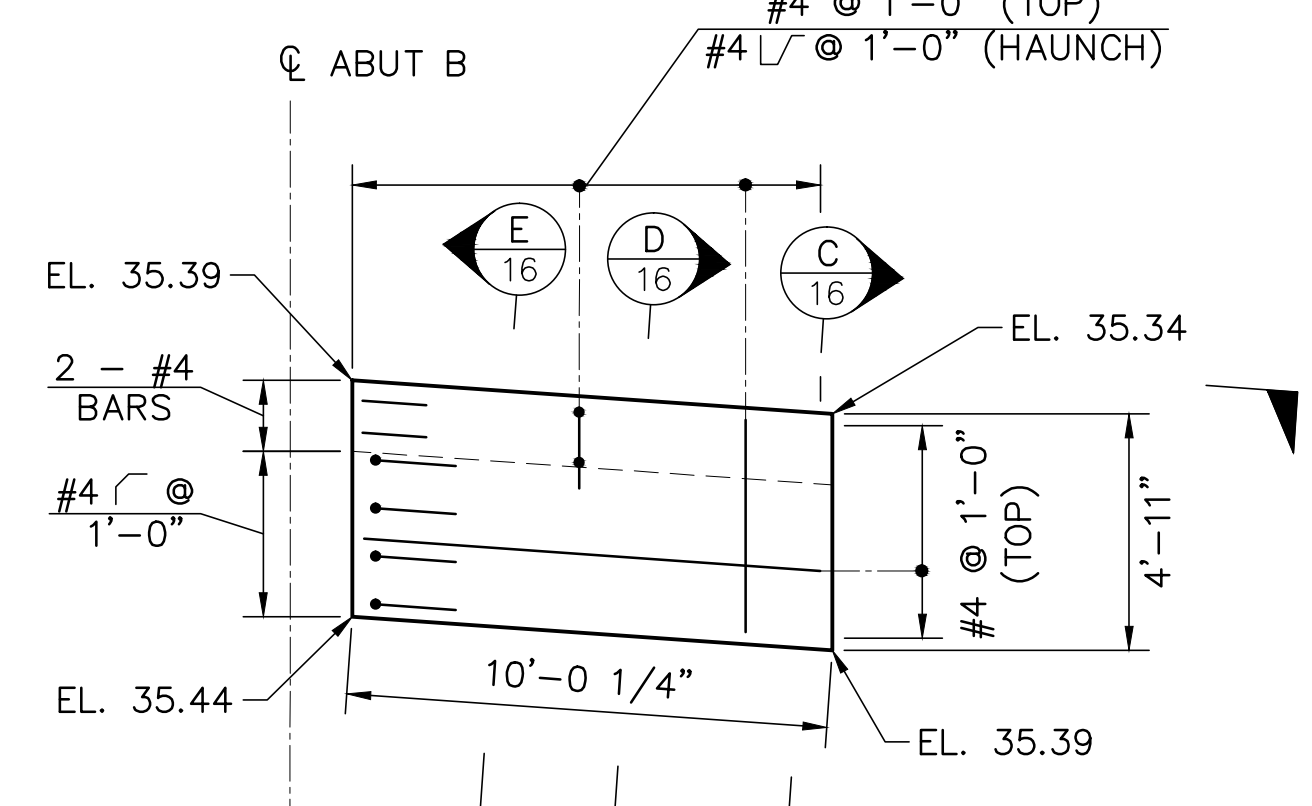

Abutment B


Sidewalk Approach Slab Plan
Scale: 1/4" = 1'-0"

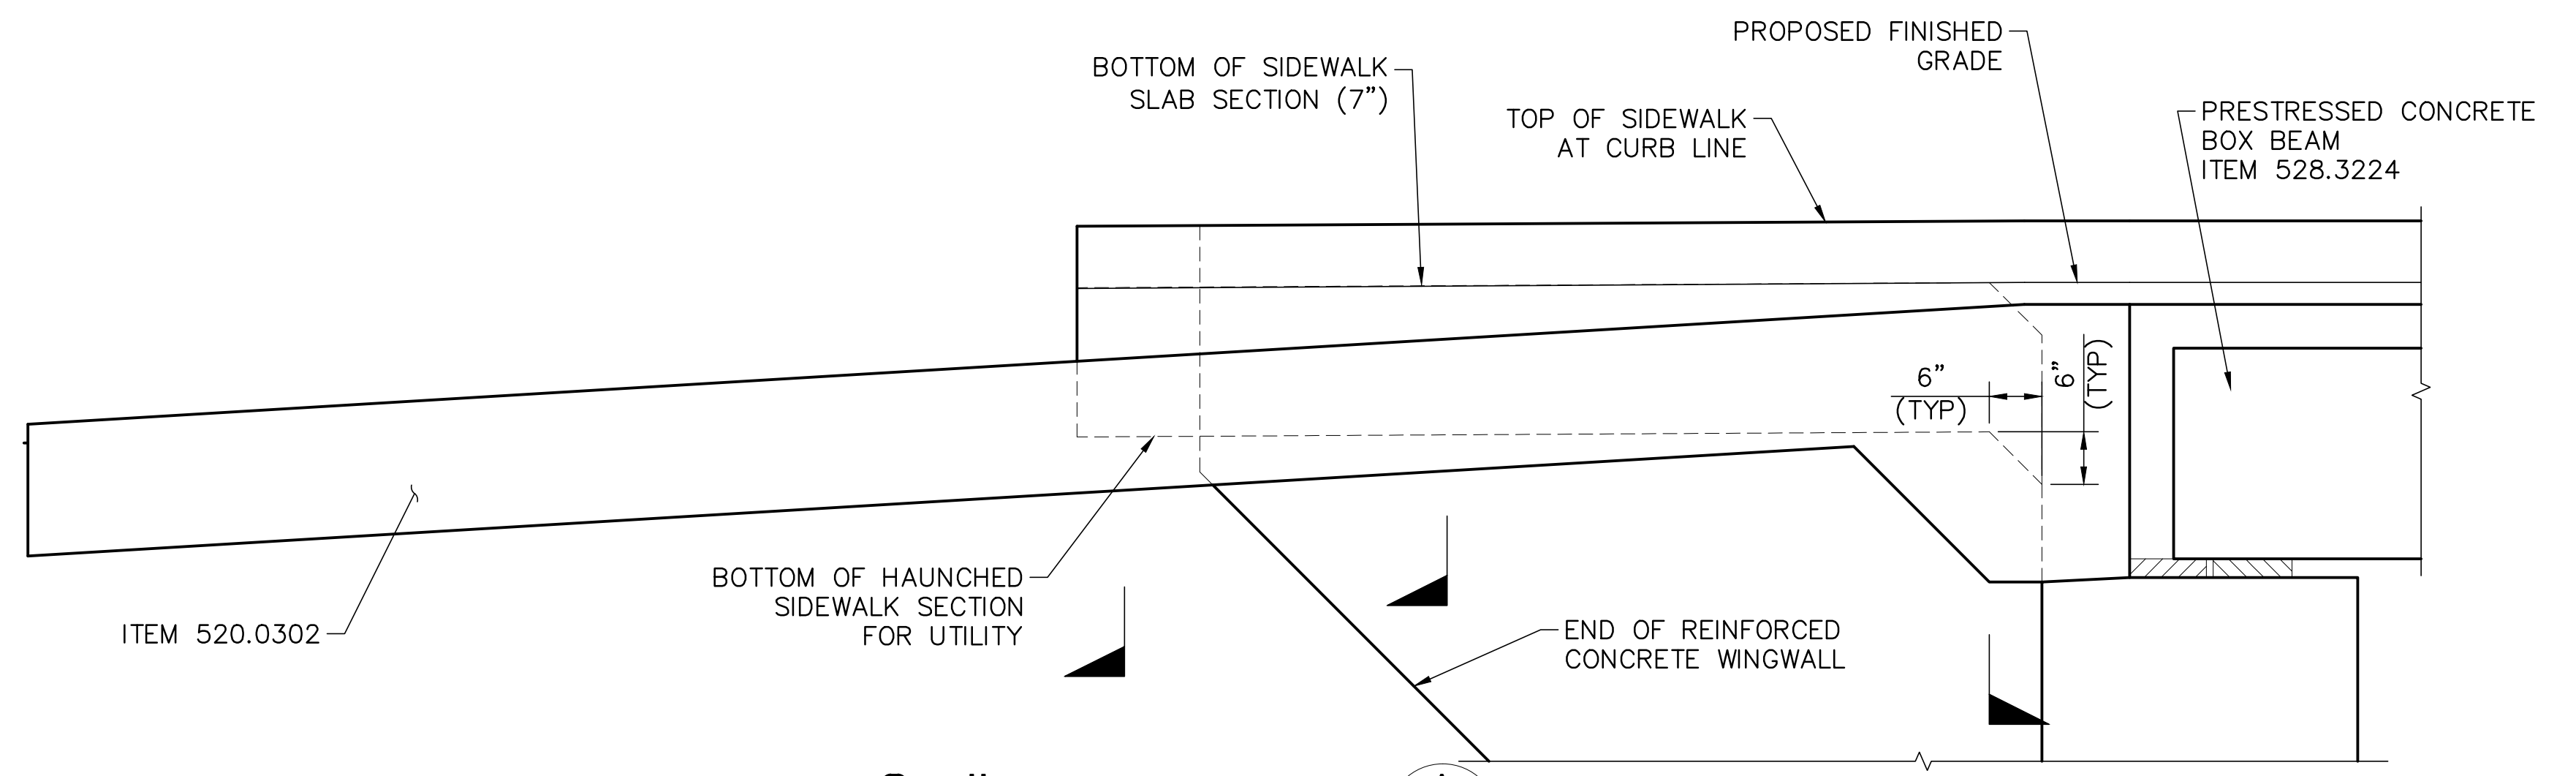


Section

Scale: 3/4" = 1'-0"


<p>CMA ENGINEERS CIVIL/ENVIRONMENTAL ENGINEERS</p> <p>10 Free Street Portland, Maine 04101 207.541-4225</p> <p>35 Bow Street Portsmouth, NH 03801 603.431-6196</p> <p>info@cmaengineers.com www.cmaengineers.com</p>		<p>designed by: LBK/OGK drawn by: LBK/OGK approved by: JLG</p> <p>date: July 2015 project no: 923 file name: 923 - Structural Plans.dwg</p> <p>scale: AS SHOWN</p>	<p>no. 0 revision AS-BUILT</p> <p>no. 1/6/16 date JLG</p>
<p>Town of Exeter Department of Public Works Linden Street Little River Bridge Replacement Approach Slab Details (Sheet 1 of 2)</p>		<p>drawing no. B-16 sheet: 17 of 29</p>	

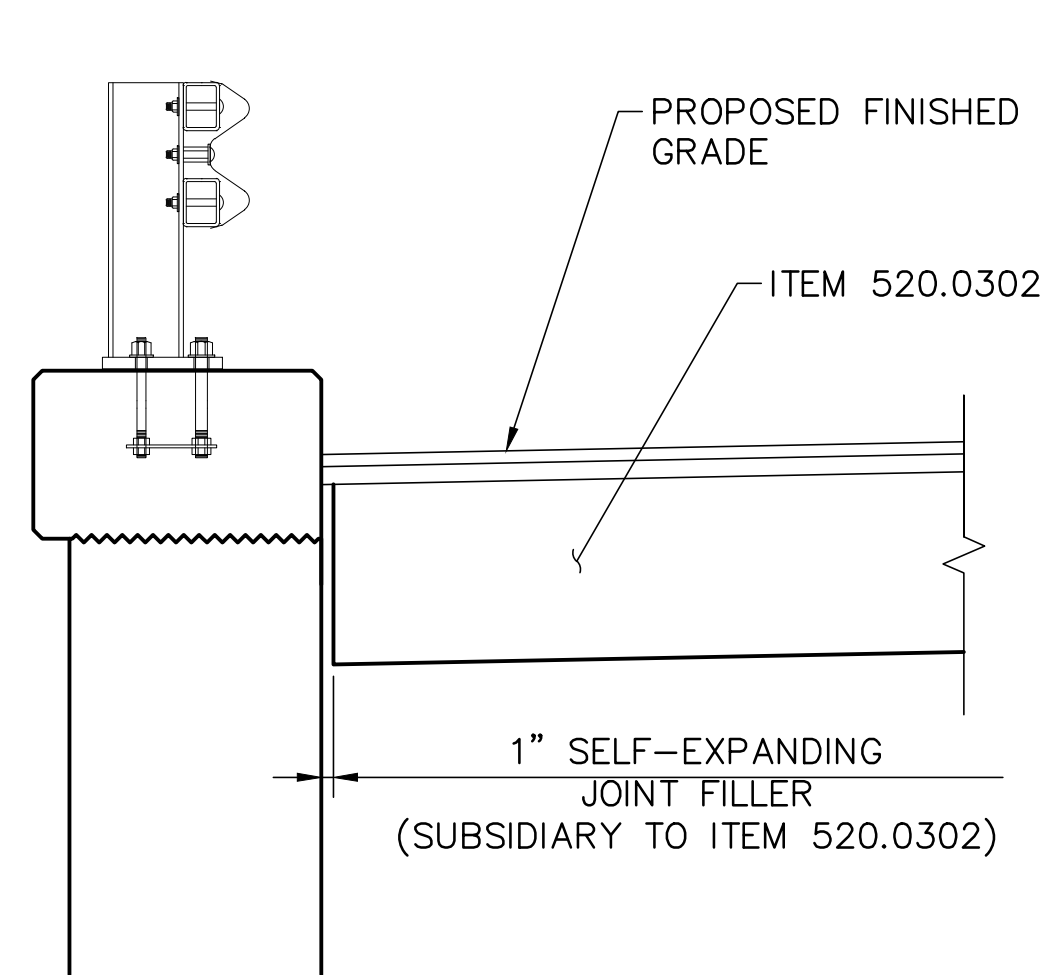


Section B
Scale: 3/4"=1'-0"

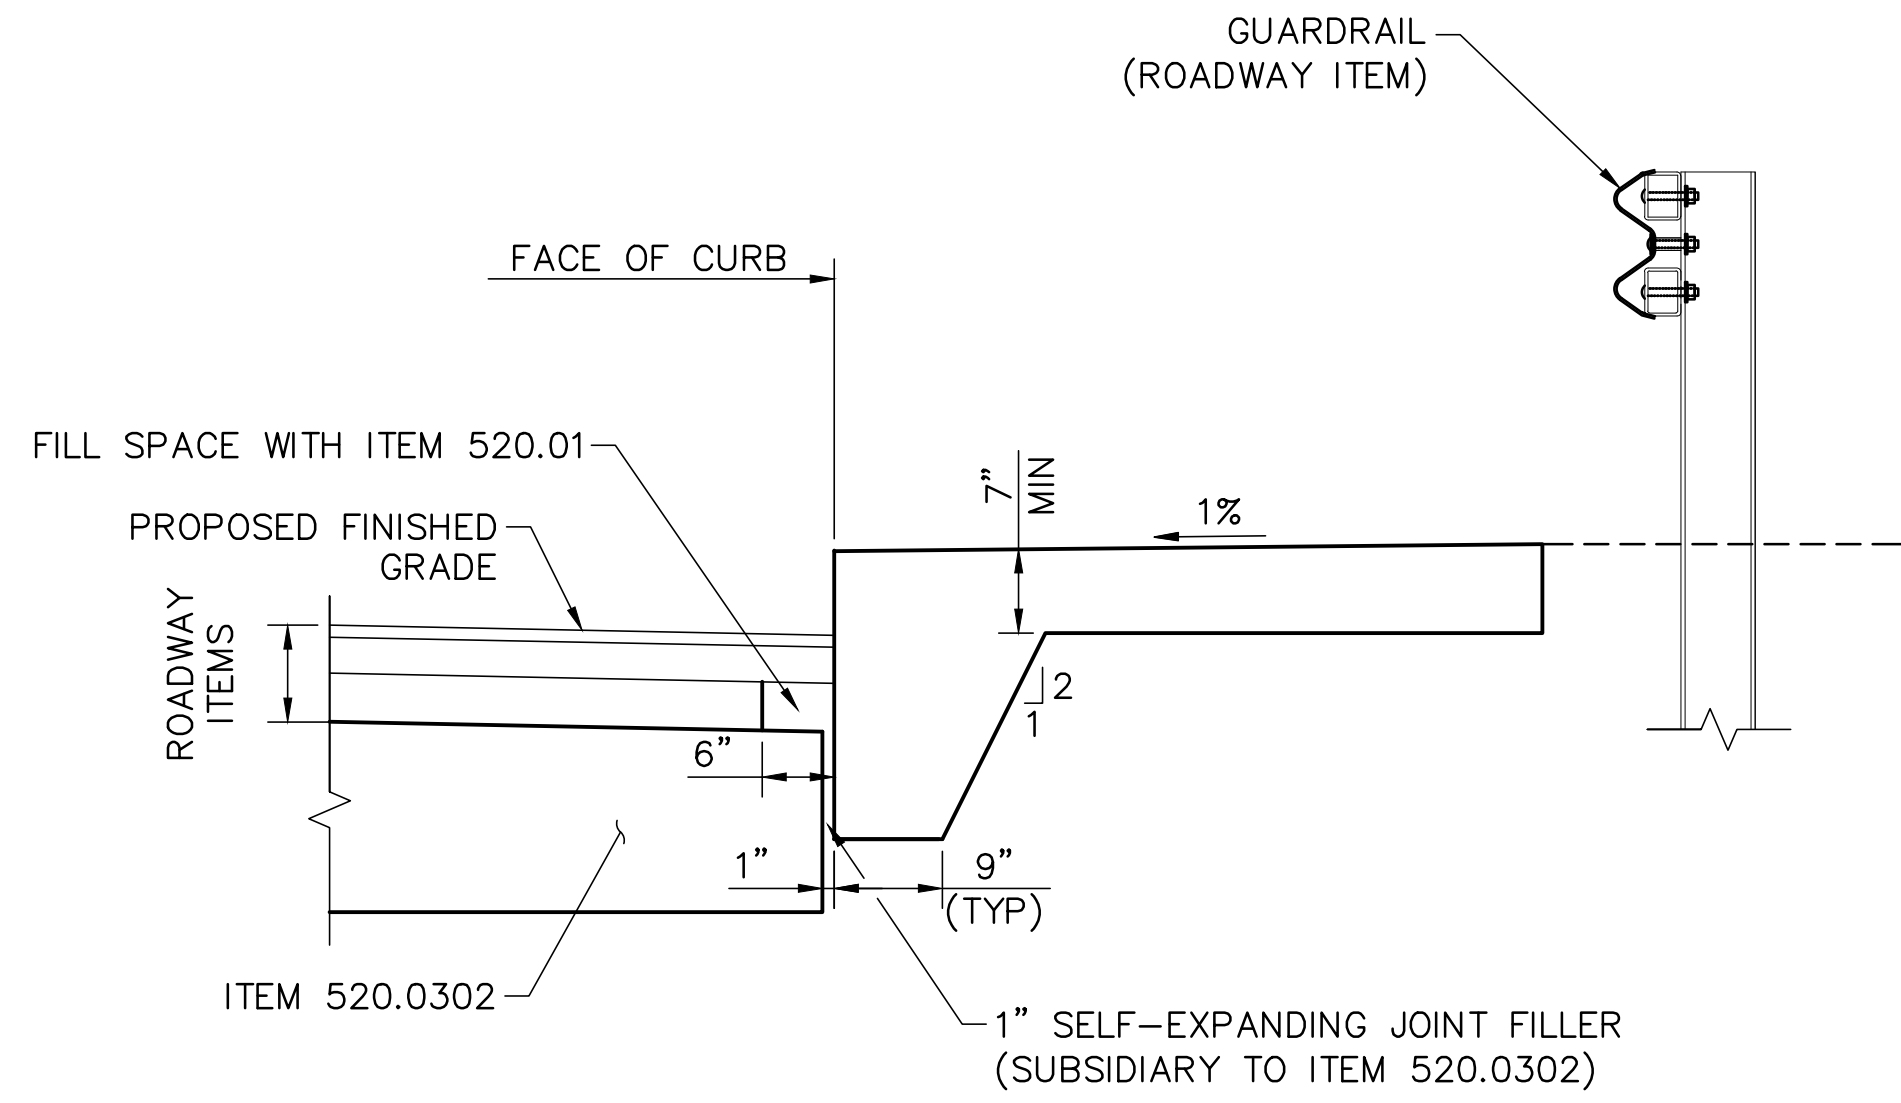


Section C
Scale: 3/4"=1'-0"

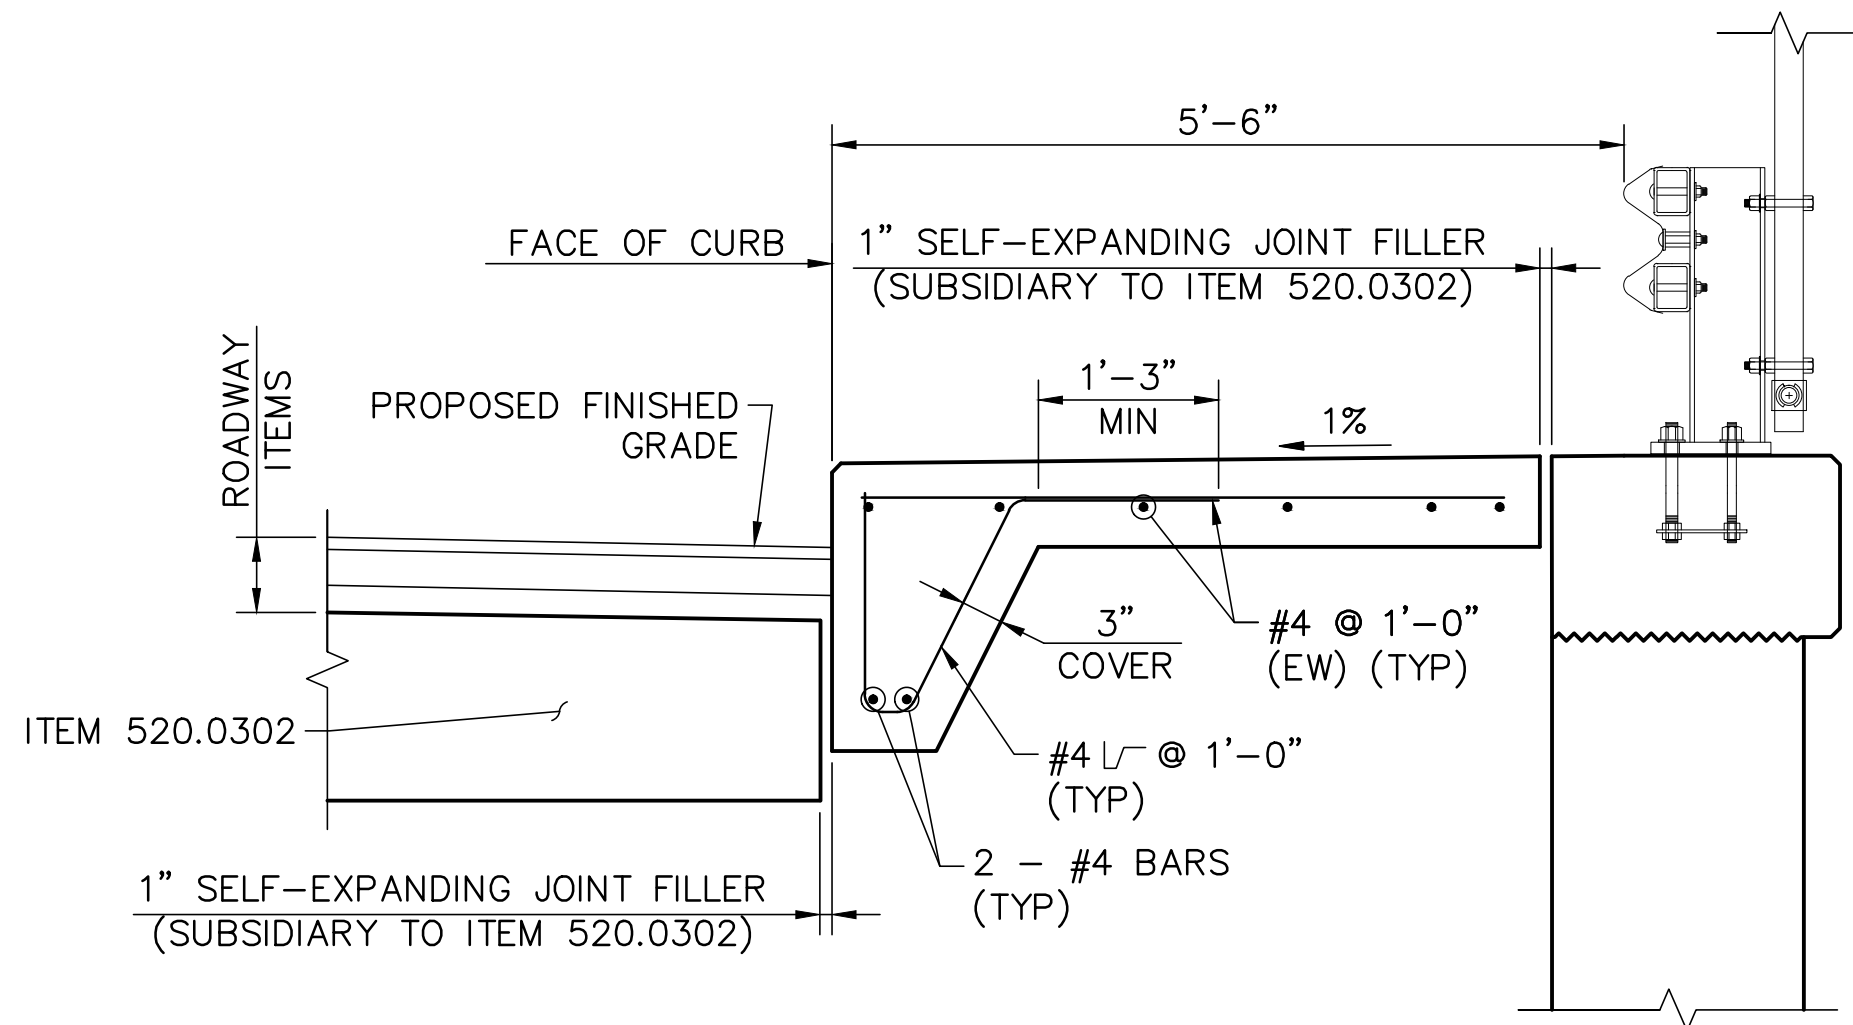


Section D
Scale: 3/4"=1'-0"

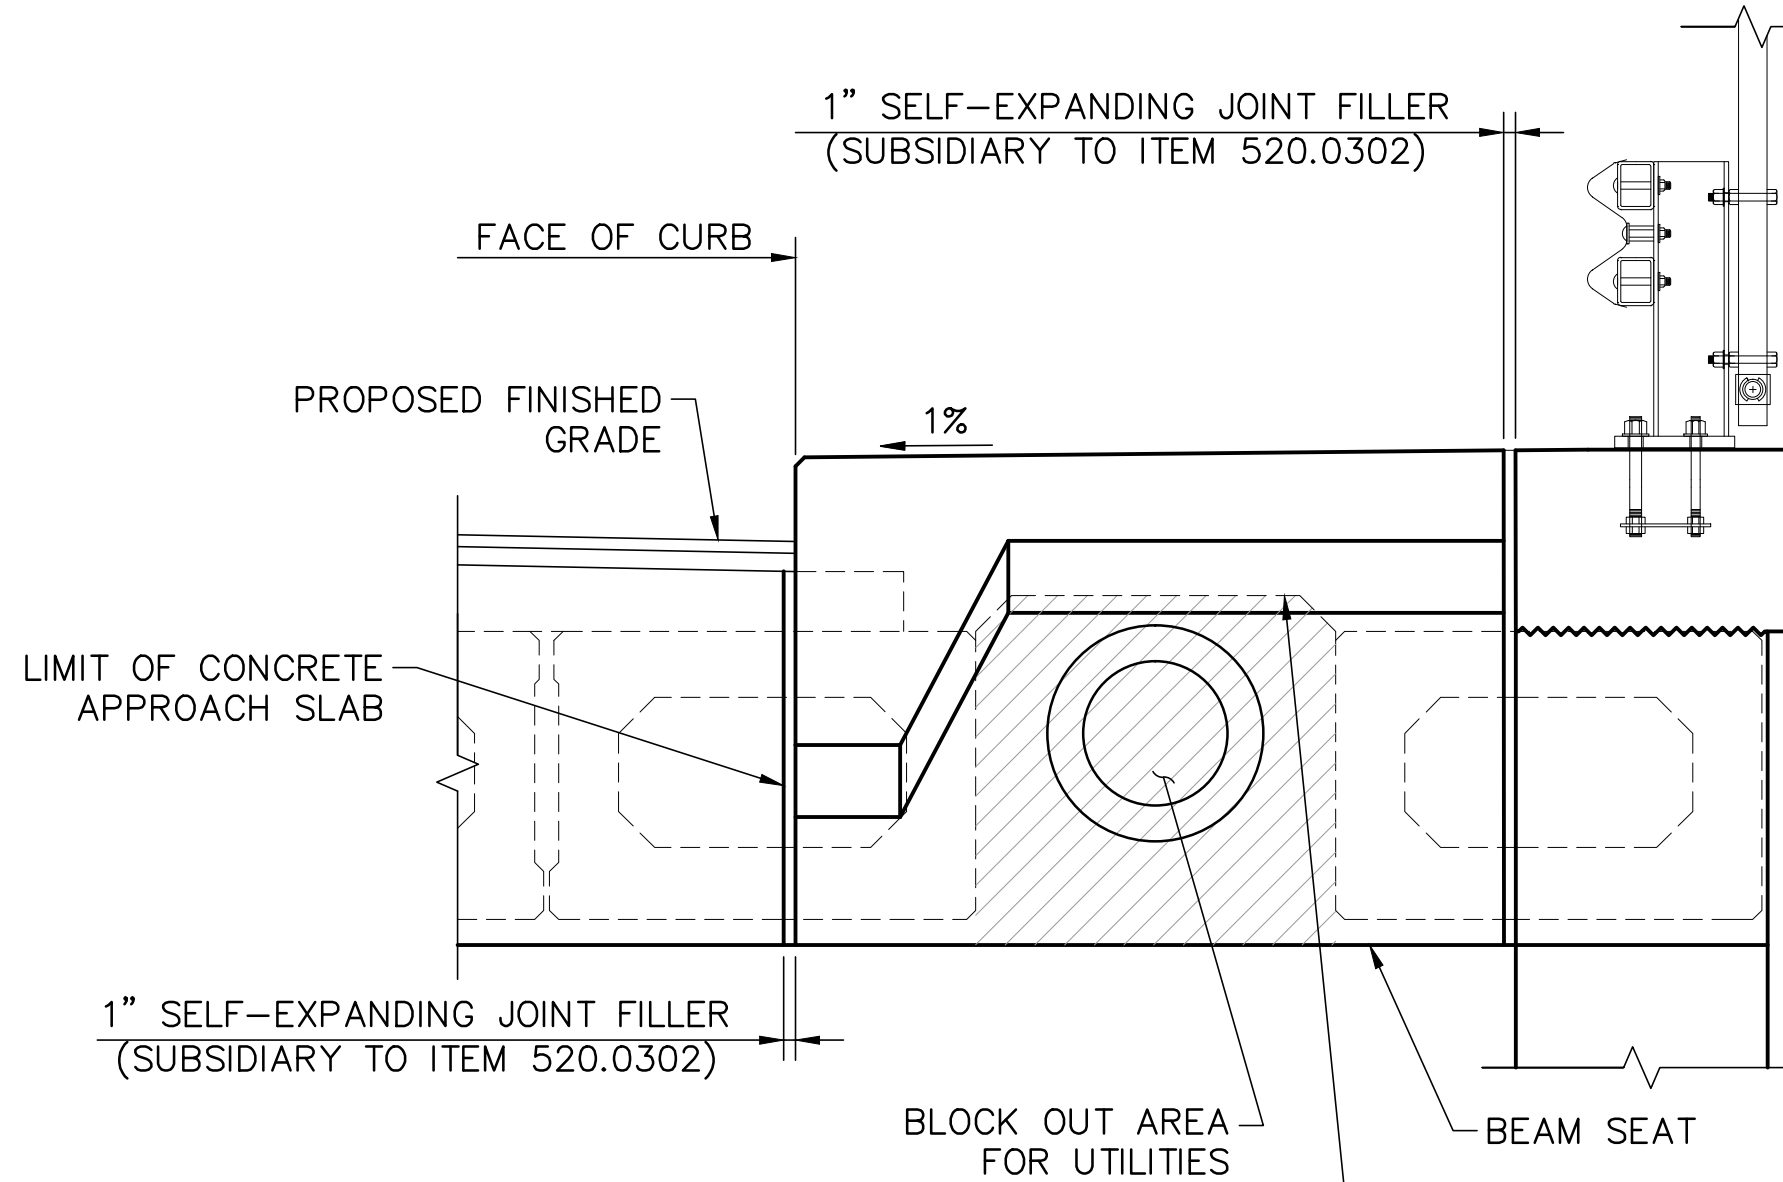


Section E
Scale: 3/4"=1'-0"

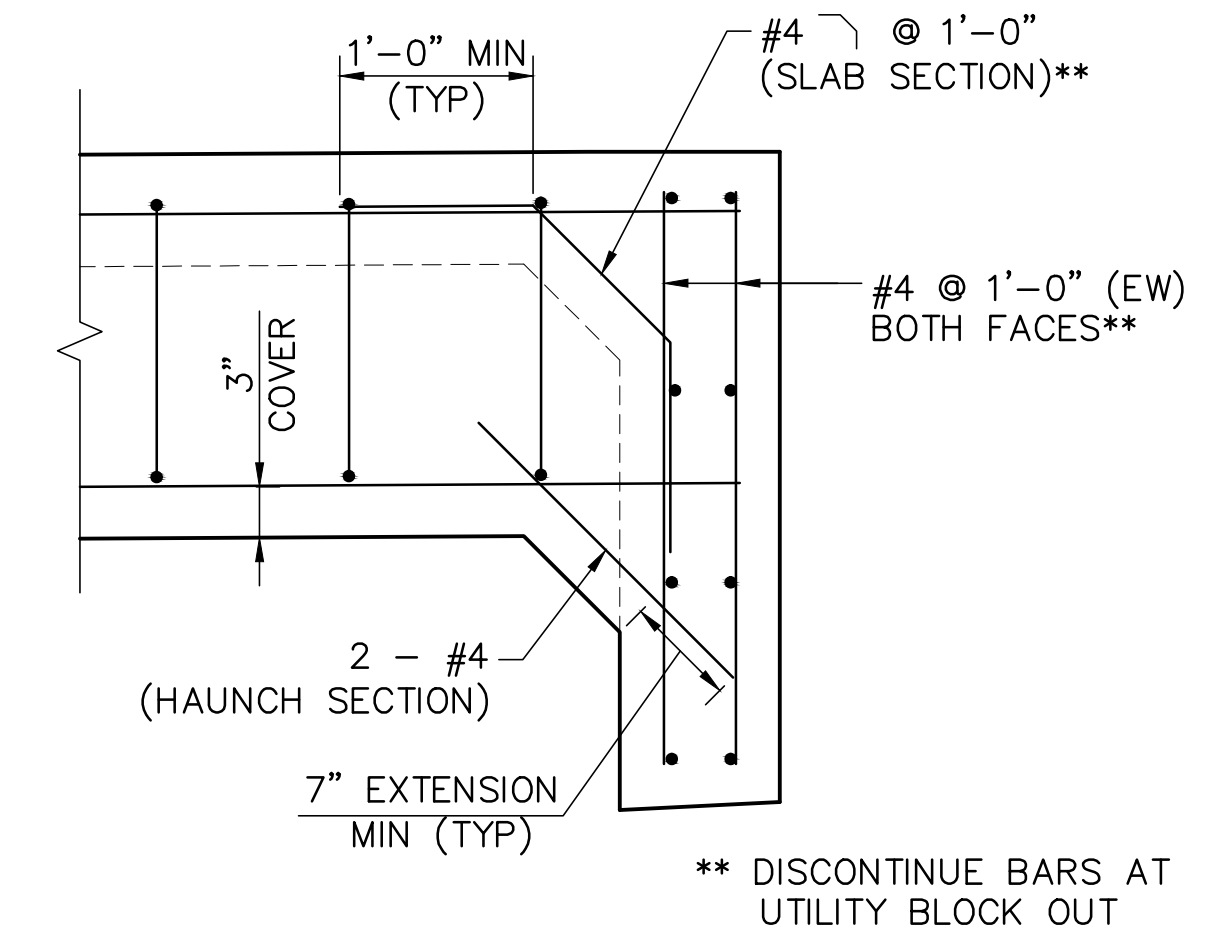

Section H
Scale: 3/4"=1'-0"

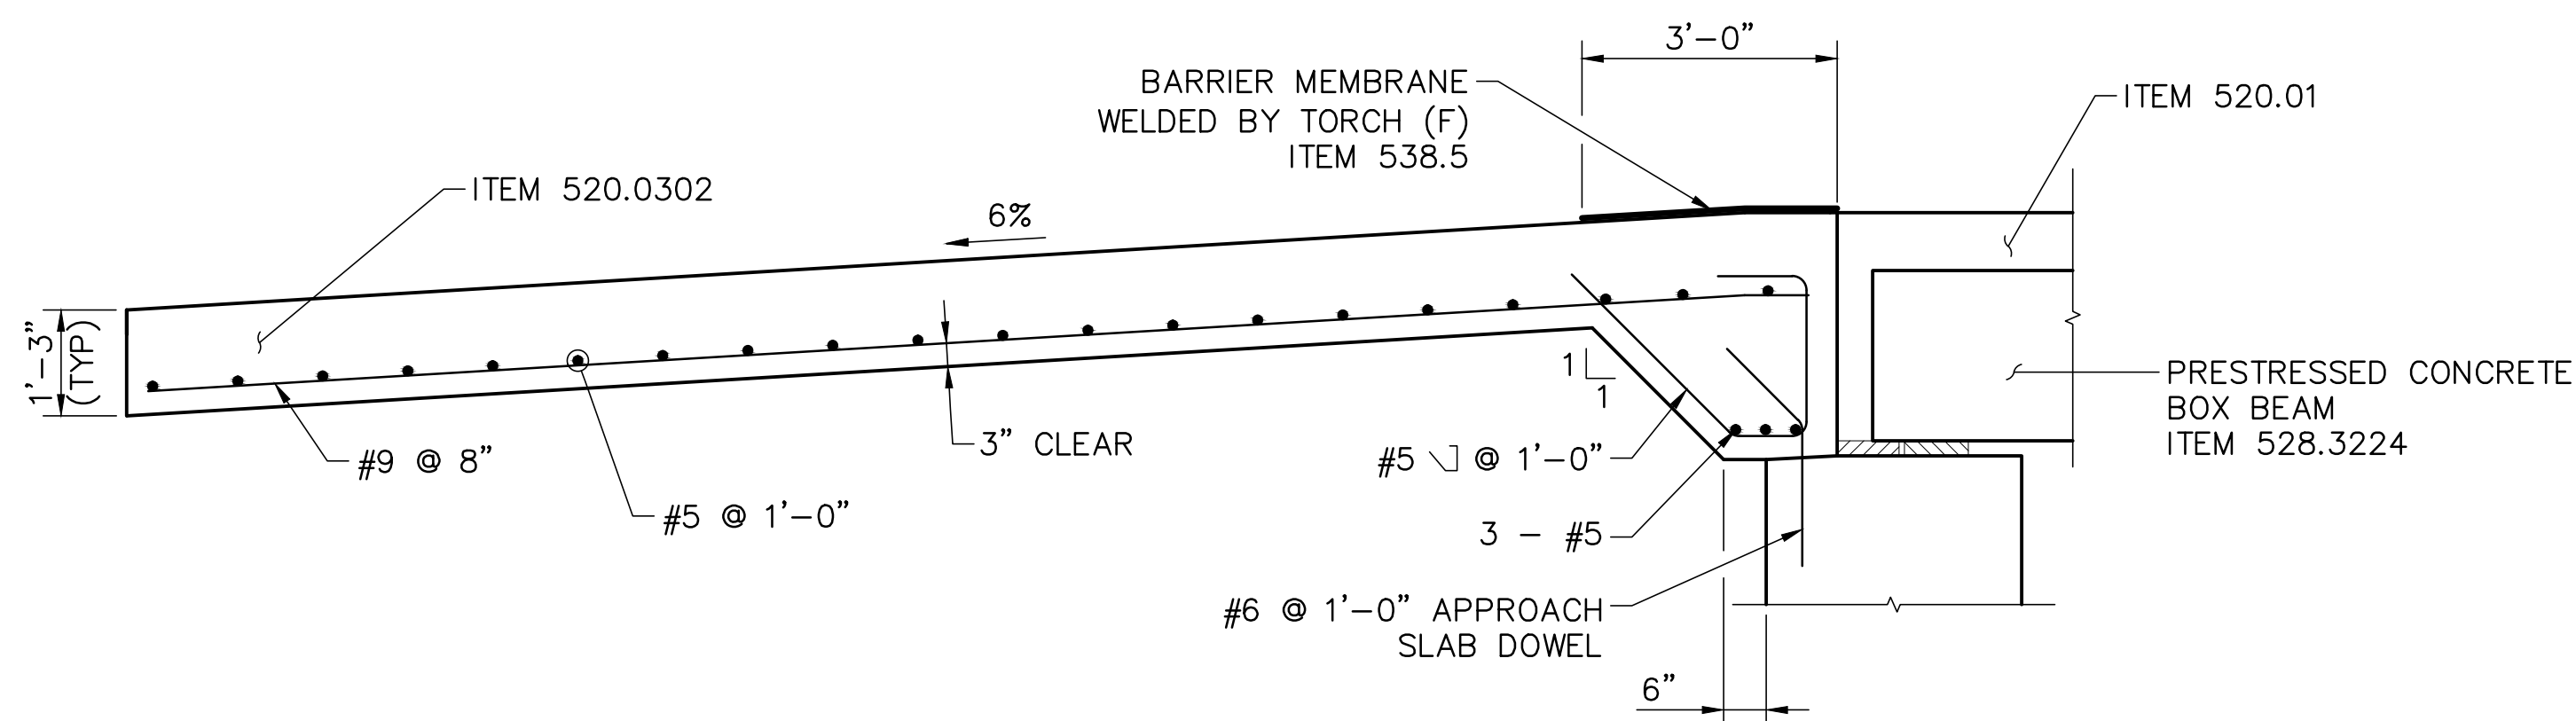

Section F
Scale: 1/2"=1'-0"

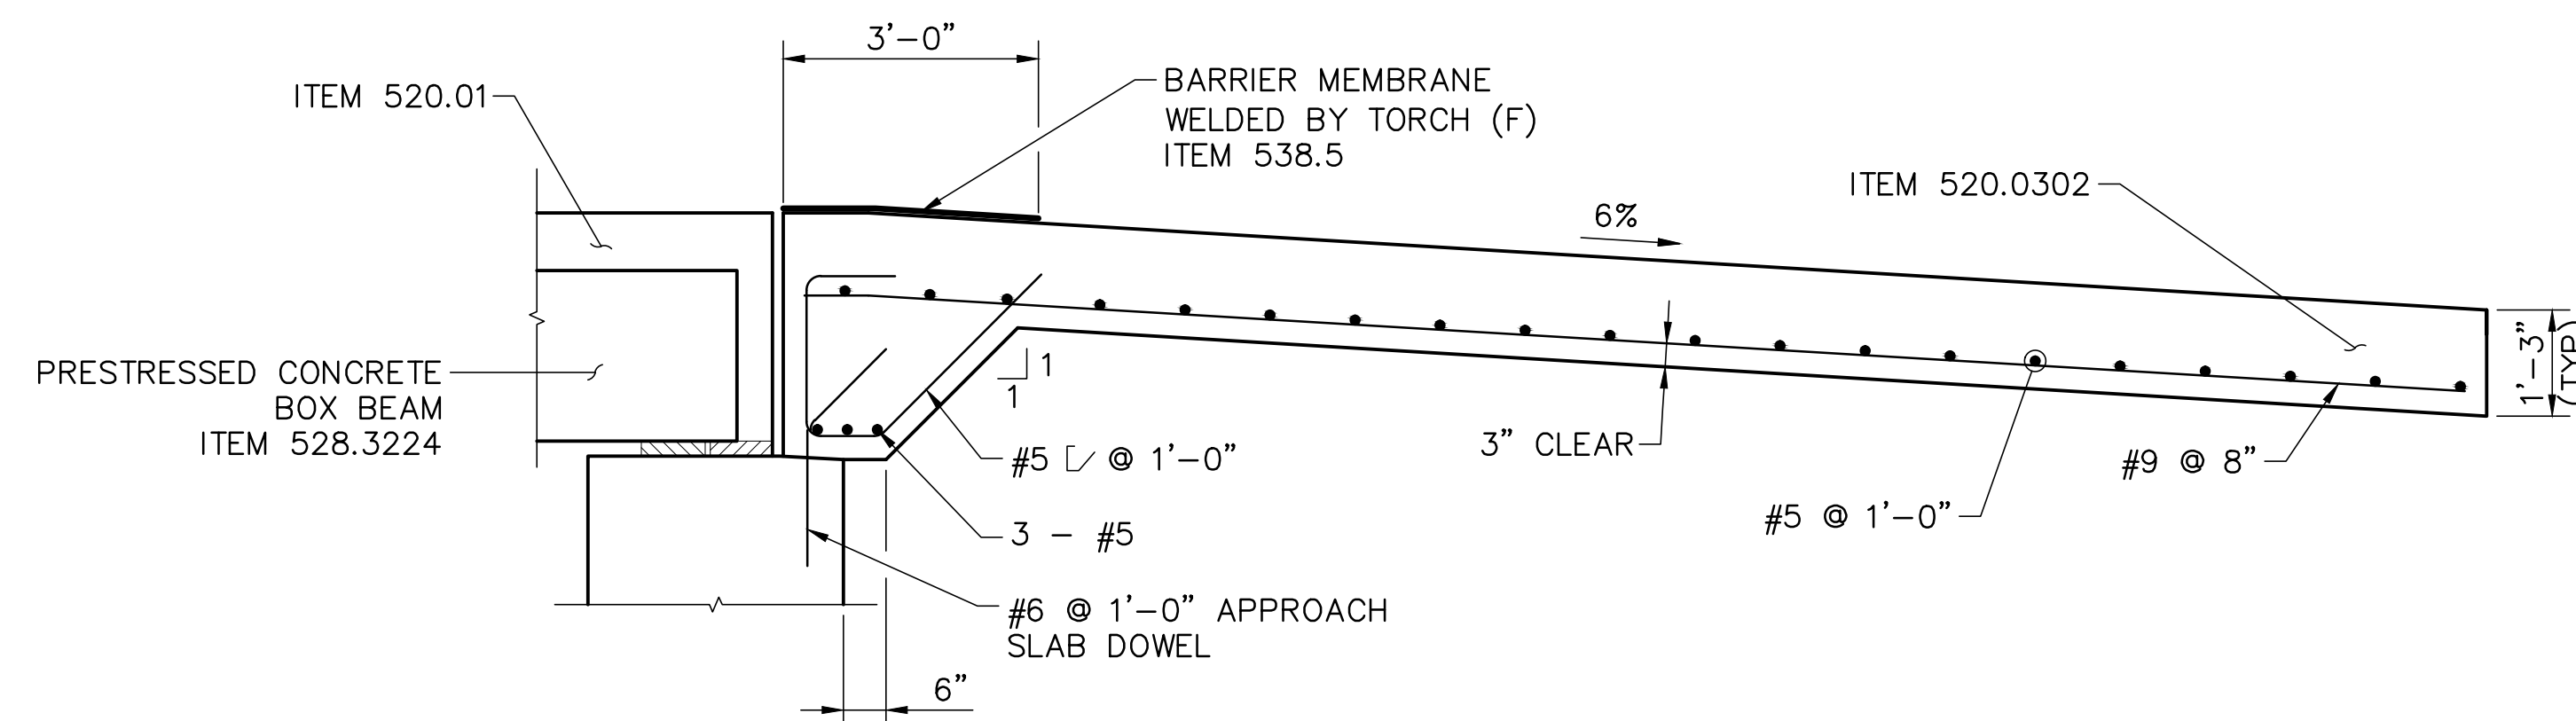


Section G
Scale: 1/2"=1'-0"

no.	0	AS-BUILT	1/6/16	JLG	by
revision					date


CMA ENGINEERS
CIVIL/ENVIRONMENTAL ENGINEERS
10 Free Street
Portland, Maine 04101
207.574.4225
www.cmaengineers.com

35 Bow Street
Portsmouth, NH 03801
603.931.6196
603.627.0708
info@cmaengineers.com

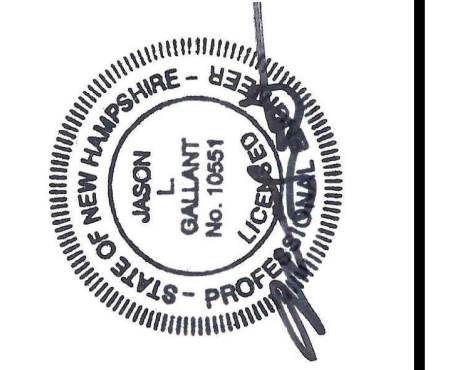


designed by:	LBK/OGK	approved by:	JLG
drawn by:	LBK/OGK	scale:	AS SHOWN
date:	July 2015		
project no:	923		
file name:	923 - Structural Plans.dwg		


Town of Exeter
Department of Public Works
Linden Street
Little River Bridge Replacement
Approach Slab Details
(Sheet 2 of 2)

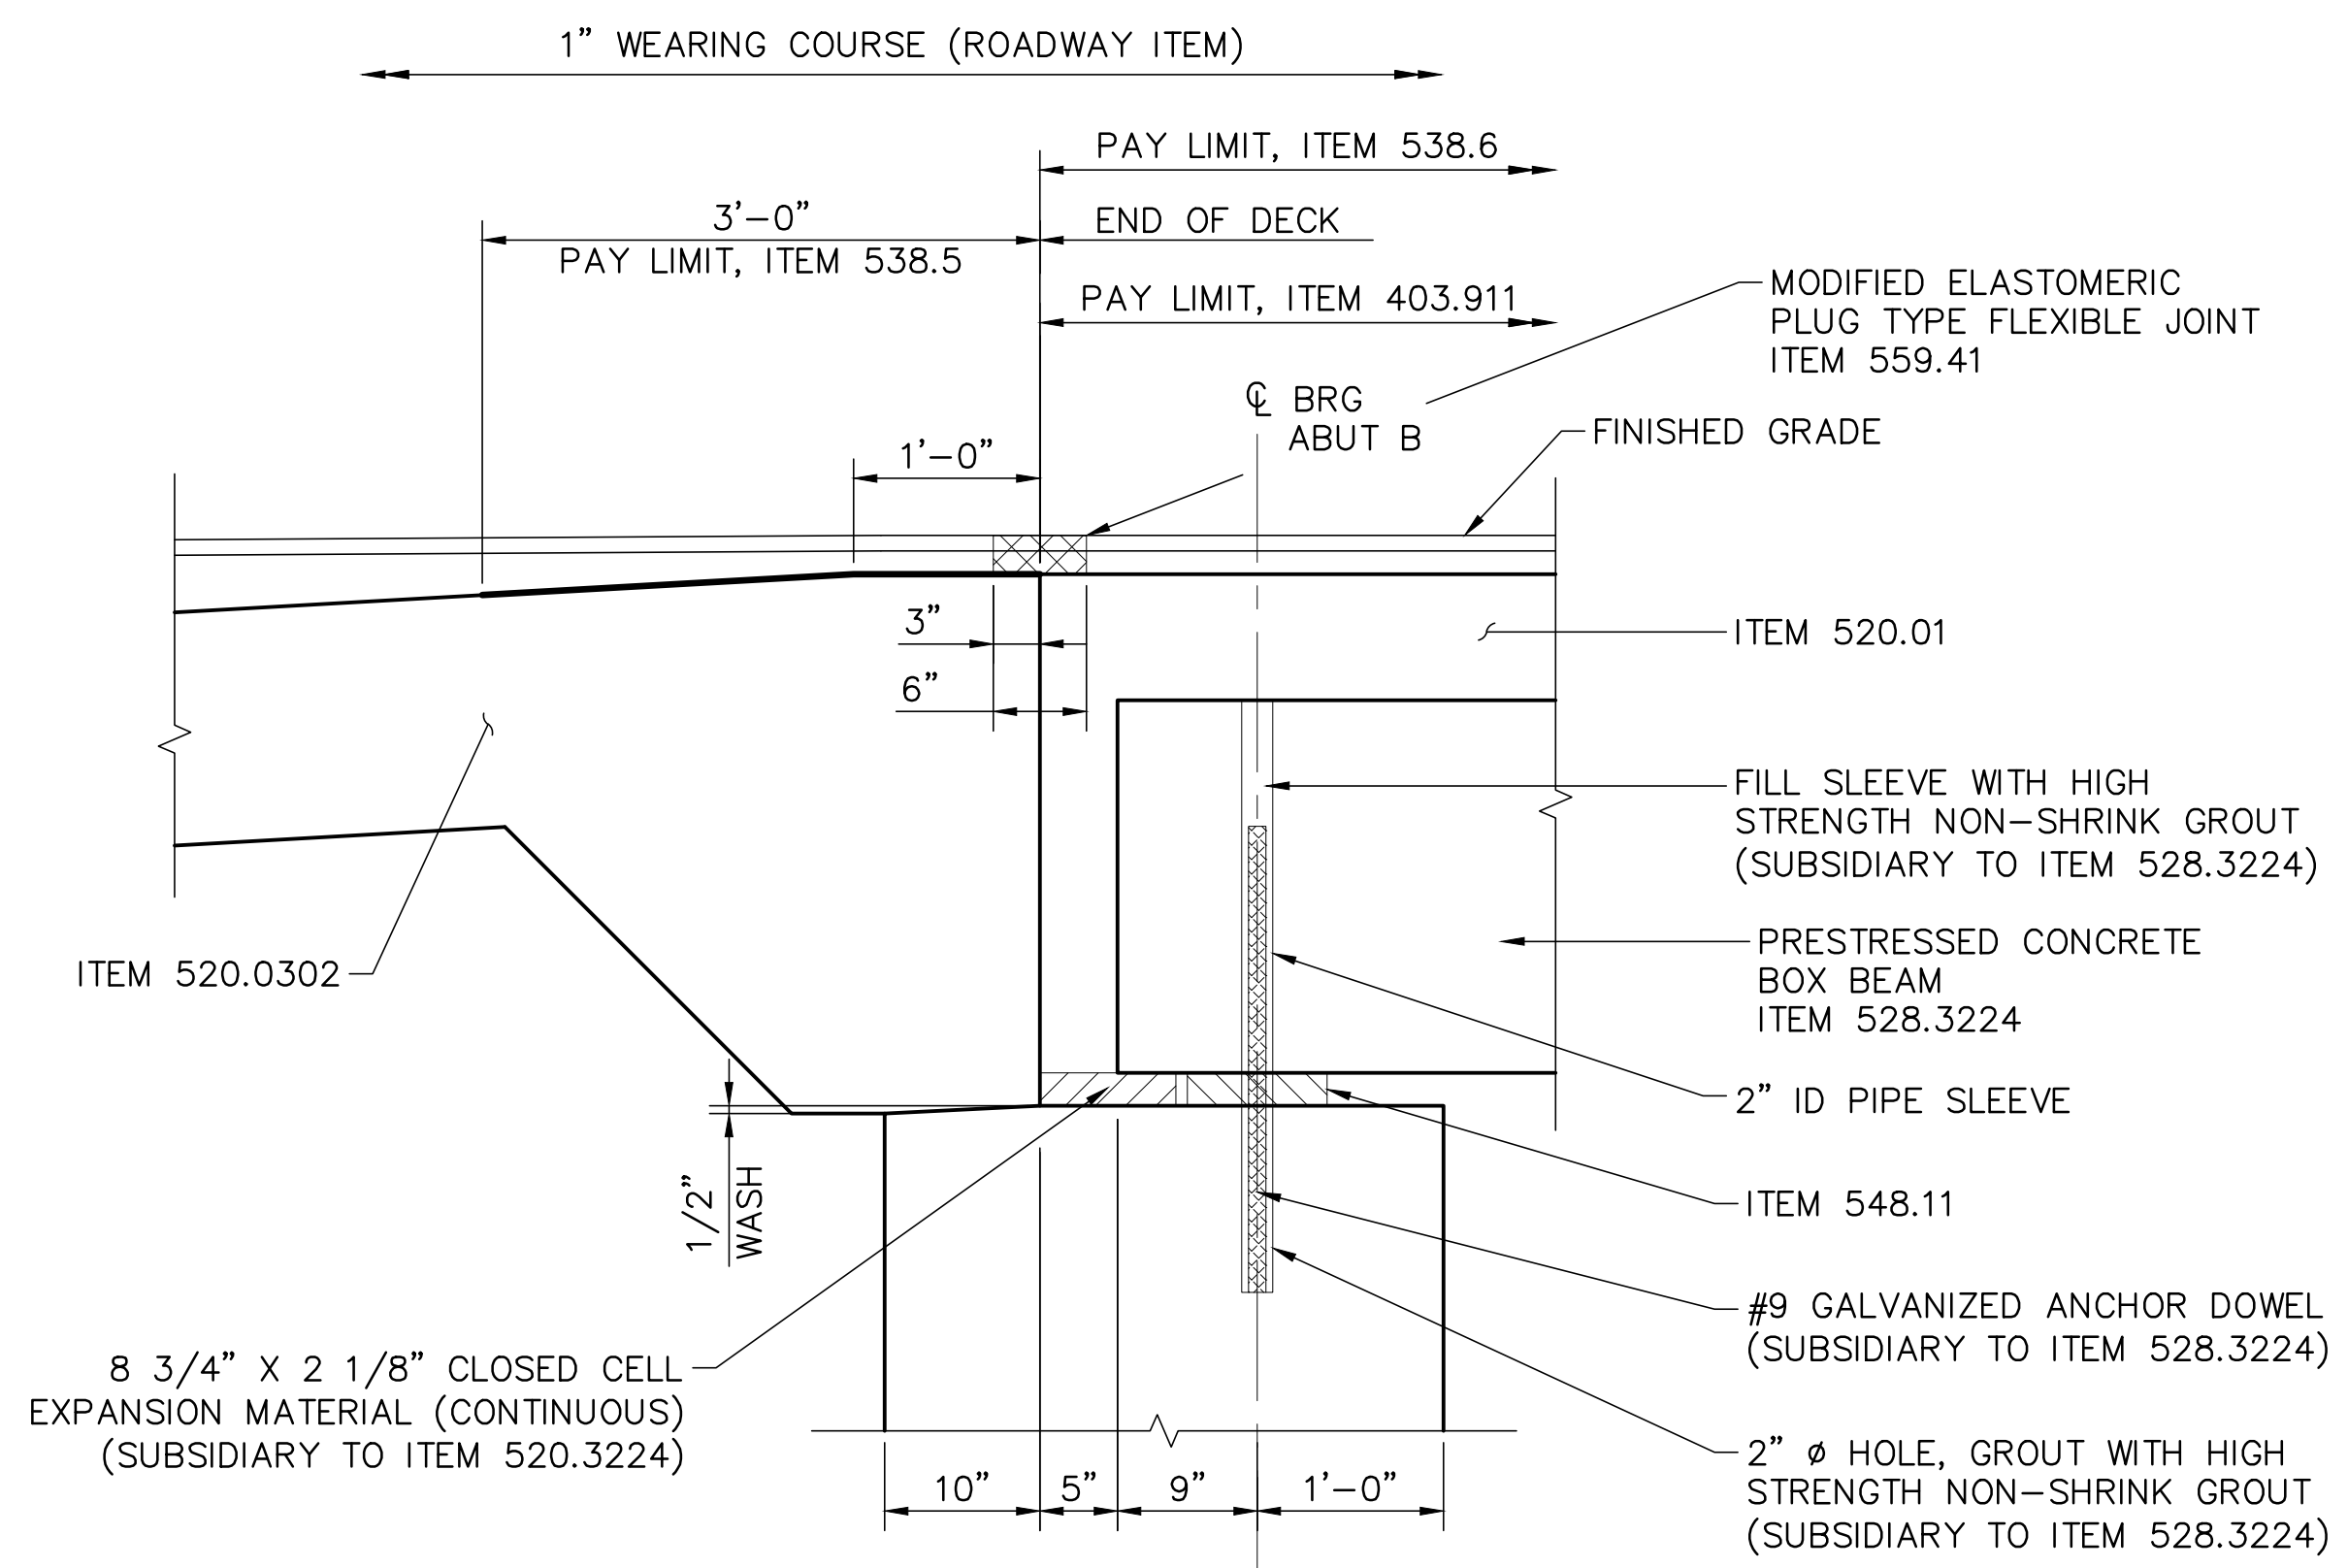


Abutment A
Scale: 1"=1'-0"

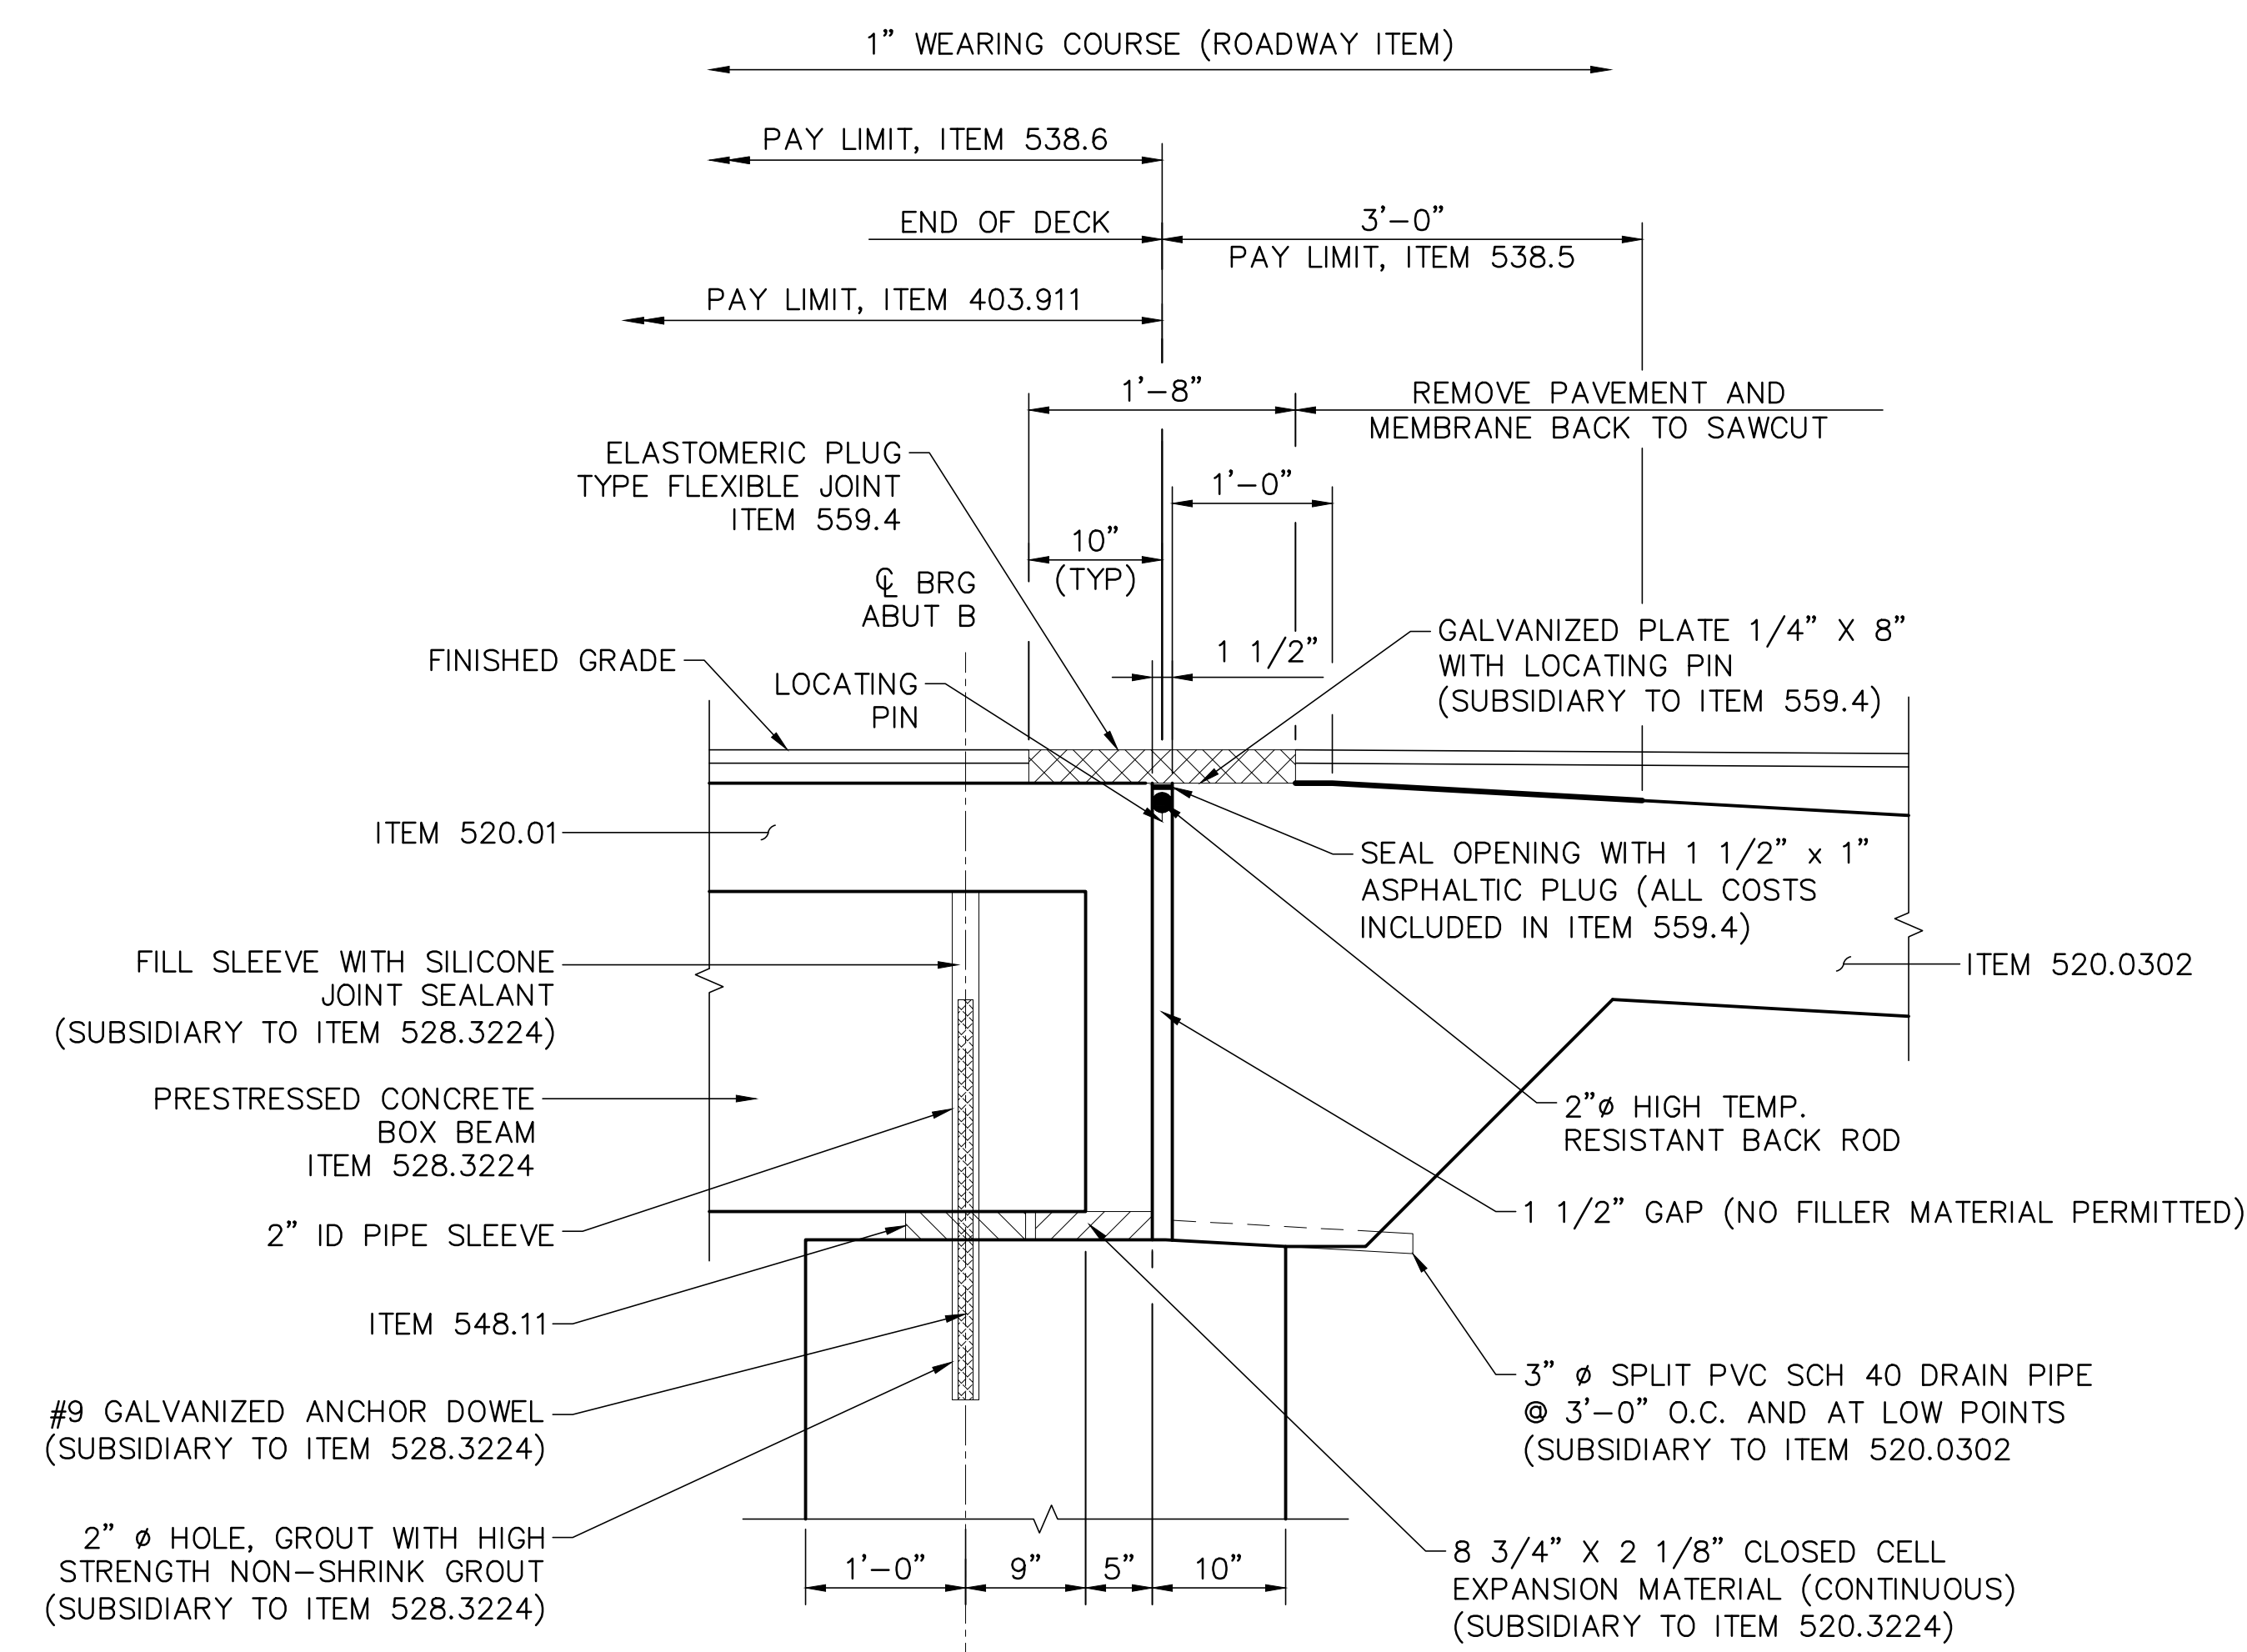


Abutment B
Scale: 1"=1'-0"

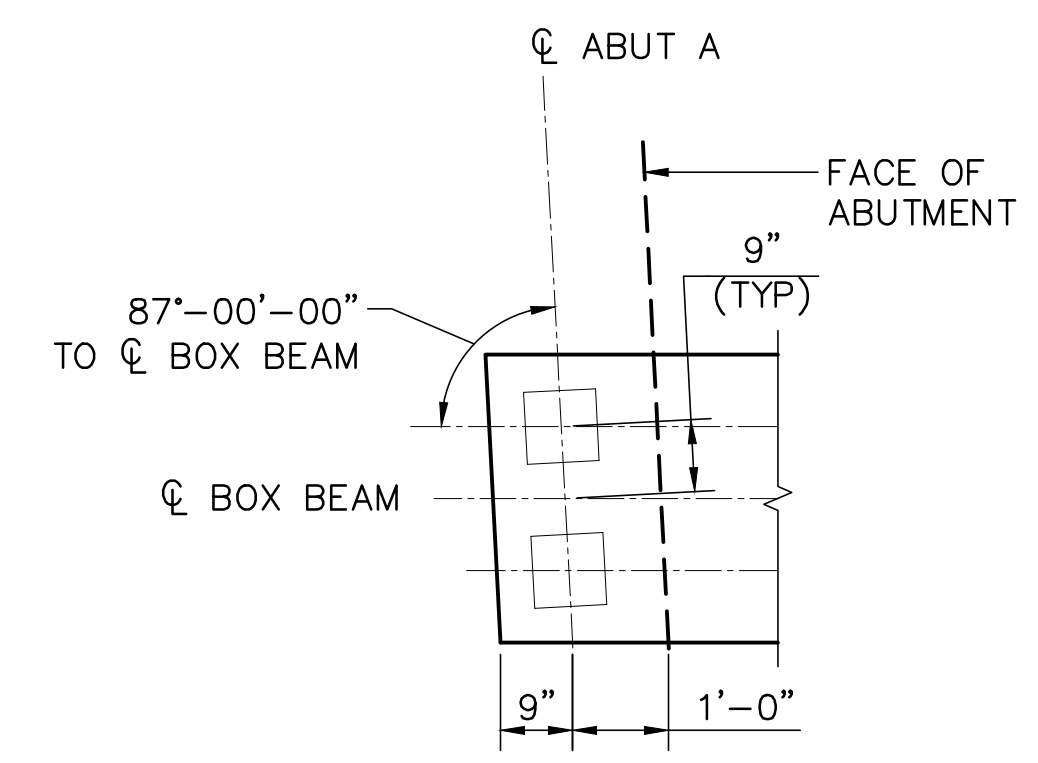


Bearing Layout (Abut A) (3 Ft Beam)
Scale: 1/2"=1'-0"

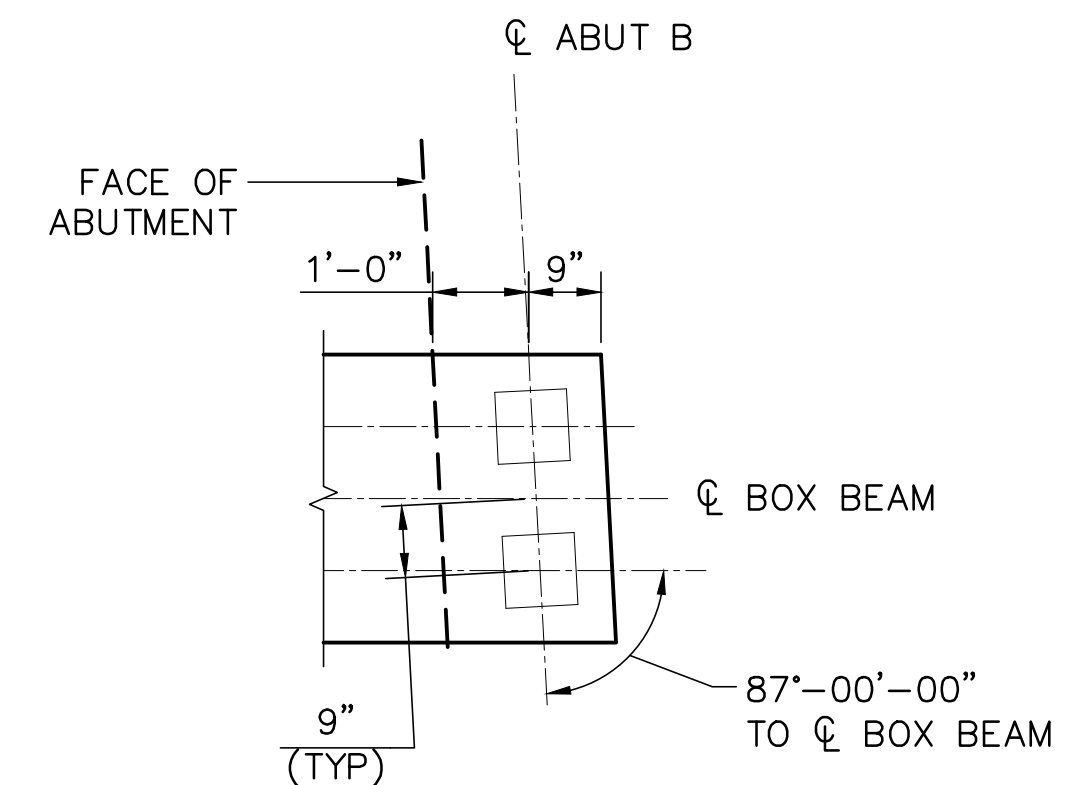


Bearing Layout (Abut B) (3 Ft Beam)
Scale: 1/2"=1'-0"

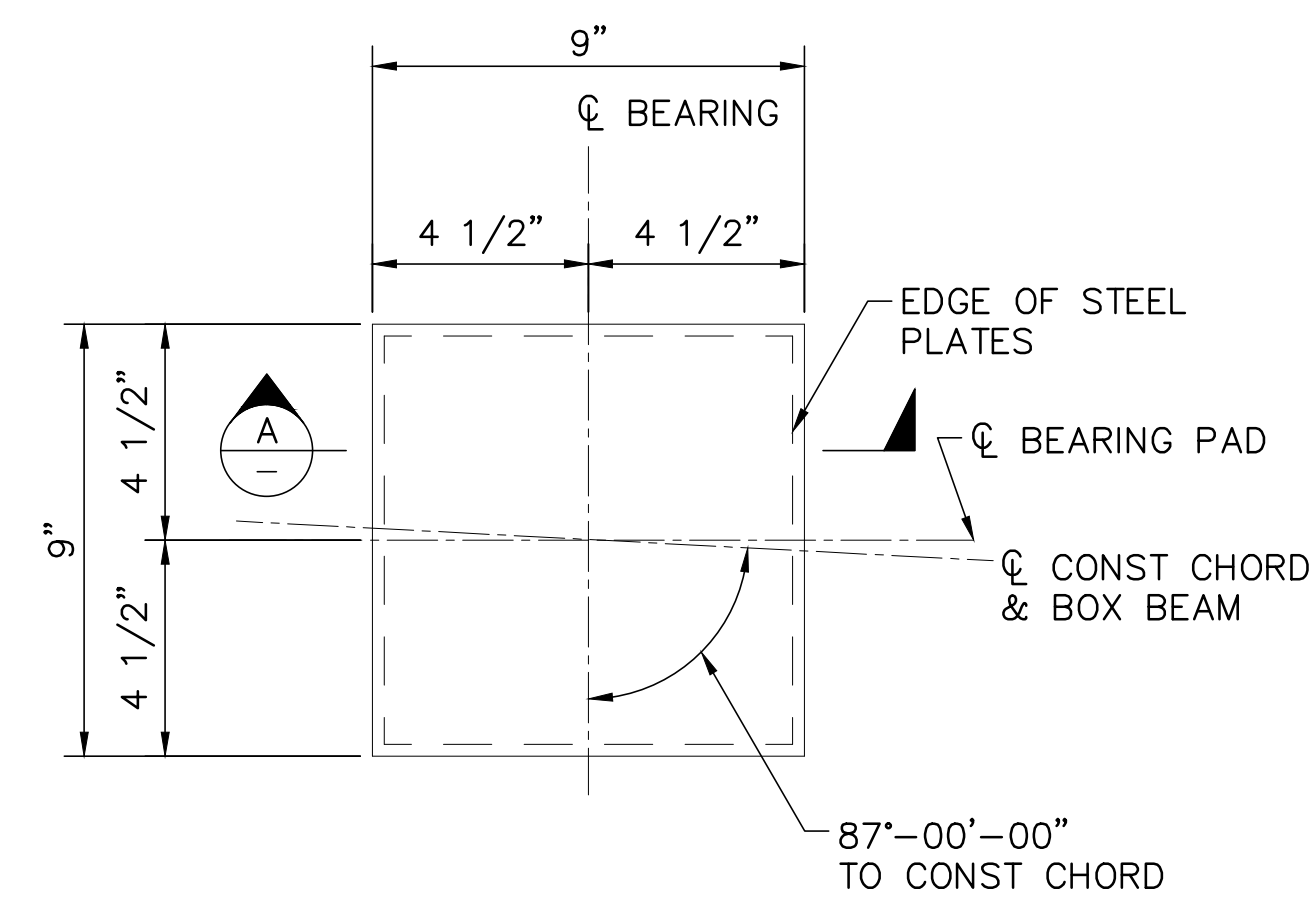


Bearing Plan
Scale: 3"=1'-0"

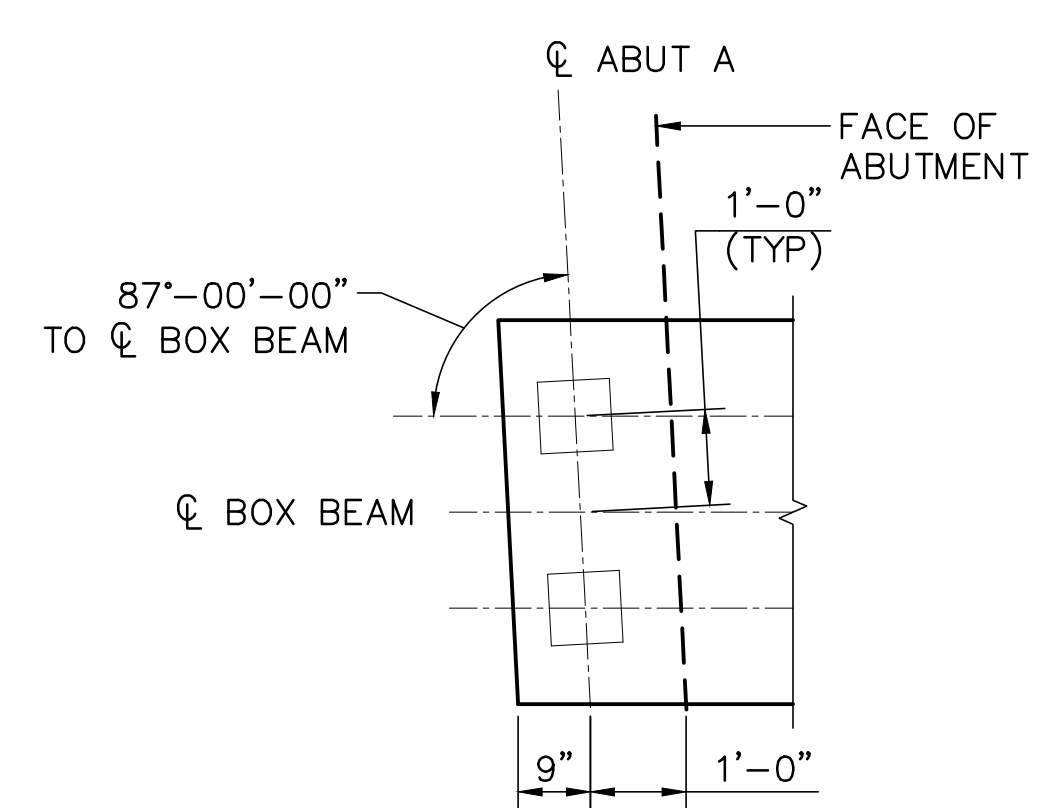

Bearing Layout (Abut A) (4 Ft Beam)
Scale: 1/2"=1'-0"

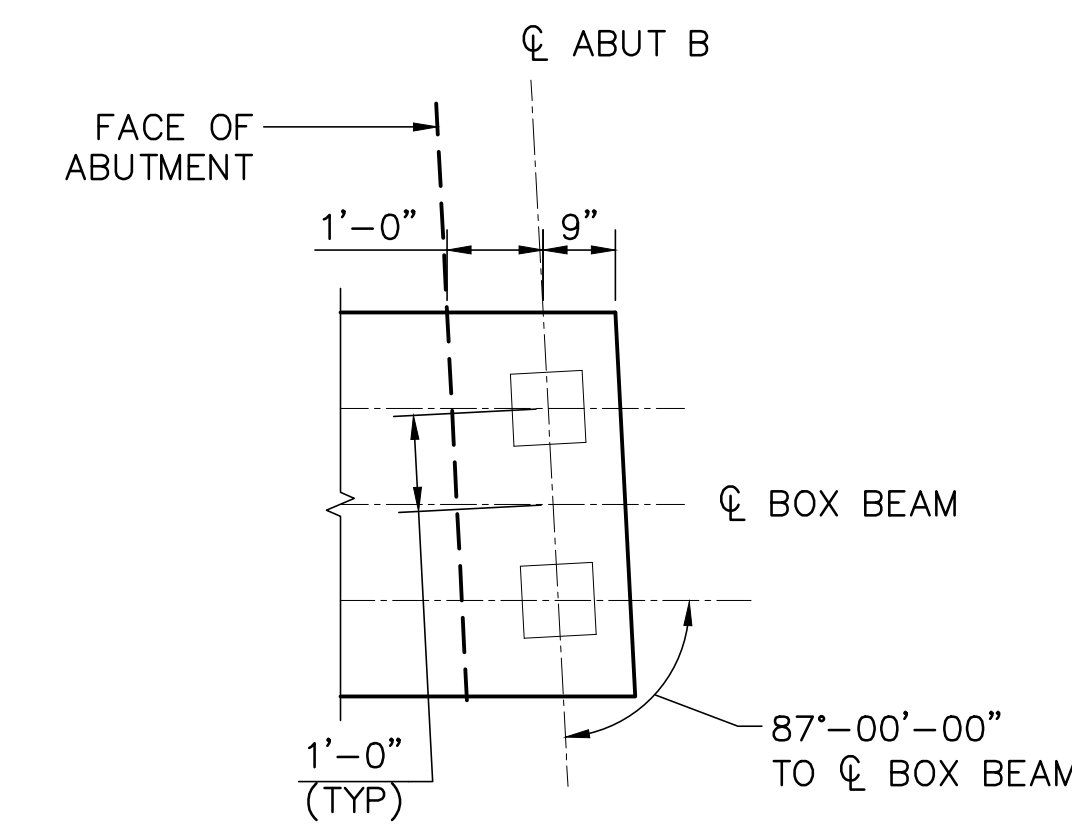


Bearing Layout (Abut B) (4 Ft Beam)
Scale: 1/2"=1'-0"

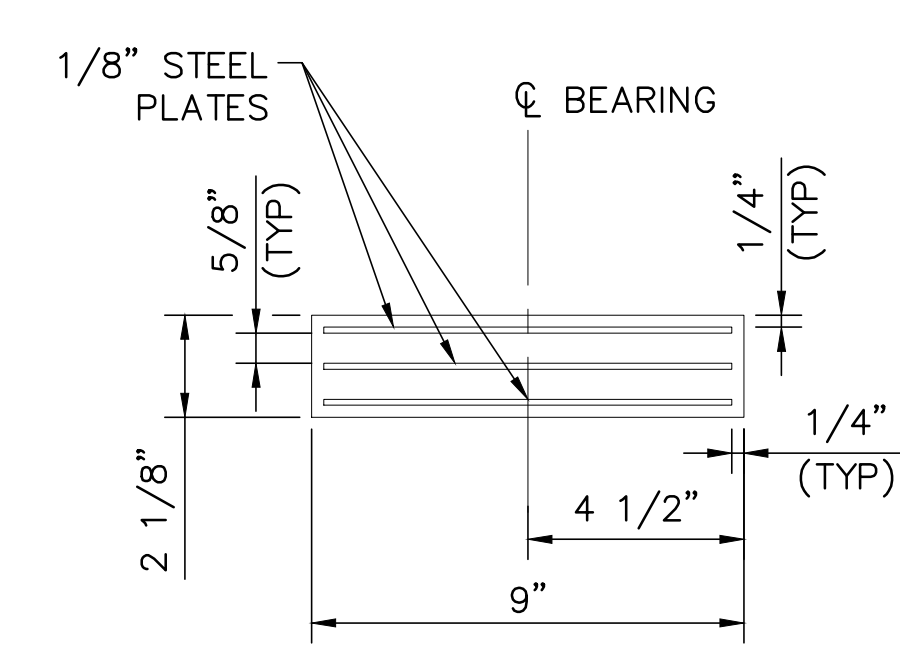


Section
Scale: 3"=1'-0"


		designed by: LBK/OGK drawn by: LBK/OGK approved by: JLG date: July 2015 project no: 923 file name: 923 - Structural Plans.dwg	no. 0 AS-BUILT 1/6/16 JLG by
CMA ENGINEERS CIVIL/ENVIRONMENTAL ENGINEERS 35 Bow Street Portsmouth, NH 03801 603-431-6196 info@cmaengineers.com 10 Free Street Portland, Maine 04101 207-561-4225 www.cmaengineers.com		Town of Exeter Department of Public Works Linden Street Little River Bridge Replacement Bearing and Joint Details drawing no. B-18 sheet: 19 of 29	

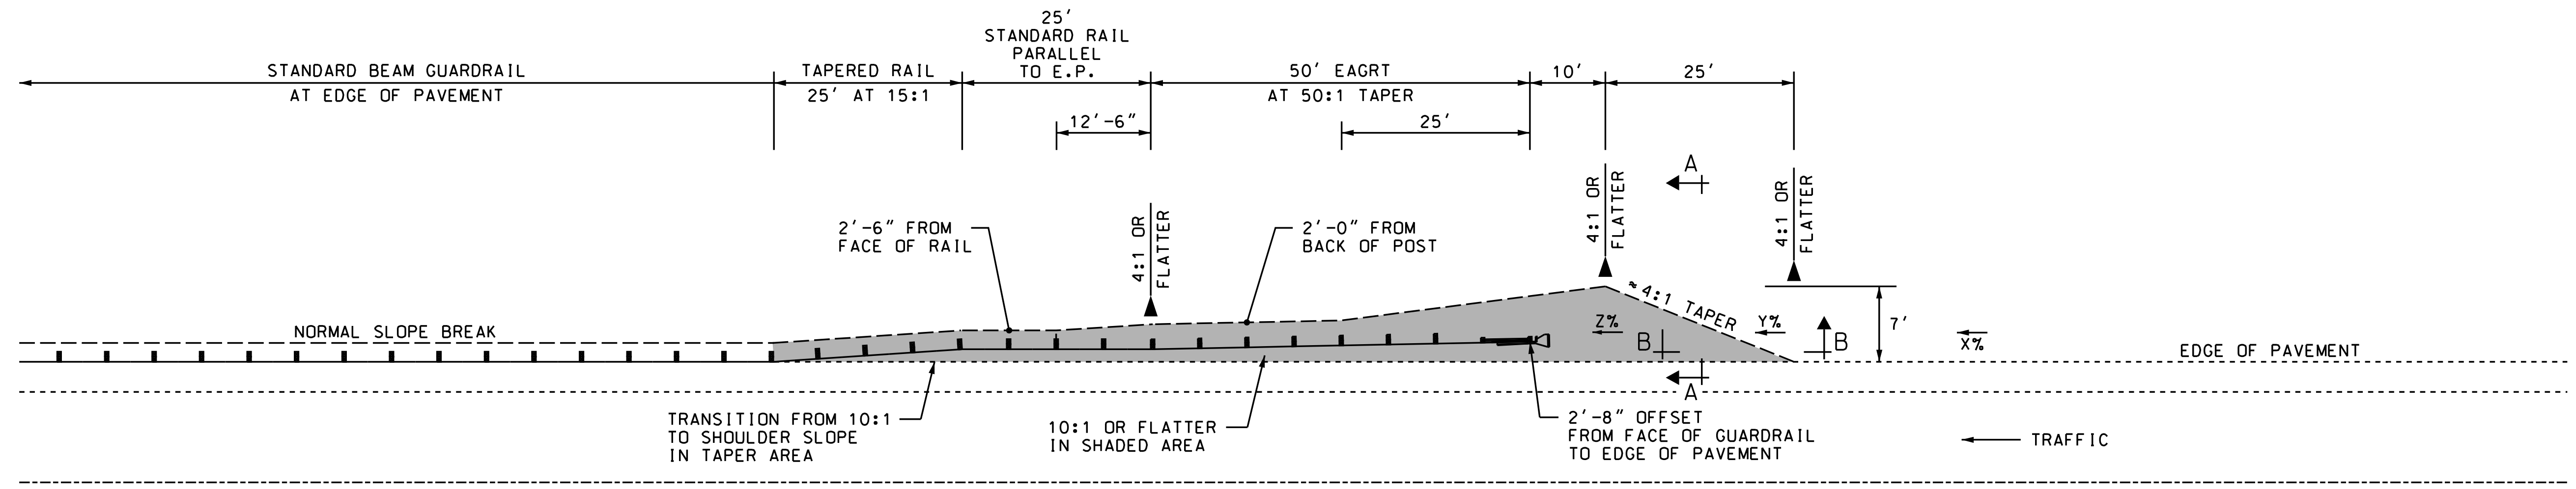

50' EAGRT UNIT

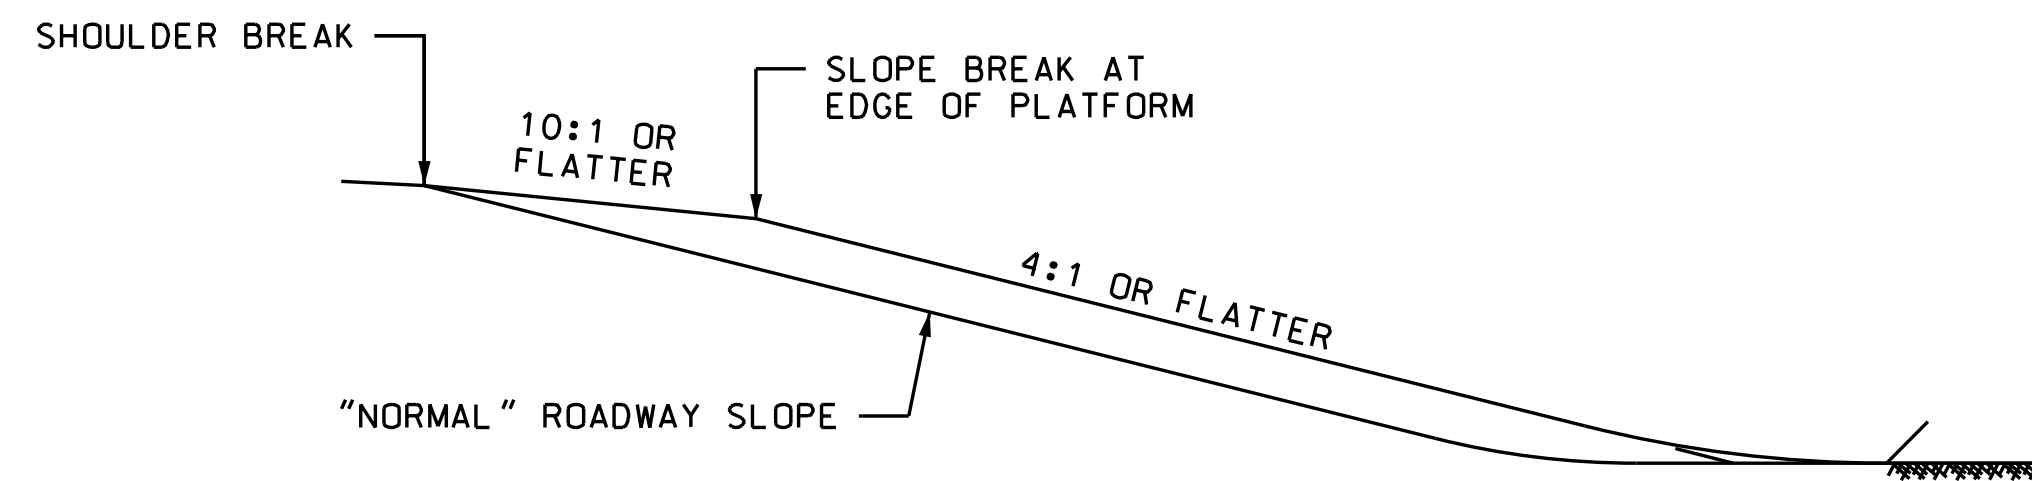


SECTION A-A
PLATFORM SLOPE GRADING

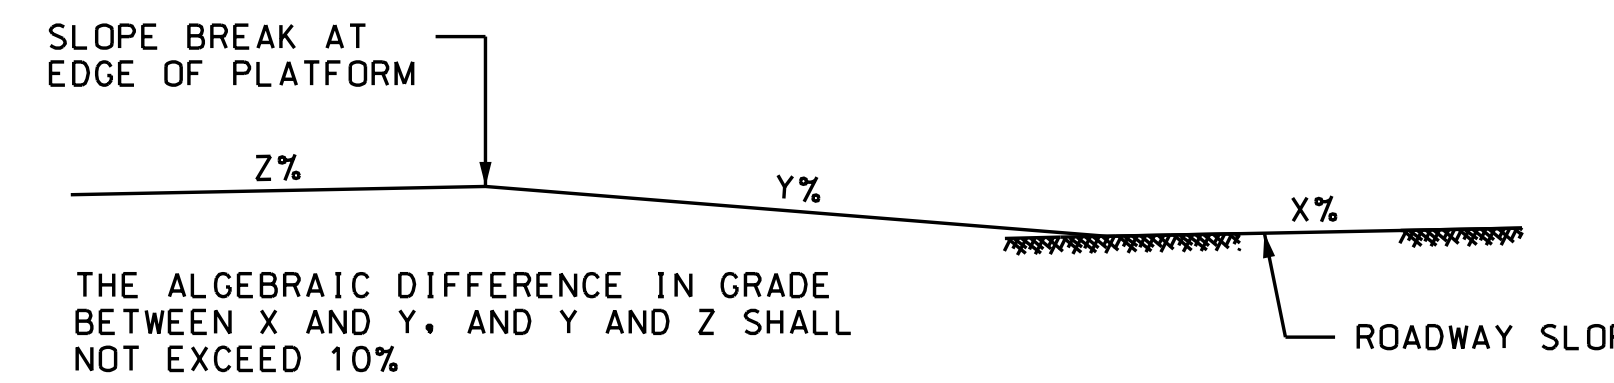

SECTION B-B
PLATFORM APPROACH GRADING

X: LONGITUDINAL GRADE OF ROADWAY SLOPE IN ADVANCE OF PLATFORM
Y: LONGITUDINAL GRADE OF PLATFORM APPROACH
Z: LONGITUDINAL GRADE OF PLATFORM

THE ALGEBRAIC DIFFERENCE IN GRADE BETWEEN X AND Y, AND Y AND Z SHALL NOT EXCEED 10%.

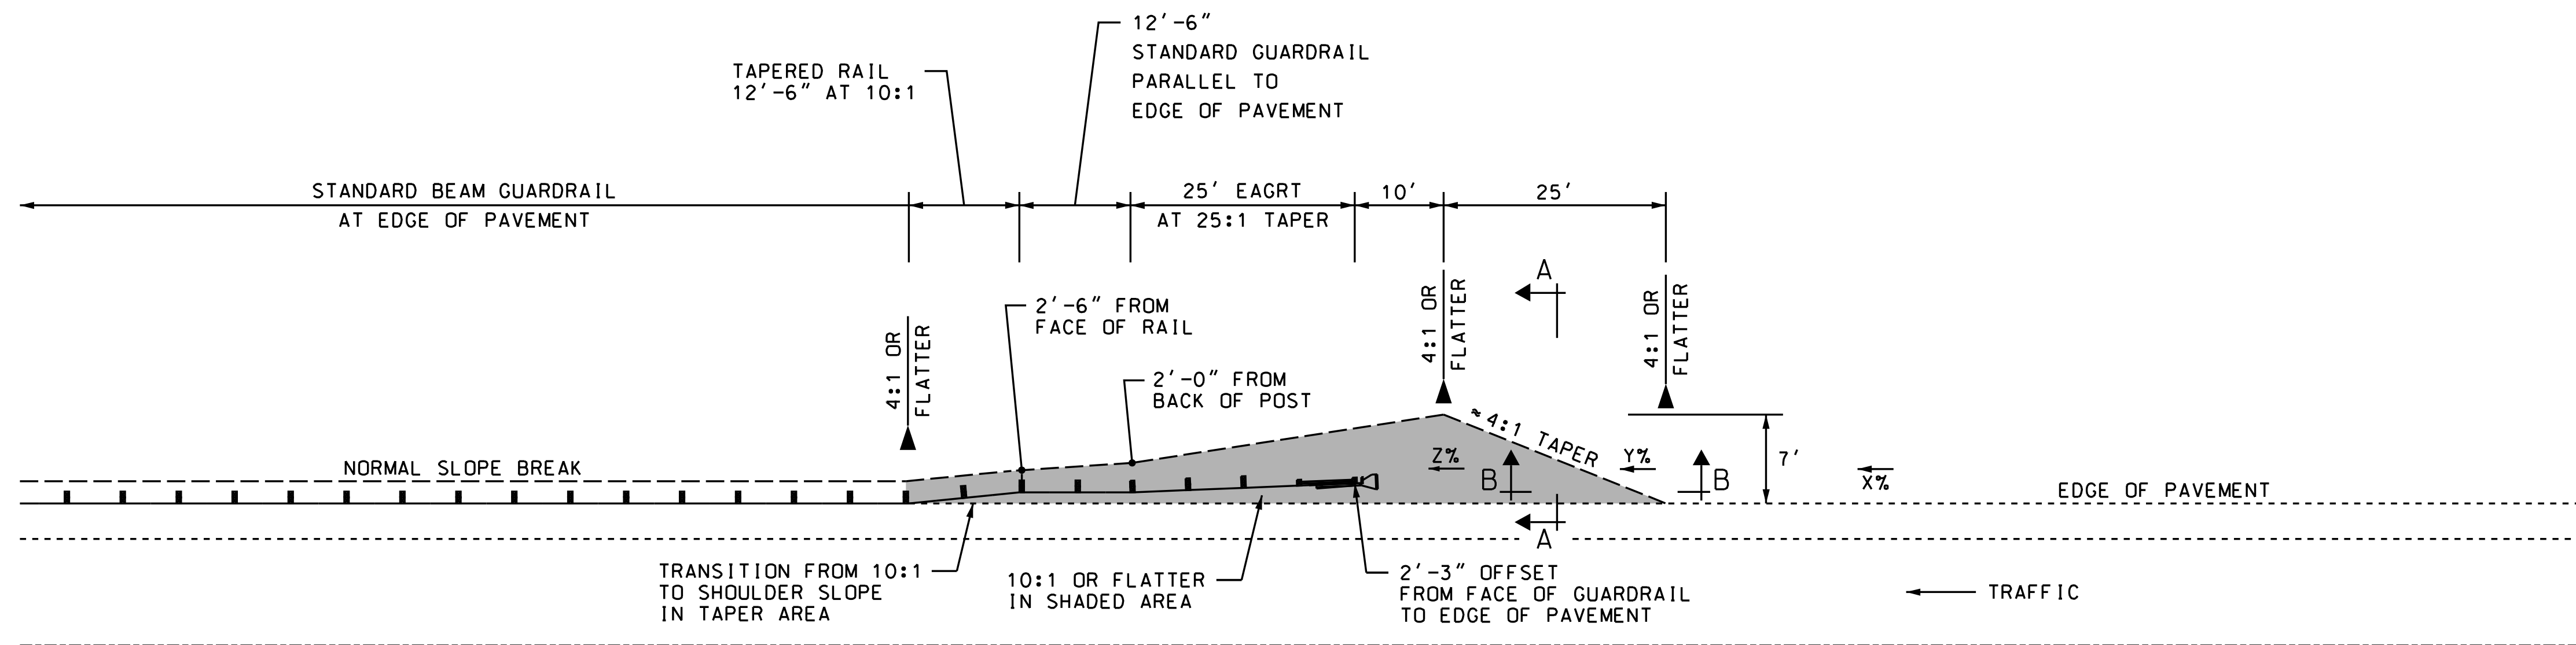


25' EAGRT UNIT


CMA
ENGINEERS

REVISION DATE	DGN	STATE PROJECT NO.	SHEET NO.	TOTAL SHEETS
11/24/14			21	29


STATE OF NEW HAMPSHIRE				
DEPARTMENT OF TRANSPORTATION • BUREAU OF HIGHWAY DESIGN				
ALTERNATIVE PLATFORM FOR OFFSET ENERGY ABSORBING GUARDRAIL TERMINAL (EAGRT)				

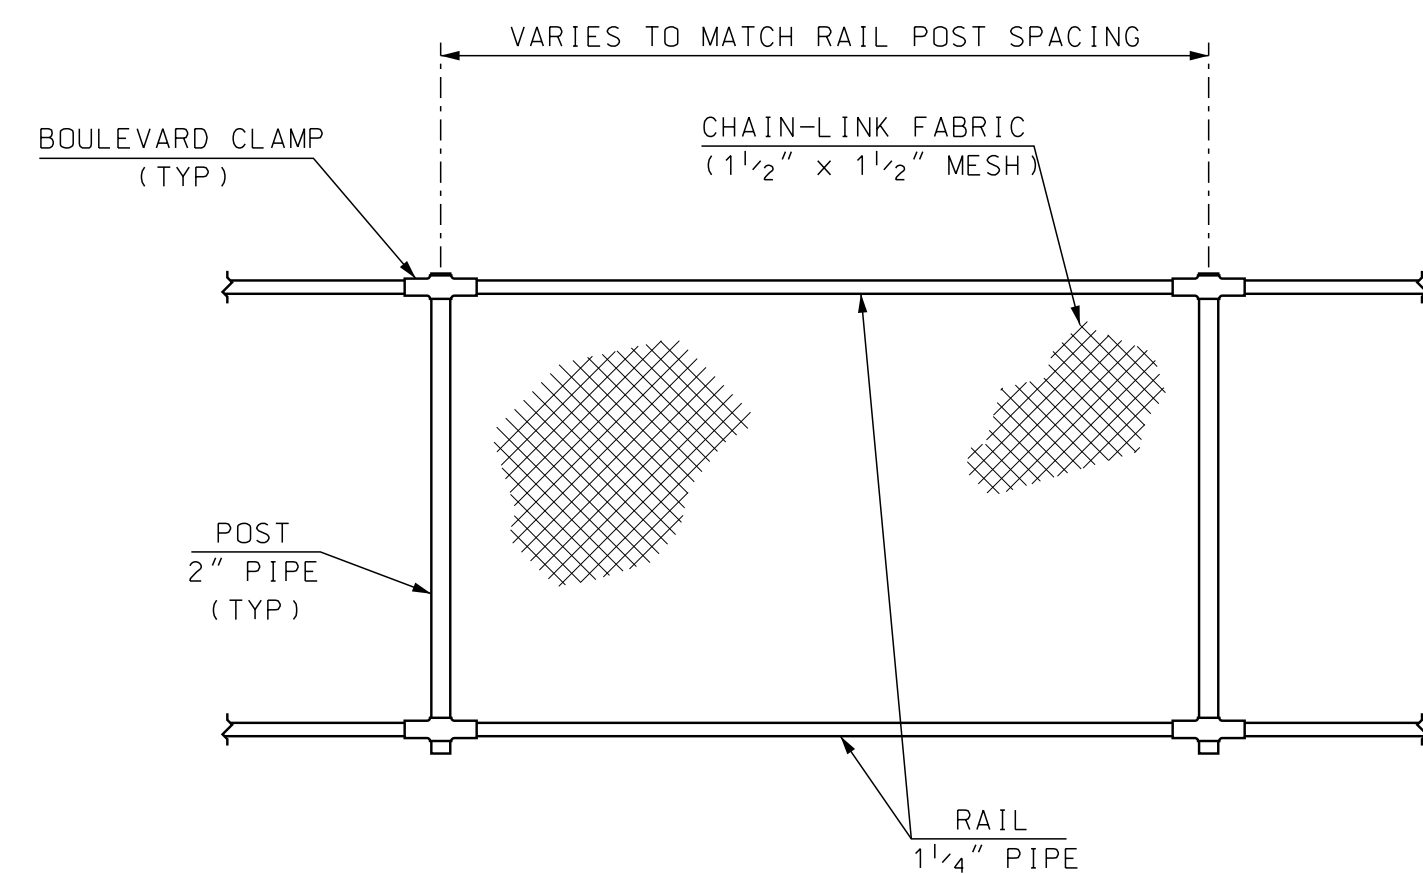


ELEVATION - SNOW SCREENING
SCALE: 1/2" = 1'-0"

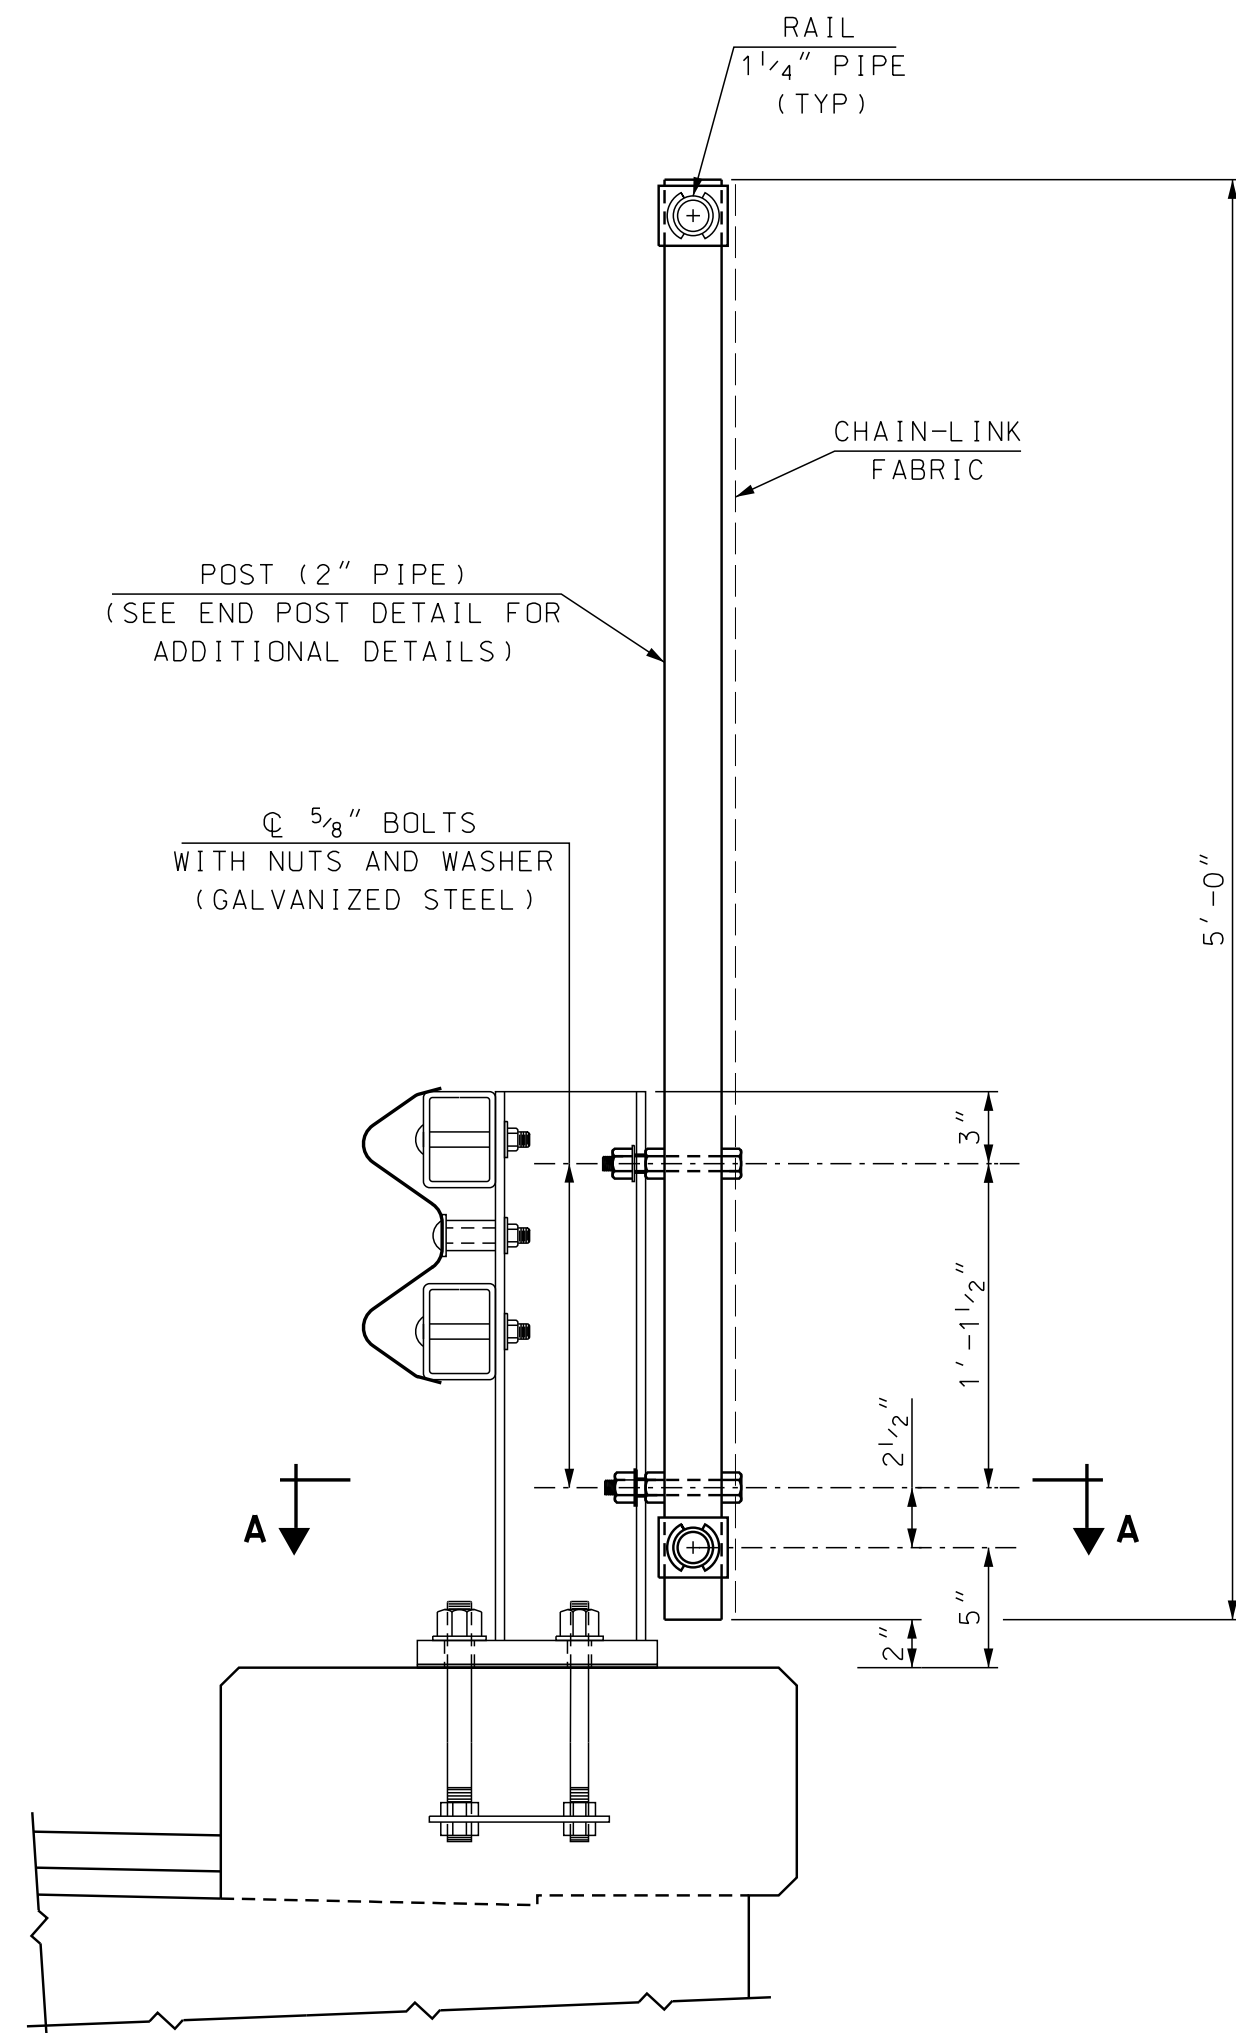


TYPICAL SECTION (T101 BRIDGE RAIL)
SCALE: 1/2" = 1'-0"

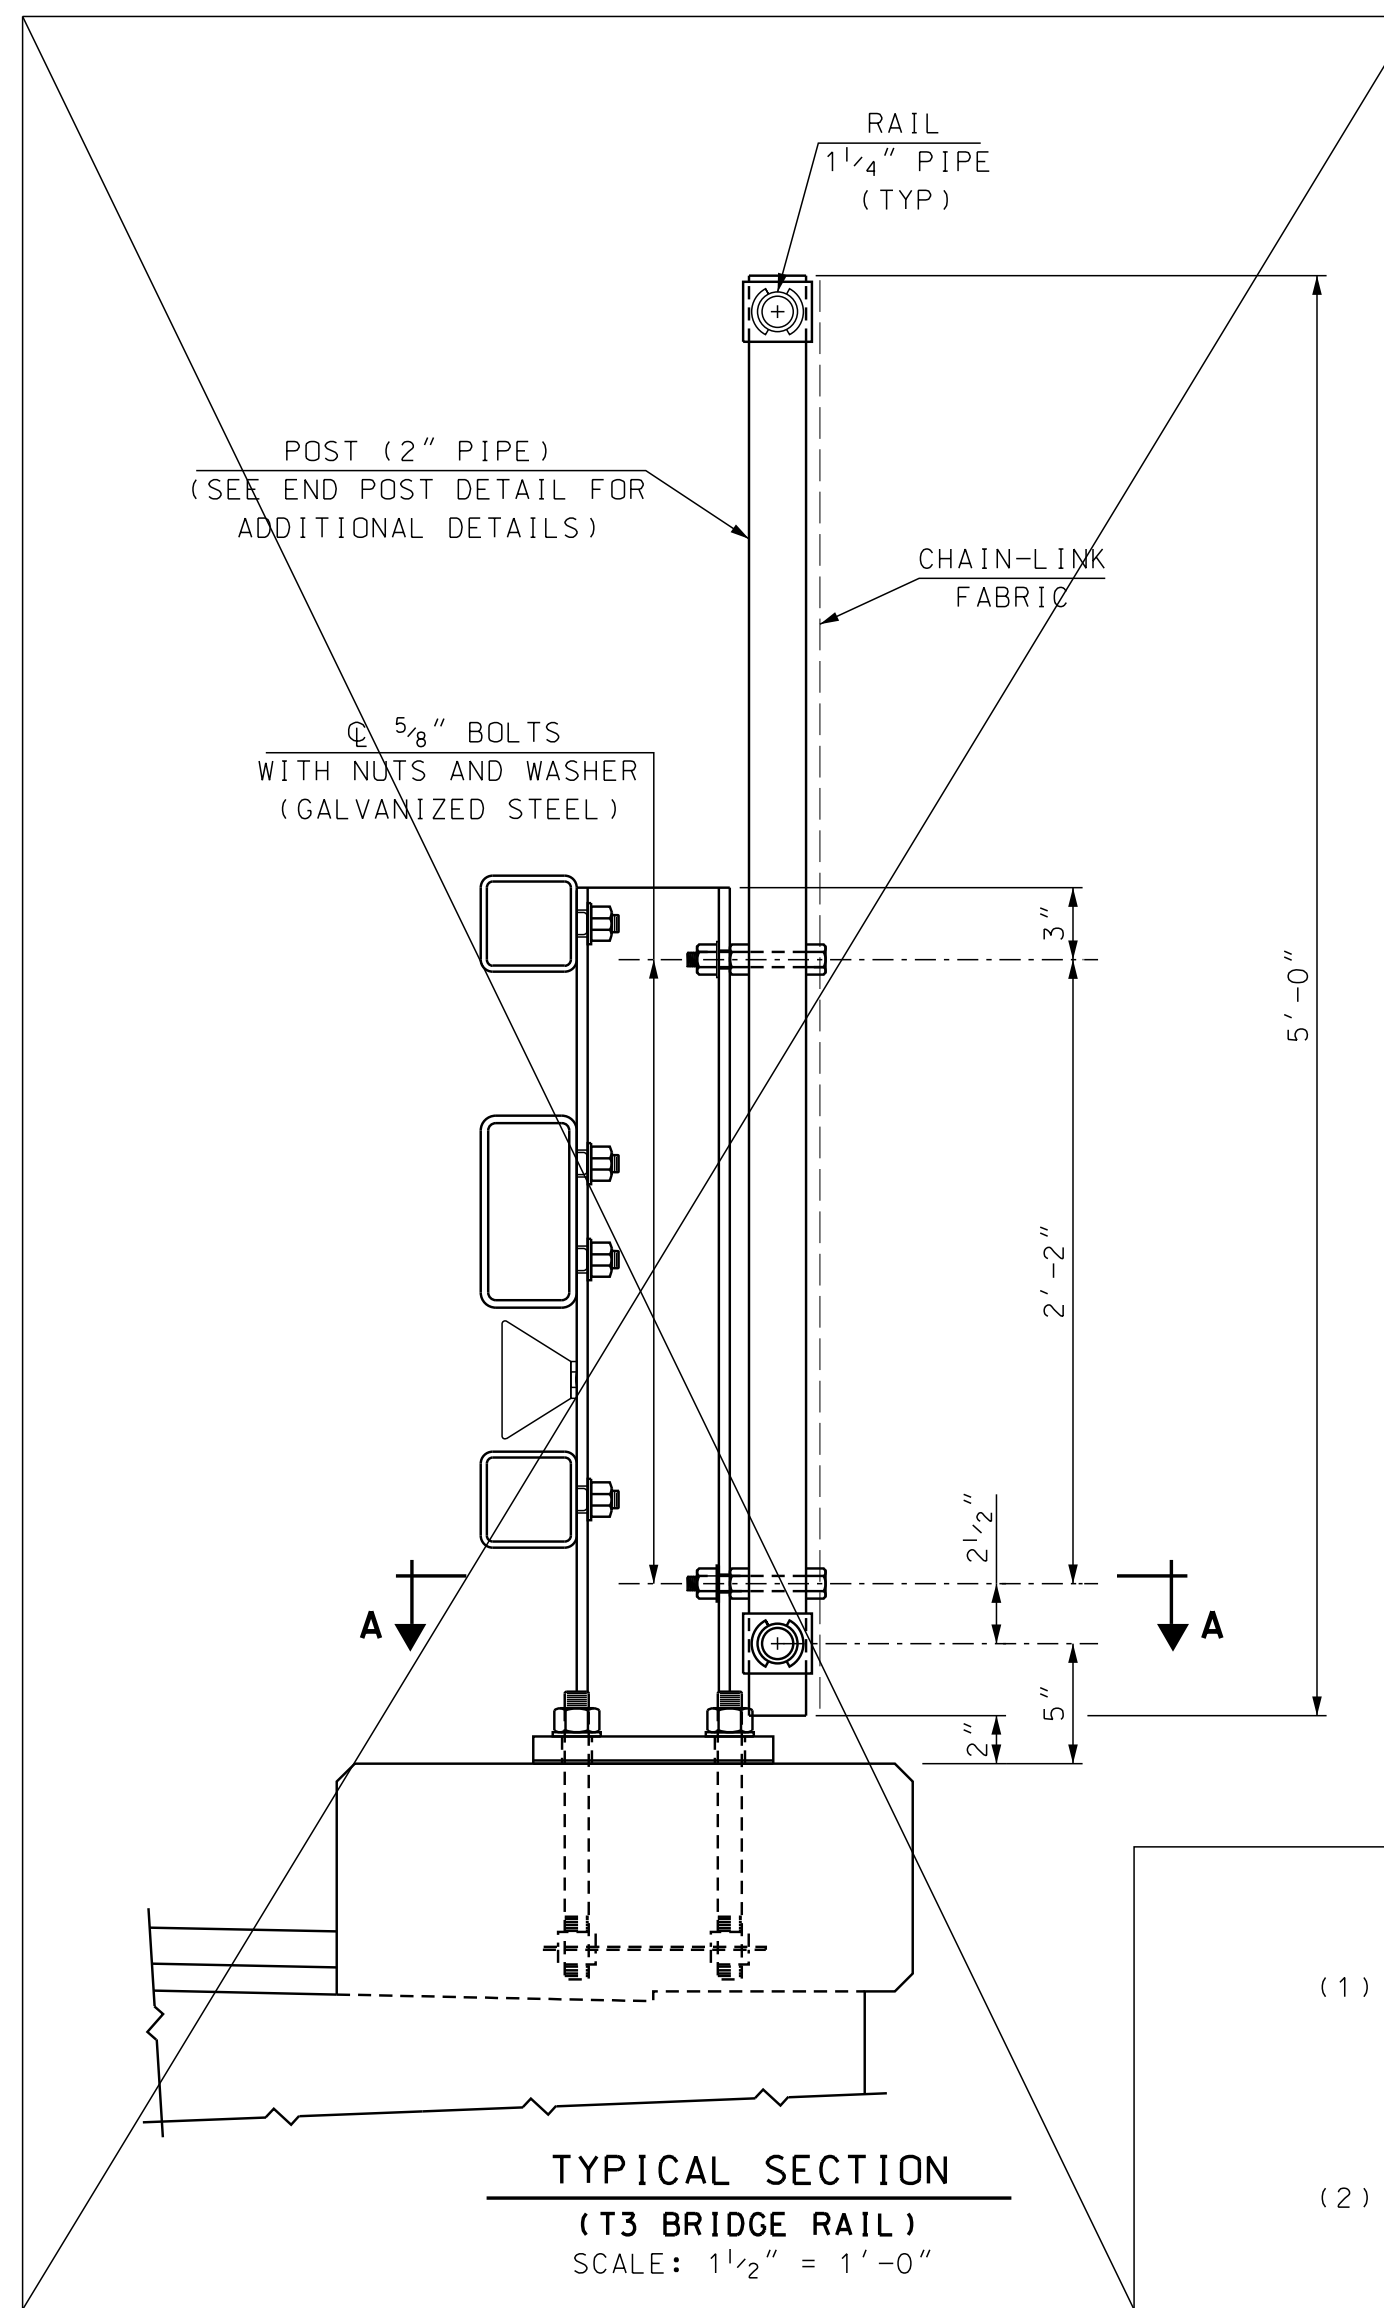


TYPICAL SECTION (T3 BRIDGE RAIL)
SCALE: 1/2" = 1'-0"

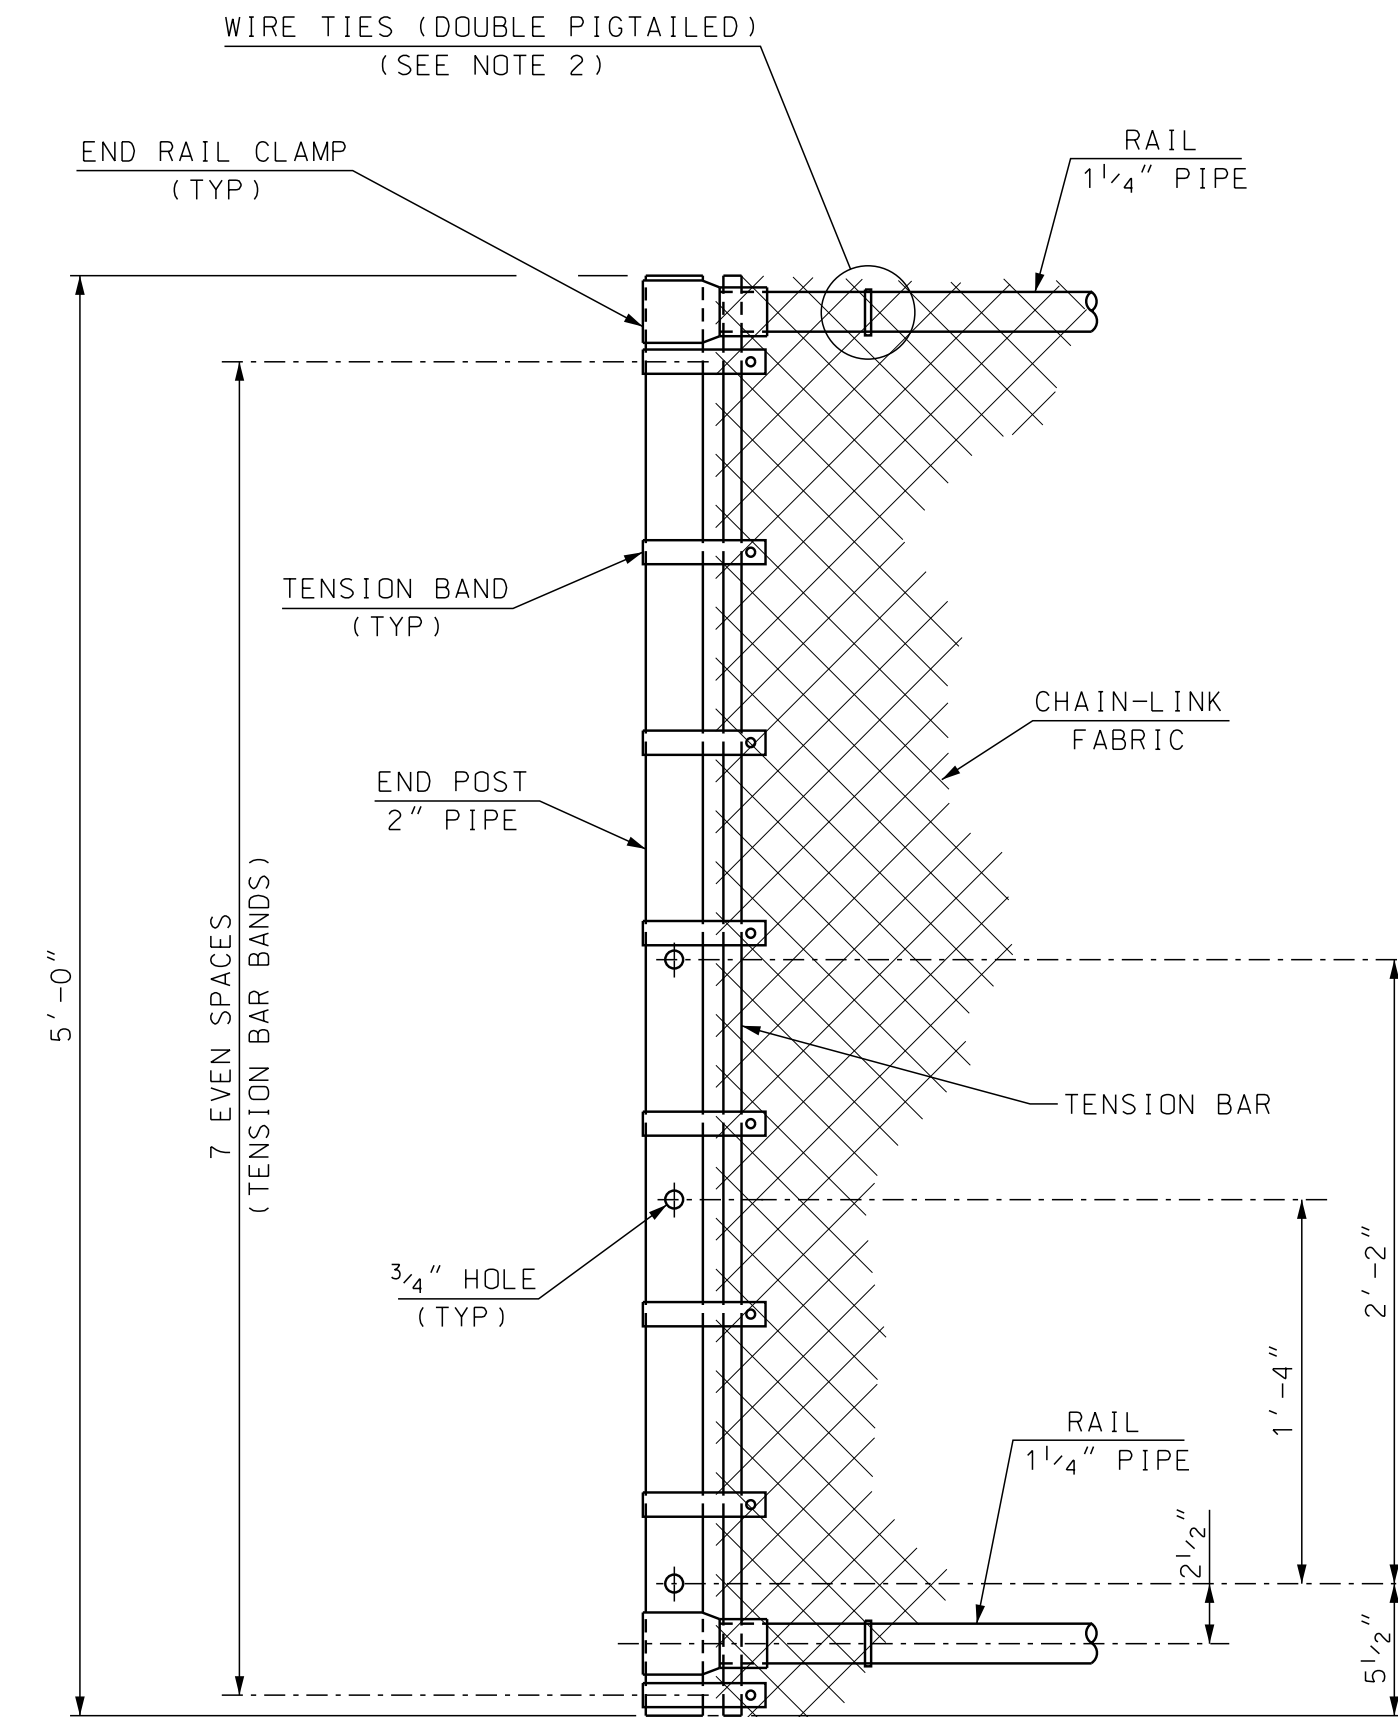


END POST DETAIL
SCALE: 1/2" = 1'-0"

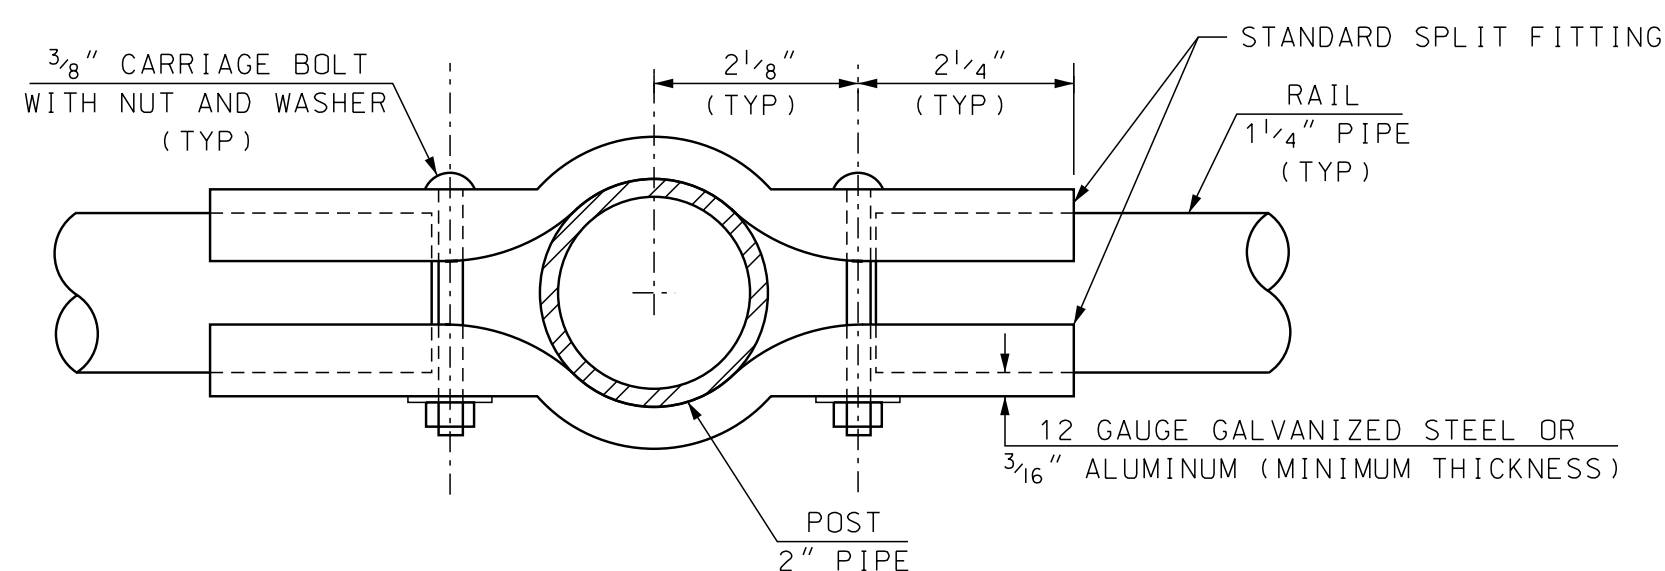


BOULEVARD CLAMP DETAIL
SCALE: 6" = 1'-0"

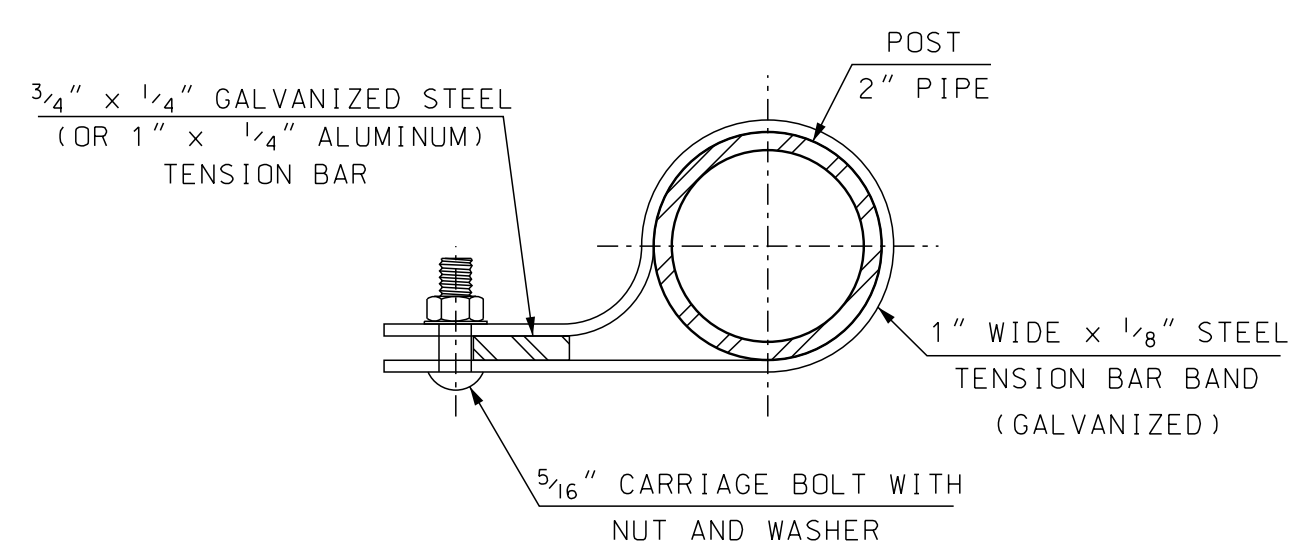


TENSION BAND DETAIL
SCALE: 6" = 1'-0"

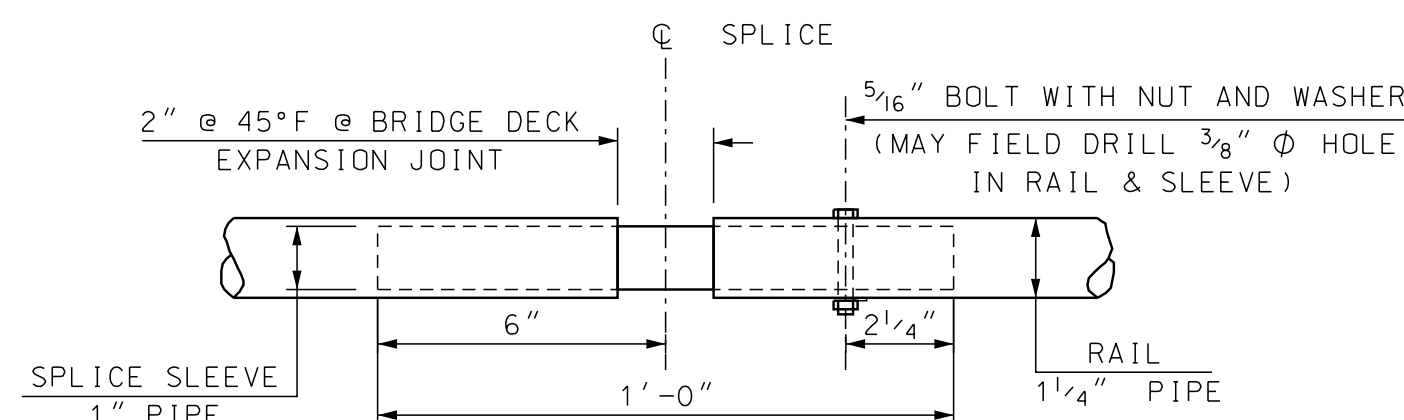


RAIL SPLICE DETAIL
SCALE: 3" = 1'-0"

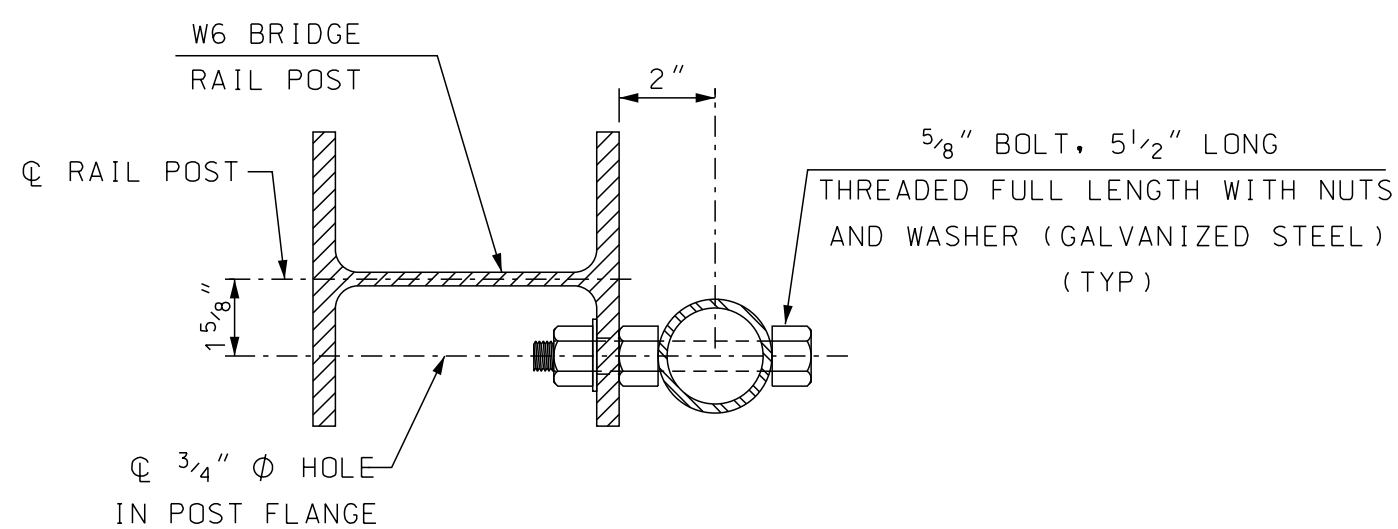

SECTION A-A (AT INTERIOR POST)
SCALE: 3" = 1'-0"

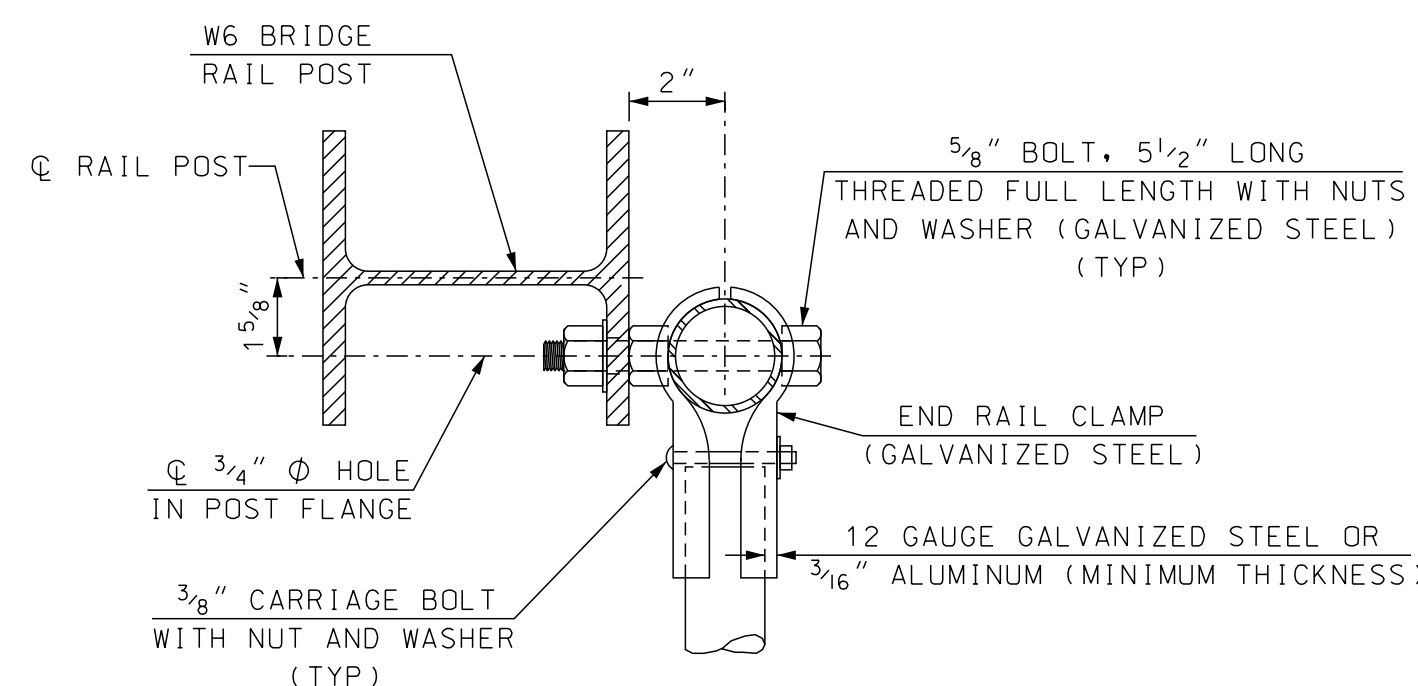

SECTION A-A (AT END POST)
SCALE: 3" = 1'-0"

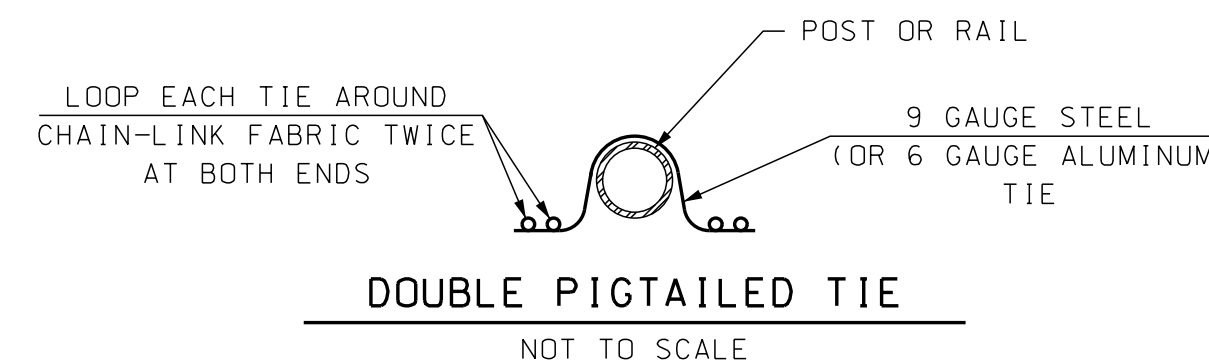


DOUBLE PIGTAILED TIE
NOT TO SCALE

- GENERAL NOTES**
- CHAIN-LINK FABRIC SHALL BE 9 GAUGE STEEL, ZINC-COATED CONFORMING TO AASHTO M 181, TYPE I, CLASS D (ASTM A 392), ALUMINUM-COATED CONFORMING TO AASHTO M 181, TYPE II (ASTM A 491) OR 6 GAUGE ALUMINUM ALLOY CONFORMING TO AASHTO M 181, TYPE III (ASTM F 1183). CHAIN-LINK FABRIC SHALL BE KNUCKLED ON TOP AND BOTTOM. THE SIZE OF WIRE MESH (FABRIC) SHALL BE 1 1/2".
 - WIRE TIES SHALL BE STANDARD ROUND 9 GAUGE ZINC- OR ALUMINUM-COATED STEEL OR 6 GAUGE ALUMINUM ALLOY CONFORMING TO ASTM F 626. ALL TIES SHALL BE WRAPPED AROUND CHAIN-LINK FABRIC TWICE (DOUBLE PIGTAILED) AT BOTH ENDS. SPACE TIES @ 6" O.C. TO BOTTOM RAIL AND @ 12" O.C. TO ALL POSTS AND OTHER RAILS.
 - POST AND RAIL PIPE SHALL BE HOT-DIP GALVANIZED STEEL CONFORMING TO AASHTO M 181, GRADE 1 (ASTM F 1083) OR ALUMINUM ALLOY CONFORMING TO AASHTO M 181 (ASTM B 429, ALLOY 6063-T6). ALL PIPE SHALL BE SCHEDULE 40, STANDARD WEIGHT. NOMINAL PIPE SIZES ARE SHOWN IN THE DRAWINGS.
 - TENSION BARS, BAR BANDS, BOULEVARD AND END RAIL CLAMPS SHALL BE STEEL OR ALUMINUM ALLOY CONFORMING TO AASHTO M 181 (ASTM F 626). STEEL COMPONENTS SHALL BE HOT-DIP GALVANIZED IN ACCORDANCE WITH AASHTO M 111 (ASTM A 123) OR AASHTO M 232 (ASTM A 153) AS APPLICABLE.
 - ALL BOLTS AND NUTS SHALL BE STEEL CONFORMING TO ASTM A 307 AND ASTM A 563 GRADE A RESPECTIVELY. WASHERS SHALL BE HARDENED STEEL COMMERCIAL TYPE A PLAIN AND SHALL MEET THE DIMENSIONAL REQUIREMENTS OF ANSI B18.22. ALL BOLTS, NUTS AND WASHERS SHALL BE HOT-DIP GALVANIZED IN ACCORDANCE WITH AASHTO M 111 (ASTM A 123) OR AASHTO M 232 (ASTM A 153) AS APPLICABLE.
 - RAIL SPLICES SHALL BE PROVIDED AT BRIDGE DECK EXPANSION JOINT(S) AND BRIDGE RAIL SPLICES AS DIRECTED BY THE CONTRACT ADMINISTRATOR.
 - RAIL MAY BE FIELD CUT (SAWN) TO FIT POST SPACING. GALVANIZED RAIL, CUT OR DRILLED AS ALLOWED, SHALL BE TOUCHED-UP IN ACCORDANCE WITH 563.3.2.2.3.
 - ALL COSTS FOR CHAIN-LINK FABRIC, POSTS, RAILS AND APPURTENANCES SHALL BE INCLUDED IN ITEM 563.353, BRIDGE RAIL T101 WITH SNOW SCREENING.
 - SEE BRIDGE RAIL SHEET FOR ADDITIONAL DETAILS.

STATE OF NEW HAMPSHIRE									
DEPARTMENT OF TRANSPORTATION * BUREAU OF BRIDGE DESIGN									
TOWN: EXETER			BRIDGE NO.: 087/062			STATE PROJECT			
LOCATION: LITTLE RIVER CROSSING AT LINDEN STREET									
SNOW SCREEN WITH T101 BRIDGE RAIL									
REVISIONS		BY	DATE	BY		DATE		BRIDGE SHEET	
1	ADDED T3 RAIL DETAILS	1/30/13	DESIGNED NHDOT	8/10	CHECKED NHDOT	8/10	8/10	21	OF 21
			DRAWN NHDOT	8/10	CHECKED NHDOT	8/10	8/10		FILE NUMBER
			QUANTITIES LBK	3/15	CHECKED SCK	5/15			
SUBDIRECTORY		DGN LOCATOR	SHEET SCALE		ISSUE DATE		FEDERAL PROJECT NO.	TOTAL SHEETS	
			AS NOTED		2/98			29	
					REV. DATE		12/20/13	22	

CMA ENGINEERS

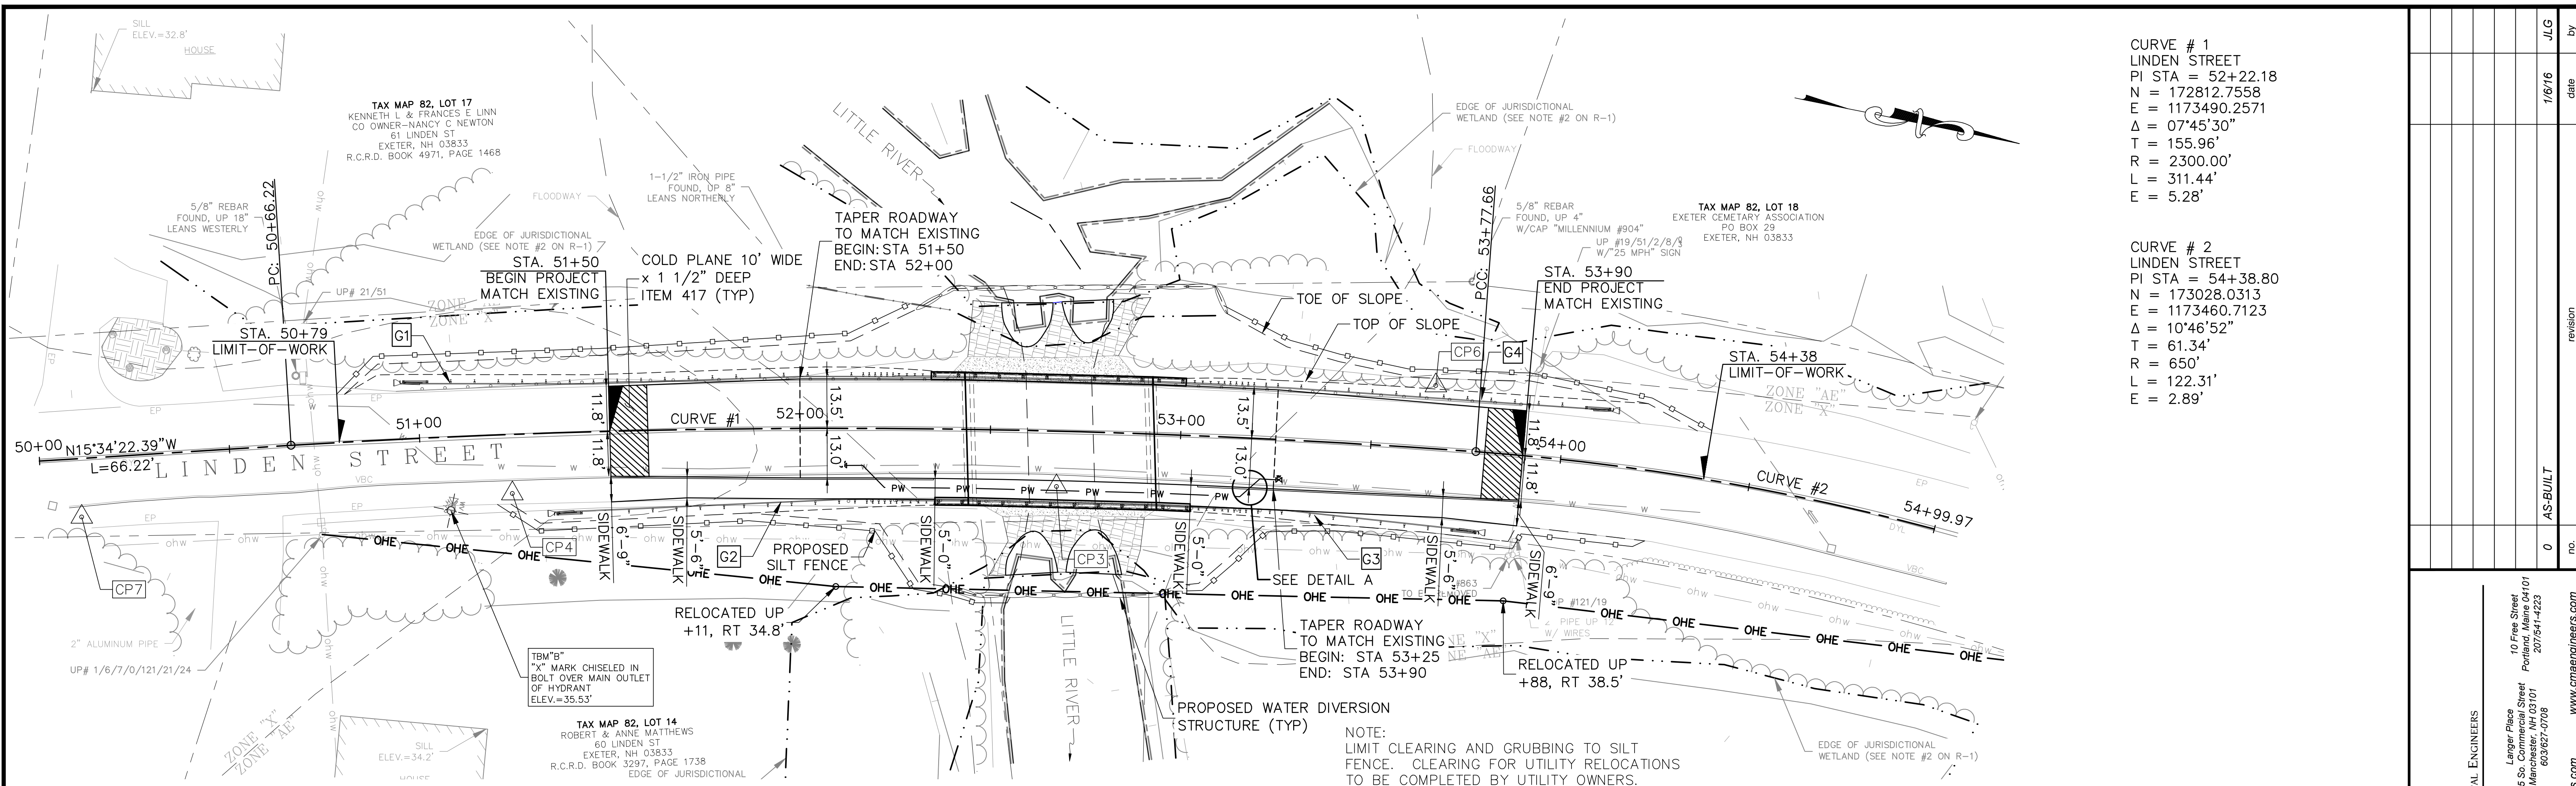


Plan
Scale: 1"=20'

CURVE # 1
LINDEN STREET
PI STA = 52+22.18
N = 172812.7558
E = 1173490.2571
Δ = 07°45'30"
T = 155.96'
R = 2300.00'
L = 311.44'
E = 5.28'


CURVE # 2
LINDEN STREET
PI STA = 54+38.80
N = 173028.0313
E = 1173460.7123
Δ = 10°46'52"
T = 61.34'
R = 650'
L = 122.31'
E = 2.89'

NOTE:
LIMIT CLEARING AND GRUBBING TO SILT FENCE. CLEARING FOR UTILITY RELOCATIONS TO BE COMPLETED BY UTILITY OWNERS.

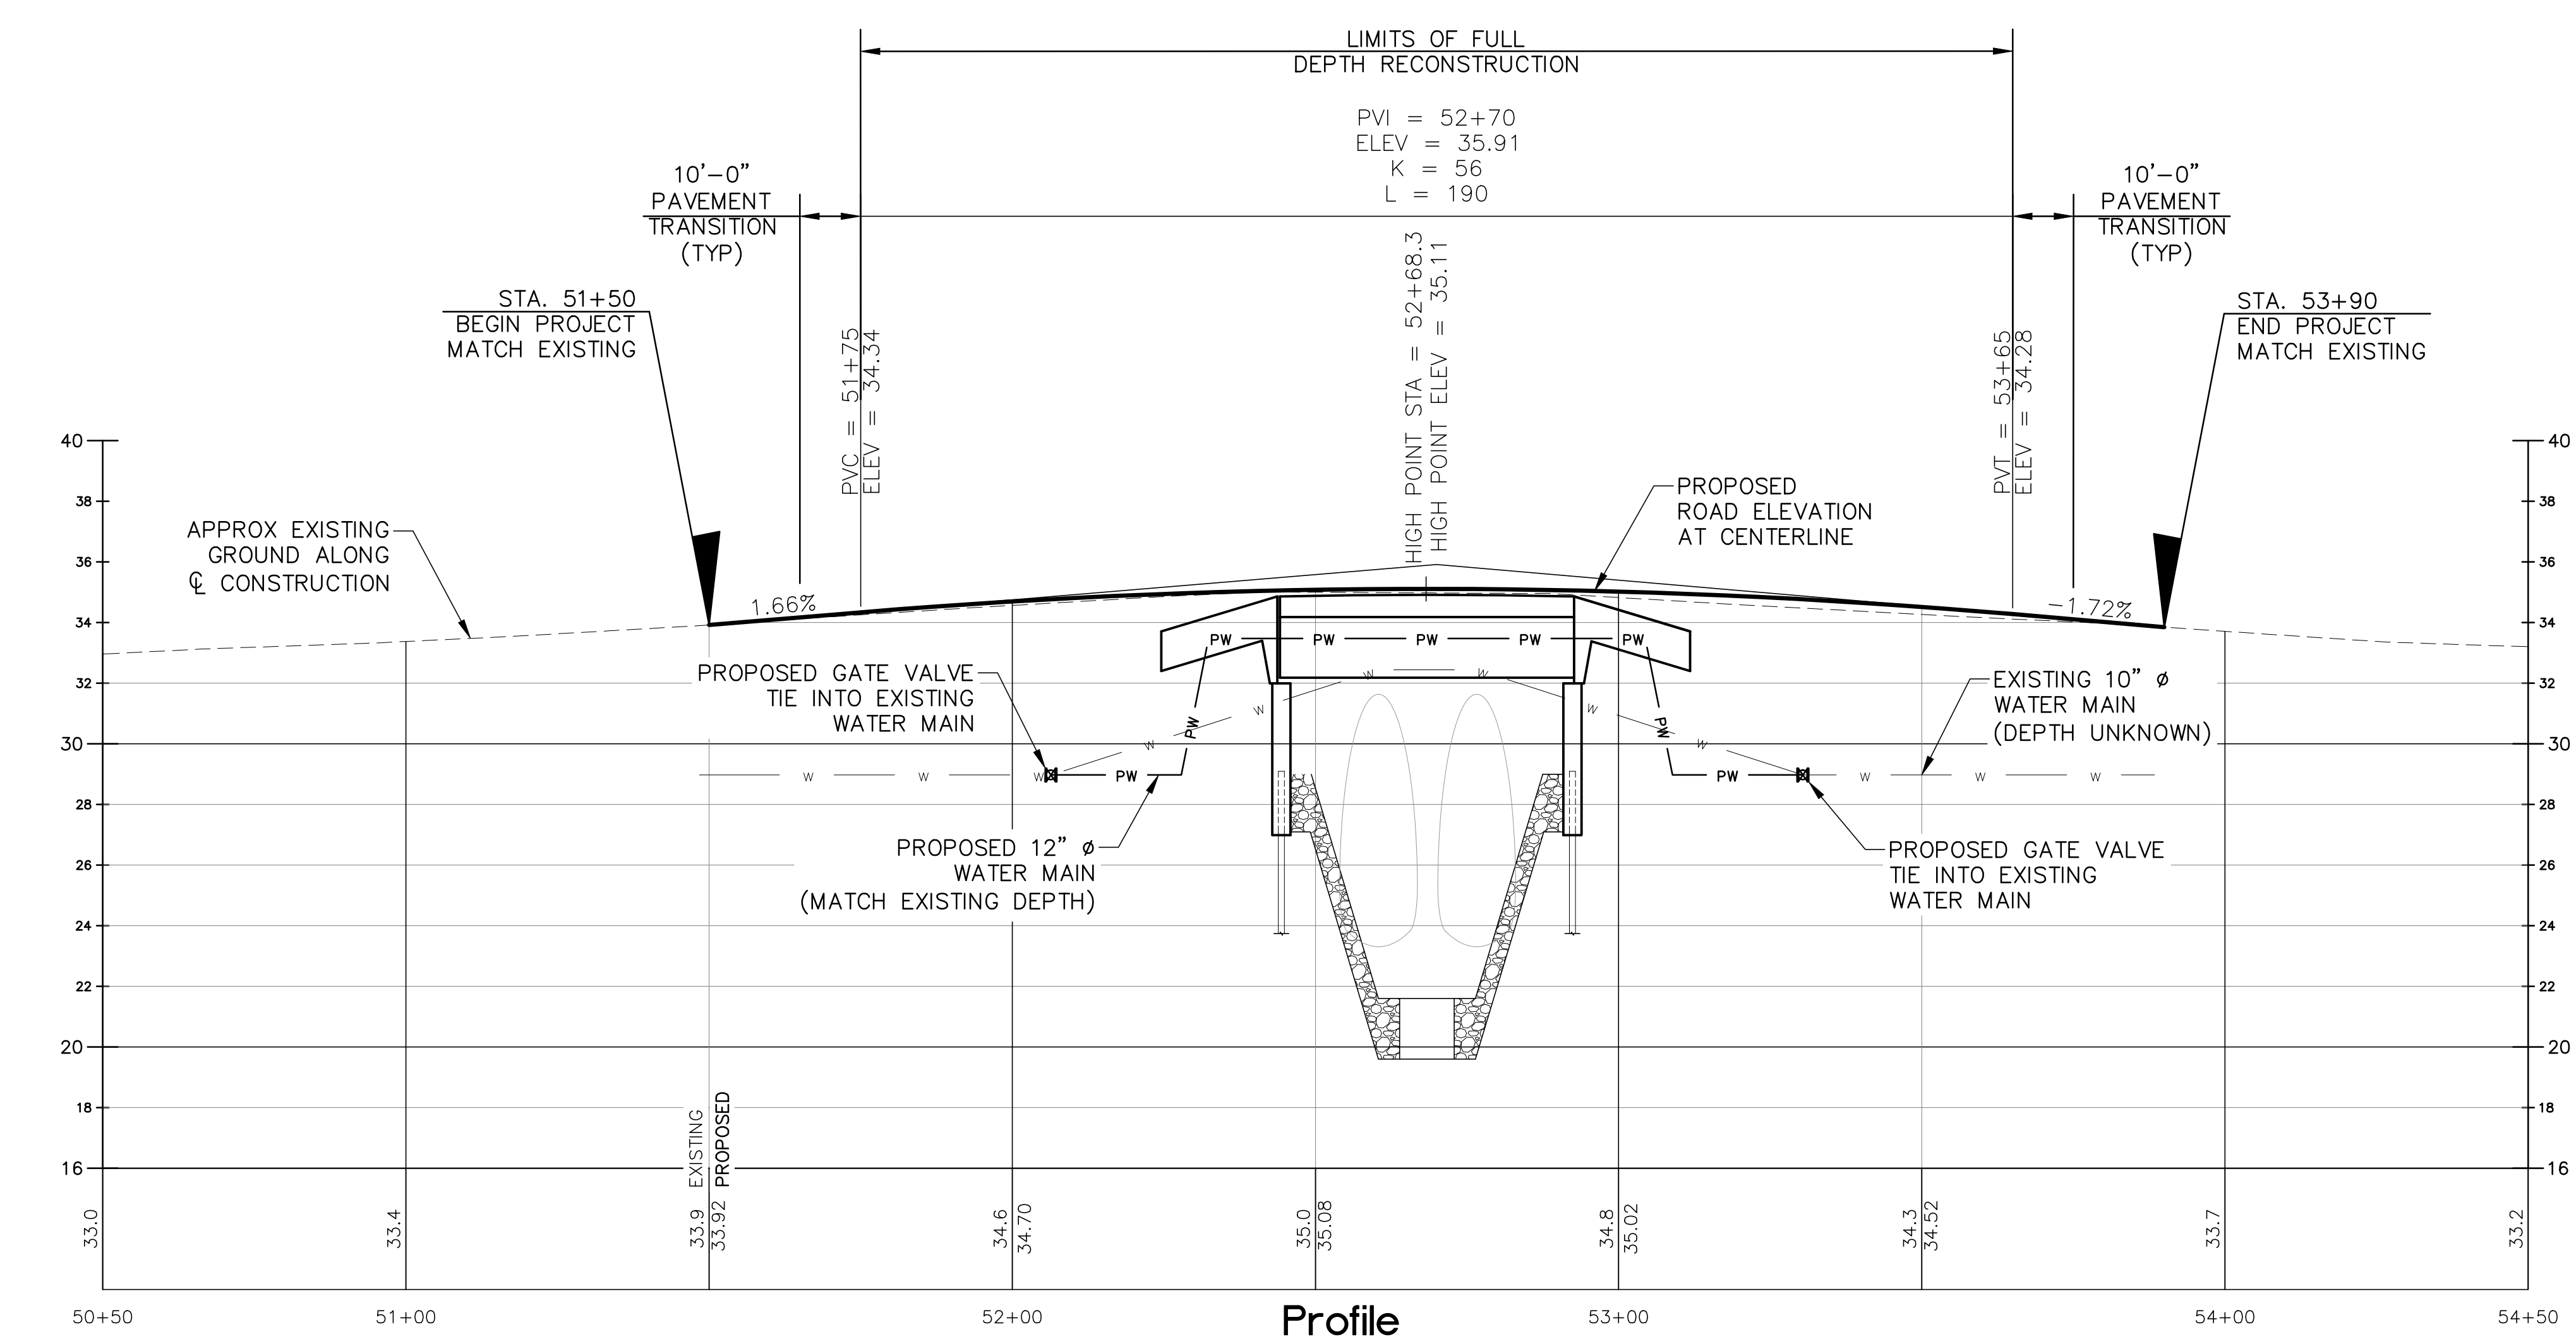

Profile
Vertical Scale: 1"=4'
Horizontal Scale: 1"=20'

CONTROL POINTS TABLE				
POINT #	NORTHING	EASTING	ELEVATION	DESCRIPTION
CP1	173689.0717	1173709.7186	46.52	HUBS
CP2	173200.0030	1173458.2140	33.84	HUBS
CP3	172861.4239	1173500.9164	35.26	MAGS
CP4	172721.9956	1173532.4221	34.07	MAGS
CP5	172317.5397	1173637.7321	33.65	MAGS
CP6	172953.3795	1173454.2495	32.75	HUBS
CP7	172612.6377	1173561.9500	32.56	MAGS

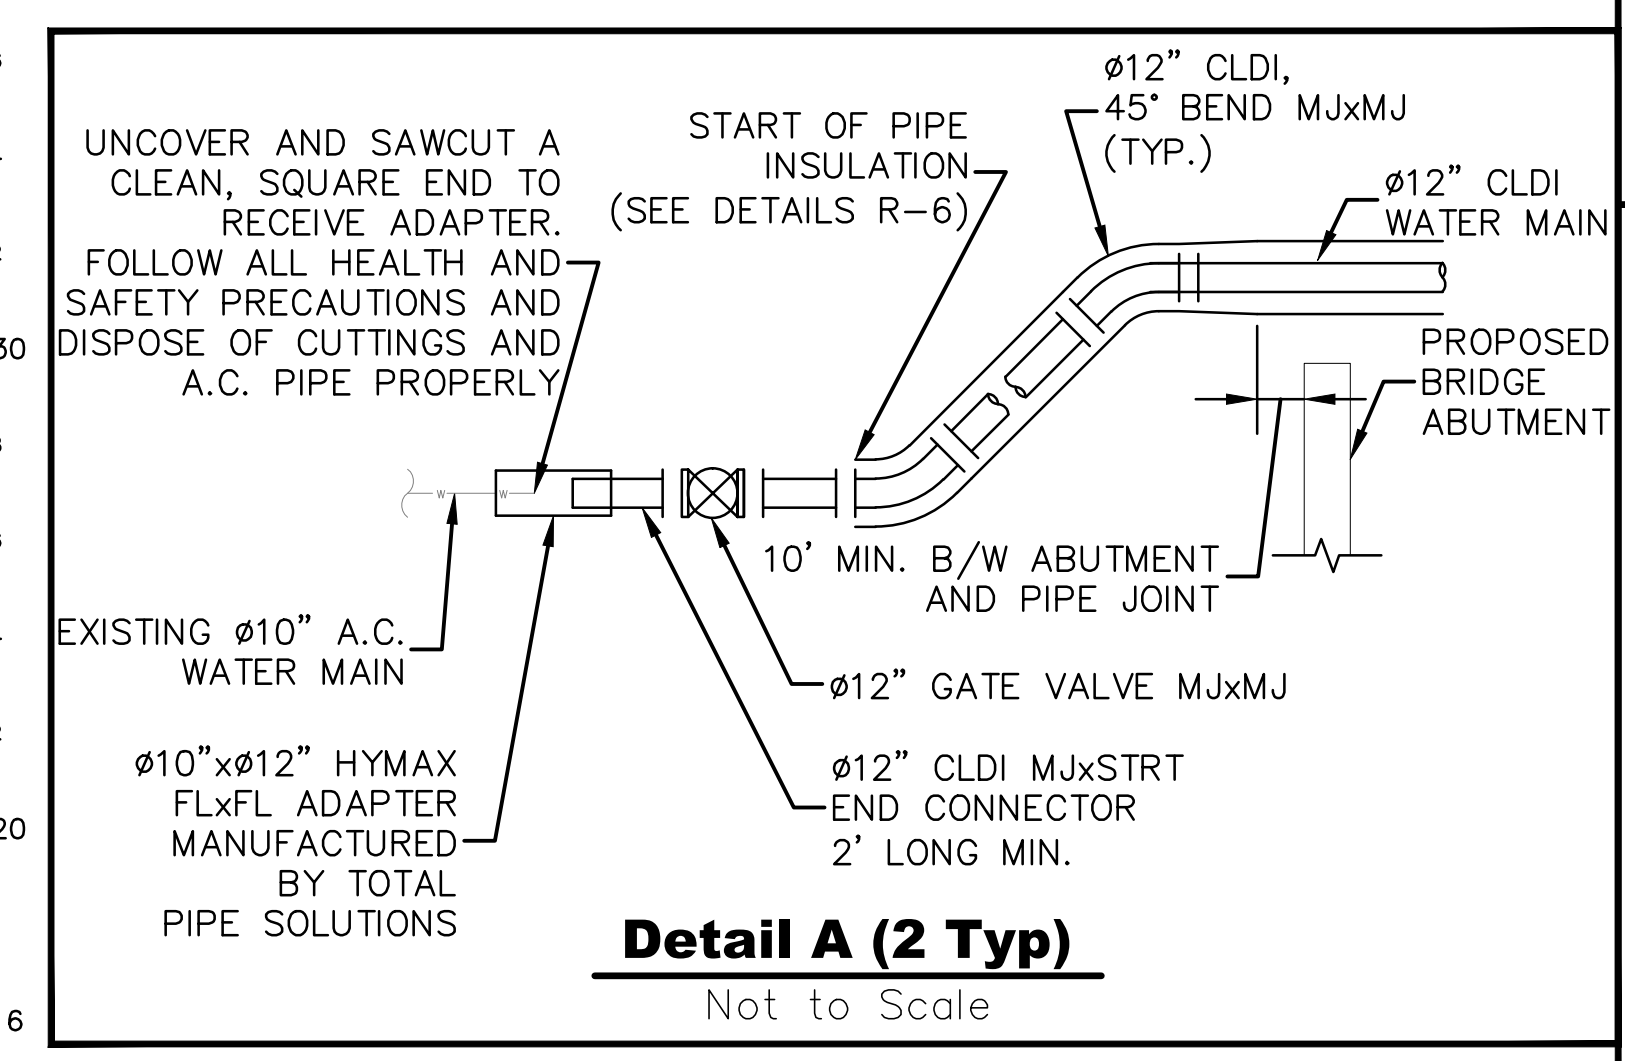

CMA ENGINEERS
CIVIL/ENVIRONMENTAL ENGINEERS
10 Free Street
Portland, Maine 04101
55 So. Commercial Street
Manchester, NH 03801
603-431-6196
info@cmaengineers.com
www.cmaengineers.com




designed by: LBK/OGK
drawn by: LBK/OGK
checked by: JLG
approved by: JLG

date: May 2015
project no: 923
file name: 923 - Roadway Plans.dwg

scale: 1"=20'
sheet: 24 of 29

Town of Exeter
Department of Public Works
Linden Street
Little River Bridge Replacement
Roadway Plan and Profile

drawing no: R-2

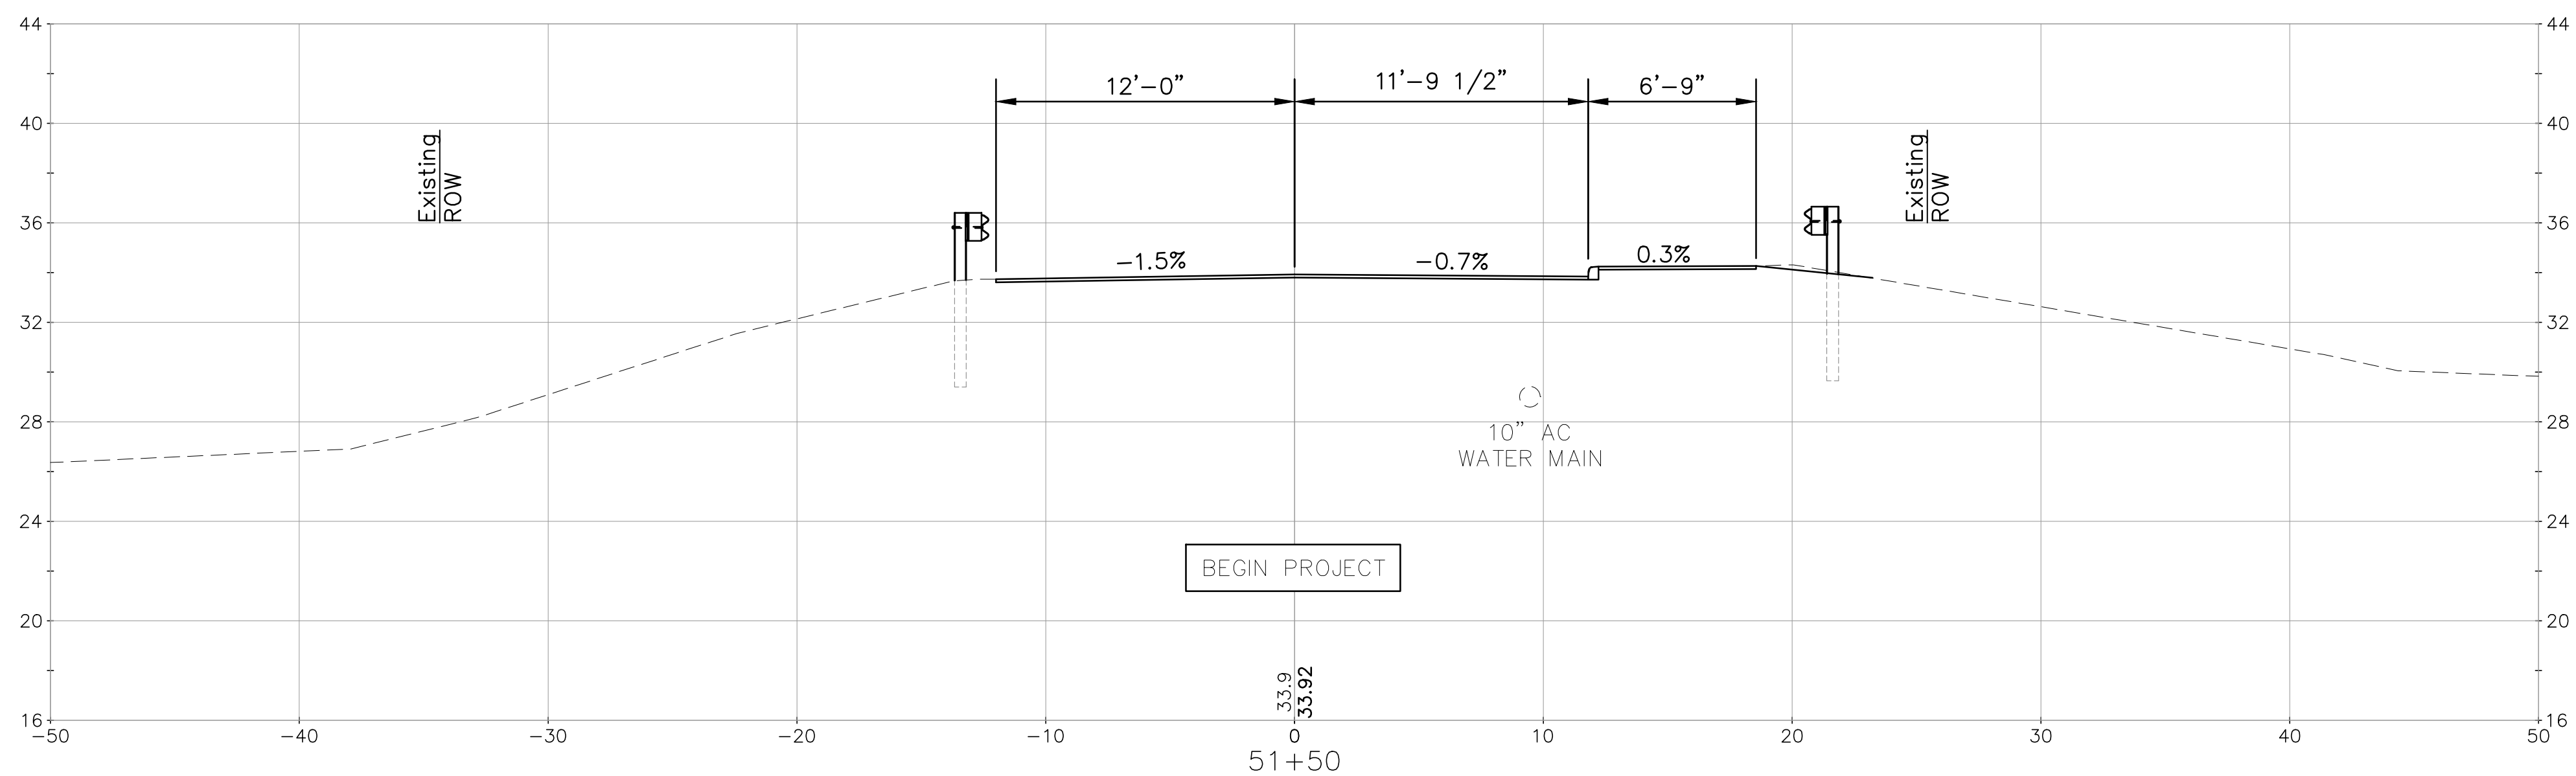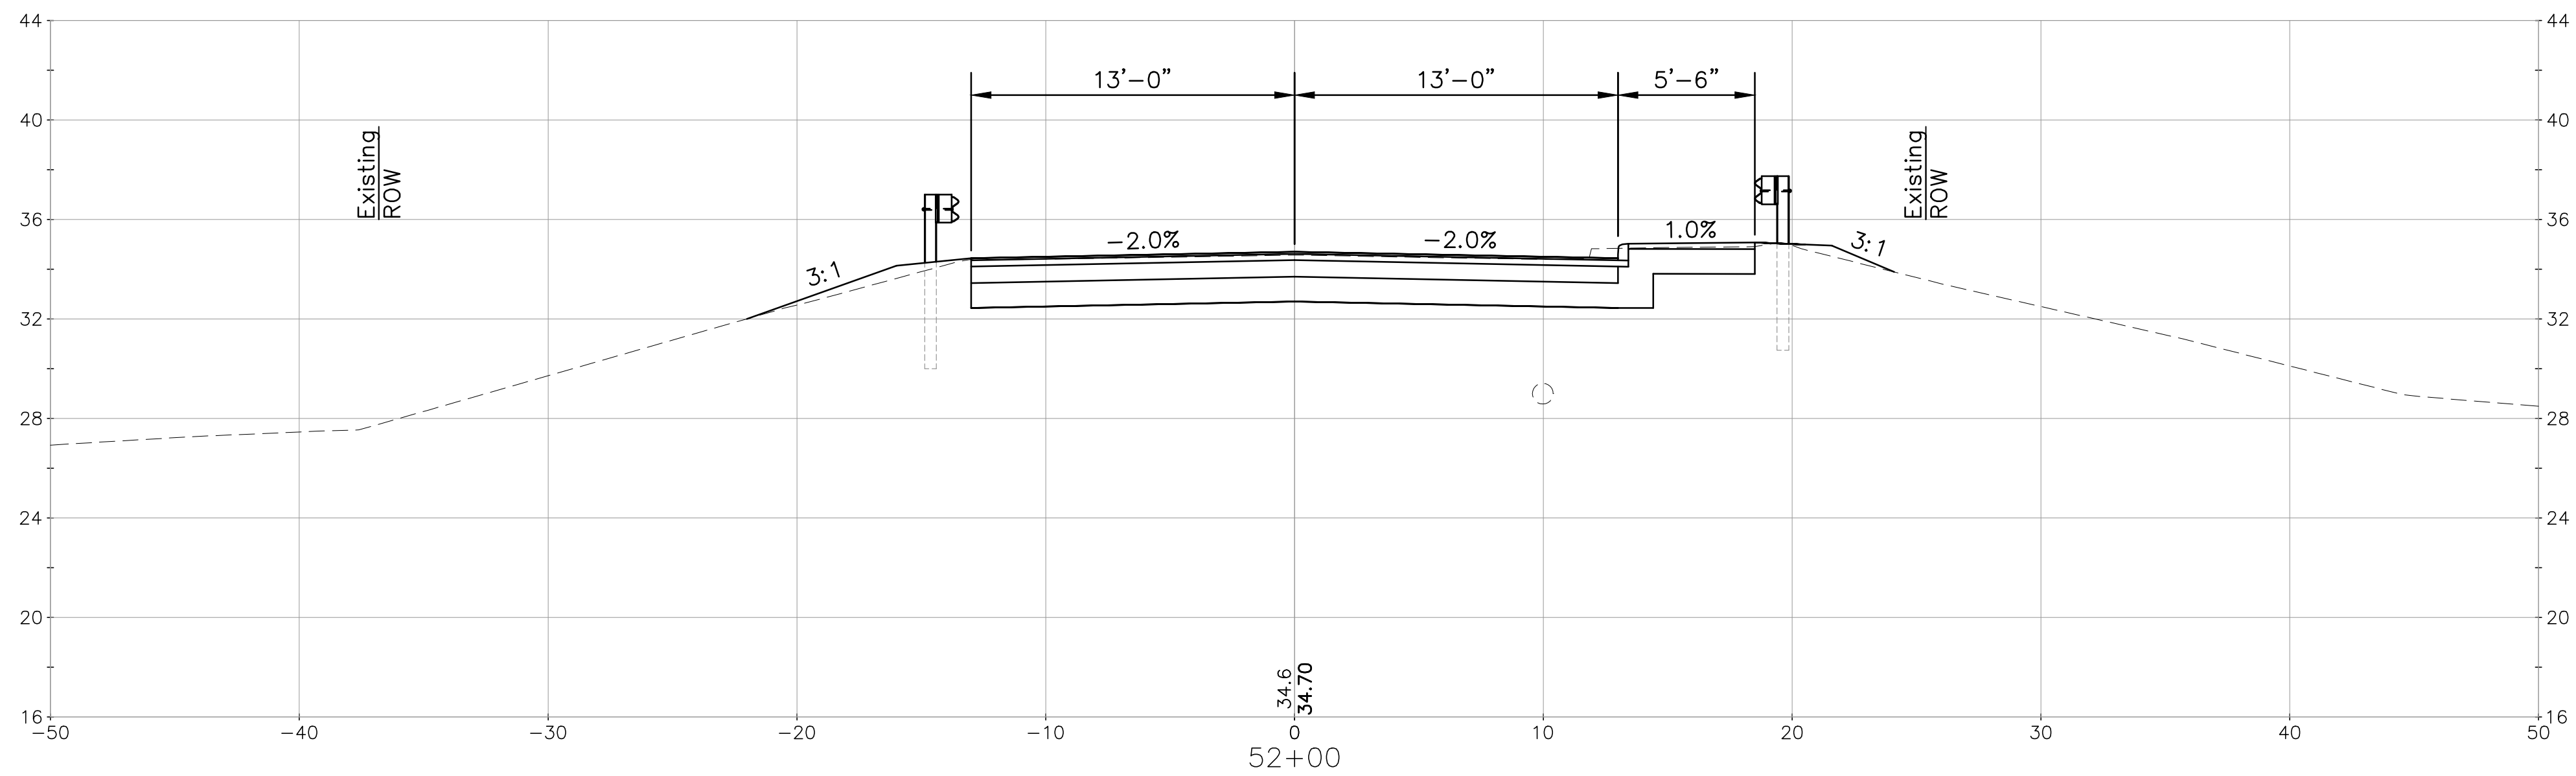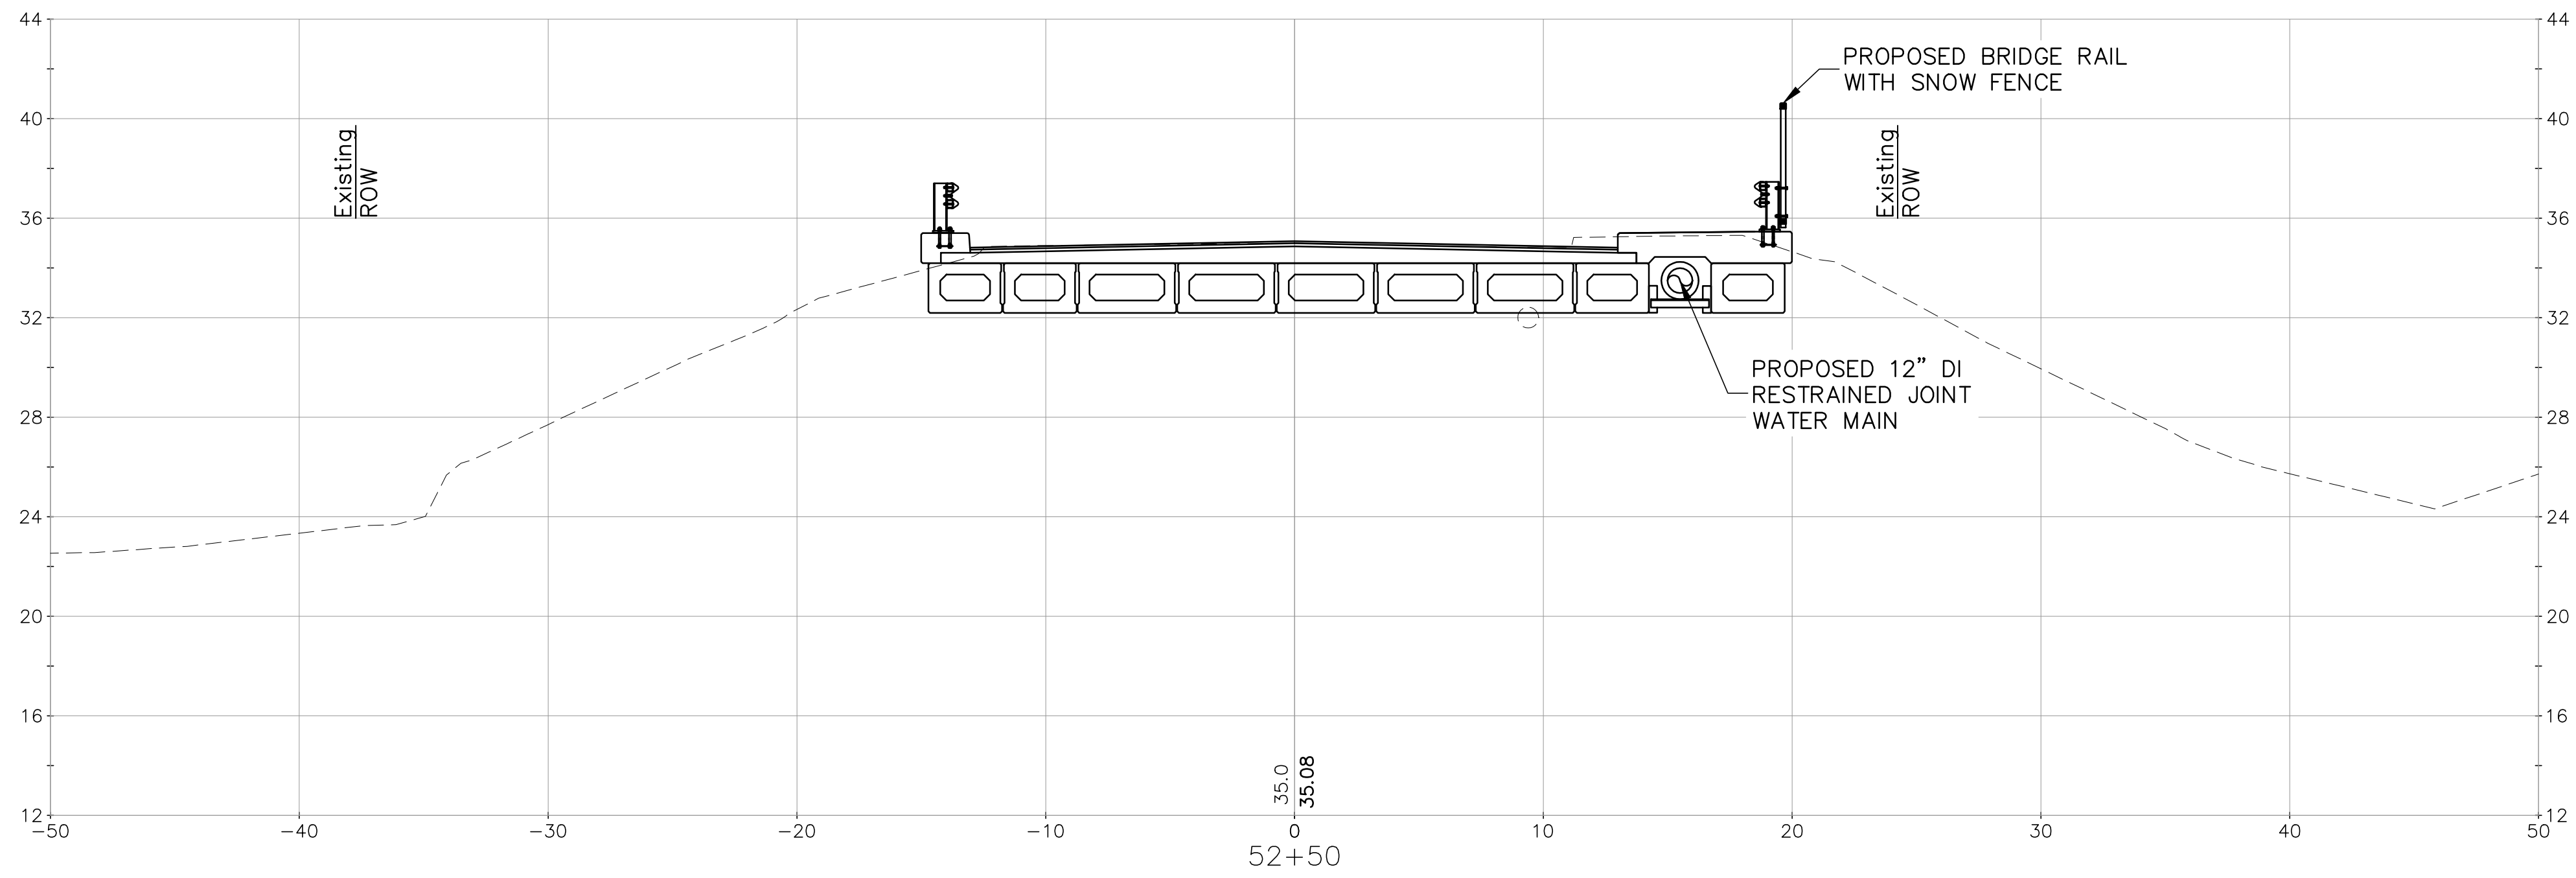

no.	0	AS-BUILT	1/6/16	JLG	by
revision					date


CMA ENGINEERS
 CIVIL/ENVIRONMENTAL ENGINEERS

10 Free Street
 Portland, Maine 04101
 207.541-4223

35 Bow Street
 Portsmouth, NH 03801
 603.431-6196

55 So. Commercial Street
 Manchester, NH 03101
 603.627-0708




info@cmaengineers.com www.cmaengineers.com

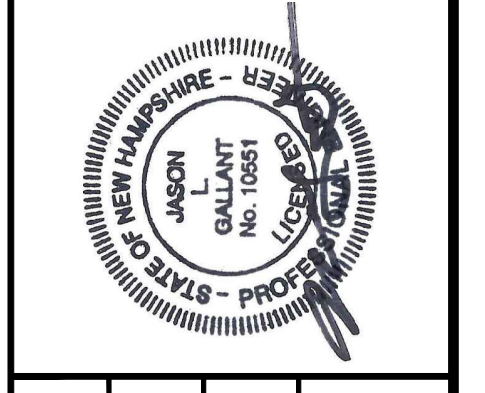

date:	May 2015
designed by:	LBK/OGK
project no:	923
drawn by:	LBK/OGK
file name:	923 - Railway Plans.dwg
approved by:	JLG


Town of Exeter
 Department of Public Works
 Linden Street
 Little River Bridge Replacement
 Cross Sections
 (1 of 2)

drawing no.
R-3

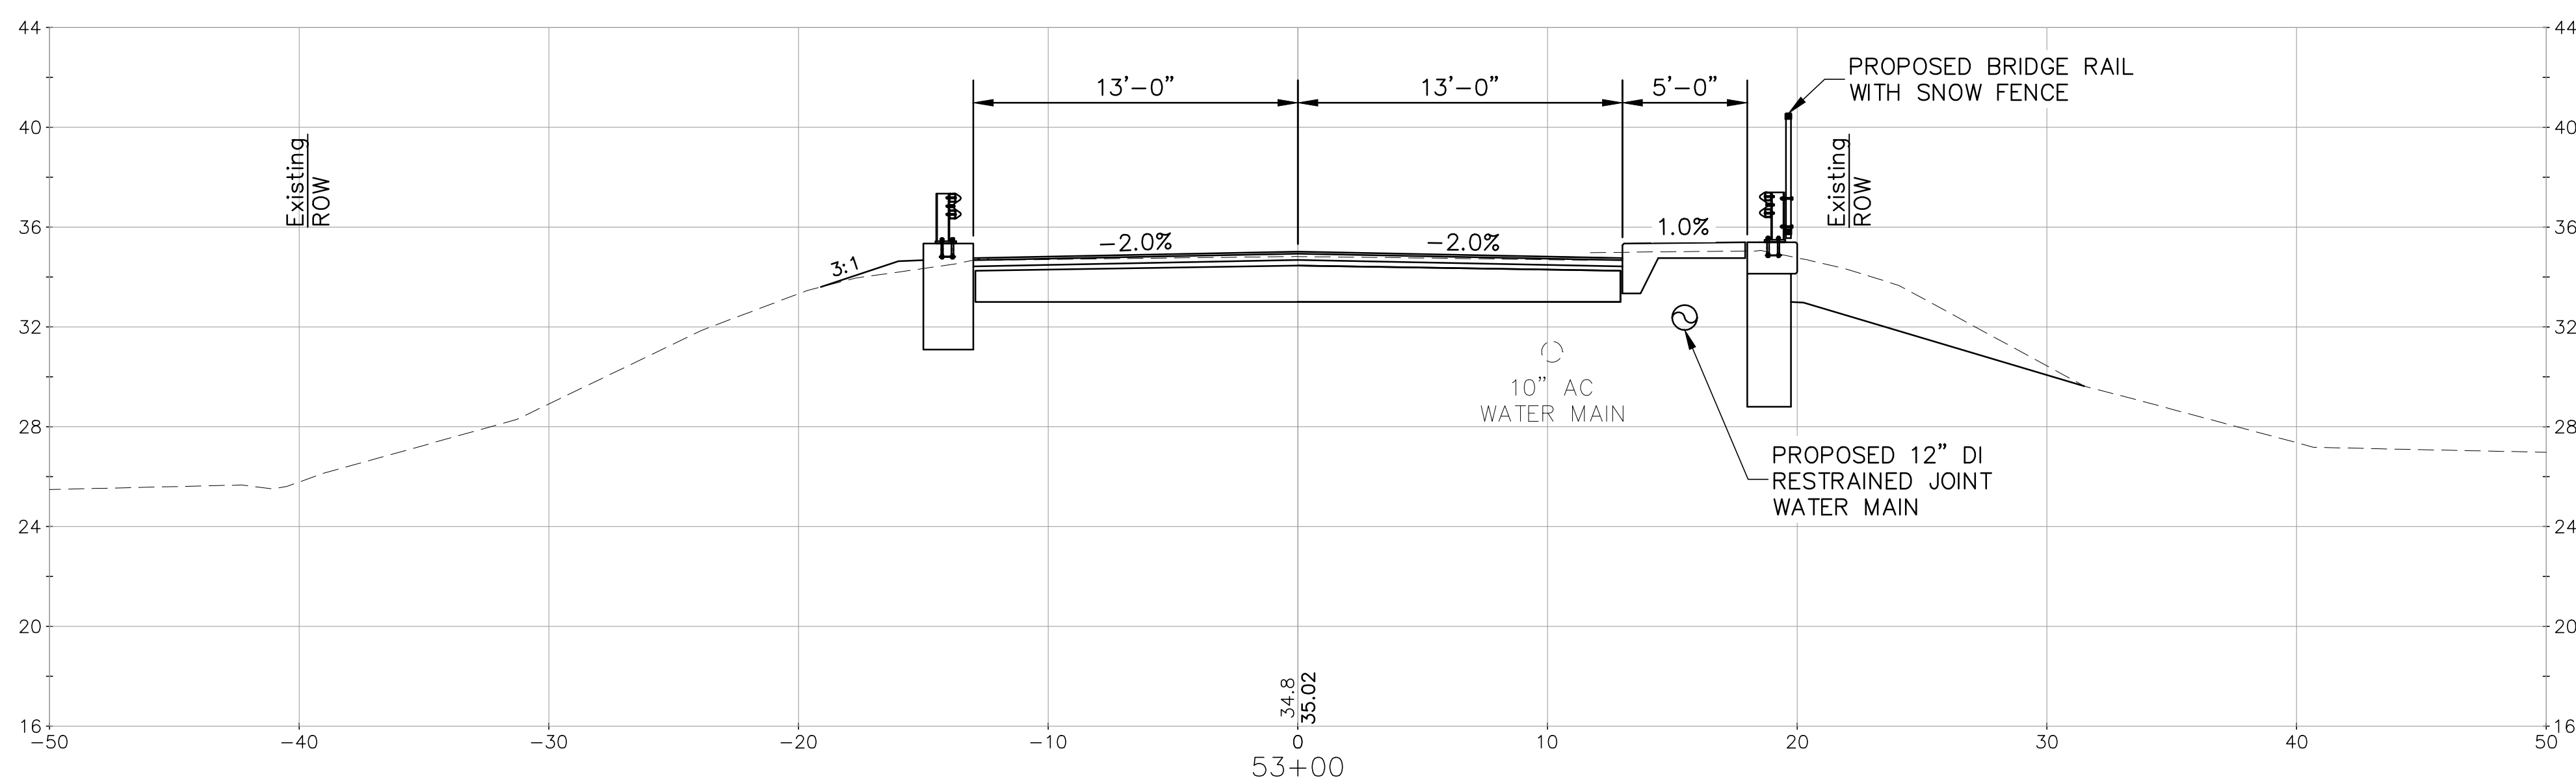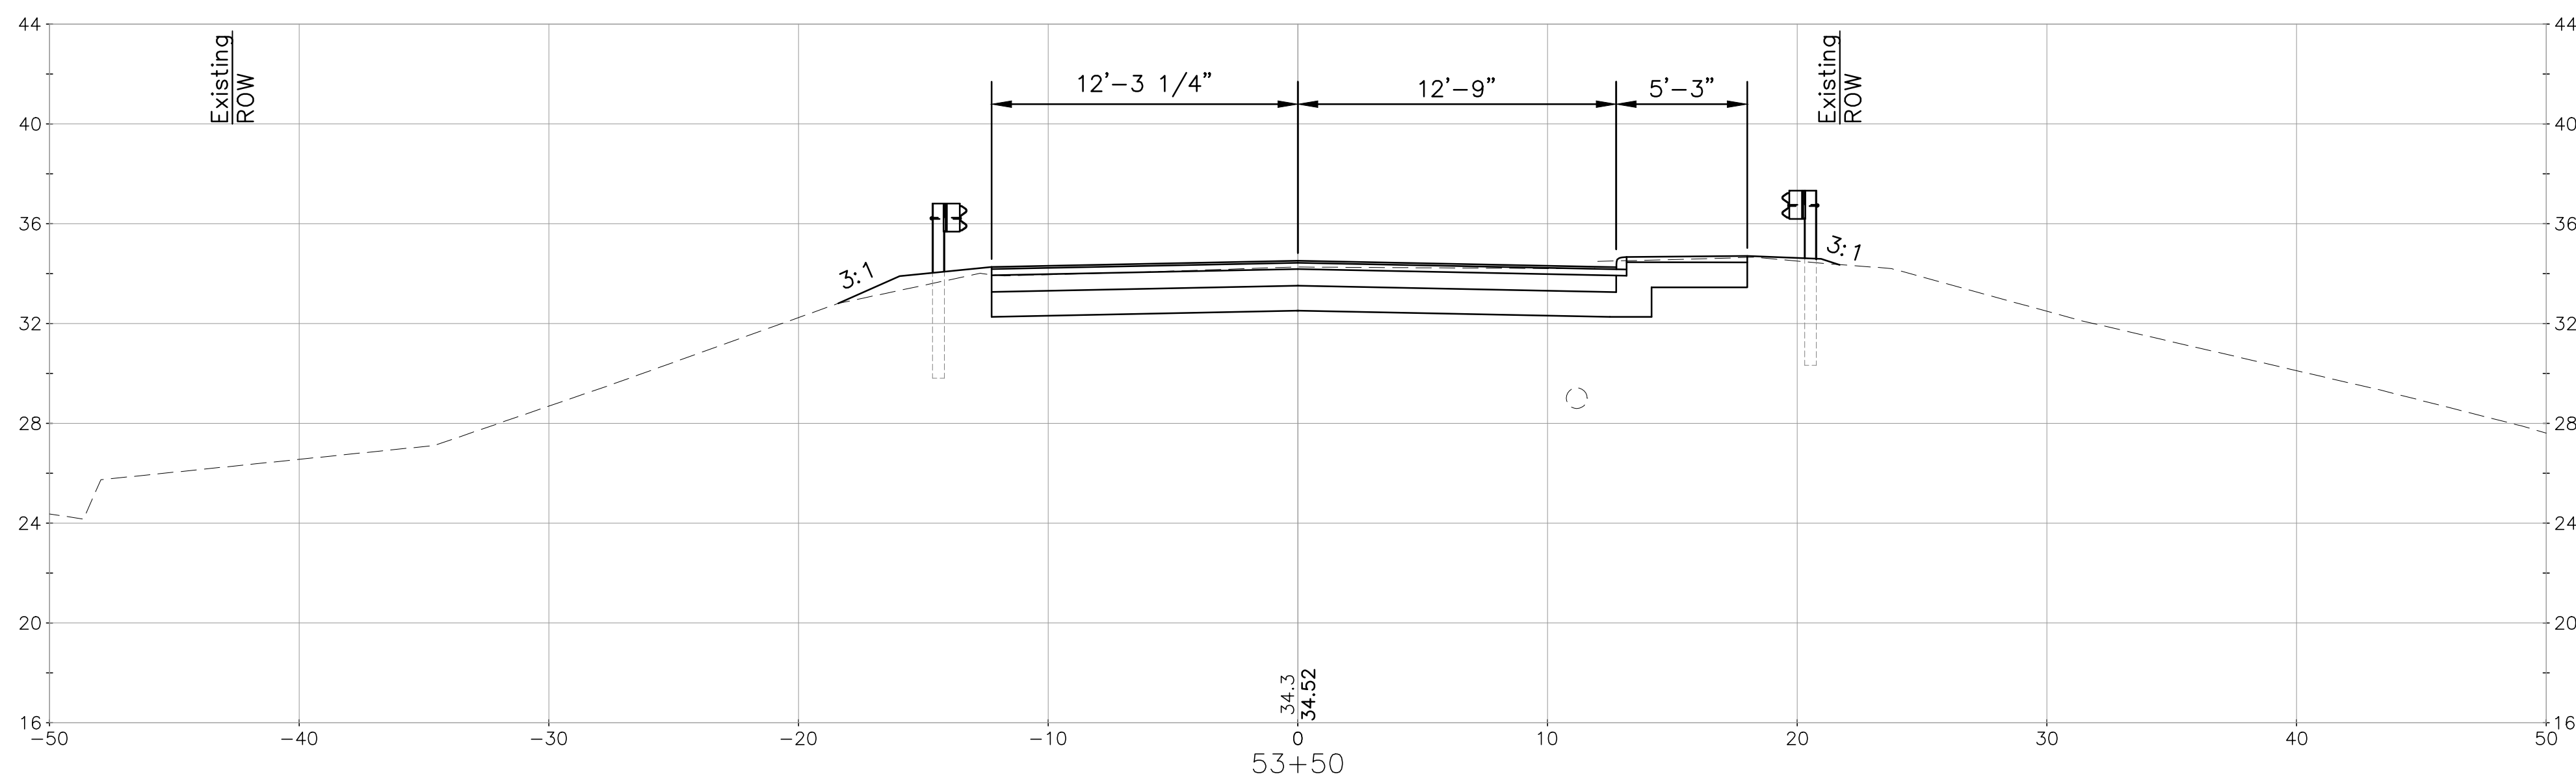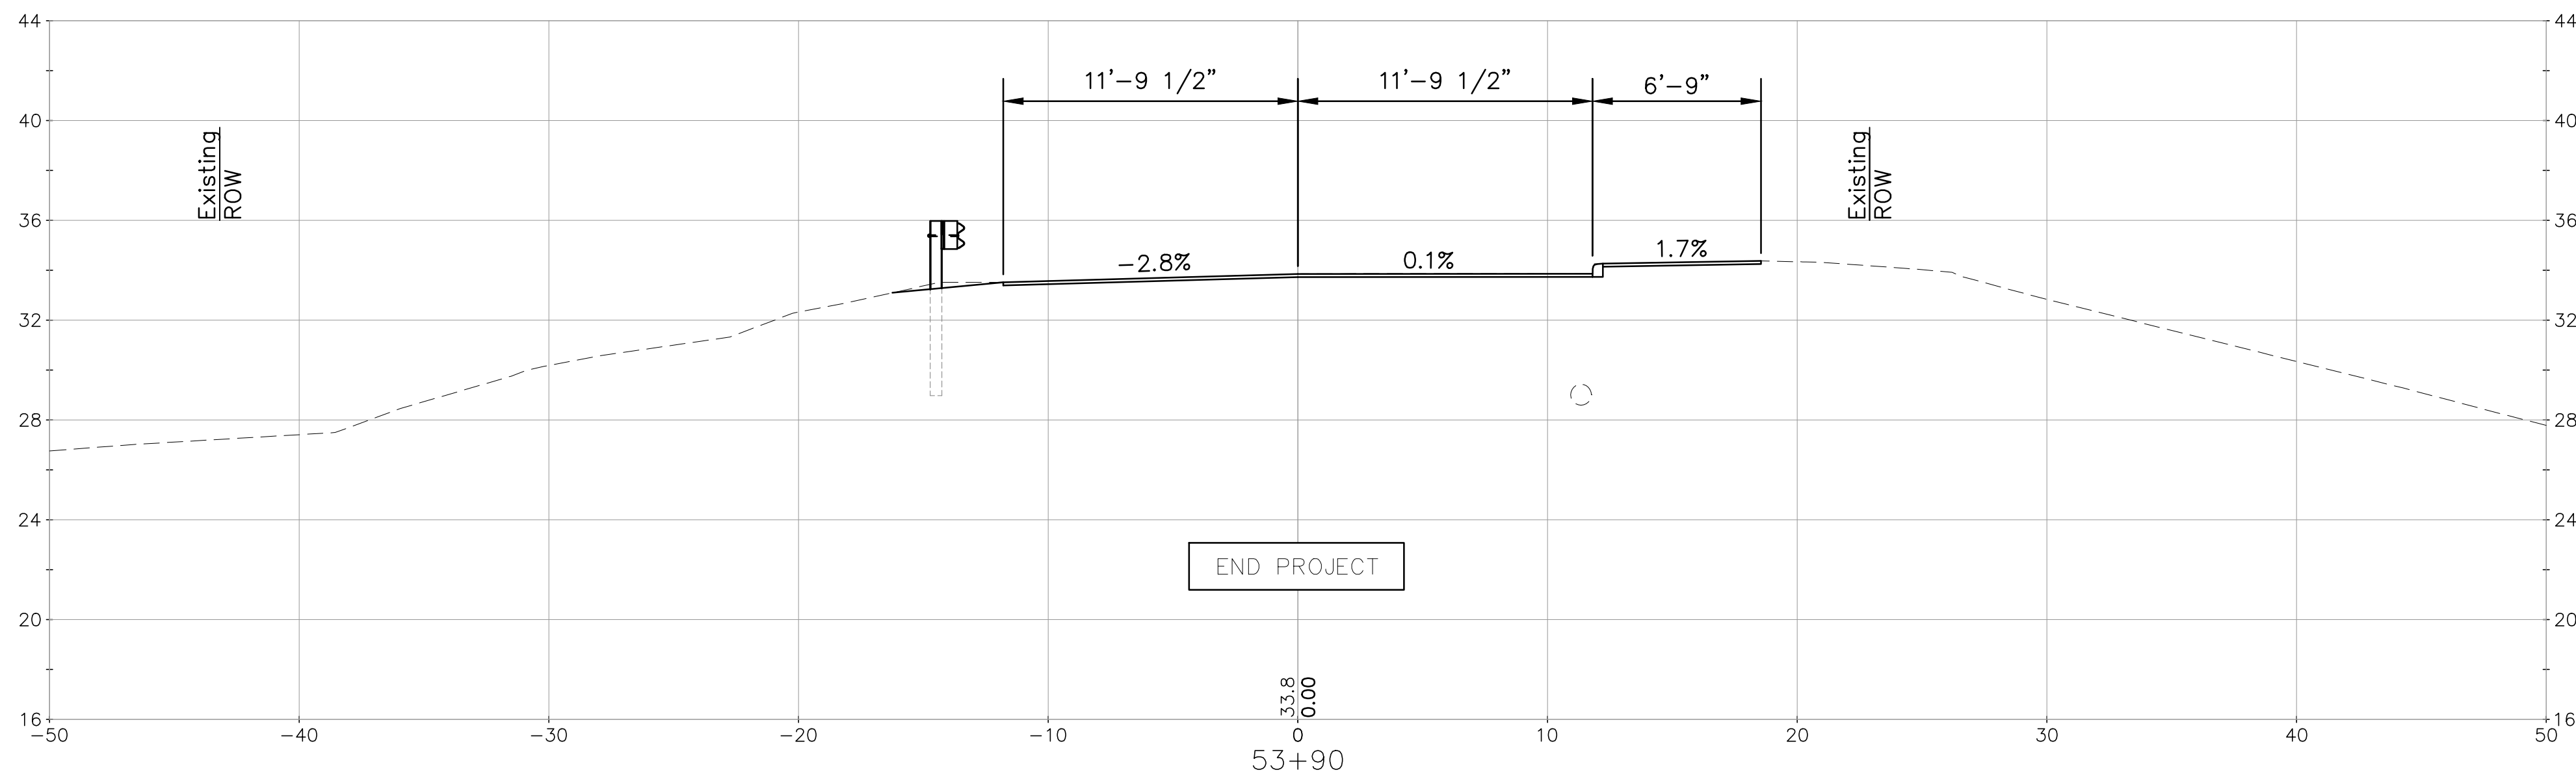

no.	0	AS-BUILT	1/6/16	JLG	by
revision			date		

CMA ENGINEERS
 CIVIL/ENVIRONMENTAL ENGINEERS
 35 Bow Street
 Portsmouth, NH 03801
 603-431-6196
 info@cmaengineers.com
 10 Free Street
 Portland, Maine 04101
 207-541-4223
 www.cmaengineers.com

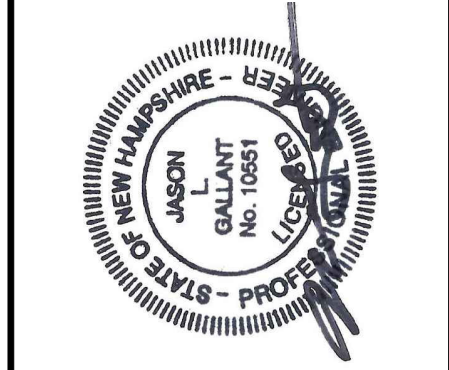

date:	May 2015	designed by:	LBK/OGK
project no:	923	drawn by:	LBK/OGK
file name:	923 - Railway Plans.dwg	approved by:	JLG

Town of Exeter
 Department of Public Works
 Linden Street
 Little River Bridge Replacement
 Cross Sections
 (2 of 2)

drawing no.
R-4

F:\CADD\PROJECTS\923-Exeter Bridges\Production\Linden St\As-Built\923 - Roadway Plans.dwg Date Plotted: Jun 06, 2016 2:33pm Plotted By: LKALLOCH

Water Main Notes:


- WATER MAIN PIPE AND APPURTENANCES SHALL BE NEWLY MANUFACTURED MATERIALS FREE FROM DEFECTS AND BLEMISHES AND SHALL MEET THE LATEST STANDARDS OF THE AMERICAN WATER WORKS ASSOCIATION (AWWA), AS OUTLINED IN THE NEW HAMPSHIRE DEPARTMENT OF ENVIRONMENTAL SERVICES CERTIFIED RULES, ENV-WS 307, TABLE 307-1. APPLICABLE AWWA STANDARDS INCLUDE, BUT ARE NOT LIMITED TO, THE FOLLOWING:
 - C600 (1999 OR LATEST) INSTALLATION OF DUCTILE-IRON MAINS AND THEIR APPURTENANCES
 - C104/A21.4 (2003 OR LATEST) AMERICAN NATIONAL STANDARD FOR CEMENT-MORTAR LINING FOR DUCTILE-IRON PIPE AND FITTINGS FOR WATER
 - C110/A21.10 (2003 OR LATEST) AMERICAN NATIONAL STANDARD FOR DUCTILE-IRON AND GRAY-IRON FITTINGS, 3 IN. THROUGH 48 IN., FOR WATER AND OTHER LIQUIDS
 - C111/A21.11 (2000 OR LATEST) AMERICAN NATIONAL STANDARD FOR RUBBER-GASKET JOINTS FOR DUCTILE-IRON AND GRAY-IRON PRESSURE PIPE AND FITTINGS
 - C116/A21.16 (2003 OR LATEST) AMERICAN NATIONAL STANDARD FOR PROTECTIVE FUSION-BONDED EPOXY COATINGS INTERNAL & EXTERNAL IRON/GRAY-IRON FITTINGS
 - C150/A21.50 (2002 OR LATEST) AMERICAN NATIONAL STANDARD FOR THE THICKNESS DESIGN OF DUCTILE-IRON PIPE
 - C153/A21.53 (2000 OR LATEST) AMERICAN NATIONAL STANDARD FOR DUCTILE-IRON COMPACT FITTINGS, 2 IN. THROUGH 16 IN., FOR WATER AND OTHER LIQUIDS
 - C500 (2002 OR LATEST) GATE VALVES FOR WATER AND SEWERAGE SYSTEMS
 - C502 (1994 OR LATEST) DRY-BARREL FIRE HYDRANTS
 - C503 (1997 OR LATEST) WET-BARREL FIRE HYDRANTS
 - C509 (2001 OR LATEST) RESILIENT-SEATED GATE VALVES FOR WATER AND SEWERAGE SYSTEMS
 - C651-86 (1999 OR LATEST) DISINFECTING WATER MAINS
 - AWWA C600, SECTION 4, OR EQUIVALENT, FOR PRESSURE TESTING WATER MAINS.
- THE EXISTING WATER MAIN IS 10-INCH DIAMETER ASBESTOS CEMENT (A.C.) PIPE. THE CONTRACTOR SHALL FOLLOW ALL PREVAILING HEALTH AND SAFETY STANDARDS FOR CUTTING, REMOVAL AND DISPOSAL OF PORTIONS OF THE AC PIPE THAT ARE TO BE PERMANENTLY REMOVED.
- NEW WATER MAIN SHALL BE BURIED A MINIMUM OF 6'-0" TO TOP OF PIPE AND LAID AT A CONSTANT GRADE. WHERE TOP OF WATER MAIN IS LESS THAN 6'-0" BELOW FINISHED GRADE, THE CONTRACTOR SHALL INSTALL RIGID INSULATION IN CONFORMANCE WITH WATER MAIN TRENCH DETAIL ON SHEET R-6 UNTIL THE WATER MAIN DEPTH IS AT, OR EXCEEDS, 6'-0".
- CONTRACTOR SHALL USE RESTRAINT SYSTEMS ON ALL VALVES AND FITTINGS UNLESS OTHERWISE NOTED ON THE PLANS.
- ALL GATE VALVES SHALL HAVE RESTRAINED MECHANICAL JOINTS AND SHALL OPEN LEFT.
- EXISTING CURB BOXES AND/OR OTHER CASTINGS DISTURBED OR RELOCATED BY CONSTRUCTION ACTIVITIES SHALL BE ADJUSTED TO MATCH FINAL GRADE, UNLESS OTHERWISE DIRECTED BY THE ENGINEER.
- WHERE WATER MAIN IS LESS THAN 6'-0" HORIZONTALLY FROM A STRUCTURE, THE CONTRACTOR SHALL INSTALL 2 INCHES OF RIGID INSULATION ALONG THE SIDE WALL OF THE WATER MAIN TRENCH A MINIMUM OF 10'-0" HORIZONTALLY BEYOND THE CENTERLINE OF THE STRUCTURE IN BOTH DIRECTIONS TO PROTECT THE WATER MAIN FROM FREEZING.

- THE CONTRACTOR SHALL MAINTAIN WATER SERVICE TO RESIDENTS AT ALL TIMES. DISRUPTION OF WATER SERVICE TO RESIDENTS REQUIRES COORDINATION BY THE CONTRACTOR WITH THE TOWN'S PUBLIC WORKS DIRECTOR AND THE ENGINEER AT LEAST 72 HOURS PRIOR TO THE PLANNED INTERRUPTION OF SERVICE.
- THE CONTRACTOR IS RESPONSIBLE FOR TAKING DETAILED MEASUREMENTS OF THE EXACT LOCATION OF ALL BURIED WATER DISTRIBUTION PIPING AND APPURTENANCES INSTALLED BY THE CONTRACTOR INCLUDING PIPE, GATE VALVES, TRANSITION FITTINGS, BENDS, AND SHALL RECORD THE MEASUREMENTS ON AS-BUILT PLANS OR RECORD DRAWINGS. THE AS BUILT PLANS OR RECORD DRAWINGS OF THE WATER DISTRIBUTION PIPING AND APPURTENANCES SHALL INCLUDE THE FOLLOWING INFORMATION:
 - PRECISELY-MEASURED DIMENSIONS TO ALL TRANSITION FITTINGS;
 - PRECISELY-MEASURED DIMENSIONS TO ALL "ON-LINE" GATE VALVES;
 - PRECISELY-MEASURED DIMENSIONS TO ALL BENDS AND/OR PRINCIPAL CHANGES IN PIPE DIRECTION;

NOTE: "PRECISELY-MEASURED" MEANS OF SUFFICIENT ACCURACY TO LOCATE THE PIPING OR APPURTENANCE TO WITHIN 1 FOOT ACCURACY, RECORDED TO THE NEAREST 0.5 FOOT.
- THE CONTRACTOR SHALL SUPPLY THE TOWN OF EXETER WITH ONE ORIGINAL AND ONE COPY OF THE AS-BUILT PLAN OR RECORD DRAWING OF THE NEW WATER DISTRIBUTION PIPING INSTALLATION.
- CONTRACTOR SHALL FLUSH AND CHLORINATE THE NEW WATER DISTRIBUTION PIPING SYSTEM BEFORE ACTIVATING INTO SERVICE. THE NEW WATER DISTRIBUTION PIPES AND APPURTENANCES SHALL BE FLUSHED TO REMOVE ANY DIRT OR OTHER CONTAMINANTS, AND TESTED PER THE TOWN OF EXETER REQUIREMENTS AS SPECIFIED IN SPECIAL PROVISION 611.3.12 - PRESSURE AND LEAKAGE TESTING OF THE TECHNICAL SPECIFICATIONS.
- THE CONTRACTOR SHALL PERFORM A LEAKAGE TEST OF THE NEW PIPING SYSTEM BEFORE SYSTEM USE. THE DISTRIBUTION SYSTEM SHALL BE CHECKED FOR LEAKAGE BY CONDUCTING A SUSTAINED PRESSURE TEST PER THE TOWN OF EXETER REQUIREMENTS AS SPECIFIED IN SPECIAL PROVISION 611.3.13 - DISINFECTION OF THE TECHNICAL SPECIFICATIONS.


Insulated Pipe Notes:

- DUCTILE IRON PIPE SHALL BE TR FLEX, RESTRAINED JOINT PIPE WITH 2.16" OF CLOSED CELL POLYURETHANE INSULATION WRAPPED IN A SEAMLESS, HDPE JACKET. NO TAPE CASINGS WILL BE ALLOWED
- PIPING AND INSULATION SHALL BE INSTALLED PER MANUFACTURERS RECOMMENDATIONS.
- ALL FITTINGS SHALL HAVE RESTRAINED, MECHANICAL JOINTS AND INSULATED WITH FIELD APPLIED INSULATION COVERS.
- NO PIPING SHALL BE INSTALLED IN STANDING WATER. TRENCHES SHALL BE MAINTAINED DRY UNTIL FINAL FIELD CLOSURE IS COMPLETE.

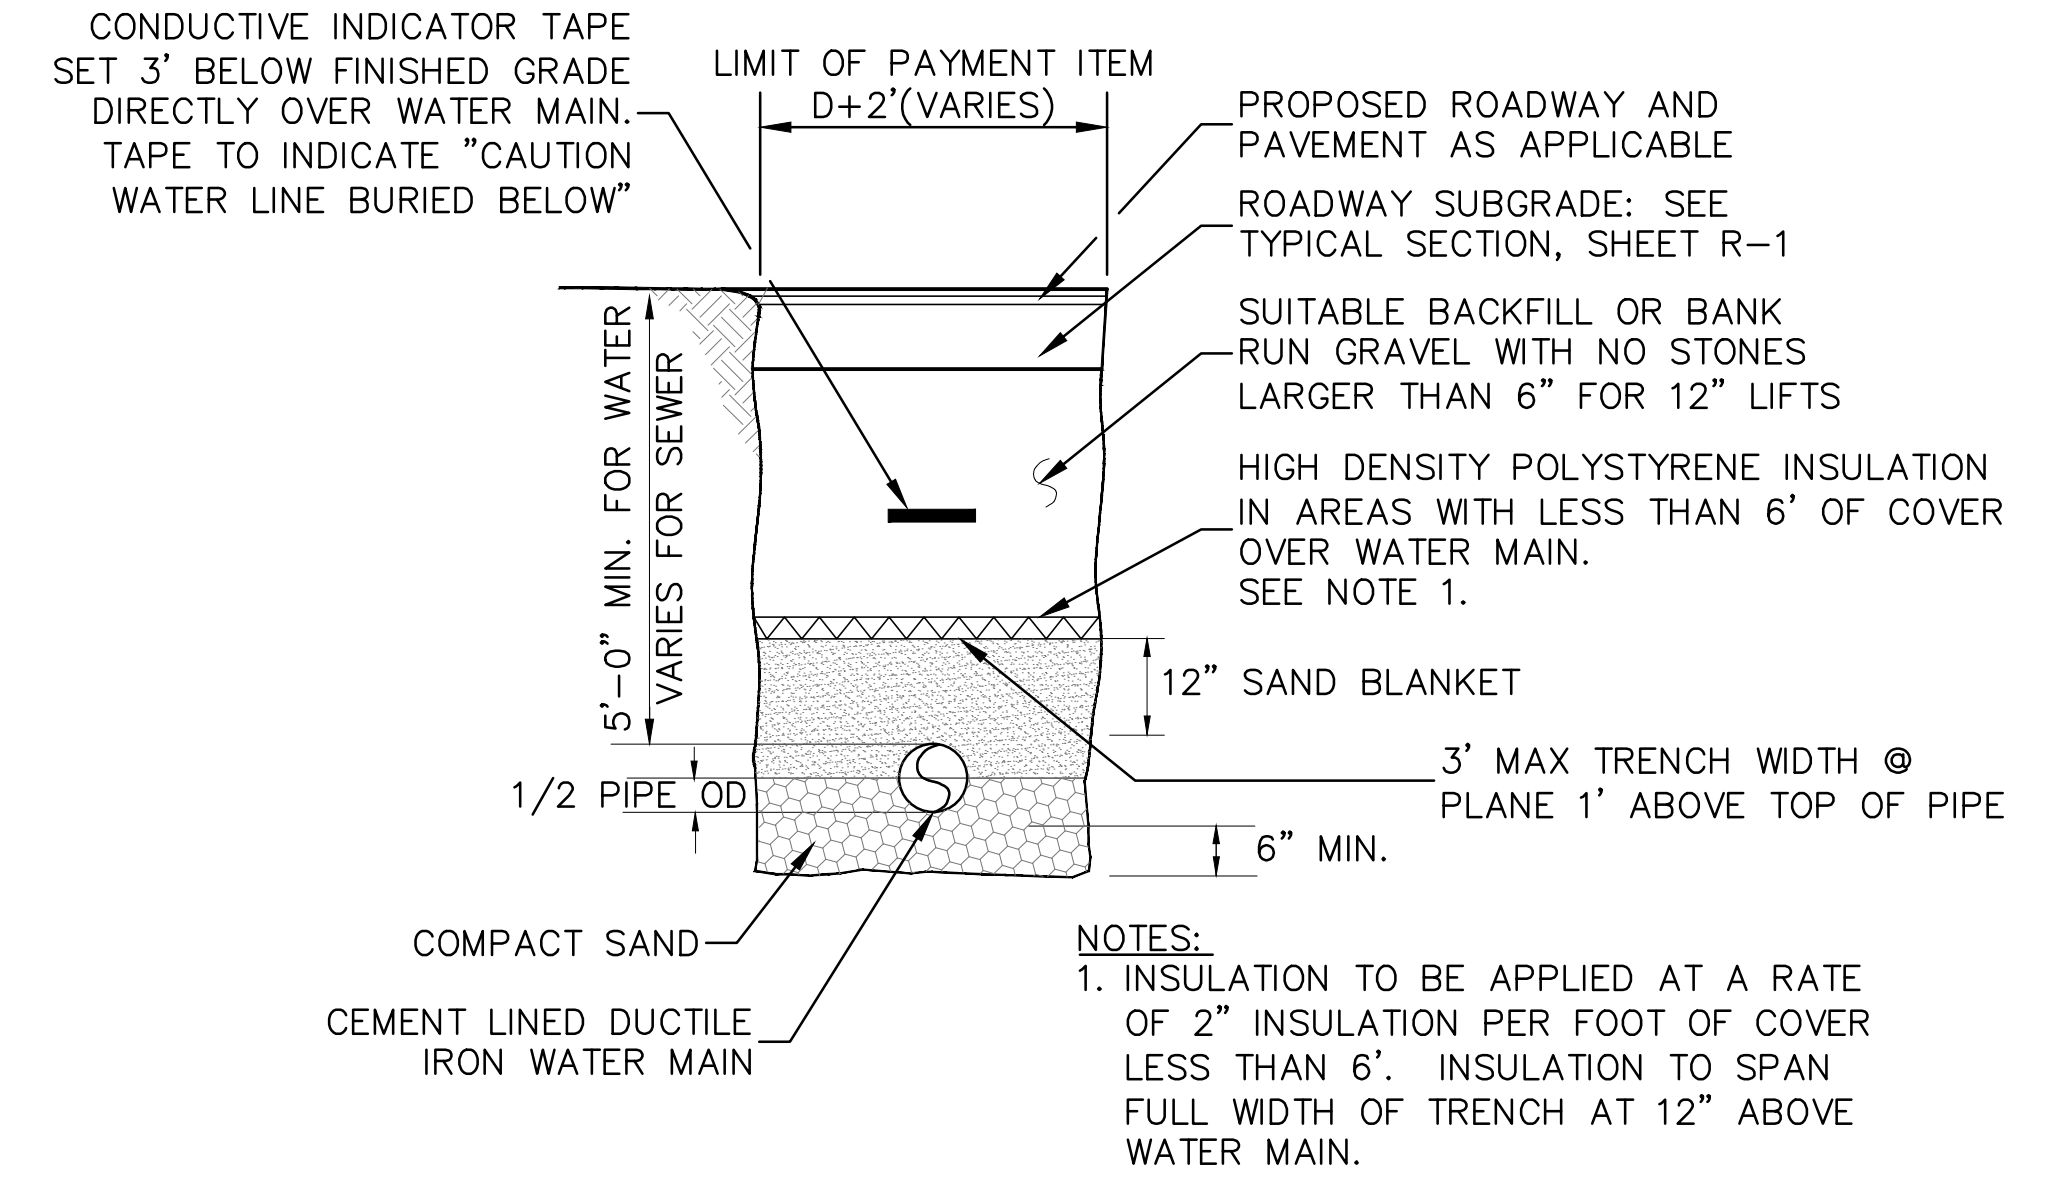


Water Main Trench Detail

Not to Scale

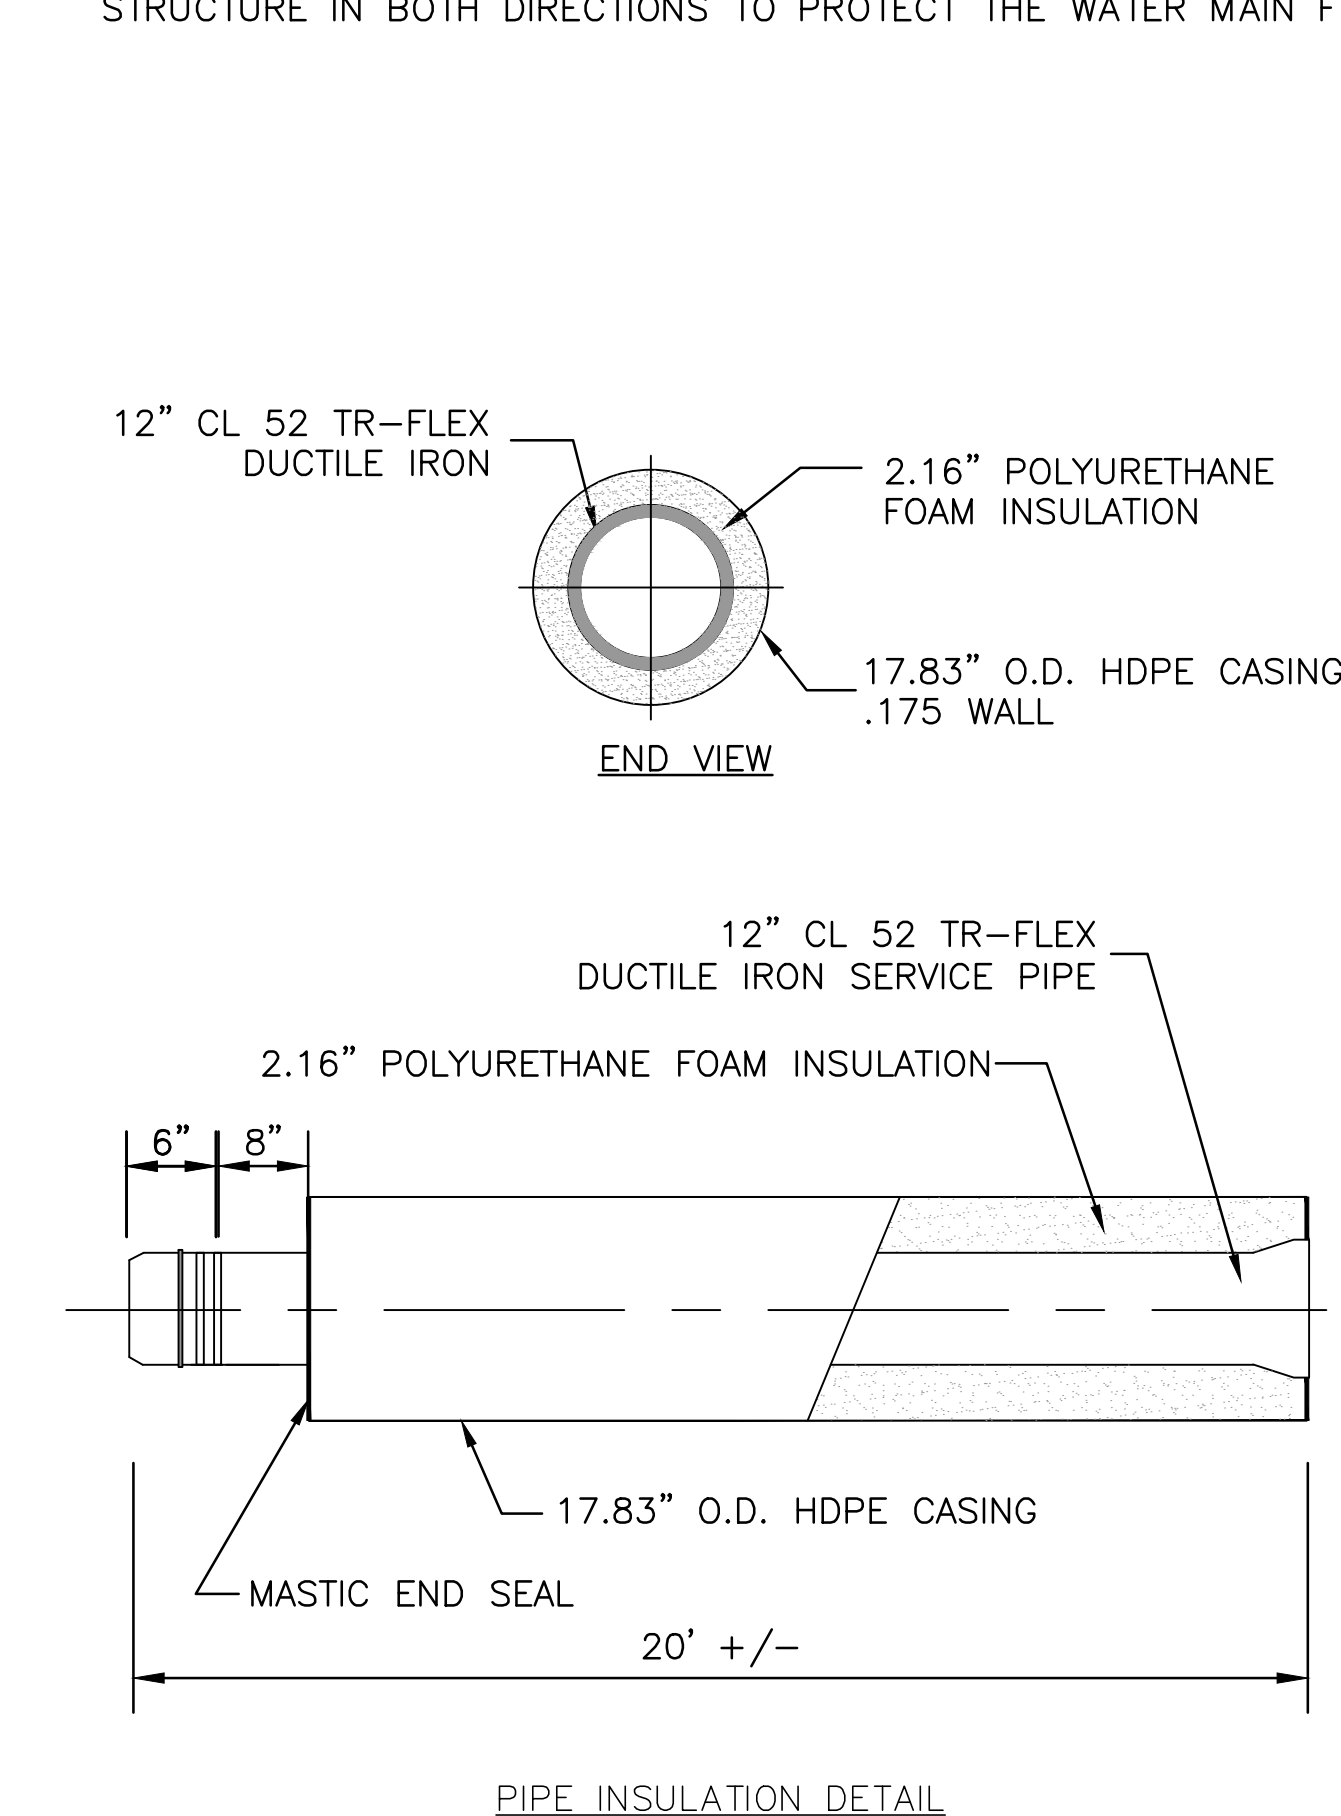


PIPE INSULATION DETAIL

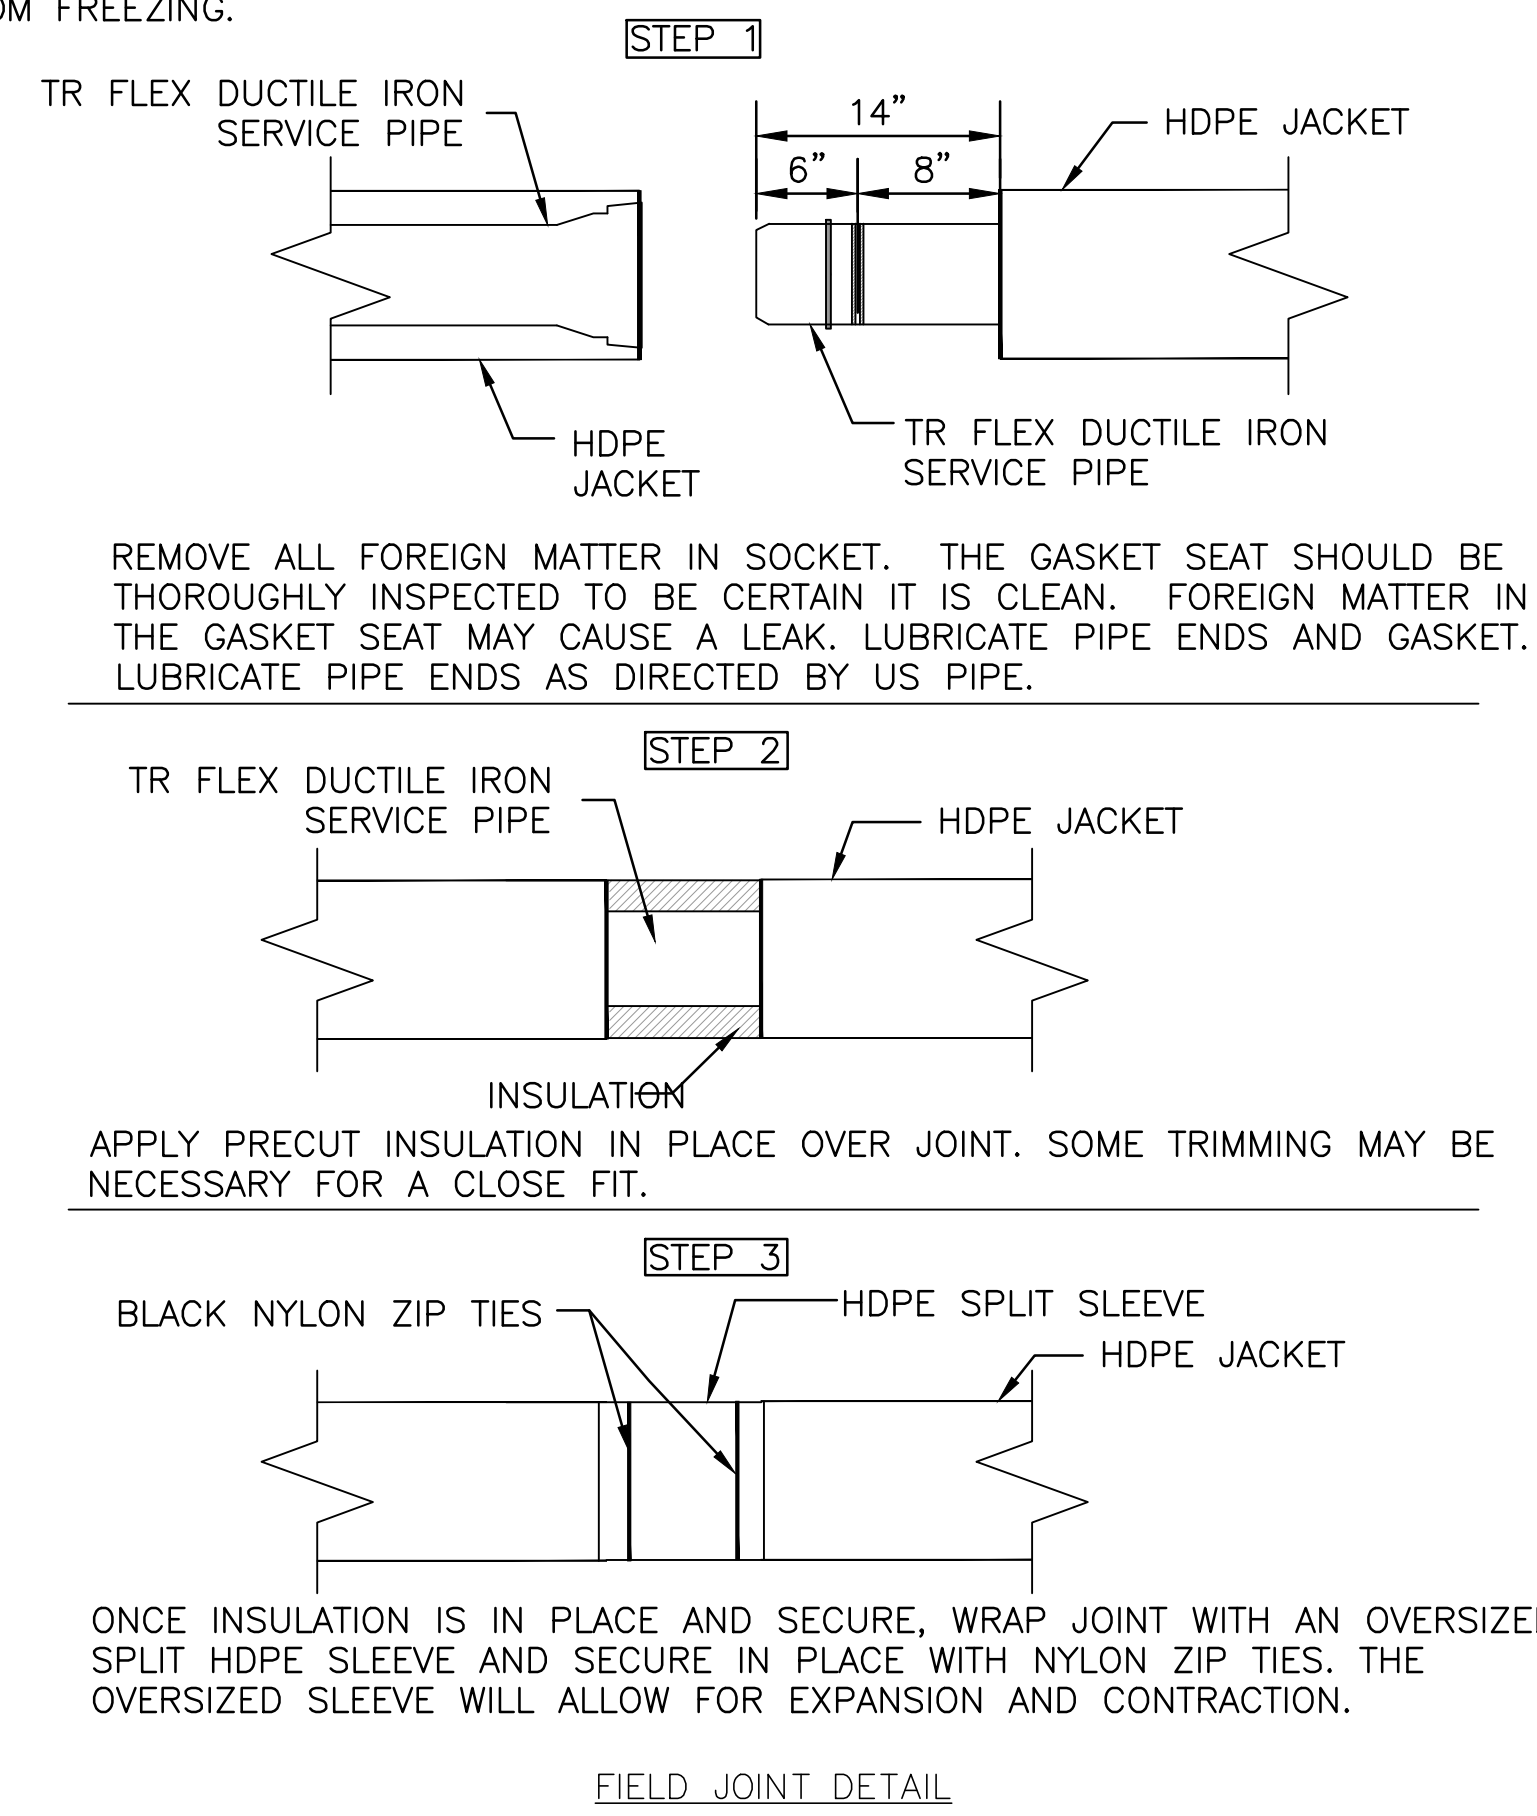

FIELD JOINT DETAIL

Water Main Pipe Insulation Details

Not to Scale

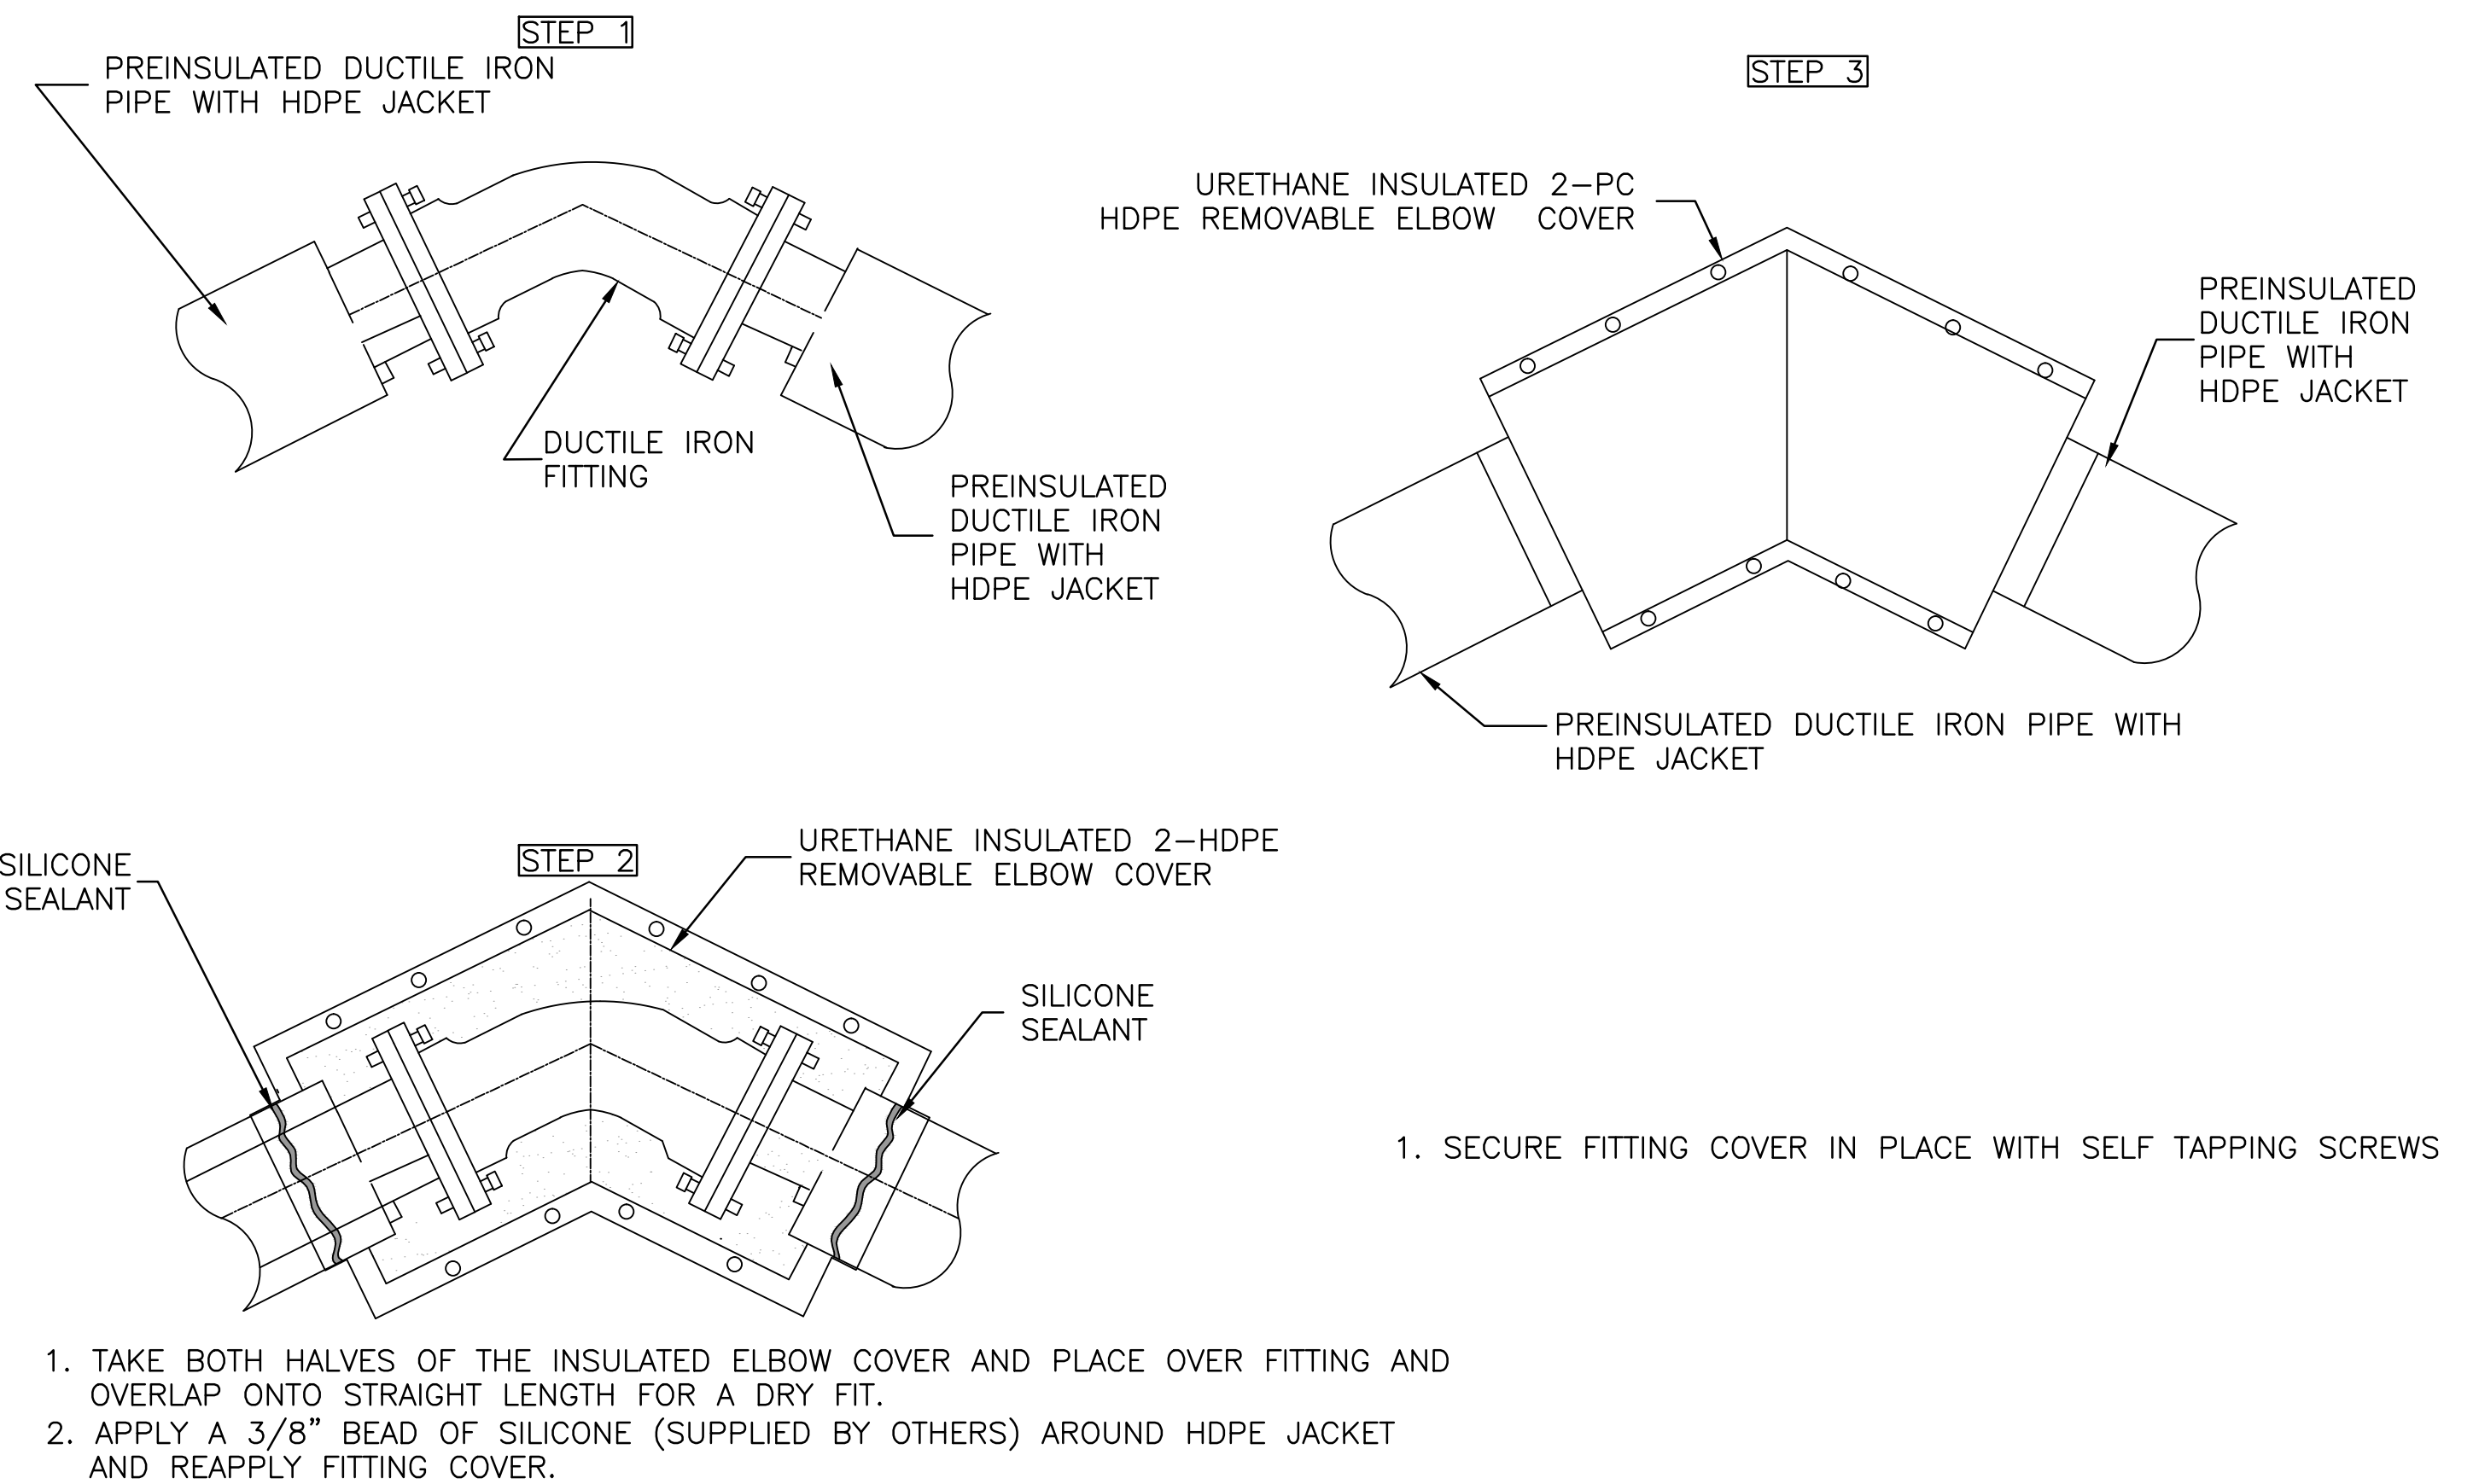


FIELD APPLIED FITTING COVER DETAIL

designed by: LBK/OGK	date: May 2015	file name: 923-R-Details.dwg	scale: 1" = 20'
drawn by: LBK/OGK	project no: 923	scale: 1" = 20'	scale: 1" = 20'
approved by: JLG	revision:	revision:	revision:
no.:	no.:	no.:	no.:
AS-BUILT	1/6/16	JLG	by
0	date		


CMA ENGINEERS
 CIVIL/ENVIRONMENTAL ENGINEERS
 10 Fire Street Portland, Maine 04101 207.541-4223
 35 Bow Street Portsmouth, NH 03801 603.627-0708
 55 So. Commercial Street Manchester, NH 03101 603.627-0708
 info@cmaengineers.com www.cmaengineers.com

TOWN OF EXETER
 DEPARTMENT OF PUBLIC WORKS
 LINDEN STREET
 LITTLE RIVER BRIDGE REPLACEMENT
 ROAD AND UTILITY DETAILS


drawing no.
R-5
 sheet: 27 of 29

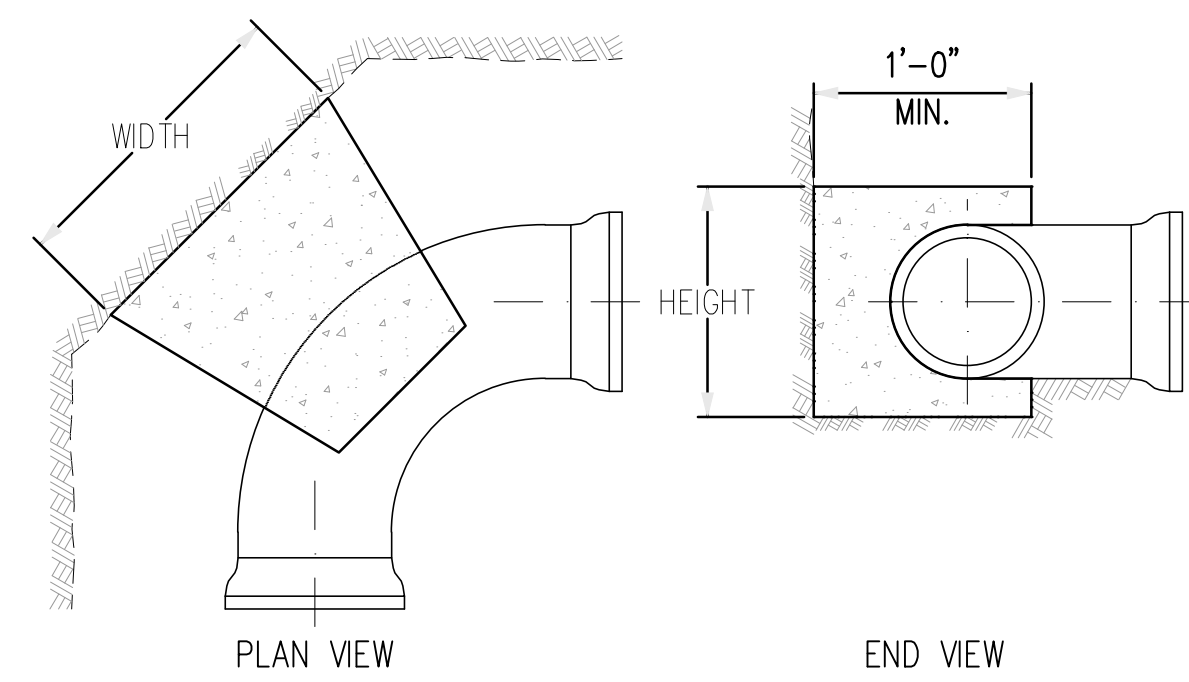


90° BEND THRUST BLOCK DIMENSIONING					
PIPE SIZE	WIDTH (FT-IN)	HEIGHT (FT-IN)	PIPE SIZE	WIDTH (FT-IN)	HEIGHT (FT-IN)
4 NPS	2'-3"	1'-3"	14 NPS	7'-3"	3'-6"
6 NPS	3'-3"	1'-9"	16 NPS	8'-3"	4'-0"
8 NPS	4'-3"	2'-3"	18 NPS	9'-3"	4'-6"
10 NPS	5'-3"	2'-6"	20 NPS	10'-6"	5'-0"
12 NPS	6'-0"	3'-3"	24 NPS	12'-6"	6'-0"

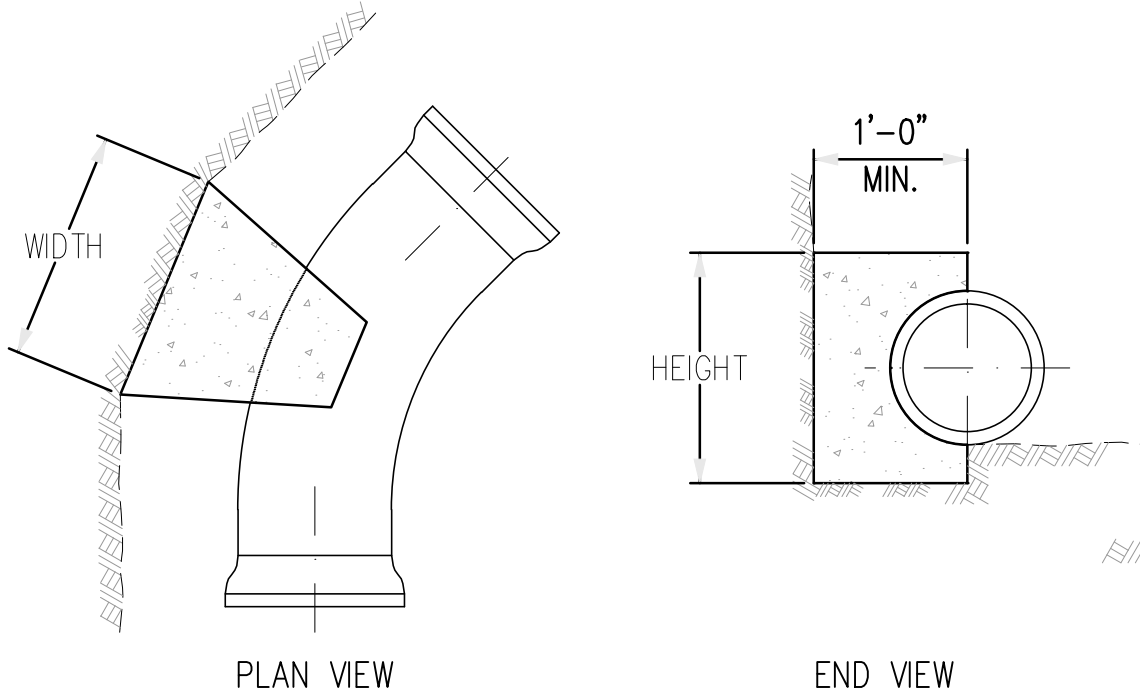


45° BEND THRUST BLOCK DIMENSIONING					
PIPE SIZE	WIDTH (FT-IN)	HEIGHT (FT-IN)	PIPE SIZE	WIDTH (FT-IN)	HEIGHT (FT-IN)
4 NPS	2'-0"	0'-9"	14 NPS	5'-3"	2'-6"
6 NPS	2'-6"	1'-3"	16 NPS	5'-6"	3'-3"
8 NPS	3'-3"	1'-9"	18 NPS	7'-3"	3'-3"
10 NPS	4'-0"	2'-0"	20 NPS	7'-3"	4'-0"
12 NPS	4'-6"	2'-3"	24 NPS	8'-9"	4'-6"

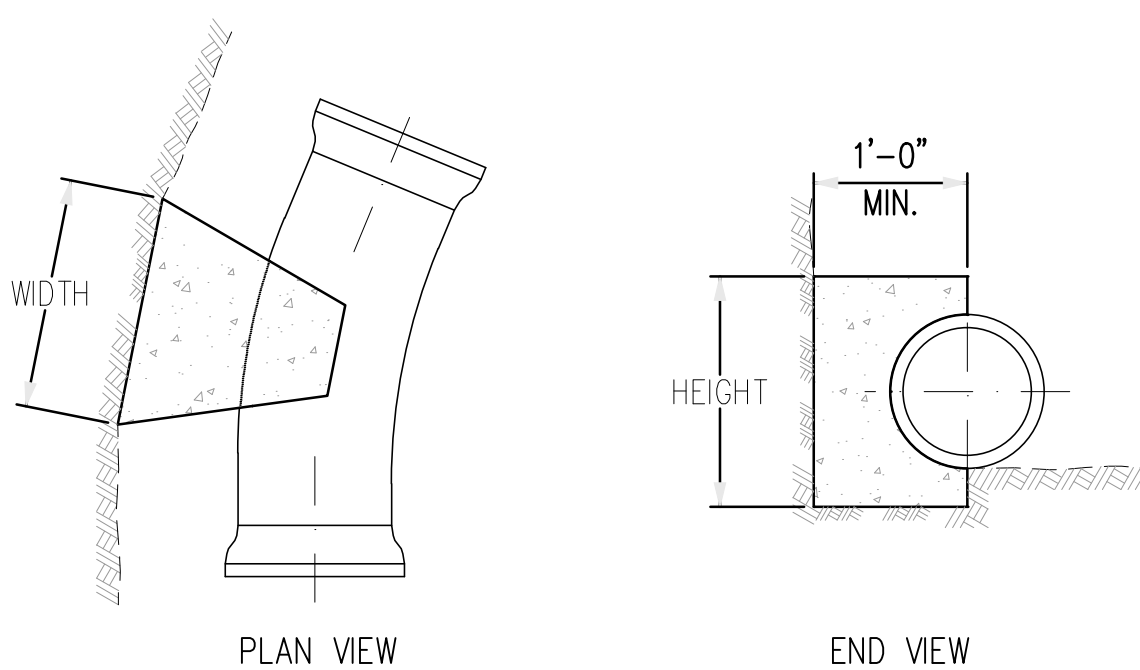


22 1/2° BEND THRUST BLOCK DIMENSIONING					
PIPE SIZE	WIDTH (FT-IN)	HEIGHT (FT-IN)	PIPE SIZE	WIDTH (FT-IN)	HEIGHT (FT-IN)
4 NPS	1'-3"	0'-9"	14 NPS	3'-6"	2'-0"
6 NPS	2'-0"	0'-9"	16 NPS	4'-6"	2'-3"
8 NPS	2'-3"	1'-3"	18 NPS	5'-0"	2'-6"
10 NPS	3'-0"	1'-3"	20 NPS	5'-0"	3'-0"
12 NPS	3'-3"	1'-9"	24 NPS	6'-3"	3'-3"

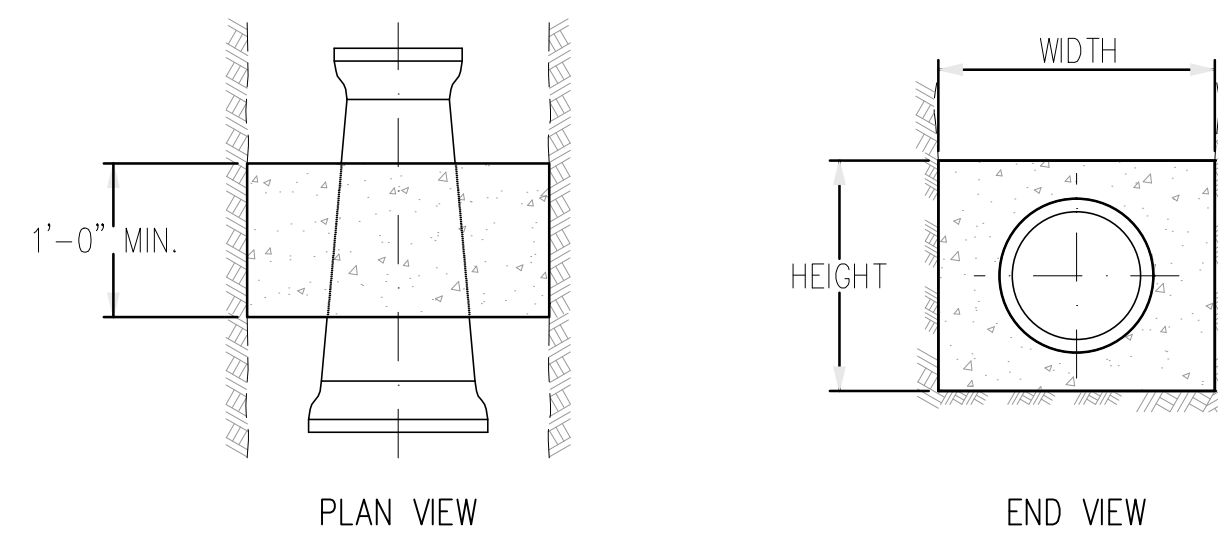

REDUCER THRUST BLOCK DIMENSIONING					
SIZE	WIDTH (FT-IN)	HEIGHT (FT-IN)	SIZE	WIDTH (FT-IN)	HEIGHT (FT-IN)
6x4 NPS	1'-6"	1'-6"	16x8 NPS	4'-6"	4'-6"
8x4 NPS	2'-3"	2'-3"	16x10 NPS	4'-0"	4'-0"
8x6 NPS	1'-9"	1'-9"	16x12 NPS	3'-6"	3'-6"
10x6 NPS	2'-6"	2'-6"	20x12 NPS	5'-0"	5'-0"
10x8 NPS	2'-0"	2'-0"	20x16 NPS	4'-0"	4'-0"
12x6 NPS	3'-3"	3'-3"	24x12 NPS	6'-6"	6'-6"
12x8 NPS	3'-0"	3'-0"	24x16 NPS	5'-9"	5'-9"
12x10 NPS	2'-3"	2'-3"	24x20 NPS	4'-6"	4'-6"

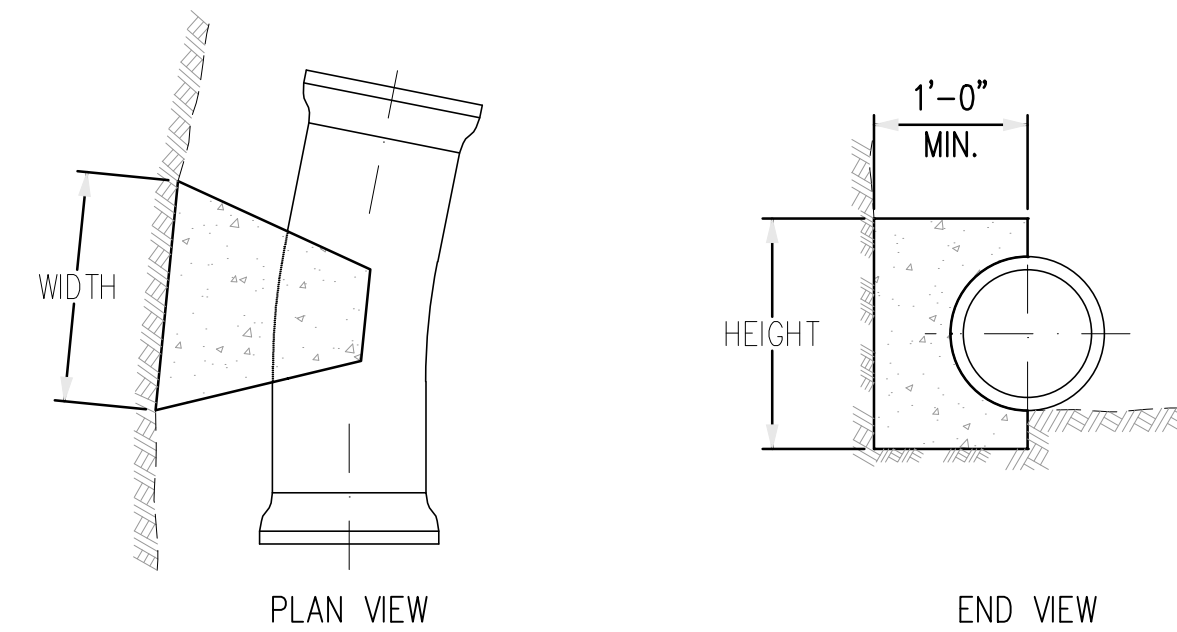

11 1/4° BEND THRUST BLOCK DIMENSIONING					
PIPE SIZE	WIDTH (FT-IN)	HEIGHT (FT-IN)	PIPE SIZE	WIDTH (FT-IN)	HEIGHT (FT-IN)
4 NPS	1'-0"	0'-6"	14 NPS	3'-0"	1'-3"
6 NPS	1'-3"	0'-9"	16 NPS	3'-3"	1'-9"
8 NPS	1'-9"	0'-9"	18 NPS	3'-6"	1'-9"
10 NPS	2'-0"	1'-0"	20 NPS	3'-6"	2'-0"
12 NPS	2'-3"	1'-3"	24 NPS	4'-6"	2'-3"

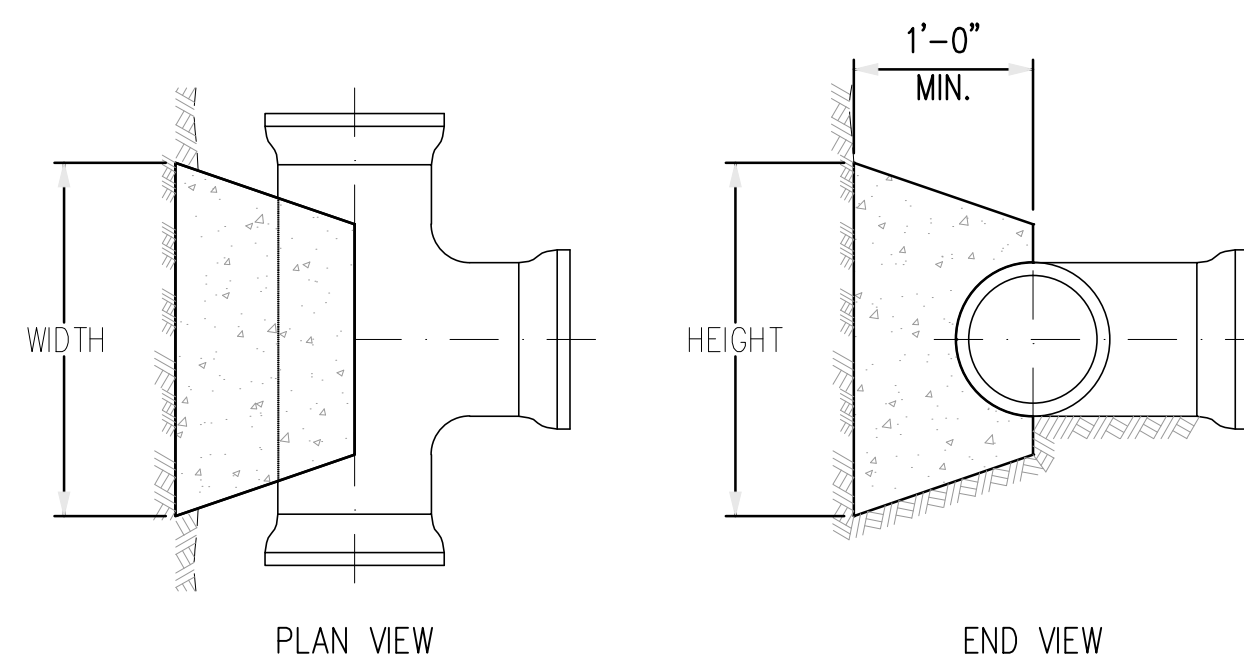


TEE/DEAD END THRUST BLOCK DIMENSIONING					
PIPE SIZE	WIDTH (FT-IN)	HEIGHT (FT-IN)	PIPE SIZE	WIDTH (FT-IN)	HEIGHT (FT-IN)
4 NPS	2'-0"	1'-0"	14 NPS	5'-6"	3'-3"
6 NPS	3'-0"	1'-3"	16 NPS	6'-6"	3'-6"
8 NPS	3'-3"	2'-0"	18 NPS	7'-6"	4'-0"
10 NPS	4'-3"	2'-3"	20 NPS	8'-6"	4'-3"
12 NPS	5'-3"	2'-6"	24 NPS	10'-3"	5'-3"

HORIZONTAL THRUST BLOCKS-MINIMUM RESTRAINED LENGTH OF PIPE (FT-IN) L _R										
FITTING	4 NPS	6 NPS	8 NPS	10 NPS	12 NPS	14 NPS	16 NPS	18 NPS	20 NPS	24 NPS
11 n BEND	1'-3"	2'-0"	2'-6"	3'-0"	3'-6"	4'-0"	4'-6"	5'-0"	5'-6"	6'-3"
22 n BEND	1'-3"	2'-0"	2'-6"	3'-0"	3'-6"	4'-0"	4'-6"	5'-0"	5'-6"	6'-6"
45n BEND	3'-0"	4'-0"	5'-3"	6'-3"	7'-6"	8'-6"	9'-6"	10'-6"	11'-6"	13'-6"
90n BEND	7'-0"	9'-9"	12'-6"	15'-6"	18'-0"	20'-0"	23'-0"	25'-6"	28'-0"	32'-6"
DEAD END	8'-6"	12'-6"	16'-0"	19'-3"	23'-0"	26'-0"	29'-6"	33'-0"	36'-0"	42'-0"

NOTE: PVC PIPE WILL TYPICALLY HAVE SLIGHTLY GREATER RESTRAINED LENGTH
NOTE: FOR POLYETHYLENE WRAPPED PIPE, MULTIPLY VALUES IN TABLE BY 1.45

MINIMUM GRAVITY BLOCK VOLUMES FOR VERTICAL BENDS (CU.FT.)										
FITTING	4 NPS	6 NPS	8 NPS	10 NPS	12 NPS	14 NPS	16 NPS	18 NPS	20 NPS	24 NPS
11 1/4°	4	11	18	25	35	46	60	74	92	131
22 1/2°	11	18	32	49	67	92	120	148	184	261
45°	18	35	64	95	134	180	233	293	360	512
90°	32	67	117	177	247	332	431	540	664	950

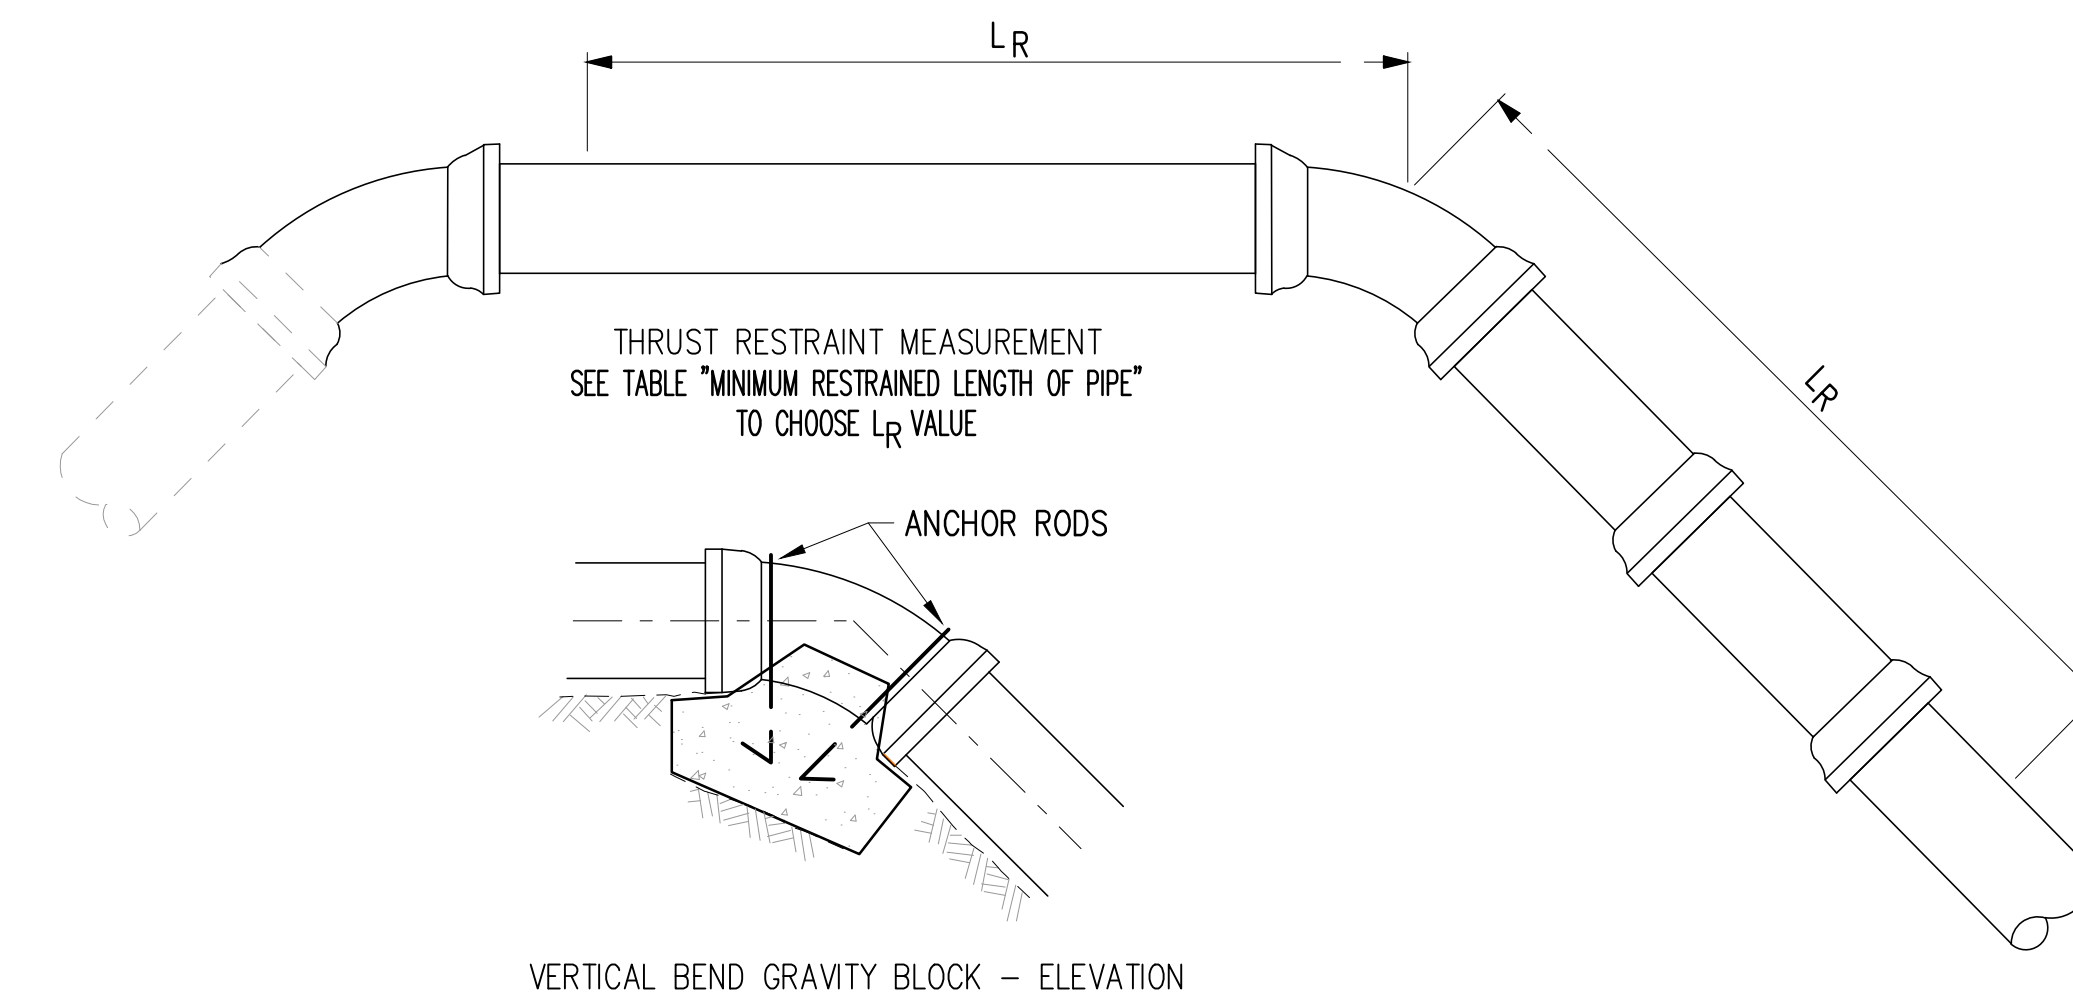

MINIMUM RESTRAINED LENGTH OF PIPE (L) FOR VERTICAL BENDS											
VERTICAL UPWARD BENDS - NPS (FT.)											
FITTING	4 NPS	6 NPS	8 NPS	10 NPS	12 NPS	14 NPS	16 NPS	18 NPS	20 NPS	24 NPS	
11 1/4°	1.5	2.0	3.0	3.0	4.0	4.0	5.0	5.0	6.0	6.5	
22 1/2°	1.5	2.0	3.0	3.0	4.0	4.0	5.0	5.0	6.0	7.0	
45°	3.0	4.0	5.5	6.5	8.0	9.0	10.0	10.5	11.5	13.5	
90°	7.0	10.0	12.5	15.5	18.5	20.5	23.0	26.0	28.0	32.5	
VERTICAL DOWNWARD BENDS - NPS (FT.)											
FITTING	4 NPS	6 NPS	8 NPS	10 NPS	12 NPS	14 NPS	16 NPS	18 NPS	20 NPS	24 NPS	
11 1/4°	3.5	5.0	6.5	8.0	9.5	10.5	12.0	13.0	14.5	17.0	
22 1/2°	7.0	10.0	13.0	15.5	18.5	21.0	24.0	26.5	29.0	34.0	
45°	14.5	20.5	27.0	32.5	38.5	44.0	49.0	54.5	60.0	70.0	
90°	35.0	49.5	64.0	78.0	92.0	105.0	118.5	131.5	144.5	169.0	

NOTE: FOR POLYETHYLENE WRAPPED PIPE, MULTIPLY VALUES IN TABLE BY 1.45
NOTE: FOR PVC PIPE MULTIPLY VALUES IN TABLE BY 1.15

ANCHOR ROD SCHEDULE FOR GRAVITY BLOCKS		
PIPE SIZE	RODS	MIN. EMBEDMENT LENGTH
4 NPS	1 - (3)	6"
6 NPS	1 - (3)	6"
8 NPS	2 - (4)	6"
10 NPS	2 - (4)	6"
12 NPS	2 - (5)	7"
14 NPS	2 - (6)	8"
16 NPS	2 - (6)	8"
18 NPS	2 - (7)	10"
20 NPS	2 - (8)	11"
24 NPS	2 - (9)	12"

NUMBERS IN PARENTHESIS ARE BAR SIZES MARKED IN EIGHTHS OF INCHES

THRUST BLOCK NOTES:

- SEE SPECIAL PROVISION 611 - WATER MAIN INSTALLATION FOR ADDITIONAL INFORMATION ON THRUST RESTRAINT REQUIREMENTS.
- THRUST RESTRAINT USING THRUST BLOCKS OR RESTRAINED LENGTHS ARE SHOWN ON THESE SHEETS. THRUST BLOCKS, RESTRAINED JOINTS USING THE RODS OR RETAINER GLANDS ARE ALL ACCEPTABLE METHODS; HOWEVER, THE THRUST RESTRAINT METHOD SELECTED SHALL BE APPROVED BY THE ENGINEER.
- IF THE OWNER OF THE WATER SYSTEM ALLOWS A METHOD THAT RESTRAINS INDIVIDUAL JOINTS, EACH JOINT THAT FALLS WITHIN THE MINIMUM RESTRAINED LENGTH, MEASURED FROM THE CENTER OF THE FITTING, AS SHOWN ON THESE SHEETS SHALL BE RESTRAINED, AND SHALL WITHSTAND THE MAXIMUM PRESSURE APPLIED TO THE SYSTEM.
- CLASS B CONCRETE SHALL NOT BE PLACED UNDERWATER. THE CONTRACTOR SHALL DEWATER THE EXCAVATION TO INSTALL THE THRUST BLOCKS IN THE DRY.
- CONCRETE FOR THRUST BLOCKS SHALL NOT BE ALLOWED TO COVER OR INTERFERE WITH JOINT OR RESTRAINT HARDWARE. PLASTIC SHEETING OR BUILDING FELT MAY BE PLACED OVER PIPE OR FITTINGS TO PREVENT CONCRETE FROM ADHERING TO SURFACES.
- FOR BENDS, BEARING AREA SHALL BE PARALLEL TO THE EDGE OF THE FITTING AT THE FITTING MIDPOINT.
- FOR TEES, BEARING AREA SHALL BE PERPENDICULAR TO THE BRANCH (SINGLE LEG) AXIS.
- FOR REDUCERS, BEARING AREA SHALL BE PERPENDICULAR TO THE FITTING AXIS. THE MINIMUM THICKNESS ALONG THE FITTING AXIS SHALL BE 1'-0" OR THE LENGTH BETWEEN THE BELLS, WHICHEVER IS SMALLER.
- THRUST BLOCK ANCHOR RODS SHALL MEET THE REQUIREMENTS OF SECTION 530.2.5 OF THE NHDOT STANDARD SPECIFICATIONS. ALL EMBEDDED RODS SHALL HAVE STANDARD ACI HOOKS ON EACH END, AND SHALL HAVE A MINIMUM OF 3" CONCRETE COVER IN ALL DIRECTIONS.
- THRUST RESTRAINT FOR SIZES OVER 24 NPS AND/OR FOR OTHER FITTINGS NOT SHOWN ON THESE SHEETS WILL BE AS SHOWN IN THE CONTRACT DOCUMENTS.
- THRUST BLOCK SIZES AND MINIMUM RESTRAINED LENGTHS SHOWN ON THESE SHEETS ARE BASED UPON THE FOLLOWING ASSUMED CONDITIONS:
1.5 SAFETY FACTOR
5 FT DEPTH OF COVER
200 PSI WATER SYSTEM TEST PRESSURE
30n SOIL FRICTION ANGLE
90 LBS/FT³ SOIL UNIT WEIGHT
IF SOILS ARE POORER THEN REFER TO REFERENCES
- FOR INSTALLATIONS NOT MEETING THE CONDITIONS OF NOTE 8, THE CONTRACTOR SHALL SUBMIT CALCULATIONS TO THE ENGINEER FOR APPROVAL OF RESTRAINT LENGTH CHOSEN.
- TO DETERMINE REQUIRED SIZES FOR DIFFERENT TEST PRESSURES, MULTIPLY THE DIMENSION BY A FACTOR OF THE SPECIFIC VALUE DIVIDED BY THE STANDARD VALUE.

EXAMPLE: GRAVITY BLOCK VOLUME FOR 12 NPS 45° BEND WITH 100 PSI TEST PRESSURE:
WIDTH = 3'-3"
HEIGHT = 1'-7"
VOLUME REQUIRED 134 Ftr X (100/200) = 67 Ftr

designed by:	LEK/OOK	drawn by:	LEK/OOK	approved by:	J/LG
date:	May 2015	project no.:	923	file name:	923-Thrust Block.dwg
scale:	As Shown				
<p>Town of Exeter Department of Public Works Linden Street Little River Bridge Replacement Thrust Block Details</p>					
drawing no. R-6					
sheet:	28	of	29	no.	AS-BUILT
revision	1/6/16	date	J/LG	by	



W20-3

1
48" X 48"




W20-3

2
48" X 48"




W20-3

3
48" X 48"

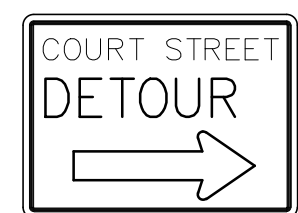

M4-9R

4
30" X 24"

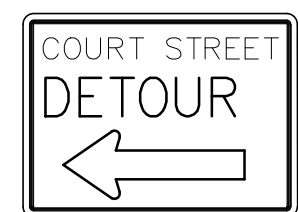



M4-9L

5
30" X 24"



M4-8a

6
24' X 18"

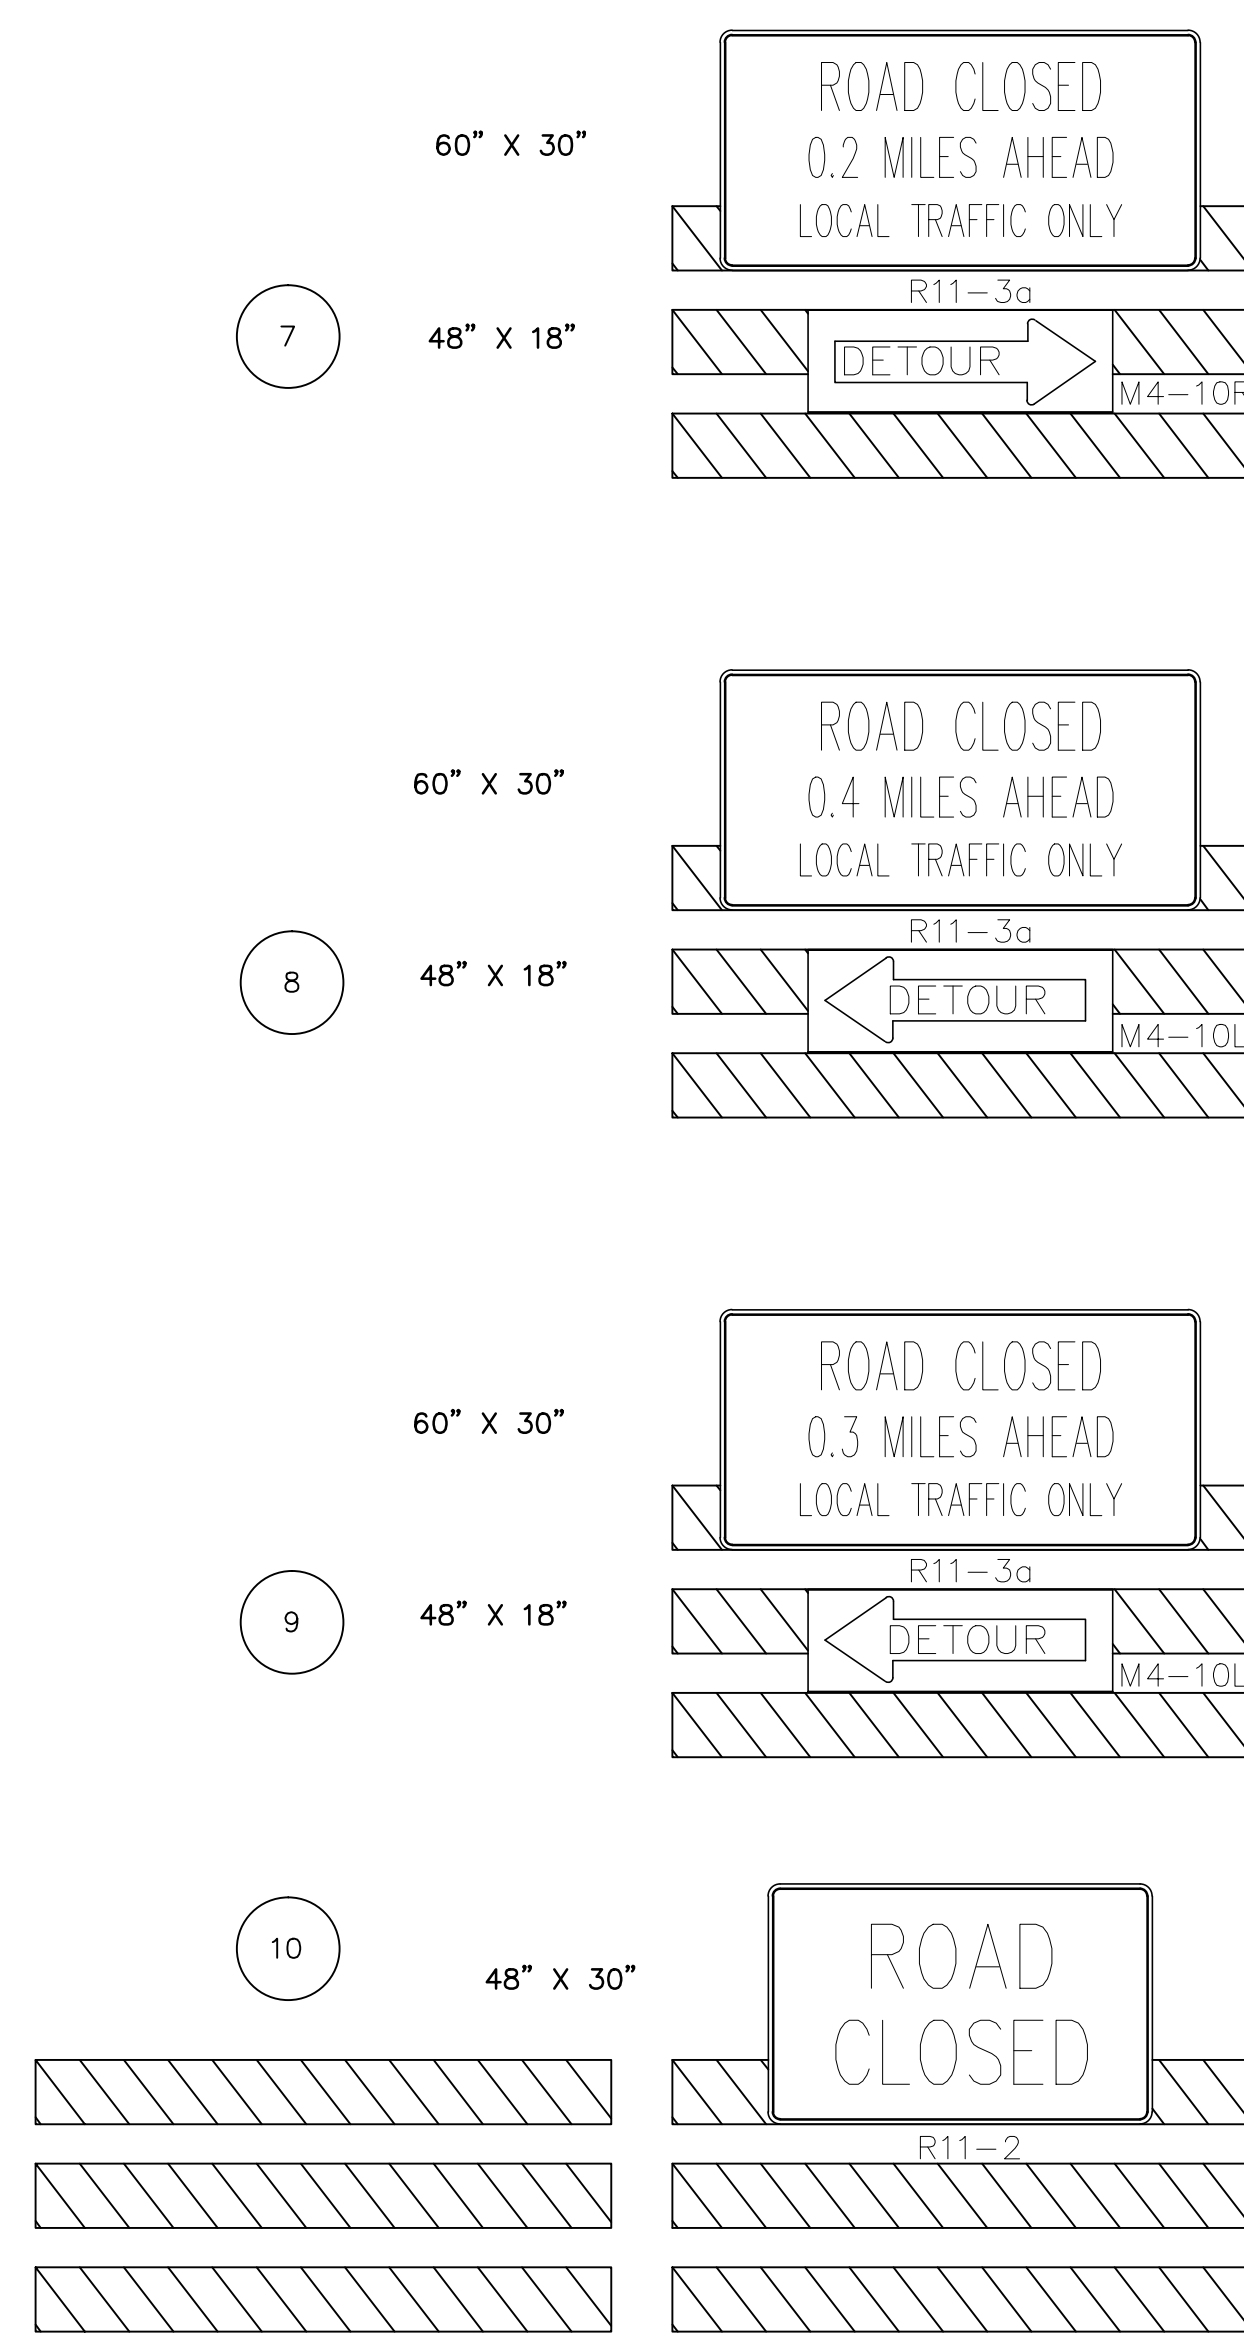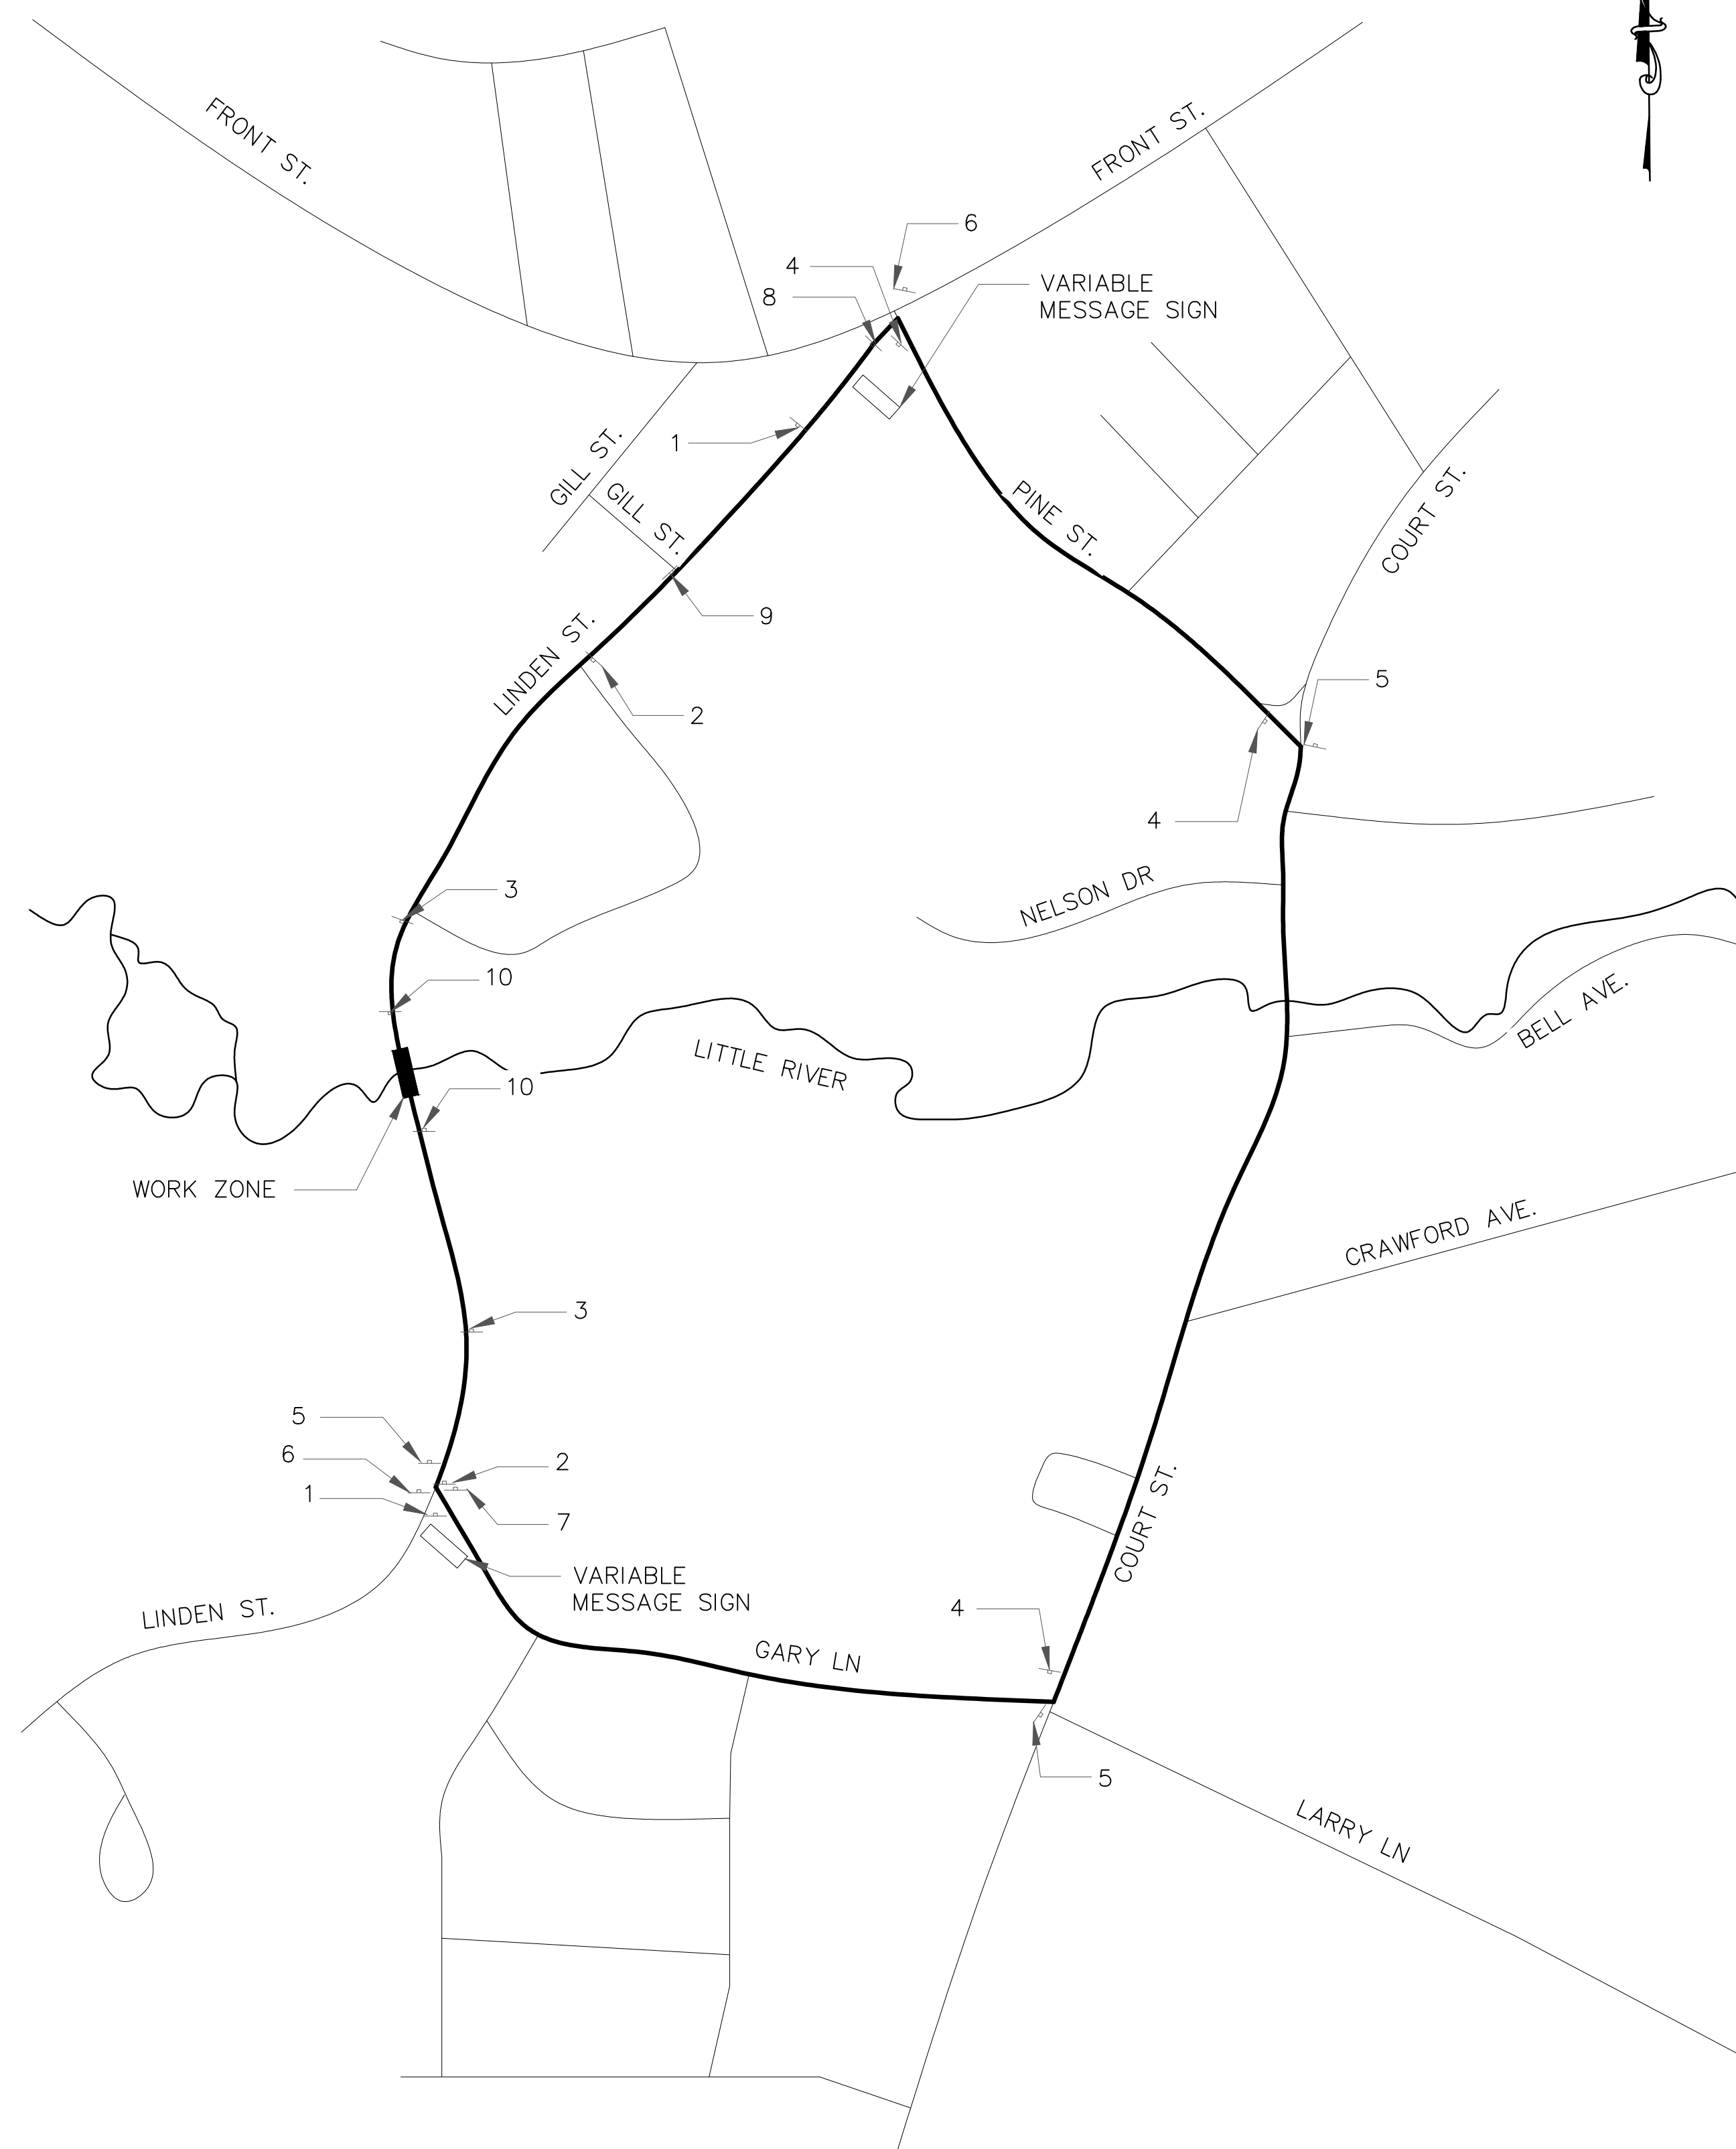

- NOTES:
- ALL TRAFFIC CONTROL DEVICES SHALL CONFORM WITH SECTIONS 618 AND 619 OF THE STANDARD SPECIFICATIONS, THESE TRAFFIC CONTROL PLANS, THE CURRENT EDITION OF THE MUTCD, INCLUDING ALL REVISIONS, AND THE STATE OF NEW HAMPSHIRE DOT TRAFFIC CONTROL HANDBOOK.
 - 30 LINEAR FT OF TEMPORARY CONCRETE BARRIER SHALL BE PLACED TO BLOCK THE ROADWAY DIRECTLY BEHIND THE TYPE III BARRICADES (#10).
 - CONTRACTOR IS RESPONSIBLE FOR SUPPLYING AND MAINTAINING ALL SIGNS REQUIRED FOR DETOUR.
 - SIGNS SHALL BE REMOVED OR COVERED DURING PERIODS IN WHICH THEY ARE NOT REQUIRED.
 - LAYOUT SHOWN IS NOT TO SCALE AND IS A SUGGESTED LAYOUT.
 - CONTRACTOR SHALL SUBMIT A SIGNAGE PLAN FOR APPROVAL PRIOR TO ANY WORK.
 - TOTAL ESTIMATED SIGN AREA: 207.5 SF
 - ALL COST FOR TRAFFIC CONTROL DEVICES INCLUDING PLACEMENT, RELOCATION, AND REMOVAL OF SIGNS SHALL BE INCLUDED IN ITEM 619.1 - MAINTENANCE OF TRAFFIC.
 - THE CONTRACTOR SHALL COORDINATE ALL WORK WITH THE TOWN OF EXETER PUBLIC WORKS, FIRE AND POLICE DEPARTMENTS, AND ENGINEER AT LEAST 14 DAYS PRIOR TO IMPLEMENTING AND ROAD CLOSURES OR DETOURS.
 - THE CONTRACTOR SHALL PLACE PORTABLE MESSAGE BOARDS (PMB'S) AS INDICATED ON THE PLANS AT LEAST 7 DAYS IN ADVANCE OF ROAD CLOSURES AND DETOURS.
 - ACCESS TO EXISTING DRIVES SHALL BE MAINTAINED AT ALL TIMES. IN THE EVENT THAT MAJOR WORK MUST BE DONE AT DRIVES THAT PRECLUDES FULL ACCESS, THE CONTRACTOR IS TO COORDINATE THE WORK WITH THE OWNER TO MINIMIZE INCONVENIENCED.

		10 Free Street Portsmouth, NH 03801 603.931.6196	55 So Commercial Street Manchester, NH 03101 603.627.0708	info@cmaengineers.com www.cmaengineers.com
designed by: OGK	date: May 2015	drawn by: OGK	approved by: JLG	scale: N.T.S.
Town of Exeter Department of Public Works	Linden Street Little River Bridge Replacement	Linden Street Traffic Control Plan	drawing no. R-7	sheet: 29 of 29
revision: 0 AS-BUILT				no. 0
by: JLG				date: 1/6/16